

DRAWING NUMBER: MD-216-49RH-EG-CV-GAD-1007 | REV: D01

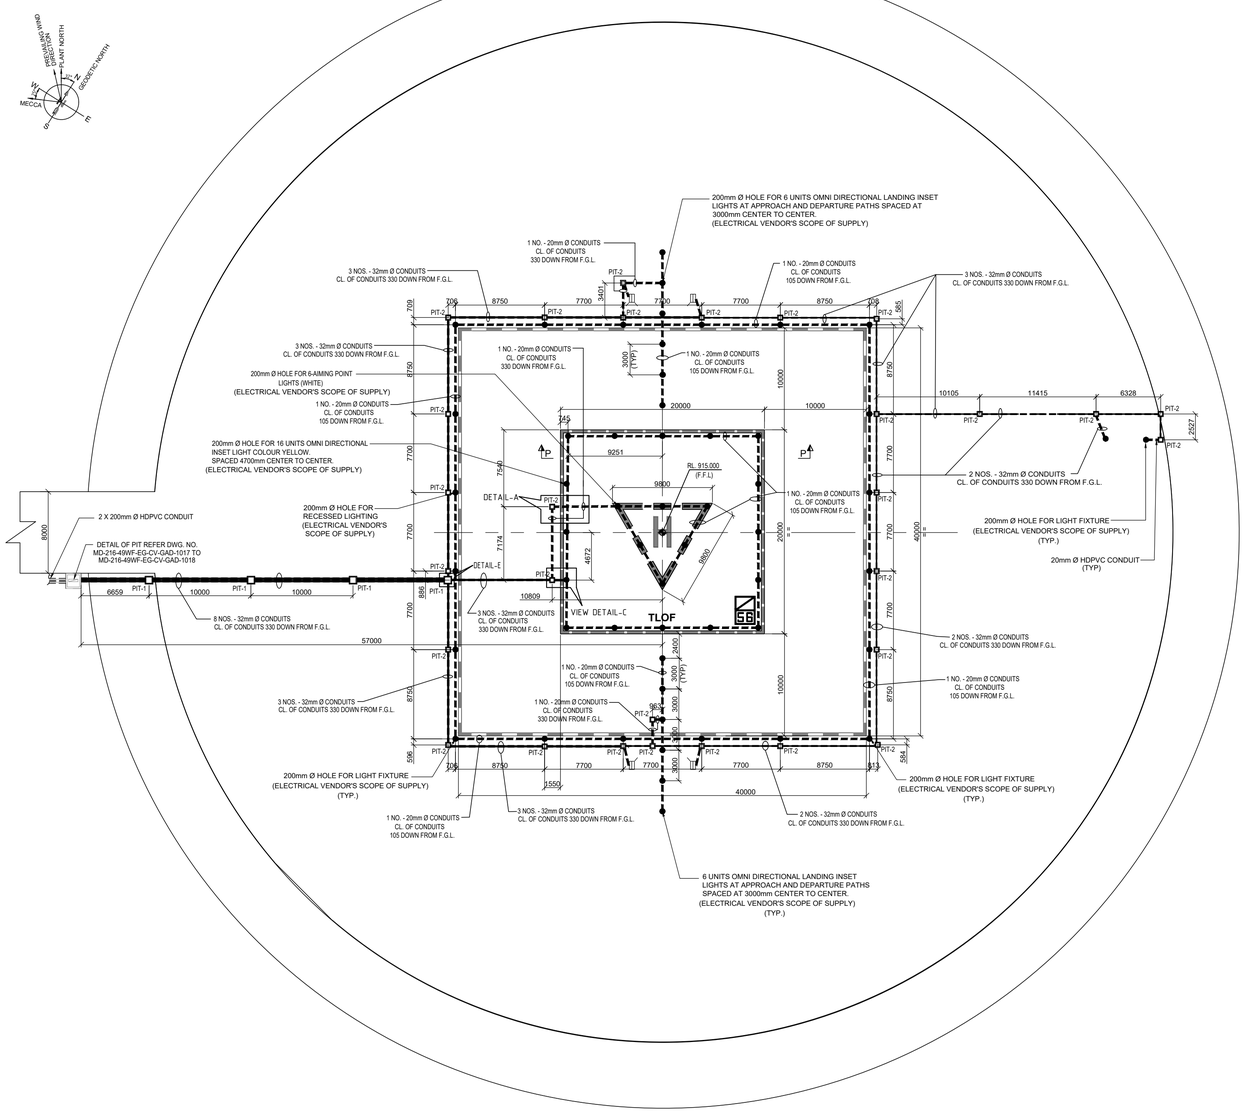

LAYOUT OF PIT & ELECTRICAL CONDUITS

SCALE 1 : 200

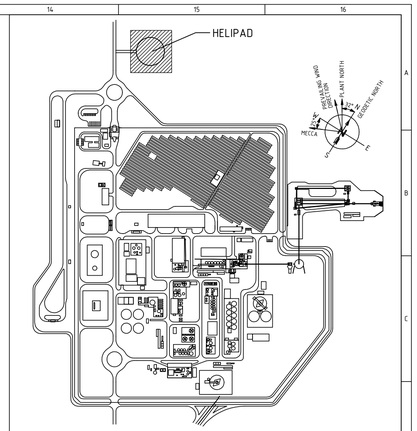

KEY PLAN

SCALE = 1:1000

LEGENDS :-

R.L - REDUCED LEVEL
℄ - CENTRE LINE
T.O.C - TOP OF CONCRETE
TYP - TYPICAL
T.O.G - TOP OF GROUT
B.O.F - BOTTOM OF FOUNDATION
F.G.L - FINISHED GROUND LEVEL
F.F.L - FINISHED FLOOR LEVEL
P.C.C - PLAIN CEMENT CONCRETE
DET. - DETAIL
FDN. - FOUNDATION
THK. - THICK
R.C.C - REINFORCED CEMENT CONCRETE
MKD. - MARKED
DWG. - DRAWING
Ø - DIAMETER

NOTES:-

1. ALL DIMENSIONS ARE IN MILLIMETRES AND LEVELS AND CO-ORDINATES ARE IN METRES UNLESS OTHERWISE STATED.
2. ALL LIGHT FIXTURE AND EMBEDED PART SHALL BE AVAILABLE BEFORE CASTING OF TLOF AREA.
3. ALL PIT COVERS SHALL BE 50 KN/sqm LOAD CARING CAPACITY.
4. THIS DRAWING SHALL READ IN CONJUNCTION WITH DRAWING NO. MD-216-49RH-EG-CV-GAD-1008.
5. FOR CIVIL WORKS GENERAL NOTES, REFER DRAWING NUMBER MD-216-1000-EG-CV-DED-1001.

DOCUMENT NUMBER	REFERENCE DOCUMENTS	REV	DATE	REVISION DESCRIPTION	DRN	CHK	ENG	APP	EMP
MD-216-4000-EG-EL-LAD-1024	BURIED CABLE ROUTE - HELIPAD								
MD-216-49RH-EG-CV-GAD-1007	HELIPAD - DETAILS OF FLOOR	D01	17/03/2023	AS-BUILT	AMJ	SJM	AVG	AG	
MD-216-49RH-EG-CV-GAD-1006	HELIPAD - LAYOUT AND DETAILS	C01	08/06/2021	ISSUED FOR CONSTRUCTION & REVISED AS MKD	AMJ	SJM	AVG	AG	
MD-216-1000-EG-ST-CRT-1001	CIVIL, STRUCTURAL & ARCHITECTURAL - DESIGN CRITERIA	A01	14/04/2021	ISSUED FOR REVIEW	AMJ	SJM	AVG	AG	

RESERVED FOR VENDOR LOGO AND DRAWING NUMBER

LARSEN & TOUBRO

This drawing is the property of LARSEN & TOUBRO and must not be passed on to any person or body not authorized by us to receive it nor be copied or otherwise made use either in full or in part by such person or body without our prior permission in writing.

Outotec

The content of these documents are the sole property of Outotec Oyj. Any rights not expressly granted herein are reserved. Reproduction, transfer or distribution of part or all of the contents in any form without prior written permission of Outotec is prohibited.

MA'ADEN معادن Saudi Arabian Mining Company

This document and the information contained herein is Ma'aden proprietary know-how. This document or any part thereof should not be reproduced, stored in a retrieval system or transmitted by any means, electronic or otherwise, or divulged without prior written permission of Ma'aden.

LARSEN & TOUBRO DRAWING NUMBER	019045_910_C_G_24620_001	REVISION 2
OUTOTEC DRAWING NUMBER	900707__GAU01__AN03__MTL01__00011	DOCUMENT ID OU100721846 / REVISION 2
DRAWN	AMJ	12/04/2021
CHECKED	SJM	13/04/2021
ENGINEER	AVG	12/04/2021
APPROVED	AG	14/04/2021
EMPLOYER		
SCALE	1:20, 1:30, 1:50, 1:75	A0

MANSOURAH - MASSARAH GOLD PROJECT
GENERAL ARRANGEMENT DRAWING
HELIPAD
LAYOUT OF PIT & BURIED CABLE ROUTE

DRAWING NUMBER: MD - 216 - 49RH - EG - CV - GAD - 1007 | REV: D01