


DRAWING NUMBER: MD - 216 - 49RH- EG - CV - GAD - 1008
REV: D01

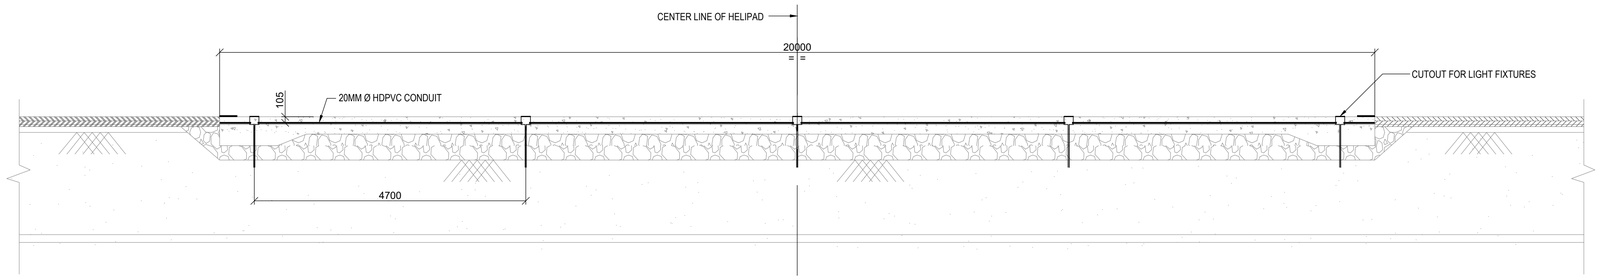


SECTION P - P
SCALE 1 : 50

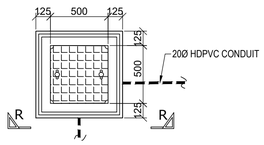


DETAIL - A
DETAIL OF PULL BOX
MKD. PIT-2
SCALE 1:25

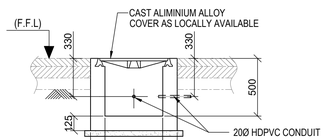


VIEW R-R
SCALE 1:25

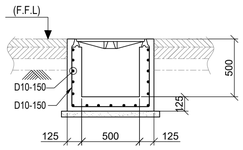


VIEW R-R
(SHOWING RC DETAIL)
SCALE 1:25

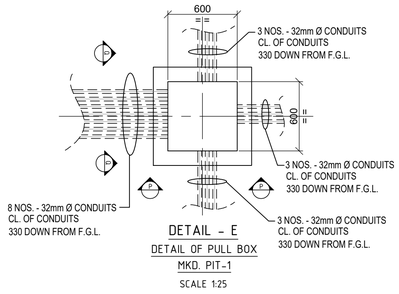

DETAIL - E
DETAIL OF PULL BOX
MKD. PIT-1
SCALE 1:25

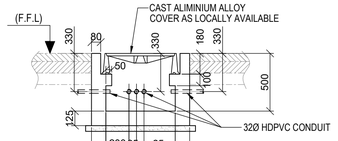


VIEW P-P
SCALE 1:25

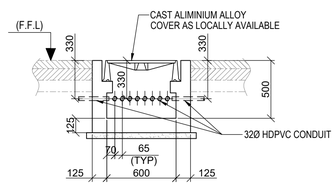


VIEW Q-Q
SCALE 1:25

LEGENDS :-


R.L. - REDUCED LEVEL
CL. - CENTRE LINE
T.O.C. - TOP OF CONCRETE
TYP. - TYPICAL
B.O.F. - BOTTOM OF FOUNDATION
F.G.L. - FINISHED GROUND LEVEL.
F.F.L. - FINISHED FLOOR LEVEL
P.C.C - PLAIN CEMENT CONCRETE
R.C.C - REINFORCED CEMENT CONCRETE
MKD. - MARKED
DWG. - DRAWING
THK. - THICK
DET. - DETAIL
FDN. - FOUNDATION

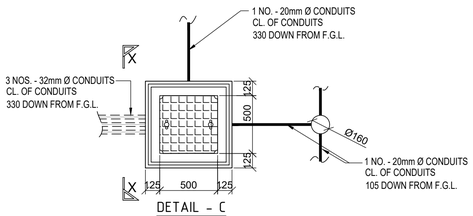


DETAIL - C
DETAIL OF PULL BOX
MKD. PIT-1
SCALE 1:25

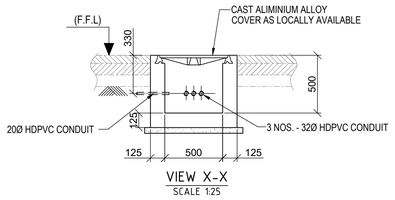


VIEW X-X
SCALE 1:25

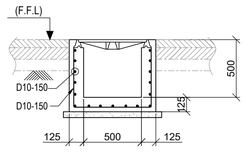

VIEW X-X
(SHOWING RC DETAIL)
SCALE 1:25

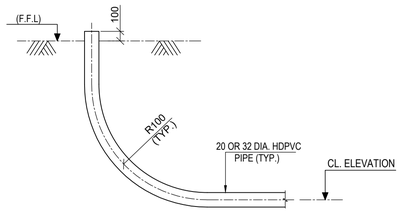

TYP. DET. OF CONDUIT
SCALE 1:30

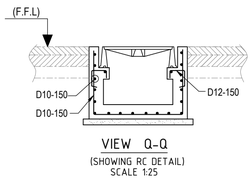

VIEW Q-Q
(SHOWING RC DETAIL)
SCALE 1:25

NOTES:-

1. ALL DIMENSIONS ARE IN MILLIMETRES AND LEVELS AND CO-ORDINATES ARE IN METRES UNLESS OTHERWISE STATED.
2. ALL LIGHT FIXTURE AND EMBEDED PART SHALL BE AVAILABLE BEFORE CASTING OF TLOF AREA.
3. ALL PIT COVERS SHALL BE 50 KN/sqm LOAD CARING CAPACITY.
4. THIS DRAWING SHALL READ IN CONJUNCTION WITH DRAWING NO. MD-216-49RH-EG-CV-GAD-1007.
5. GRADE OF CONCRETE SHALL BE C35 (35Mpa).
6. GRADE OF REINFORCEMENT SHALL BE DEFORMED BAR 420 MPa (GRADE 60) - ASTM A615/A615M.
7. CLEAR COVER TO REINFORCEMENT SHALL BE SLAB = 25 MM.
8. FOR STANDARD REINFORCEMENT DETAIL & GENERAL NOTES FOR CIVIL WORKS REFER DRAWING NO. MD-216-1000-EG-CV-DED-1005 & 1001.

DOCUMENT NUMBER	REFERENCE DOCUMENTS			REVISION DESCRIPTION	DRN	CHK	ENG	APP	EMP
MD-216-4000-EG-EL-LAD-1024	BURIED CABLE ROUTE - HELIPAD								
MD-216-49RH-EG-CV-GAD-1007	HELIPAD - DETAILS OF FLOOR	D01	17/03/2023	AS-BUILT	AMJ	SJM	AVG	AG	
MD-216-49RH-EG-CV-GAD-1006	HELIPAD - LAYOUT AND DETAILS	C01	08/06/2021	ISSUED FOR CONSTRUCTION & REVISED AS MKD. C01	AMJ	SJM	AVG	AG	
MD-216-1000-EG-ST-CRT-1001	CIVIL,STRUCTURAL AND ARCHITECTURAL DESIGN CRITERIA	A01	14/04/2021	ISSUED FOR REVIEW	AMJ	SJM	AVG	AG	

RESERVED FOR VENDOR LOGO AND DRAWING NUMBER

LARSEN & TOUBRO

This drawing is the property of LARSEN & TOUBRO and must not be passed on to any person or body not authorized by us to receive it nor be copied or otherwise made use either in full or in part by such person or body without our prior permission in writing.

Outotec

The content of these documents are the sole property of Outotec Oyj. Any rights not expressly granted herein are reserved. Reproduction, transfer or distribution of part or all of the contents in any form without prior written permission of Outotec is prohibited.

MA'ADEN معادن
Saudi Arabian Mining Company شركة التعدين العربية السعودية

This document and the information contained herein is Ma'aden proprietary know-how. This document or any part thereof should not be reproduced, stored in a retrieval system or transmitted by any means, electronic or otherwise, or divulged without prior written permission of Ma'aden.

LARSEN & TOUBRO DRAWING NUMBER: 019045_910_C_G_24621_001 — REVISION: 2
OUTOTEC DRAWING NUMBER: 900707 __GAU01 __AN03__MTL01 __00012 — DOCUMENT ID: OU100721847 — REVISION: 2

DRAWN	AMJ	12/04/2021
CHECKED	SJM	13/04/2021
ENGINEER	AVG	12/04/2021
APPROVED	AG	14/04/2021
EMPLOYER		
SCALE	1:75, 1:25 & 1:15	A1

MANSOURAH - MASSARAH GOLD PROJECT
GENERAL ARRANGEMENT DRAWING
HELIPAD
DETAIL OF PIT & BURIED CABLE ROUTE

DRAWING NUMBER: MD - 216 - 49RH- EG - CV - GAD - 1008
REV: D01