

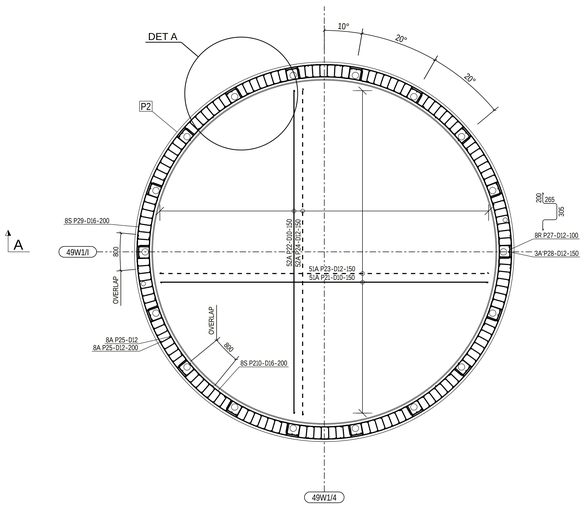



49W1-REA-003 R.C.C DETAIL AT TOP OF FOUNDATION
(SCALE 1:50)

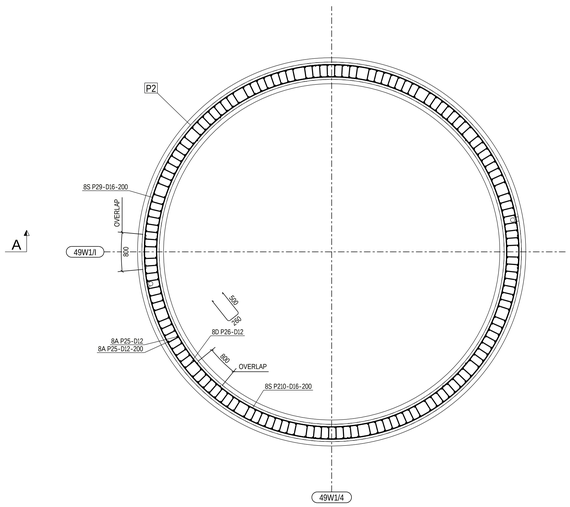

49W1-REA-003 R.C.C DETAIL AT BOTTOM OF FOUNDATION
(SCALE 1:50)

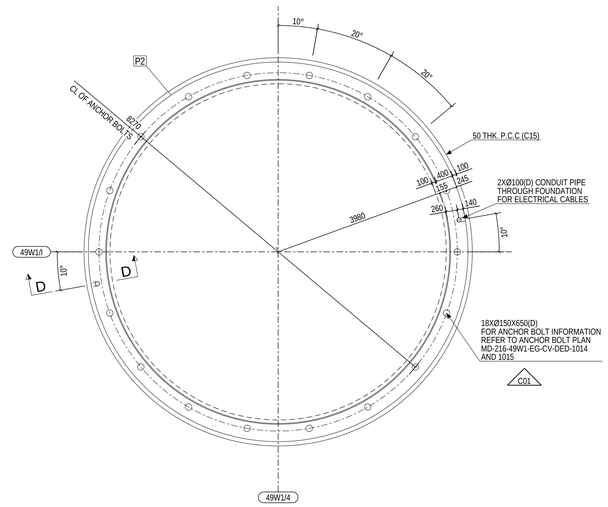


49W1-REA-003 PLAN AT TOP OF FOUNDATION
(SCALE 1:50)

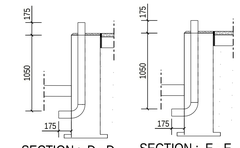

SECTION : D - D
(SCALE 1:30)

SECTION : E - E
(SCALE 1:30)

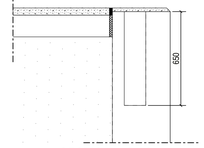

SECTION : C - C
(SCALE 1:15)

CONCRETE INFORMATION

Concretes used	C35
Concrete cover 1	50±10mm

REINFORCING BAR LIST

CAST UNIT CODE: P2 PCS: 1

REINFORCING BARS TYPE	POS	PCS	GRADE	D [mm]	L [mm]	dL [mm]	WEIGHT SUM [kg]	BENDING DIMENSIONS [mm] a	b	c	d	e	u	v	x	TD	COMMENT
A	P21	51	B500B	10	7590		191.9	7599									
1 AT GROUP	51	PCS		...	2500	102	...	2508									
A	P22	52	B500B	10	7690		192.4	7693									
1 AT GROUP	52	PCS		...	1750	116	...	1757									
A	P23	51	B500B	12	7590		276.2	7599									
1 AT GROUP	51	PCS		...	2500	102	...	2508									
A	P24	52	B500B	12	7690		276.9	7693									
1 AT GROUP	52	PCS		...	1760	116	...	1763									
A	P25	288	B500B	12	1270		326.1	1275									
D	P26	288	B500B	12	1200		307.1	500	260	500						60	
R	P27	144	B500B	12	1110		142.6	200	265	305	265	200				60	
A	P28	54	B500B	12	730		35.2	735									
S	P29	32	B500B	16	7580		383.6	7588	4330							666	862
S	P210	32	B500B	16	7140		361.3	7147	4049							626	806

REINFORCING BAR TOTAL WEIGHT [kg] 2493.2


REINFORCING BAR LIST


CAST UNIT CODE: P3 PCS: 1

REINFORCING BARS TYPE	POS	PCS	GRADE	D [mm]	L [mm]	dL [mm]	WEIGHT SUM [kg]	BENDING DIMENSIONS [mm] a	b	c	d	e	u	v	x	TD	COMMENT
S	P31	32	B500B	16	5960		301.7	5968	3296							519	655
S	P32	32	B500B	16	6400		324.0	6410	3580							559	712
R	P33	64	B500B	12	1110		63.4	200	265	305	265	200				60	
A	P34	24	B500B	12	730		15.7	735									
A	P35	224	B500B	12	1270		253.6	1275									
D	P36	224	B500B	12	1200		238.9	500	260	500						60	
A	P37	43	B500B	10	6220		125.8	6220									
34 AT GROUP	43	PCS		...	1110	122	...	1111									
A	P38	42	B500B	10	6190		125.4	6193									
1 AT GROUP	42	PCS		...	1490	115	...	1496									
A	P39	43	B500B	12	6220		181.1	6220									
1 AT GROUP	43	PCS		...	1110	122	...	1116									
A	P310	42	B500B	12	6190		180.5	6193									
1 AT GROUP	42	PCS		...	1500	114	...	1502									


REINFORCING BAR TOTAL WEIGHT [kg] 1810.0

REINFORCEMENT BENDING SHAPES:

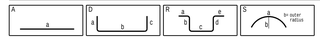


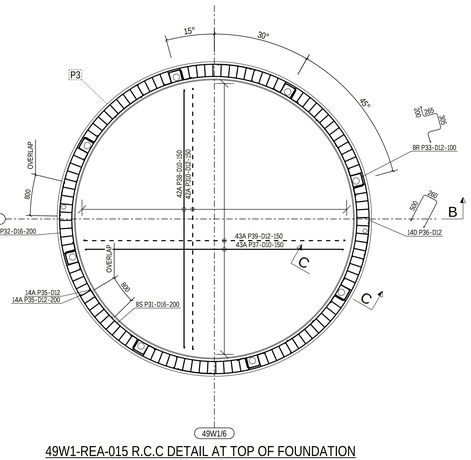


49W1-REA-015 R.C.C DETAIL AT TOP OF FOUNDATION

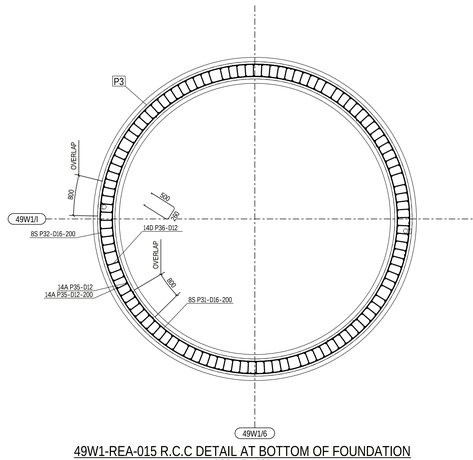


49W1-REA-015 R.C.C DETAIL AT BOTTOM OF FOUNDATION
(SCALE 1:50)

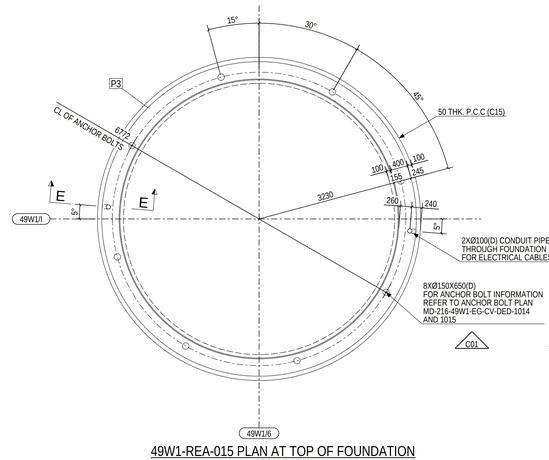


49W1-REA-015 PLAN AT TOP OF FOUNDATION
(SCALE 1:50)

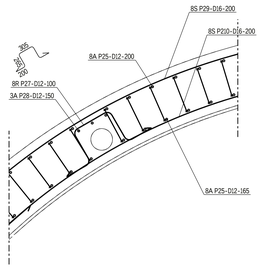


DETAIL : A
(SCALE 1:15)

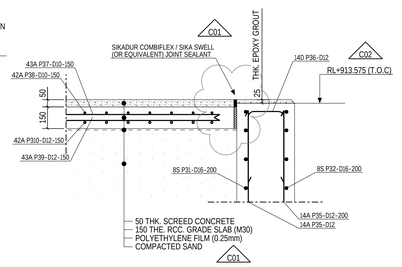


DETAIL : C
(SCALE 1:15)

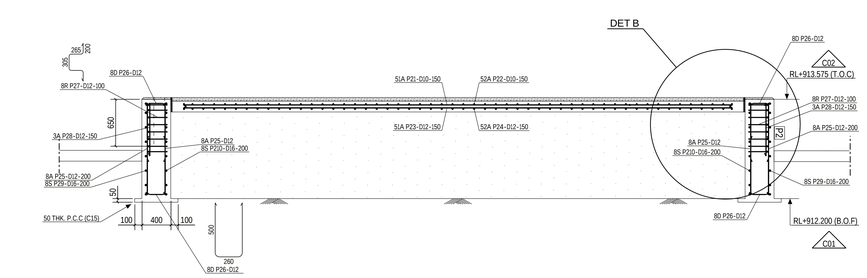

SECTION : A - A
(SCALE 1:30)

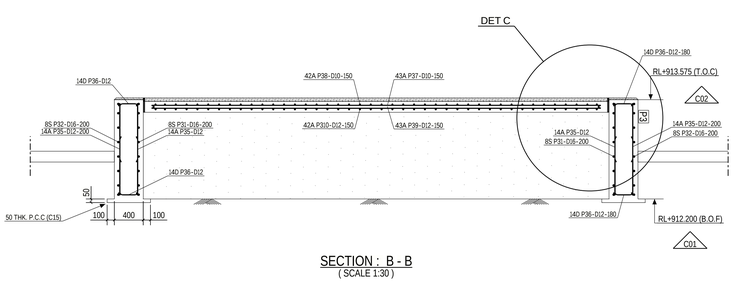

SECTION : B - B
(SCALE 1:30)

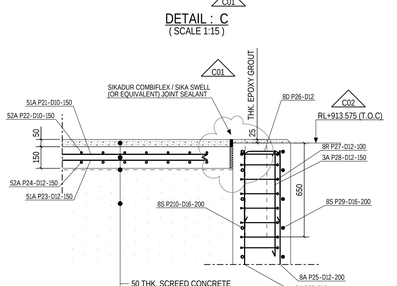

DETAIL : B
(SCALE 1:15)

NOTES:


1. ALL DIMENSIONS ARE IN MILLIMETRES AND LEVELS ARE IN METRES UNLESS OTHERWISE STATED
2. GRADE OF CONCRETE SHALL BE C35 (35MPa) UNLESS NOTED OTHERWISE & C15 (15MPa) FOR BUNDING CONCRETE.
3. GRADE OF REINFORCEMENT SHALL BE DEFORMED BAR ASTM A615-GRADE 60 (fy=420MPa)
4. CLEAR COVER TO MAIN REINFORCEMENT SHALL BE AS FOLLOWS:
a) FOUNDATION: 75 mm (BOTTOM & SIDE)
b) FOUNDATION: 50 mm (TOP)
c) COLUMN & PEDESTAL: 50 mm
5. MINIMUM LAP LENGTHS OF REINFORCEMENT SHALL BE 40XBAR DIAMETER
6. FOR STANDARD REINFORCEMENT DETAILS & GENERAL NOTES FOR CIVIL WORKS REFER TO DRAWING NUMBER MD-216-1000-EG-CV-DED-1005 & 1001
7. ANCHOR BOLTS AND EMBEDDED STEELWORK SHALL BE HOT DEEP GALVANIZED
8. T.O.C. TOLERANCE SHALL BE WITHIN +/- 10MM OF DESIGN LEVEL
9. NET SAFE BEARING CAPACITY OF SOIL AT BOTTOM OF FOUNDATION IS CONSIDERED AS 375 KN/SQ.M.
8. NET SAFE BEARING CAPACITY UNDER RING WALL 375 kPa
9. SAND SHALL BE COMPACTED TO A MAXIMUM DEPTH OF 300mm & SHALL BE COMPACTED TO 80% RELATIVE DENSITY AS DETERMINED BY ASTM D4253 & ASTM D254
10. TOP OF SCREED TOLERANCE SHALL BE WITHIN +/- 10mm OF DESIGN LEVEL

C01

LEGEND:

R.L. - REDUCED LEVEL
T.O.C. - TOP OF CONCRETE
B.O.F. - BOTTOM OF FOUNDATION
F.G.L. - FINISHED GROUND LEVEL
P.C.C. - PLAIN CEMENT CONCRETE
TYP - TYPICAL
MKD - MARKED
CL - CENTER LINE
BOTTOM REINF. (B)
TOP REINF. (T)
SBC - SAFE BEARING CAPACITY
MIN. - MINIMUM
REF. - REFERED
GA - GENERAL ARRANGEMENT
DWG. - DRAWING
R.C.C. - REINFORCED CEMENT CONCRETE

KEYPLAN

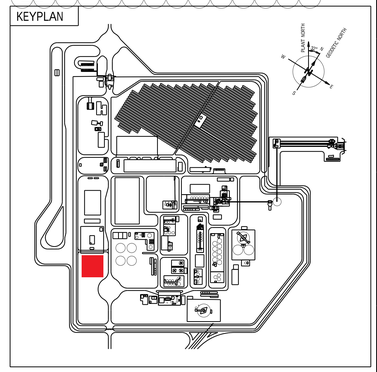

DOCUMENT NUMBER	REFERENCE DOCUMENTS
MD-216-49W1-EG-CV-CAL-1001	TANK FOUNDATIONS CALCULATION REPORT
MD-216-49W1-EG-CV-GAD-1003	1-10/A-E GENERAL ARRANGEMENT DRAWING
MD-216-49W1-EG-CV-GAD-1001	1-8/E-J GENERAL ARRANGEMENT DRAWING

DOCUMENT NUMBER	REFERENCE DOCUMENTS
MD-216-49W1-EG-CV-DED-1002	BACKWASH & REJECT TANK FOUNDATIONS DETAIL- AND REINFORCEMENT DRAWING
MD-216-49W1-EG-CV-GAD-1002	7-12/D-J GENERAL ARRANGEMENT DRAWING

REV	DATE	REVISION DESCRIPTION	DRN	CHK	ENG	APP	EMP
D01	29.01.2024	AS-BUILT	JonRen	MauNot	NarMiu	LuiPiz	
C02	17.12.2021	FOUNDATION TOP LEVEL CHANGED	JonRen	MauNot	NarMiu	LuiPiz	
C01	19.11.2021	ISSUED FOR CONSTRUCTION, REVISED AS FROM COMMENTS	JonRen	MauNot	NarMiu	LuiPiz	
A01	29.10.2021	ISSUED FOR APPROVAL	JonRen	MauNot	NarMiu	LuiPiz	

RESERVED FOR VENDOR LOGO AND DRAWING NUMBER

LARSEN & TOUBRO

This drawing is the property of LARSEN & TOUBRO and must not be passed on to any person or body not authorized by us to receive it or be copied or otherwise made use either in full or in part by such person or body without our prior permission in writing.

Outotec

The content of these documents are the sole property of Outotec Oyj. Any rights not expressly granted herein are reserved. Reproduction, transfer or distribution of part or all of the contents in any form without prior written permission of Outotec is prohibited.

MA'ADEN معادن
Saudi Arabian Mining Company شركة معادن العربية السعودية

This document and the information contained herein is Ma'aden proprietary know-how. This document or any part thereof should not be reproduced, stored in a retrieval system or transmitted by any means, electronic or otherwise, or divulged without prior written permission of Ma'aden.

LARSEN & TOUBRO DRAWING NUMBER	0L19045_080_C_D_24892_001	REVISION	3
OUTOTEC DRAWING NUMBER	900707_GAU01_AG11_CTB01_49001	DOCUMENT ID	0U100732633
		REVISION	3

DRAWN	JonRen	29.10.2021
CHECKED	MauNot	29.10.2021
ENGINEER	NarMiu	29.10.2021
APPROVED	LuiPiz	29.10.2021
EMPLOYER		
SCALE	1:50	A0

MANSOURAH - MASSARAH GOLD PROJECT
49W1 RAW WATER TREATMENT PLANT
TANK FOUNDATIONS 49W1-REA-015 & 49W1-REA-003
DETAIL- AND REINFORCEMENT DRAWING

DRAWING NUMBER: MD-216-49W1-EG-CV-DED-1001 | REV: D01