


DRAWING NUMBER: MD-216-49W1-EG-CV-DED-1003 | REV: D01

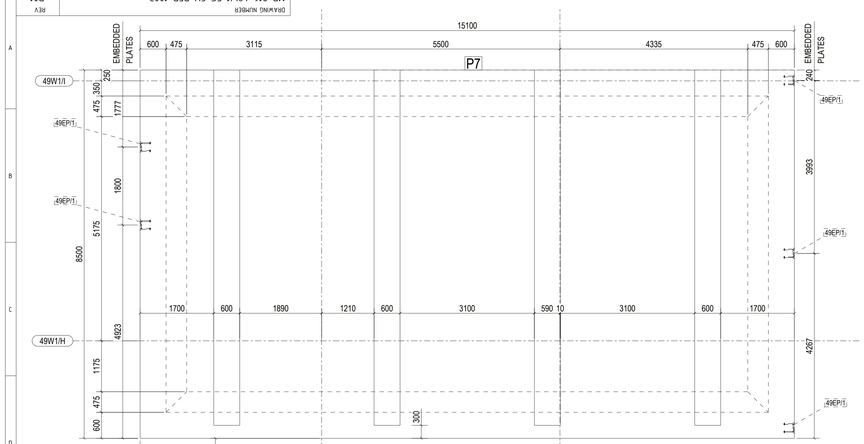


R.C.C GROUND SLAB
(SCALE 1:50)

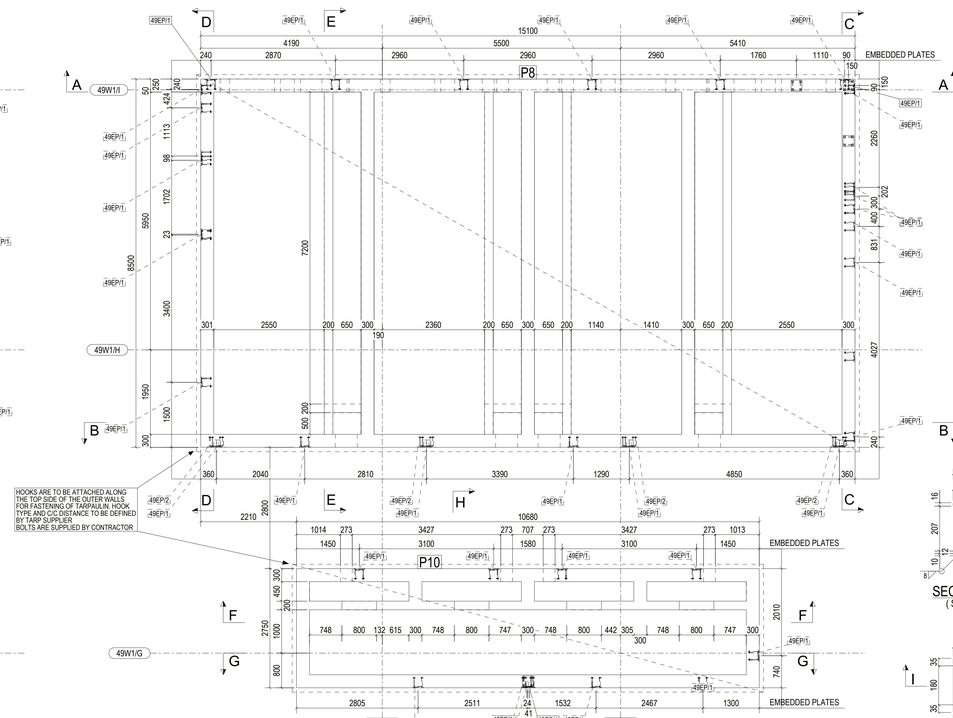

H R.C.C WALLS AND CHANNELS
(SCALE 1:50)

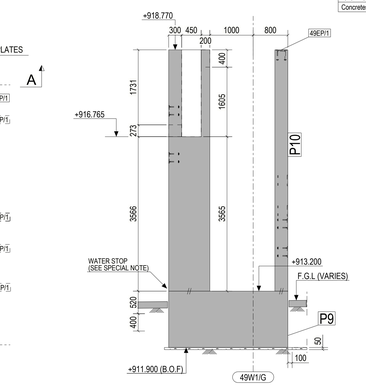


SECTION : H - H
(SCALE 1:50)

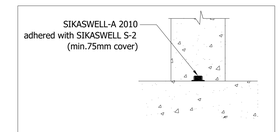


DETAIL OF CONSTRUCTION JOINT WITH WATER STOP
(SCALE 1:10)

CONCRETE INFORMATION


Concretes used	C35

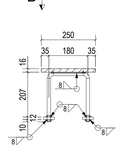


SECTION : I - I
(SCALE 1:10)

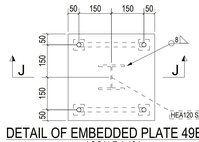


DETAIL OF EMBEDDED PLATE 49EP/2
(SCALE 1:10)

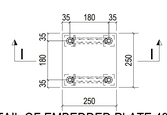


DETAIL OF EMBEDDED PLATE 49EP/1
(SCALE 1:10)

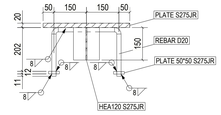


SECTION : J - J
(SCALE 1:10)

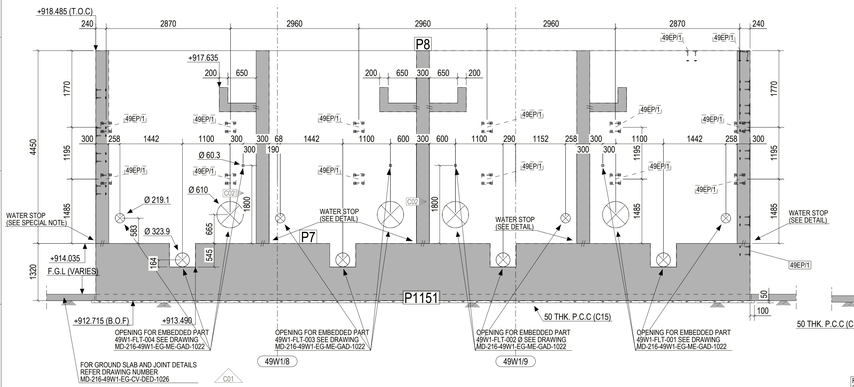


SECTION : A - A
(SCALE 1:50)

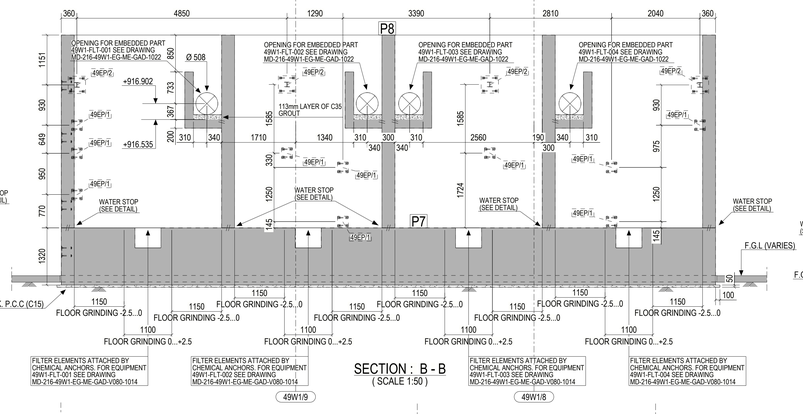


SECTION : B - B
(SCALE 1:50)

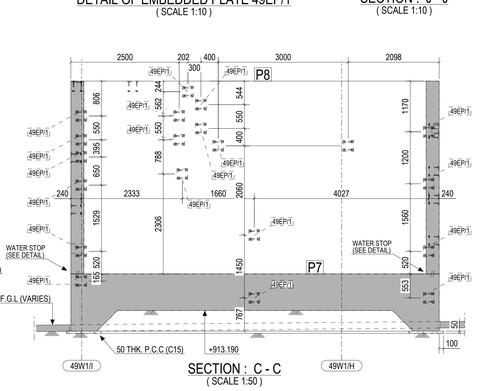


SECTION : C - C
(SCALE 1:50)

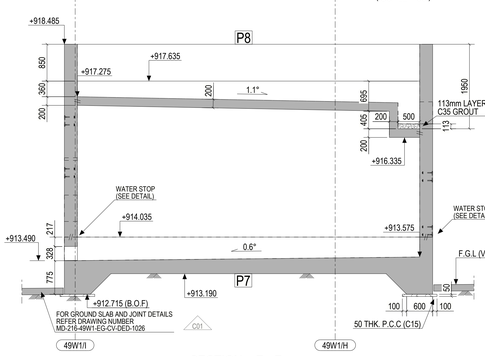


SECTION : E - E
(SCALE 1:50)

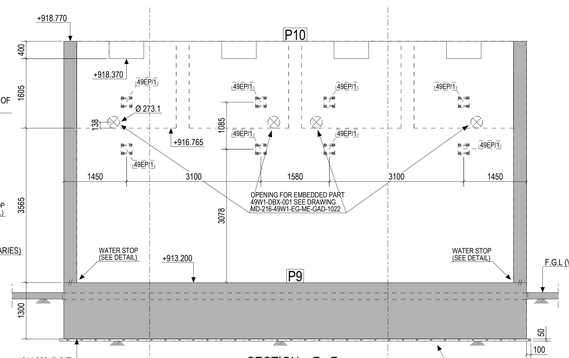

SECTION : F - F
(SCALE 1:50)

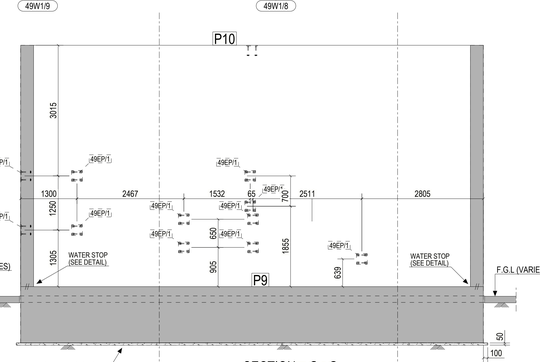


SECTION : G - G
(SCALE 1:50)

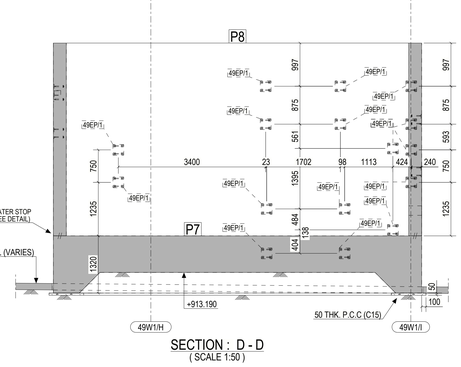

SECTION : D - D
(SCALE 1:50)

KEYPLAN

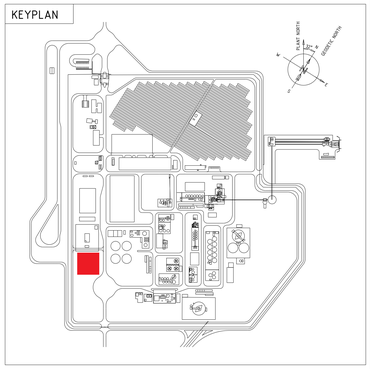

LEGEND:
R.L - REDUCED LEVEL
T.O.C. - TOP OF CONCRETE
B.O.F. - BOTTOM OF FOUNDATION
F.G.L. - FINISHED GROUND LEVEL
P.C.C. - PLAIN CEMENT CONCRETE
TYP - TYPICAL
MKD - MARKED
CL - CENTER LINE
BOTTOM REINF. (B)
TOP REINF. (T)
SBC - SAFE BEARING CAPACITY
MIN. - MINIMUM
REF. - REFERED
GA - GENERAL ARRANGEMENT
DWG. - DRAWING
R.C.C. - REINFORCED CEMENT CONCRETE
--//-- - CONSTRUCTION JOINT WITH WATER STOP

NOTES:
1. ALL DIMENSIONS ARE IN MILLIMETRES AND LEVELS ARE IN METRES UNLESS OTHERWISE STATED
2. GRADE OF CONCRETE SHALL BE C35 (35MPa) UNLESS NOTED OTHERWISE & C15 (15MPa) FOR BLINDING CONCRETE.
3. GRADE OF REINFORCEMENT SHALL BE DEFORMED BAR ASTM A615-GRADE 60 (fy=420MPa)
4. CLEAR COVER TO MAIN REINFORCEMENT SHALL BE AS FOLLOWS:
a) FOUNDATION: 75 mm (BOTTOM & SIDE)
b) FOUNDATION: 50 mm (TOP)
c) COLUMN & PEDESTAL: 50 mm
5. MINIMUM LAP LENGTHS OF REINFORCEMENT SHALL BE 40XBAR DIAMETER
6. FOR STANDARD REINFORCEMENT DETAILS & GENERAL NOTES FOR CIVIL WORKS REFER TO DRAWING NUMBER MD-216-1000-EG-CV-DED-1005 & 1001
7. ANCHOR BOLTS AND EMBEDDED STEELWORK SHALL BE HOT DIP GALVANIZED
8. T.O.C. & TOP OF SCREED TOLERANCE SHALL BE WITHIN +/- 10MM OF DESIGN LEVEL
9. NET SAFE BEARING CAPACITY OF SOIL AT BOTTOM OF FOUNDATION IS CONSIDERED AS 375 KN/SQ.M.
10. REBARS CAN BE MOVED LOCALLY BY +/- 25mm TO AVOID INTERFERENCE WITH EMBEDDED PARTS

DOCUMENT NUMBER	REFERENCE DOCUMENTS	DOCUMENT NUMBER	REFERENCE DOCUMENTS	REV	DATE	REVISION DESCRIPTION	DRN	CHK	ENG	APP	EMP
MD-216-49W1-EG-CV-DED-1026	SLAB SECTOR GL G-J/10-12										
MD-216-1000-EG-ST-CRT-1001	DESIGN CRITERIA	MD-216-49W1-EG-ME-GAD-1022	CONCRETE EMBEDDED PARTS OUTLINE DRAWING								
MD-216-49W1-EG-CV-DED-1005	SAND FILTER WALLS REINFORCEMENT DRAWING	MD-216-49W1-EG-CV-CAL-1002	SAND FILTER AND DISTRIBUTION BOX CALCULATION REPORT								
MD-216-49W1-EG-CV-GAD-1003	1-10/A-E GENERAL ARRANGEMENT DRAWING	MD-216-49W1-EG-CV-DED-1004	SAND FILTER BOTTOM SLAB REINFORCEMENT DRAWING								
MD-216-49W1-EG-CV-GAD-1001	1-8/E-J GENERAL ARRANGEMENT DRAWING	MD-216-49W1-EG-CV-GAD-1002	7-12/D-J GENERAL ARRANGEMENT DRAWING								

REV	DATE	REVISION DESCRIPTION	DRN	CHK	ENG	APP	EMP
D01	29.01.2024	AS-BUILT	MauNot	MauNot	NanWu	LuiPiz	
C02	01.06.2022	ADDED OPENING ELEVATION	MauNot	MauNot	NanWu	LuiPiz	
C01	25.01.2022	ISSUED FOR CONSTRUCTION	MaxChi	MauNot	LuiPiz	SouCha	
A02	03.01.2022	ISSUED FORAPPROVAL	JonRen	MauNot	NanWu	LuiPiz	
A01	19.10.2021	ISSUED FOR APPROVAL	JonRen	MauNot	NanWu	LuiPiz	

RESERVED FOR VENDOR LOGO AND DRAWING NUMBER

LARSEN & TOUBRO

This drawing is the property of LARSEN & TOUBRO and must not be passed on to any person or body not authorized by us to receive it nor be copied or otherwise made use either in full or in part by such person or body without our prior permission in writing.

Outotec

The content of these documents are the sole property of Outotec Oyj. Any rights not expressly granted herein are reserved. Reproduction, transfer or distribution of part or all of the contents in any form without prior written permission of Outotec is prohibited.

MA'ADEN معادن
Saudi Arabian Mining Company شركة معادن العربية السعودية

This document and the information contained herein is Ma'aden proprietary know-how. This document or any part thereof should not be reproduced, stored in a retrieval system or transmitted by any means, electronic or otherwise, or divulged without prior written permission of Ma'aden.

LARSEN & TOUBRO DRAWING NUMBER	019045_080_C_D_24892_003		REVISION 4
OUTOTEC DRAWING NUMBER	900707_GAU01_AG11_CTB01_49003	DOCUMENT ID OU100732635	REVISION 4

DRAWN	JonRen	19.11.2021	MANSOURAH - MASSARAH GOLD PROJECT 49W1 RAW WATER TREATMENT PLANT SAND FILTER AND DISTRIBUTION BOX DIMENSIONAL DRAWING
CHECKED	MauNot	19.11.2021	
ENGINEER	NanWu	19.11.2021	
APPROVED	LuiPiz	19.11.2021	
EMPLOYER			
SCALE	1:50	A0	DRAWING NUMBER MD-216-49W1-EG-CV-DED-1003 REV D01