DRAWING NUMBER MD-216-49W1-EG-CV-DED-1004 REV D01

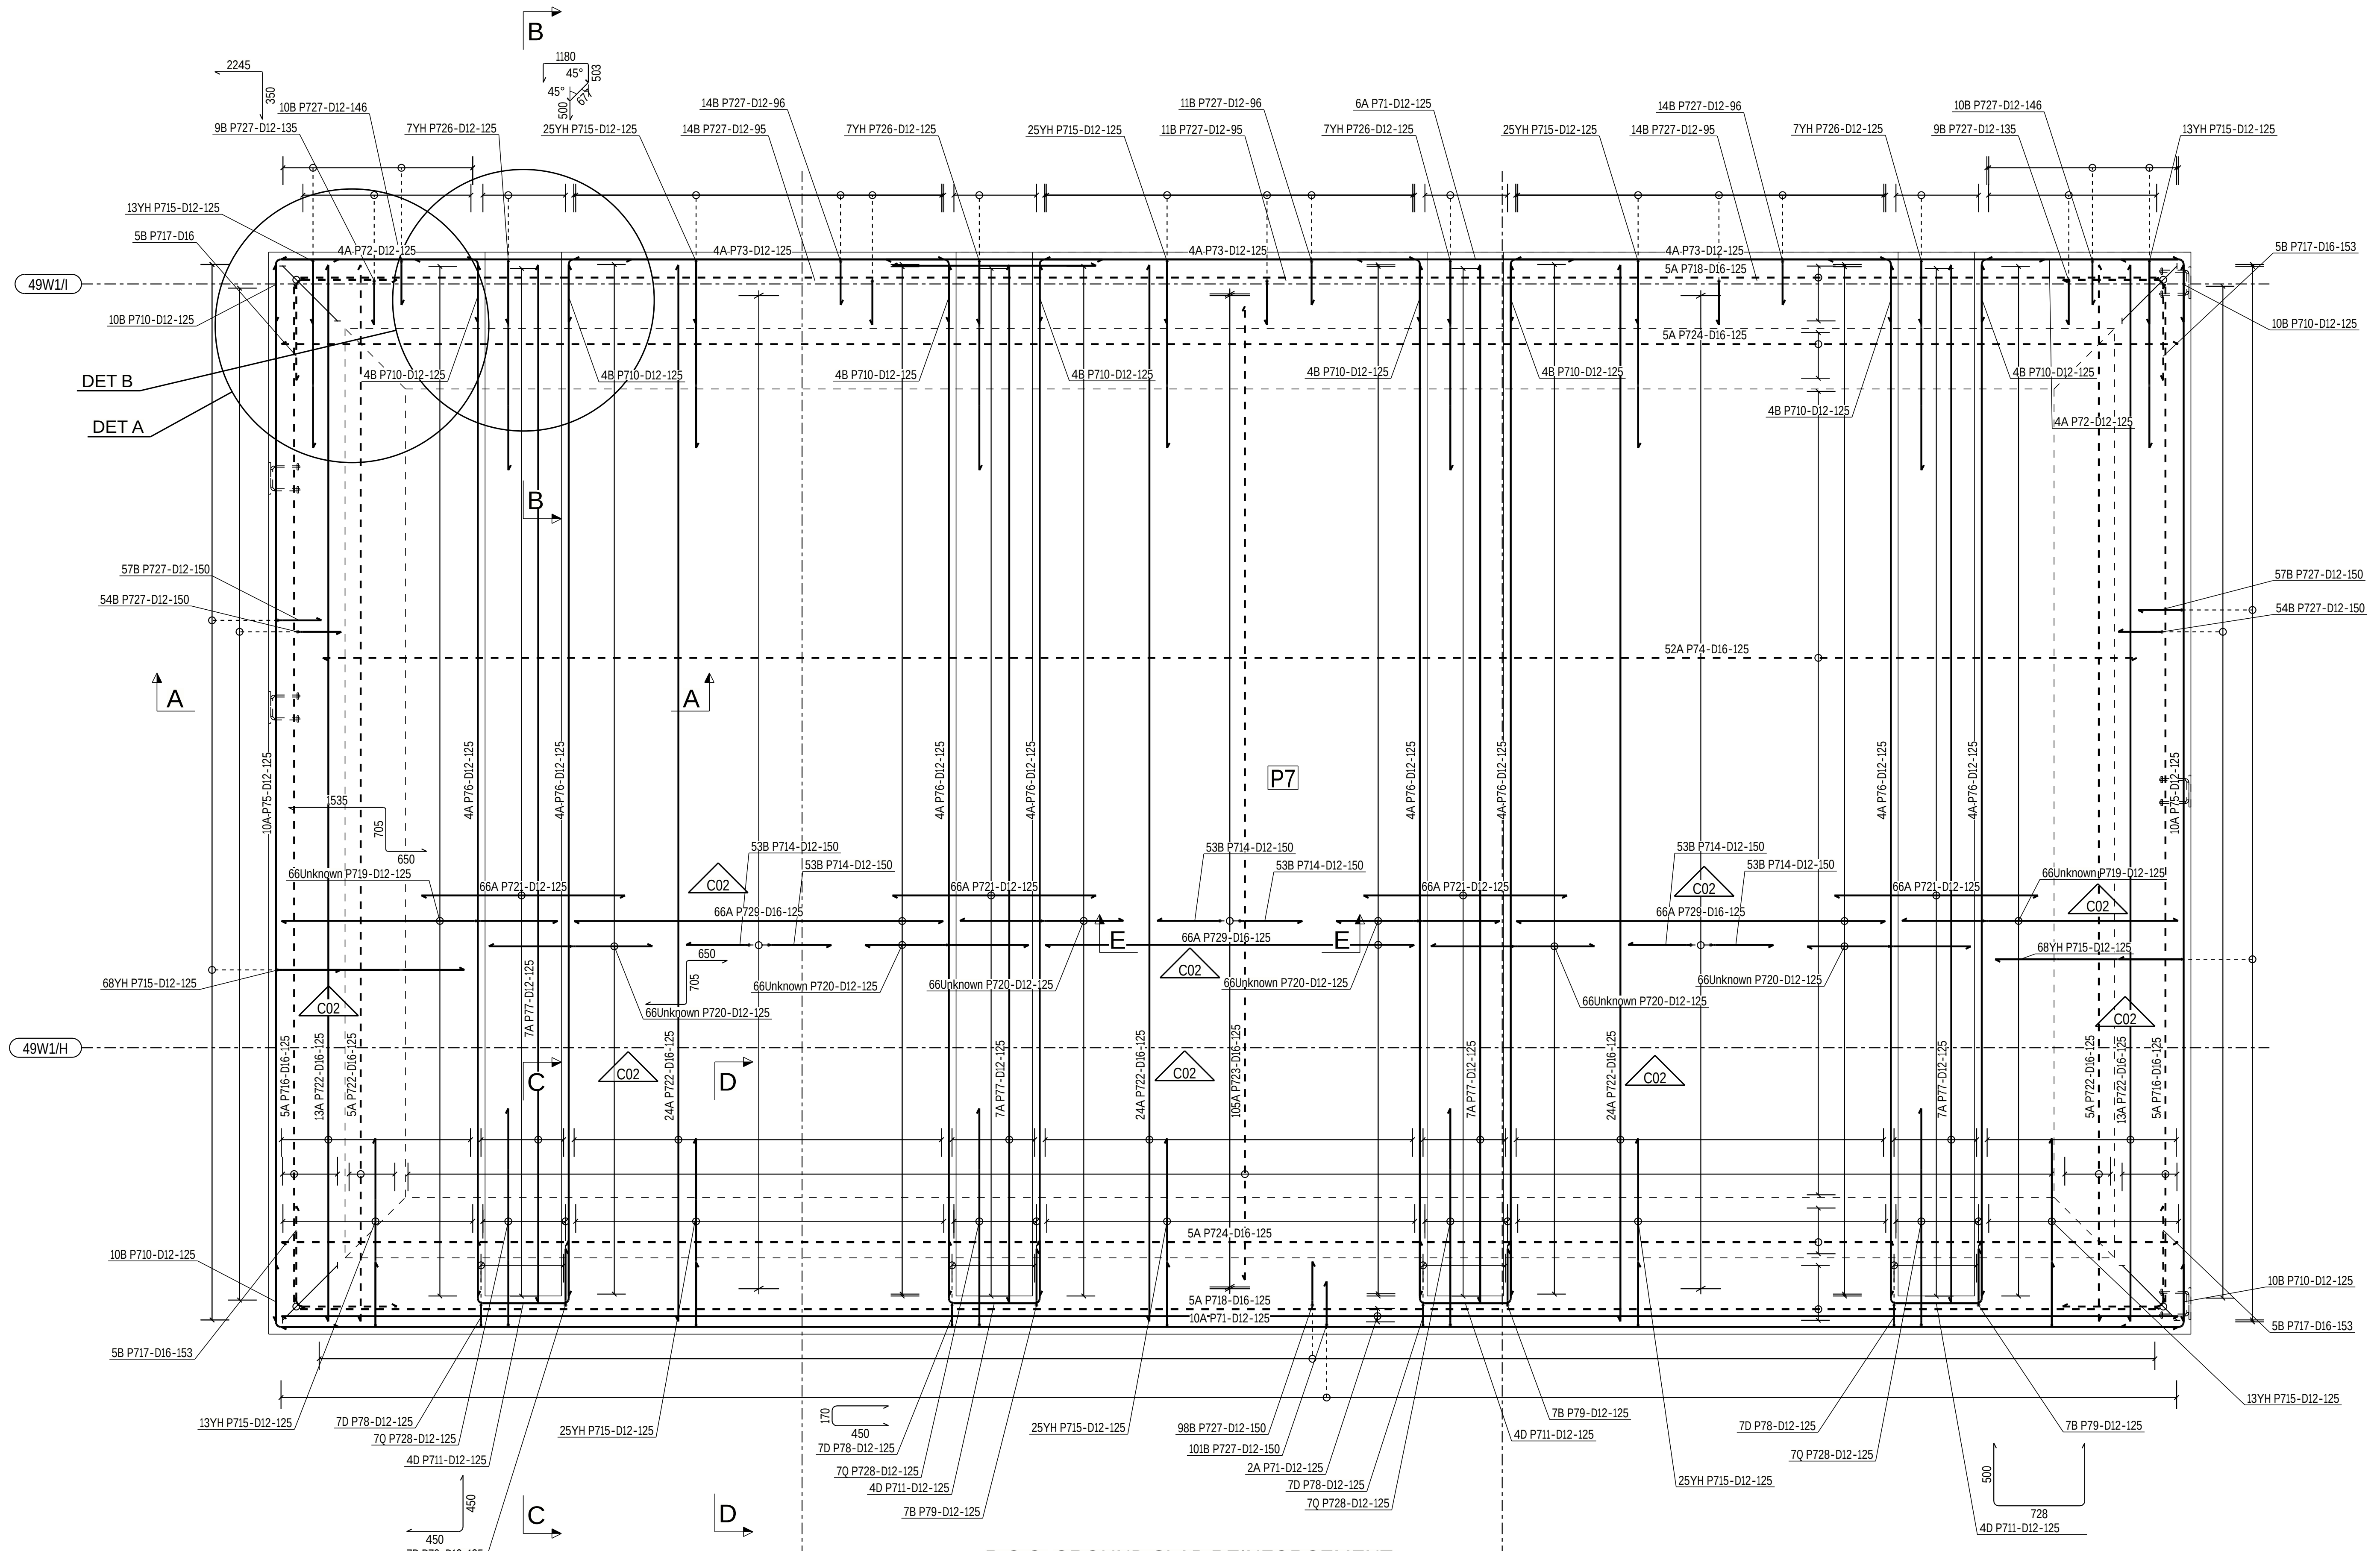

R.C.C. GROUND SLAB REINFORCEMENT

(SCALE 1:30)

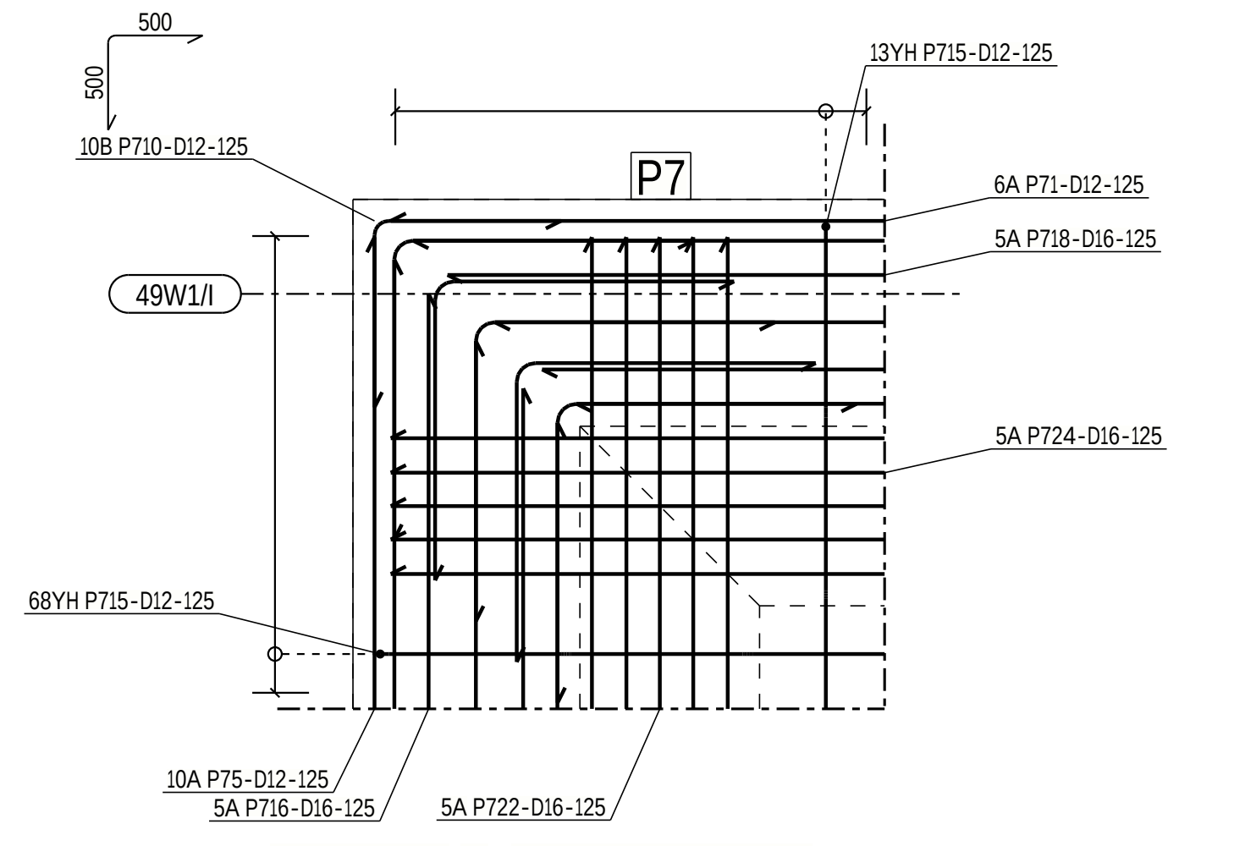

DETAIL : A BOTTOM BARS

(SCALE 1:20)

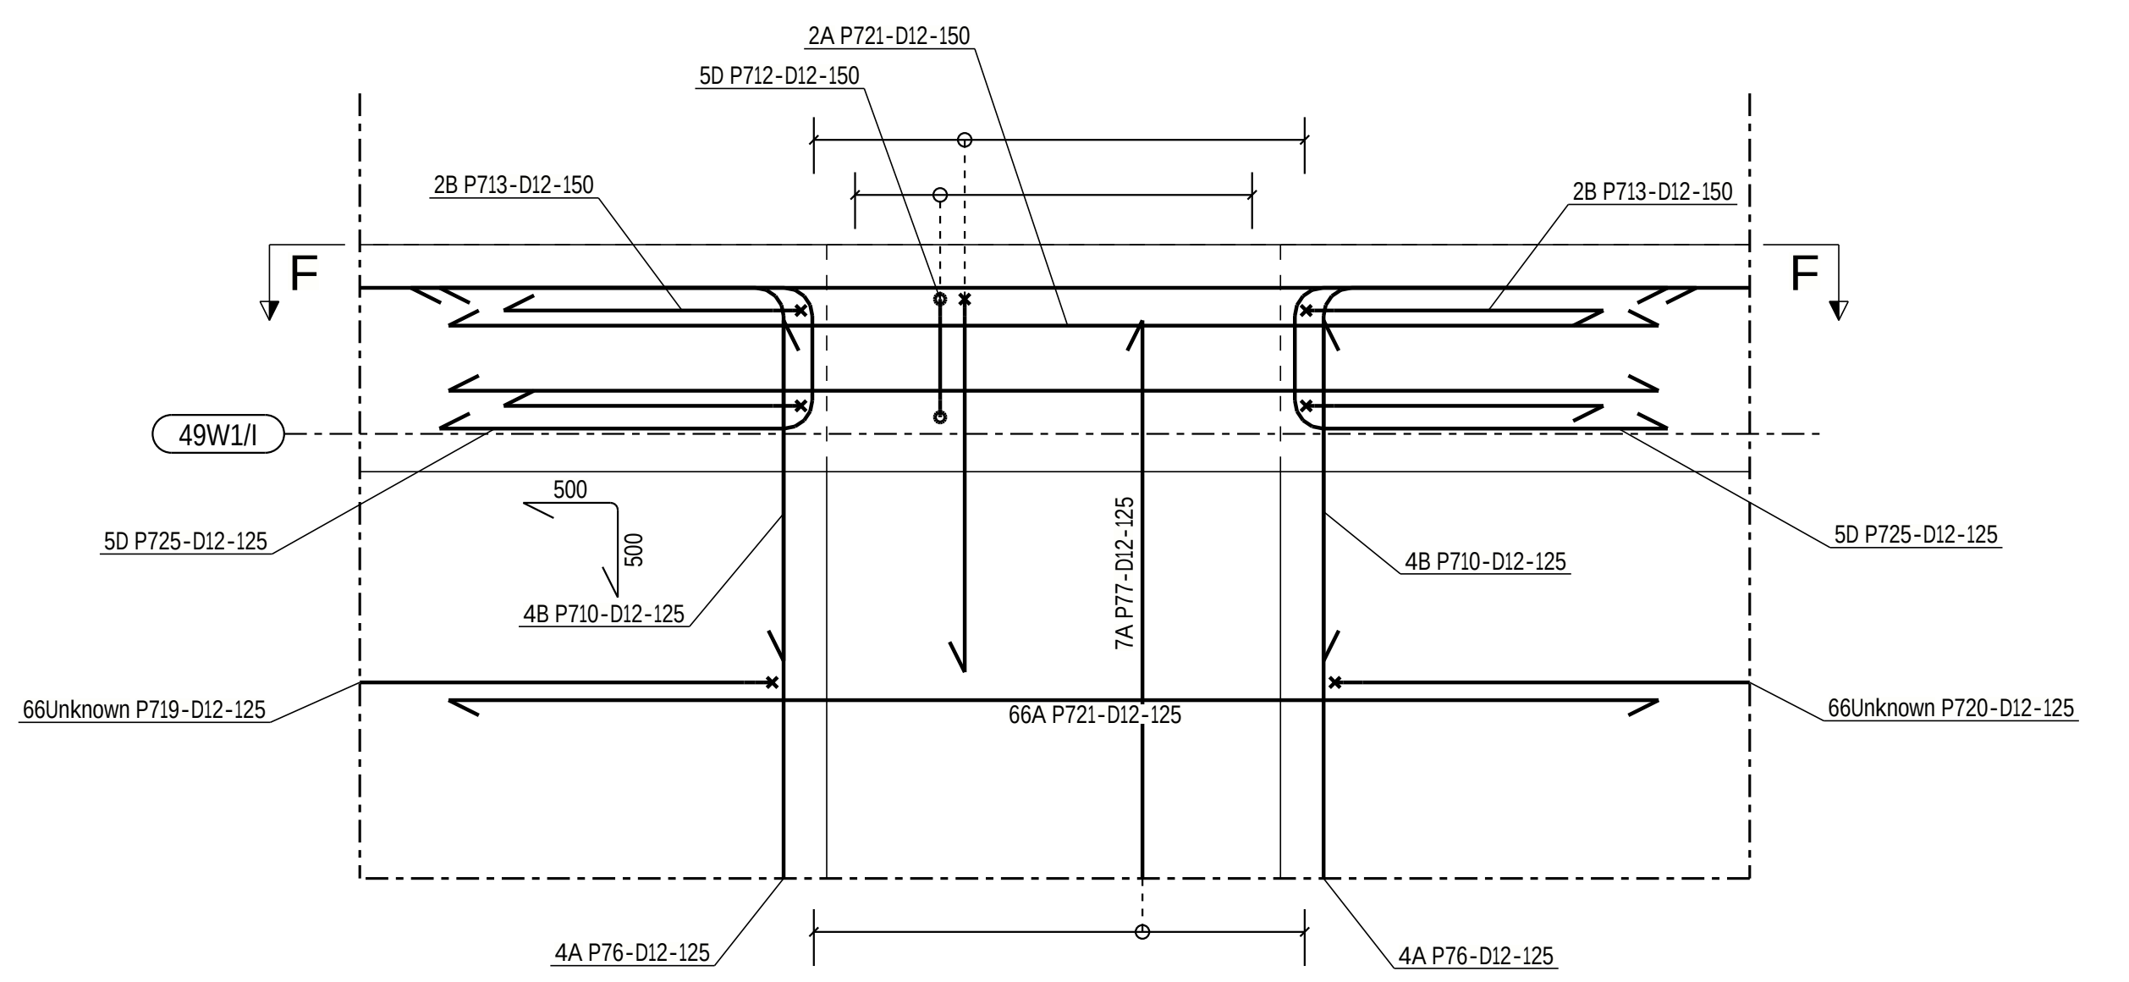

DETAIL : B REIFORCEMENT AROUND HOLE

(SCALE 1:10)

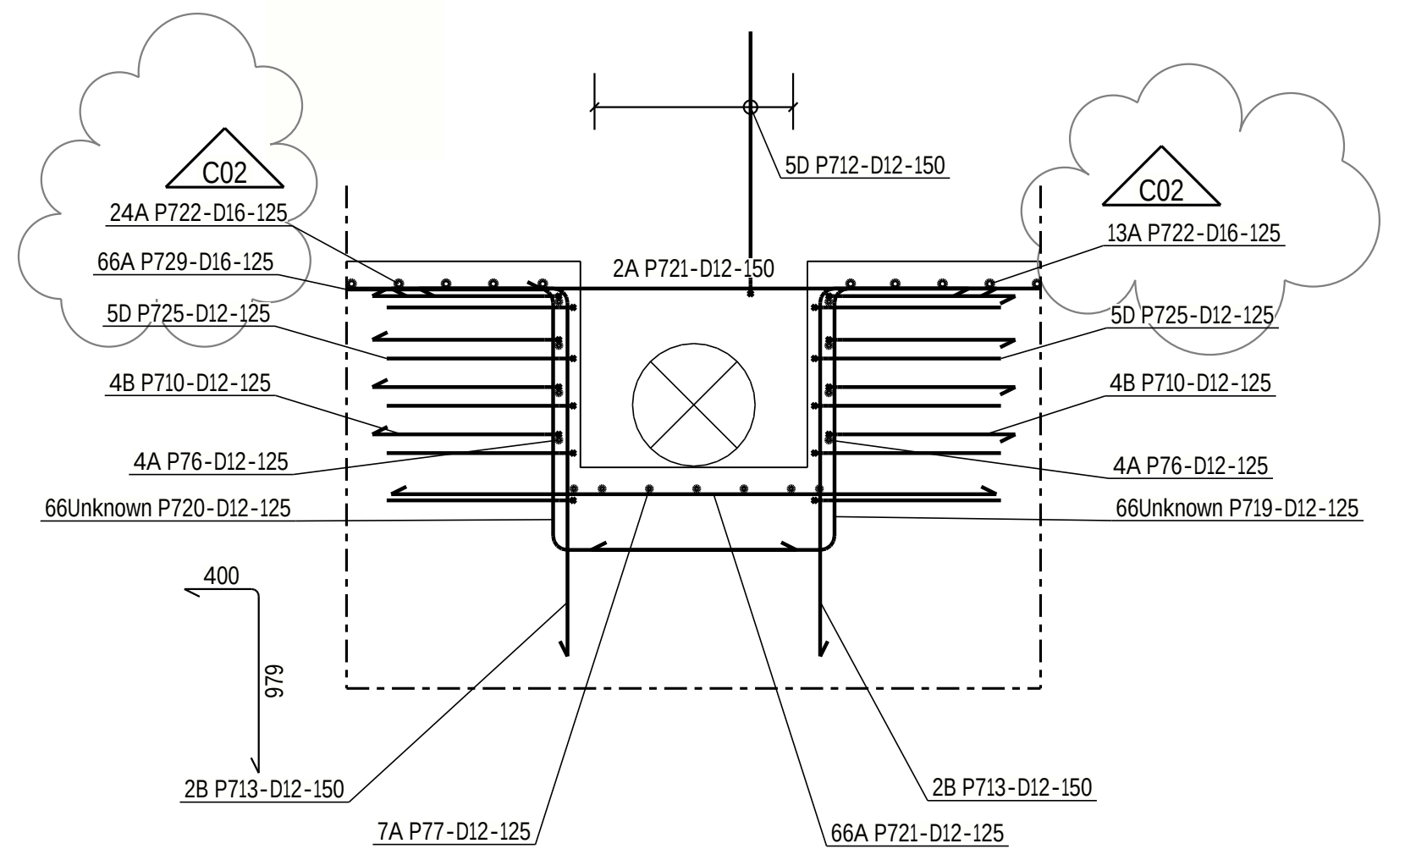

SECTION : F - F

(SCALE 1:20)

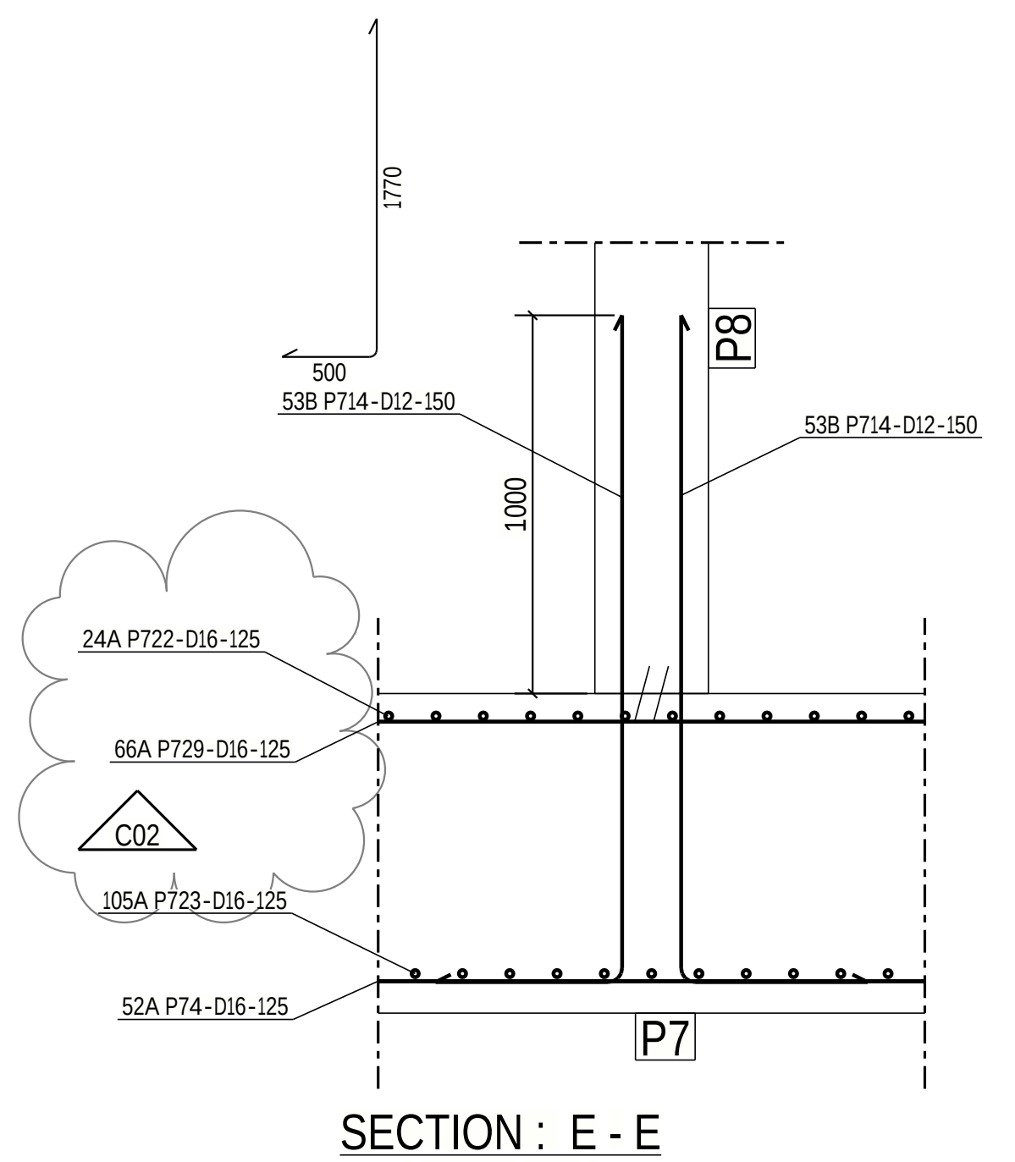

SECTION : E - E

(SCALE 1:20)

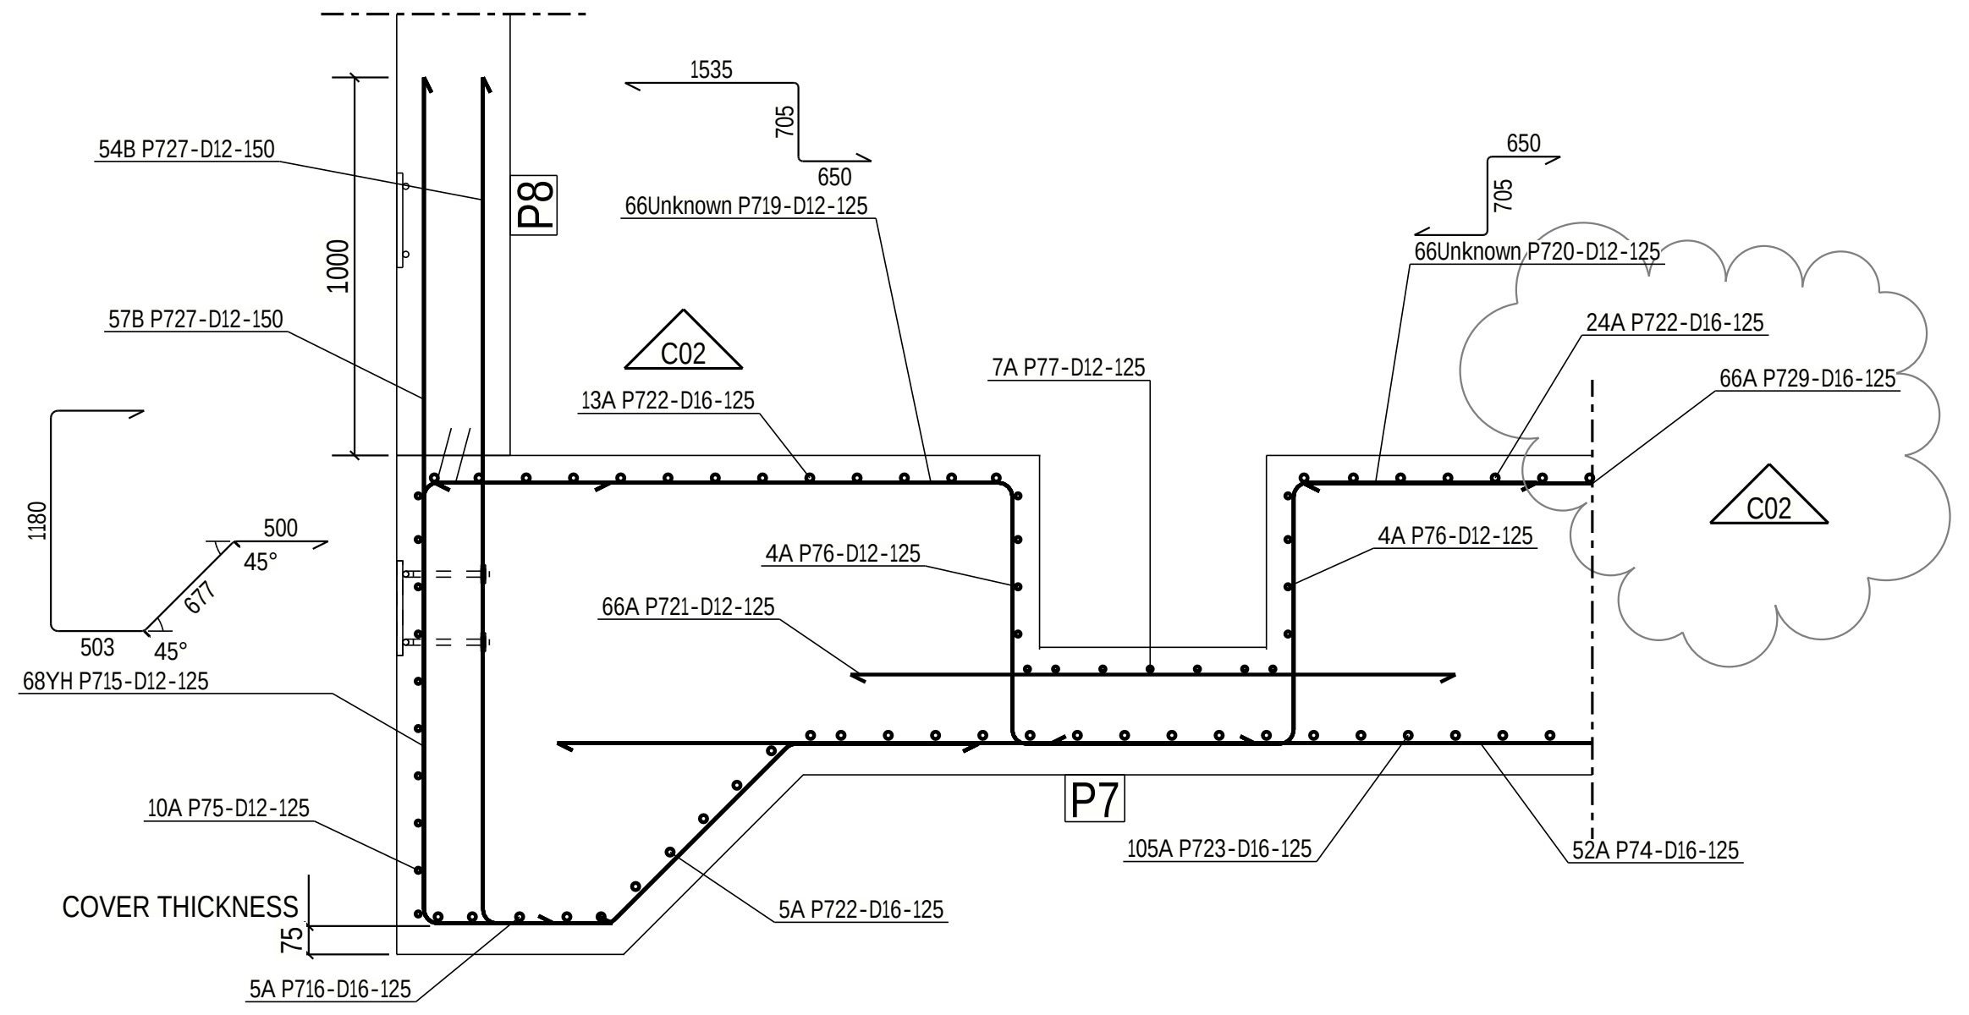

SECTION : A - A

(SCALE 1:20)

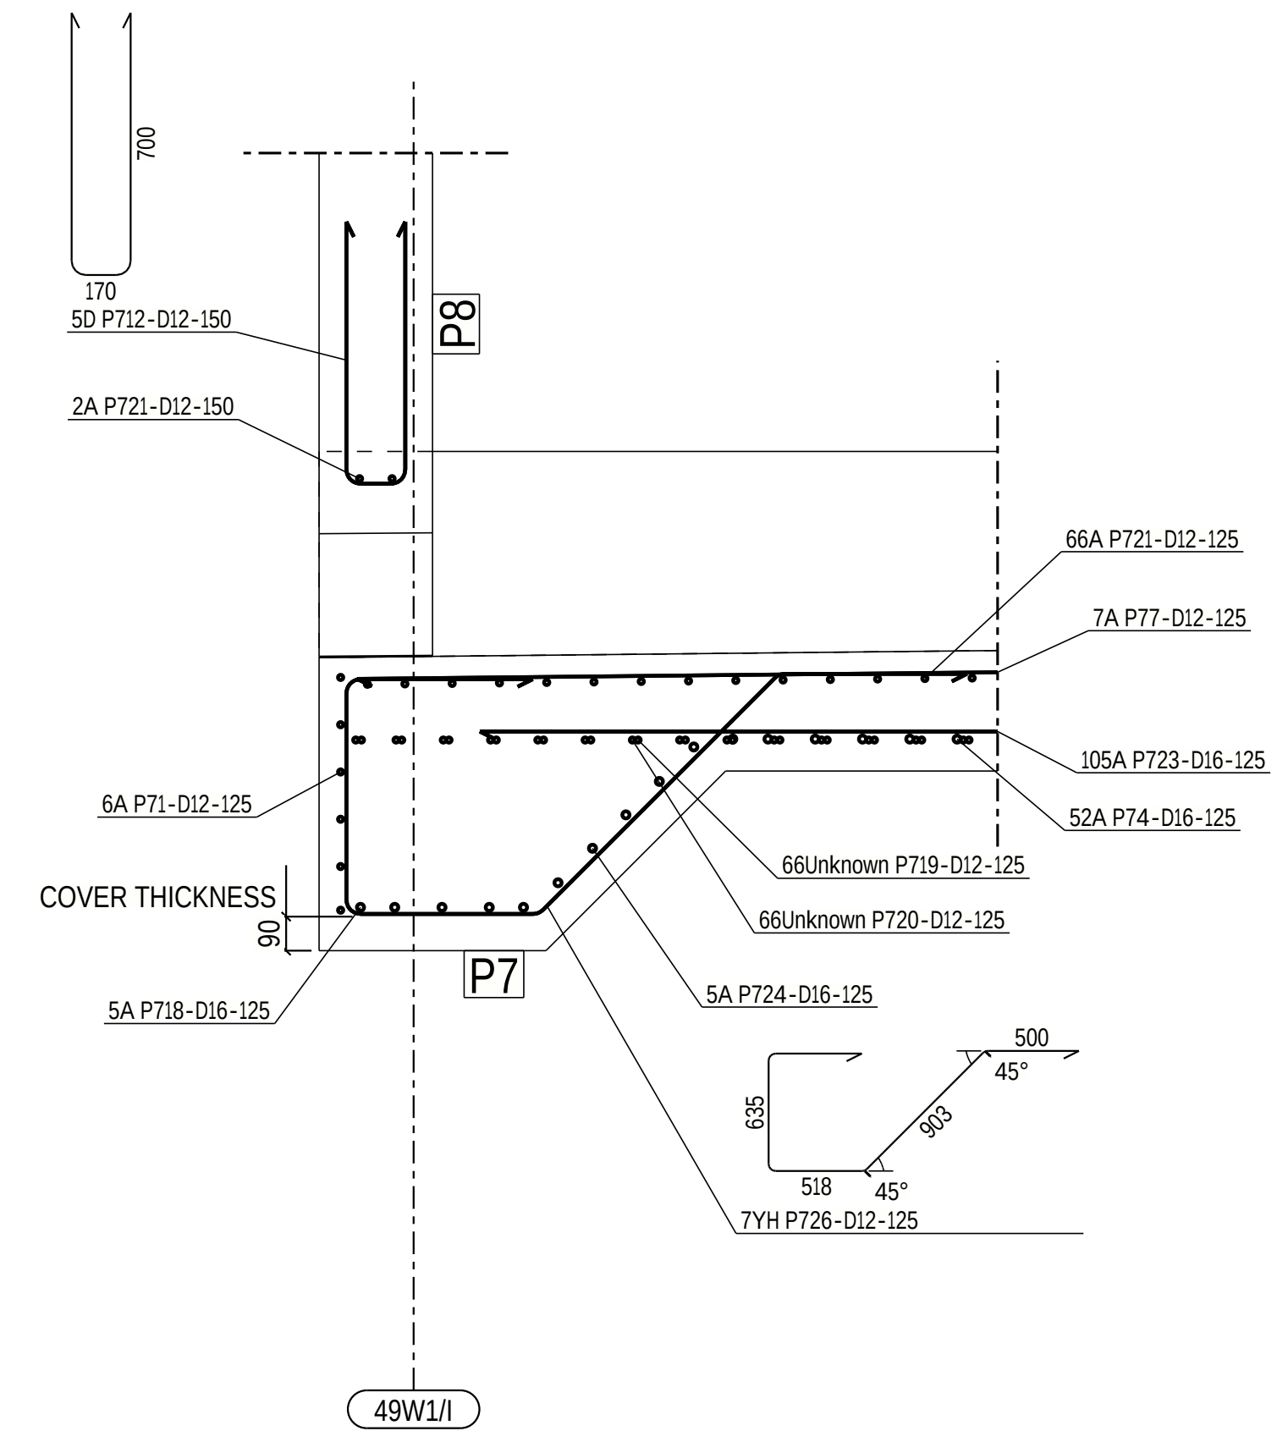

SECTION : B - B

(SCALE 1:20)

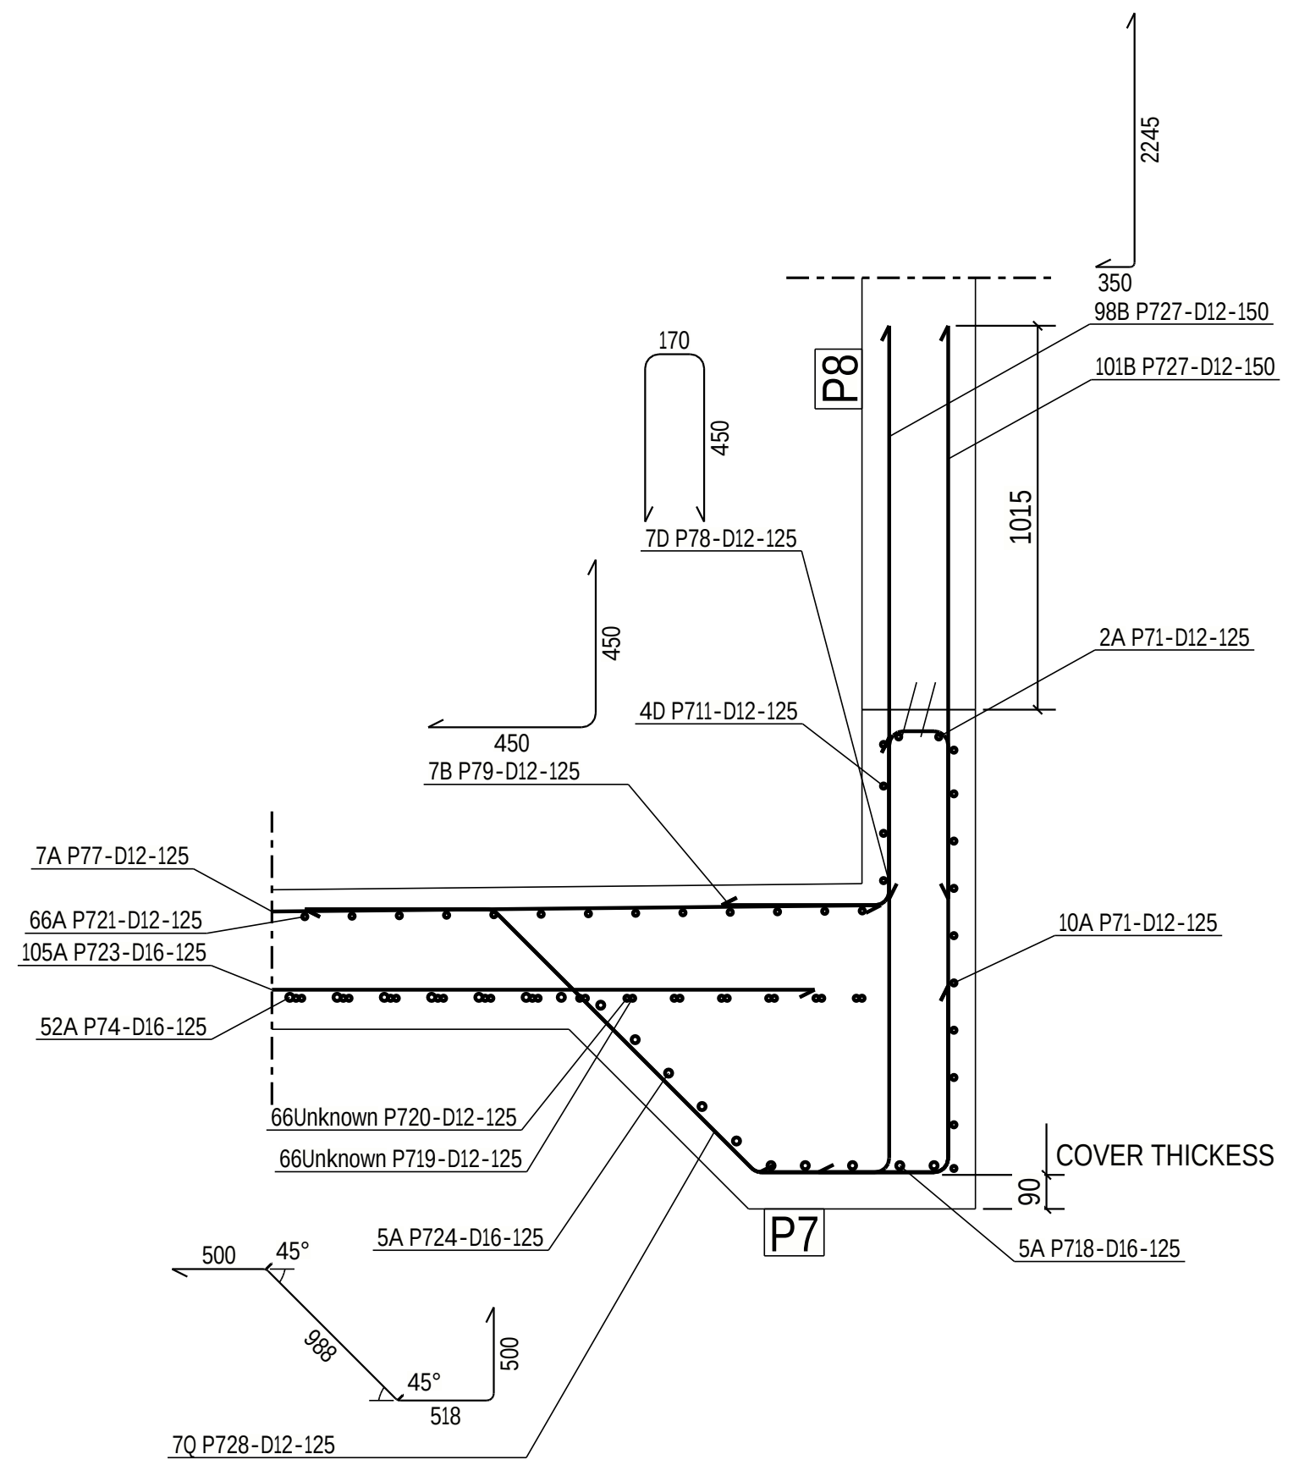

SECTION : C - C

(SCALE 1:20)

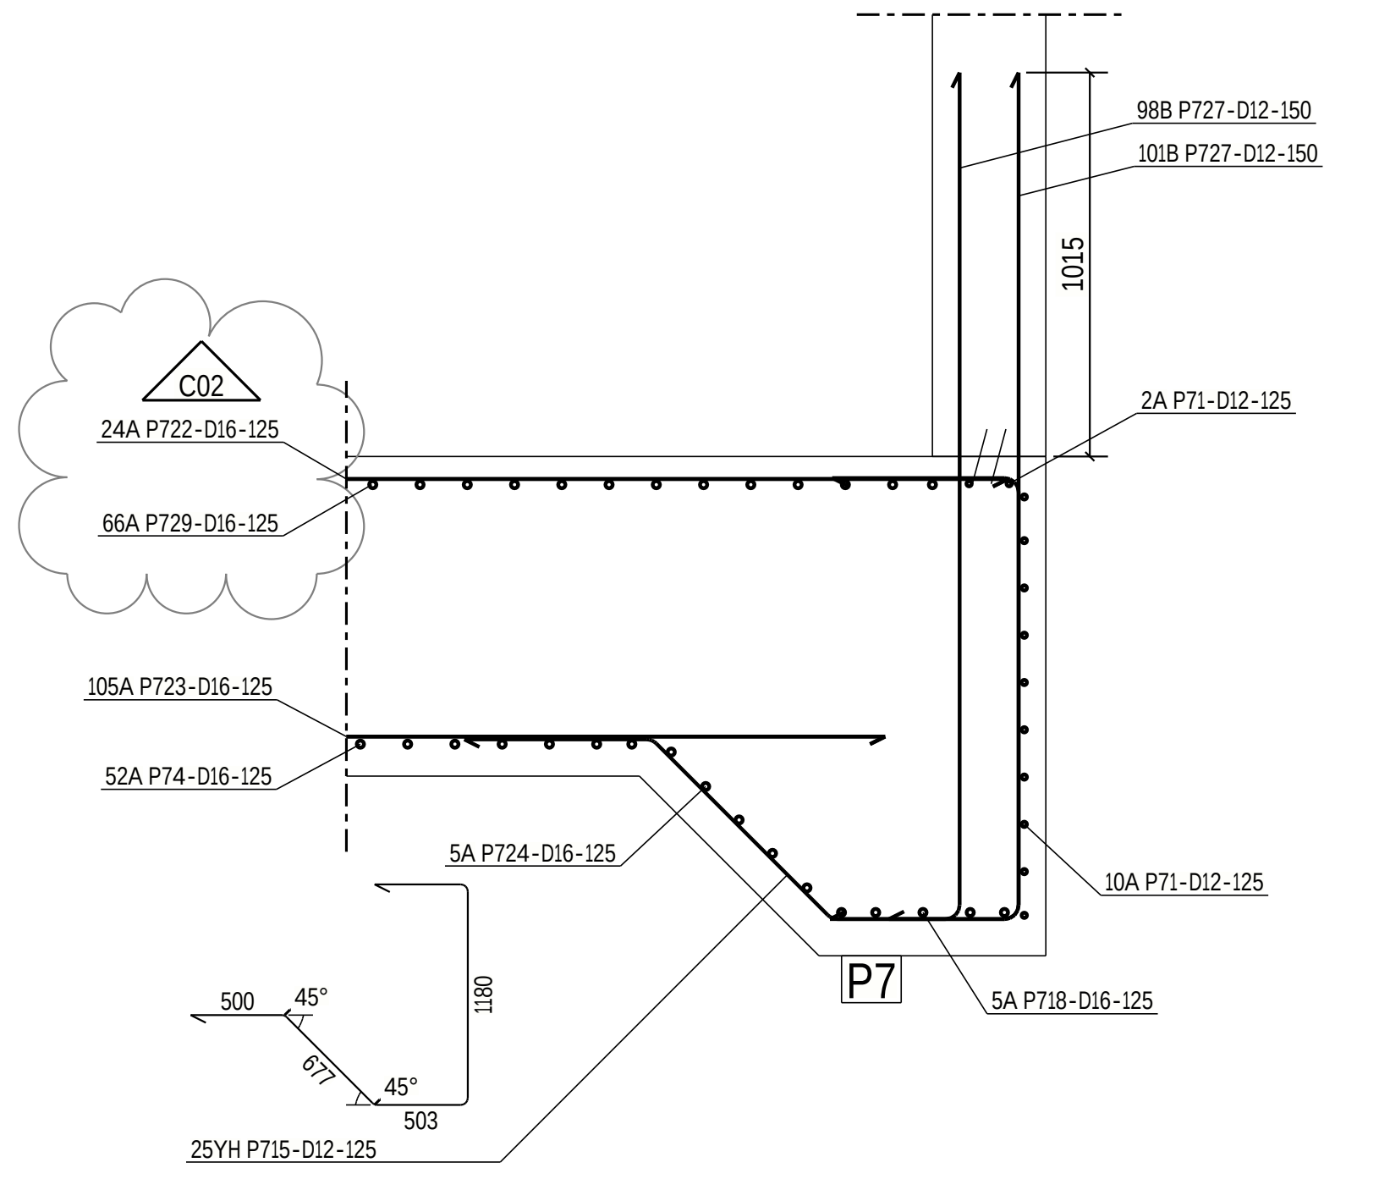

SECTION : D - D

(SCALE 1:20)

CONCRETE INFORMATION

Concretes used	C35	
Concrete cover 1	75±10mm	BOTTOM OF SLAB
Concrete cover 2	50±10mm	SIDES AND TOP OF SLAB

REINFORCING BAR LIST

CAST UNIT CODE: P7 PCS: 1

REINFORCING BARS TYPE	POS	PCS	GRADE	D [mm]	L [mm]	dL [mm]	WEIGHT SUM [kg]	a	b	c	d	e	u	v	x	TD	COMMENT
A	P71	18	B500B	12	14900		238.2	14900									
A	P72	8	B500B	12	1500		10.7	1500									
A	P73	12	B500B	12	2900		30.9	2900									
A	P74	52	B500B	16	14250		1170.8	14250									
A	P75	20	B500B	12	8300		147.4	8300									
A	P76	32	B500B	12	8100		230.2	8100									
A	P77	28	B500B	12	8150		202.7	8150									
D	P78	28	B500B	12	1010		25.1	450	170	450						60	
B	P79	28	B500B	12	870		21.6	450	450				90			60	
B	P710	72	B500B	12	970		62.0	500	500				90			60	
D	P711	16	B500B	12	1660		23.7	500	728	500						60	
D	P712	20	B500B	12	1510		26.8	700	170	700						60	
B	P713	16	B500B	12	1340		19.2	979	400				90			60	
B	P714	318	B500B	12	2240		632.6	1770	500				90			60	
YH	P715	338	B500B	12	3280		986.6	500	1180	503	677	500	45			60	
A	P716	10	B500B	16	8180		122.5	8181									
203	AT GROUP	5	PCS	...	7310	218	...	7319									
B	P717	20	B500B	16	1550		49.3	800	800				90			80	
A	P718	10	B500B	16	14780		226.7	14781									
6	AT GROUP	5	PCS	...	13910	218	...	13919									
**	P719	132	B500B	12	2830		331.7										
**	P720	396	B500B	12	1940		684.0										
A	P721	272	B500B	12	1600		386.5	1600									
A	P722	108	B500B	16	8300		1416.3	8300									
A	P723	105	B500B	16	7650		1269.1	7650									
A	P724	10	B500B	16	14900		235.4	14900									
D	P725	40	B500B	12	1140		40.5	500	200	500						60	
YH	P726	28	B500B	12	2980		74.2	500	635	518	903	500	45			60	
B	P727	537	B500B	12	2560		1223.2	350	2245				90			60	
Q	P728	28	B500B	12	2460		61.2	456	456	952	481		45		709	60	
A	P729	198	B500B	16	2900		907.2	2900									

REINFORCING BAR TOTAL WEIGHT [kg] 10856.2

REINFORCEMENT BENDING SHAPES:

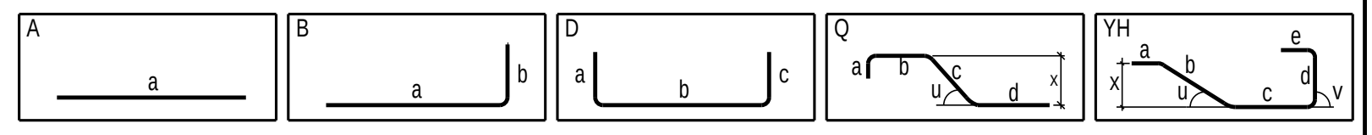

LEGEND:

R.L. - REDUCED LEVEL
T.O.C. - TOP OF CONCRETE
B.O.F. - BOTTOM OF FOUNDATION
F.G.L. - FINISHED GROUND LEVEL
P.C.C. - PLAIN CEMENT CONCRETE
TYP - TYPICAL
MKD - MARKED
CL - CENTER LINE
BOTTOM REINF. (B)
TOP REINF. (T)
SBC - SAFE BEARING CAPACITY
MIN. - MINIMUM
REF. - REFERED
GA - GENERAL ARRANGEMENT
DWG. - DRAWING
R.C.C. - REINFORCED CEMENT CONCRETE

NOTES:

1. ALL DIMENSIONS ARE IN MILLIMETRES AND LEVELS ARE IN METRES UNLESS OTHERWISE STATED
2. GRADE OF CONCRETE SHALL BE C35 (35MPa) UNLESS NOTED OTHERWISE & C15 (15MPa) FOR BLINDING CONCRETE.
3. GRADE OF REINFORCEMENT SHALL BE DEFORMED BAR ASTM A615-GRADE 60 (fy=420MPa)
4. CLEAR COVER TO MAIN REINFORCEMENT SHALL BE AS FOLLOWS:
a) FOUNDATION: 75 mm (BOTTOM & SIDE)
b) FOUNDATION: 50 mm (TOP)
c) COLUMN & PEDESTAL: 50 mm
5. MINIMUM LAP LENGTHS OF REINFORCEMENT SHALL BE 40XBAR DIAMETER
6. FOR STANDARD REINFORCEMENT DETAILS & GENERAL NOTES FOR CIVIL WORKS REFER TO DRAWING NUMBER MD-216-1000-EG-CV-DED-1005 & 1001
7. ANCHOR BOLTS AND EMBEDDED STEELWORK SHALL BE HOT DIP GALVANIZED
8. T.O.C. & TOP OF SCREED TOLERANCE SHALL BE WITHIN +/- 10MM OF DESIGN LEVEL
9. NET SAFE BEARING CAPACITY OF SOIL AT BOTTOM OF FOUNDATION IS CONSIDERED AS 375 KN/SQ.M.
10. REBARS CAN BE MOVED LOCALLY BY +/- 25mm TO AVOID INTERFERENCE WITH EMBEDDED PARTS

C01

KEYPLAN

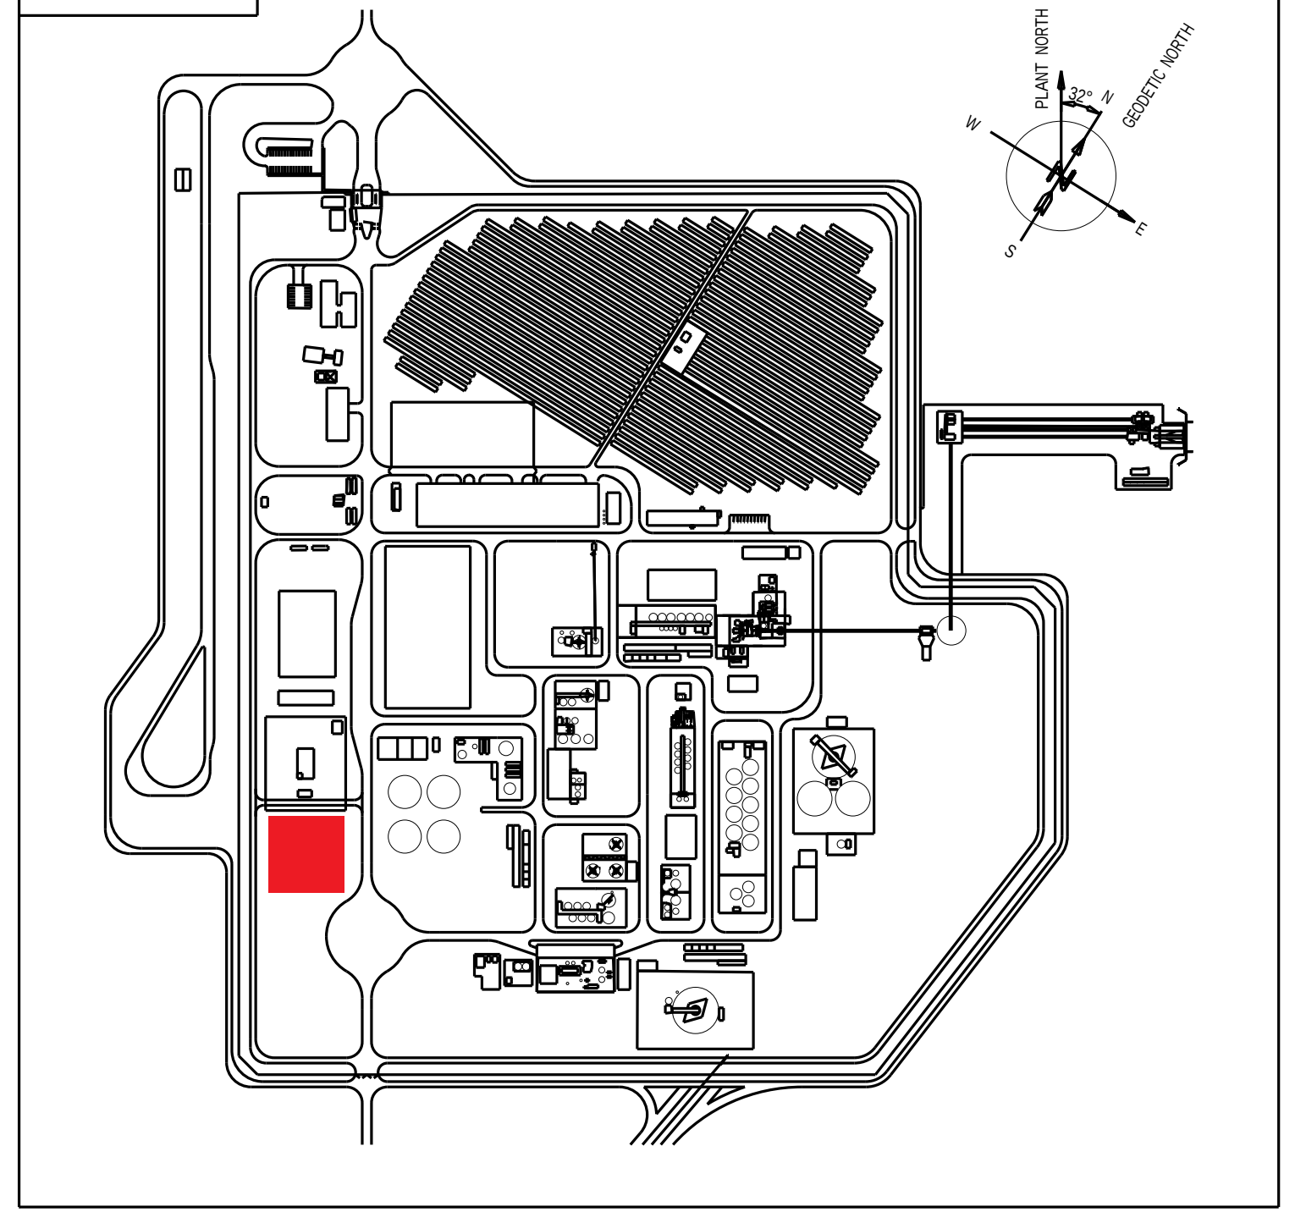

DOCUMENT NUMBER	REFERENCE DOCUMENTS	DOCUMENT NUMBER	REFERENCE DOCUMENTS
MD-216-1000-EG-ST-CRT-1001	DESIGN CRITERIA	MD-216-49W1-EG-ME-GAD-1022	CONCRETE EMBEDDED PARTS OUTLINE DRAWING
MD-216-49W1-EG-CV-DED-1005	SAND FILTER WALLS REINFORCEMENT DRAWING	MD-216-49W1-EG-CV-CAL-1002	SAND FILTER AND DISTRIBUTION BOX CALCULATION REPORT
MD-216-49W1-EG-CV-GAD-1003	1-10/A-E GENERAL ARRANGEMENT DRAWING	MD-216-49W1-EG-CV-DED-1003	SAND FILTER AND DISTRIBUTION BOX DIMENSIONAL DRAWING
MD-216-49W1-EG-CV-GAD-1001	1-8/E-J GENERAL ARRANGEMENT DRAWING	MD-216-49W1-EG-CV-GAD-1002	7-12/D-J GENERAL ARRANGEMENT DRAWING

REV	DATE	REVISION DESCRIPTION	DRN	CHK	ENG	APP	EMP
D01	29.01.2024	AS-BUILT	JonRen	MauNot	NanWu	LuiPiz	
C02	11.01.2022	TOP BARS DIAMETER CHANGED, D12 TO D16	JonRen	MauNot	NanWu	LuiPiz	
C01	03.01.2022	ISSUED FOR CONSTRUCTION	JonRen	MauNot	NanWu	LuiPiz	
A01	19.11.2021	ISSUED FOR APPROVAL	JonRen	MauNot	NanWu	LuiPiz	

REV	DATE	REVISION DESCRIPTION	DRN	CHK	ENG	APP	EMP

RESERVED FOR VENDOR LOGO AND DRAWING NUMBER

LARSEN & TOUBRO

This drawing is the property of LARSEN & TOUBRO and must not be passed on to any person or body not authorized by us to recieve it or be copied or otherwise made use either in full or in part by such person or body without our prior permission in writing.

Outotec

The content of these documents are the sole property of Outotec Oyj. Any rights not expressly granted herein are reserved. Reproduction, transfer or distribution of part or all of the contents in any form without prior written permission of Outotec is prohibited.

MA'ADEN معادن
Saudi Arabian Mining Company شركة التعدين العربية السعودية

This document and the information contained herein is Ma'aden proprietary know-how. This document or any part thereof should not be reproduced, stored in a retrieval system or transmitted by any means, electronic or otherwise, or divulged without prior written permission of Ma'aden.

LARSEN & TOUBRO DRAWING NUMBER	O19045_080_C_D_24892_004	REVISION 3
OUTOTEC DRAWING NUMBER	900707_GAU01_AG11_CTB01_49004	
DOCUMENT ID	OU100732636	REVISION 3

DRAWN	JonRen	19.11.2021
CHECKED	MauNot	19.11.2021
ENGINEER	NanWu	19.11.2021
APPROVED	LuiPiz	19.11.2021
EMPLOYER		
SCALE		A0

MANSOURAH - MASSARAH GOLD PROJECT
49W1 RAW WATER TREATMENT PLANT
SAND FILTER BOTTOM SLAB
REINFORCEMENT DRAWING

DRAWING NUMBER MD-216-49W1-EG-CV-DED-1004
REV D01

Tekla Structures