


DRAWING NUMBER: MD-216-49WI-EG-CV-DED-1005 | REV: D01

R.C.C. WALL REINFORCEMENT
(SCALE 1:30)

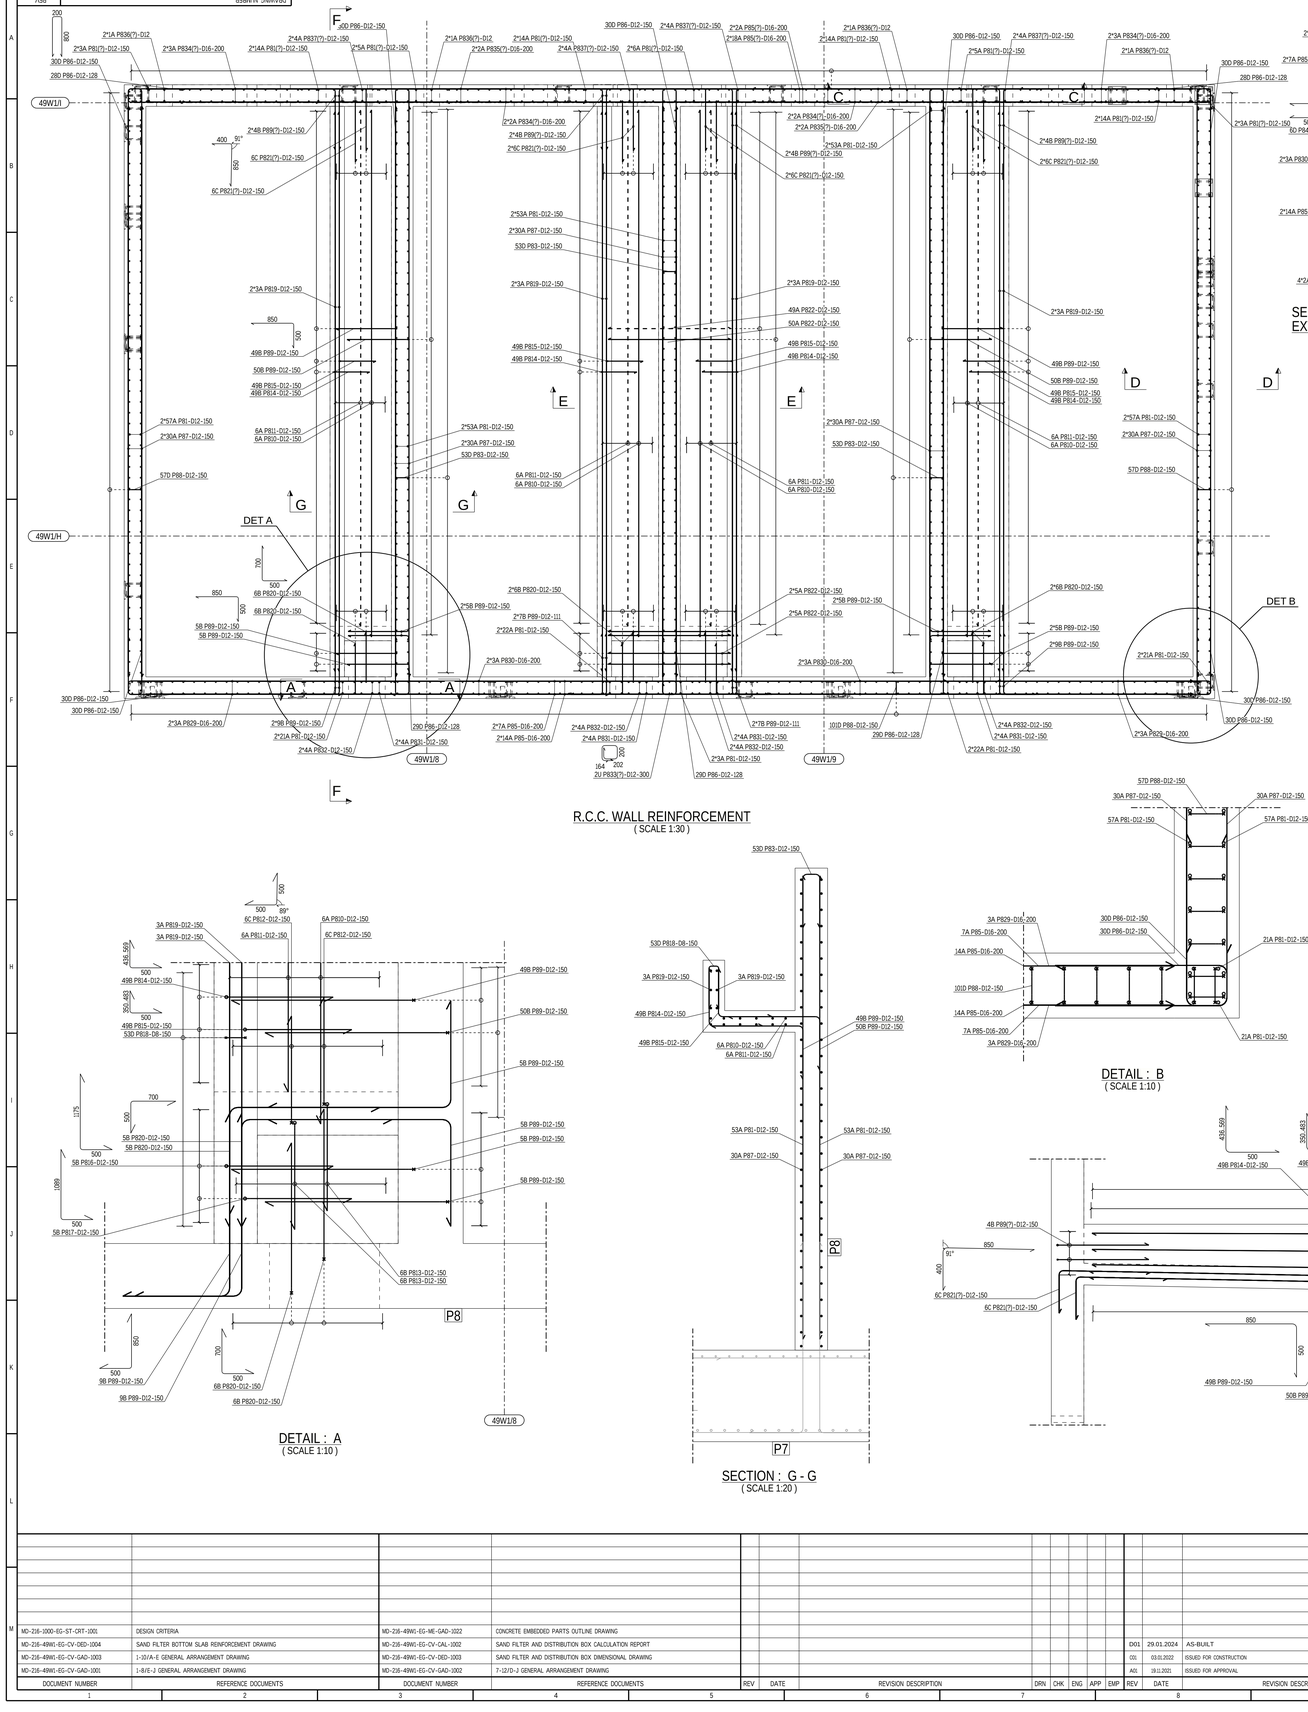


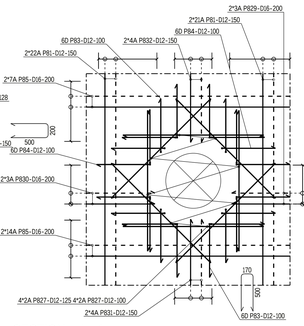

SECTION : A - A
EXTRA REINFORCEMENT AROUND Ø508 HOLES
(SCALE 1:20)

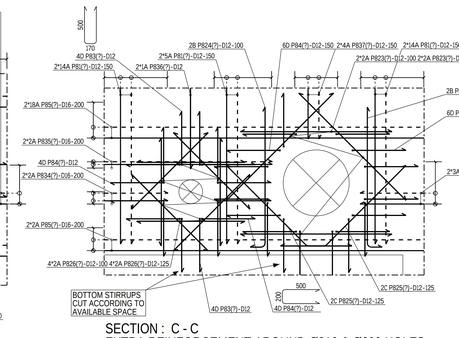

SECTION : C - C
EXTRA REINFORCEMENT AROUND Ø219 & Ø609 HOLES
(SCALE 1:20)

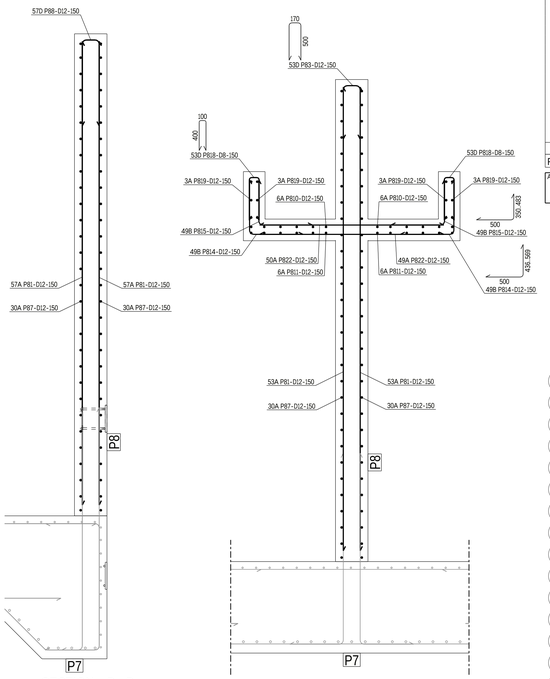


SECTION : D - D
(SCALE 1:20)

SECTION : E - E
(SCALE 1:20)

DETAIL : A
(SCALE 1:10)

SECTION : G - G
(SCALE 1:20)

DETAIL : B
(SCALE 1:10)

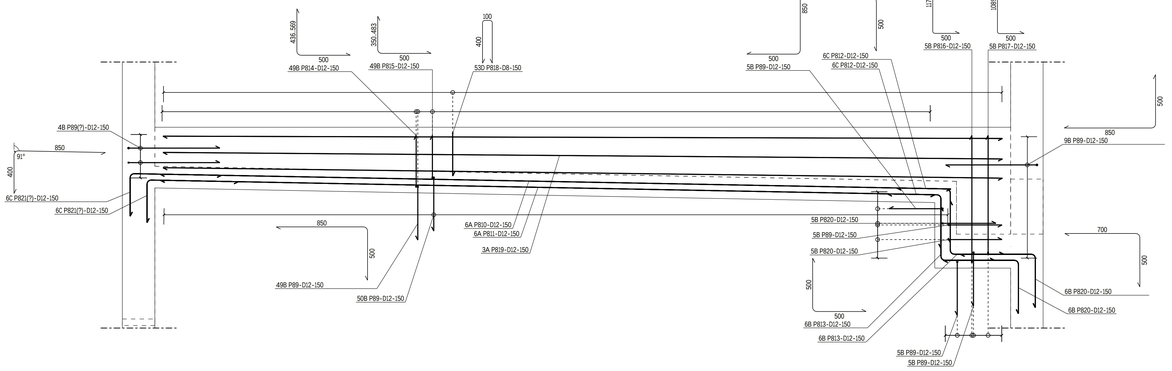

SECTION : F - F
(SCALE 1:20)

CONCRETE INFORMATION

Concretes used	C35
Concrete cover 1	50x10mm

REINFORCING BAR LIST

CAST UNIT CODE: P8 | PCS: 1

REINFORCING BARS TYPE	POS	PCS	GRADE	D [mm]	L [mm]	dL [mm]	WEIGHT SUM [kg]	BENDING DIMENSIONS [mm] a	b	c	d	e	u	v	x	TD	COMMENT
A	P81	724	B500B	12	4280		2751.7	4280									
A	P81(7)	156	B500B	12	4280		592.9	4280									
D	P83(7)	8	B500B	12	640		4.5	250	200	250						60	
D	P83	207	B500B	12	1110		204.1	500	170	500						60	
D	P83(7)	80	B500B	12	1110		78.9	500	170	500						60	
D	P84	44	B500B	12	1140		44.5	500	200	500						60	
D	P84(7)	72	B500B	12	1140		72.9	500	200	500						60	
A	P85	42	B500B	16	14500		962.2	14500									
A	P85(7)	40	B500B	16	14500		916.4	14500									
D	P86	413	B500B	12	1740		638.2	800	200	800						60	
A	P87	300	B500B	12	7900		2104.6	7900									
D	P88	215	B500B	12	1710		326.5	800	170	800						60	
D	P88(7)	101	B500B	12	1710		153.4	800	170	800						60	
B	P89	302	B500B	12	1320		354.0	850	500						90	60	
B	P89(7)	32	B500B	12	1320		37.5	850	500						90	60	
A	P810	24	B500B	12	7300		155.6	7301									
A	P811	24	B500B	12	7150		152.4	7151									
C	P812	48	B500B	12	970		41.4	500	500				89			60	
B	P813	48	B500B	12	970		41.3	500	500				90			60	
B	P814	196	B500B	12	1030		169.3	569	500				90			60	
62	AT GROUP	49	PCS	...	900	3	436	500					90				
B	P815	196	B500B	12	950		153.3	483	500				90			60	
4	AT GROUP	49	PCS	...	820	3	350	500					90				
B	P816	20	B500B	12	1640		29.2	1175	500				90			60	
B	P817	20	B500B	12	1550		27.7	1089	500				90			60	
D	P818	212	B500B	8	860		72.2	400	100	400						32	
A	P819	24	B500B	12	7750		165.2	7750									
B	P820	88	B500B	12	1170		91.4	500	700				90			60	
C	P821(7)	48	B500B	12	1220		52.0	850	400				91			60	
A	P822	119	B500B	12	1700		179.6	1700									
A	P823(7)	32	B500B	12	1400		39.8	1400									
B	P824(7)	16	B500B	12	1410		20.1	1300	144				90			60	
C	P825(7)	16	B500B	12	1460		20.8	1054	418				45			60	
A	P826(7)	64	B500B	12	1000		56.8	1000									
A	P827	56	B500B	12	1300		64.6	1300									
C	P828	8	B500B	12	1310		9.3	418	904				45			60	
A	P829	12	B500B	16	2700		51.3	2706									
A	P830	12	B500B	16	2990		56.7	2992									
A	P831	32	B500B	12	2410		68.6	2413									
A	P832	32	B500B	12	1150		32.9	1158									
U	P833(7)	2	B500B	12	980		1.7	164	202	200	202	200				60	
A	P834(7)	20	B500B	16	1920		60.9	1928									
A	P835(7)	8	B500B	16	2890		36.5	2891									
A	P836(7)	8	B500B	16	3580		25.5	3587									
A	P837(7)	32	B500B	12	3310		94.1	3310									

REINFORCING BAR TOTAL WEIGHT [kg] 11213.9

REINFORCEMENT BENDING SHAPES:



LEGEND:


R.L. - REDUCED LEVEL
T.O.C. - TOP OF CONCRETE
B.O.F. - BOTTOM OF FOUNDATION
F.G.L. - FINISHED GROUND LEVEL
P.C.C. - PLAIN CEMENT CONCRETE
TYP - TYPICAL
MKD - MARKED
CL - CENTER LINE
BOTTOM REINF. (B)
TOP REINF. (T)
SBC - SAFE BEARING CAPACITY
MIN. - MINIMUM
REF. - REFERED
GA - GENERAL ARRANGEMENT
DWG. - DRAWING
R.C.C. - REINFORCED CEMENT CONCRETE

NOTES:

1. ALL DIMENSIONS ARE IN MILLIMETRES AND LEVELS ARE IN METRES UNLESS OTHERWISE STATED
2. GRADE OF CONCRETE SHALL BE C35 (35MPa) UNLESS NOTED OTHERWISE & C15 (15MPa) FOR BLINDING CONCRETE.
3. GRADE OF REINFORCEMENT SHALL BE DEFORMED BAR ASTM A615-GRADE 60 (fy=420MPa)
4. CLEAR COVER TO MAIN REINFORCEMENT SHALL BE AS FOLLOWS:
   a) FOUNDATION: 75 mm (BOTTOM & SIDE)
   b) FOUNDATION: 50 mm (TOP)
   c) COLUMN & PEDESTAL: 50 mm
5. MINIMUM LAP LENGTHS OF REINFORCEMENT SHALL BE 40XBAR DIAMETER
6. FOR STANDARD REINFORCEMENT DETAILS & GENERAL NOTES FOR CIVIL WORKS REFER TO DRAWING NUMBER MD-216-1000-EG-CV-DED-1005 & 1001
7. ANCHOR BOLTS AND EMBEDDED STEELWORK SHALL BE HOT DEEP GALVANIZED
8. T.O.C. & TOP OF SCREED TOLERANCE SHALL BE WITHIN +/- 10MM OF DESIGN LEVEL
9. NET SAFE BEARING CAPACITY OF SOIL AT BOTTOM OF FOUNDATION IS CONSIDERED AS 375 KN/SQ.M
10. REBARS CAN BE MOVED LOCALLY BY +/- 25mm TO AVOID INTERFERENCE WITH EMBEDDED PARTS

C01

KEYPLAN

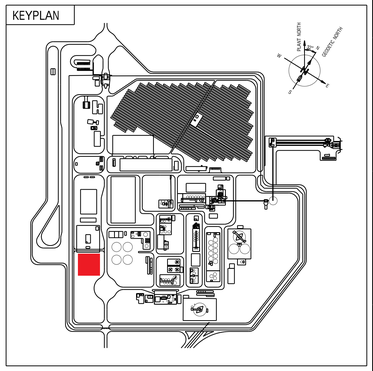

DOCUMENT NUMBER	REFERENCE DOCUMENTS	DOCUMENT NUMBER	REFERENCE DOCUMENTS
MD-216-1000-EG-ST-CRT-1001	DESIGN CRITERIA	MD-216-49WI-EG-ME-GAD-1022	CONCRETE EMBEDDED PARTS OUTLINE DRAWING
MD-216-49WI-EG-CV-DED-1004	SAND FILTER BOTTOM SLAB REINFORCEMENT DRAWING	MD-216-49WI-EG-CV-CAL-1002	SAND FILTER AND DISTRIBUTION BOX CALCULATION REPORT
MD-216-49WI-EG-CV-GAD-1003	1-J/I-A-E GENERAL ARRANGEMENT DRAWING	MD-216-49WI-EG-CV-DED-1003	SAND FILTER AND DISTRIBUTION BOX DIMENSIONAL DRAWING
MD-216-49WI-EG-CV-GAD-1001	1-8/E-J GENERAL ARRANGEMENT DRAWING	MD-216-49WI-EG-CV-GAD-1002	7-12/D-J GENERAL ARRANGEMENT DRAWING

REV	DATE	REVISION DESCRIPTION	DRN	CHK	ENG	APP	EMP
D01	29.01.2024	AS-BUILT	JonRen	MauNot	NamWu	LuiPiz	
C01	03.01.2022	ISSUED FOR CONSTRUCTION	JonRen	MauNot	NamWu	LuiPiz	
A01	19.11.2021	ISSUED FOR APPROVAL	JonRen	MauNot	NamWu	LuiPiz	

RESERVED FOR VENDOR LOGO AND DRAWING NUMBER

LARSEN & TOUBRO

This drawing is the property of LARSEN & TOUBRO and must not be passed on to any person or body not authorized by us to receive it or be copied or otherwise made use either in full or in part by such person or body without our prior permission in writing.

Outotec

The content of these documents are the sole property of Outotec Oyj. Any rights not expressly granted herein are reserved. Reproduction, transfer or distribution of part or all of the contents in any form without prior written permission of Outotec is prohibited.

MA'ADEN معادن
Saudi Arabian Mining Company شركة معادن العربية السعودية

This document and the information contained herein is Ma'aden proprietary know-how. This document or any part thereof should not be reproduced, stored in a retrieval system or transmitted by any means, electronic or otherwise, or divulged without prior written permission of Ma'aden.

LARSEN & TOUBRO DRAWING NUMBER	019045_080_C_D_24892_005	REVISION 2
OUTOTEC DRAWING NUMBER	900707_GAU01_AG11_CTB01_49005	DOCUMENT ID OU100732637 / REVISION 2

DRAWN	JonRen	19.11.2021
CHECKED	MauNot	19.11.2021
ENGINEER	NamWu	19.11.2021
APPROVED	LuiPiz	19.11.2021
EMPLOYER		
SCALE		A0

MANSOURAH - MASSARAH GOLD PROJECT
49WI RAW WATER TREATMENT PLANT
SAND FILTER WALLS
REINFORCEMENT DRAWING

DRAWING NUMBER: MD-216-49WI-EG-CV-DED-1005 | REV: D0