


DRAWING NUMBER: MD-216-49W1-EG-CV-DED-1007 | REV: D01

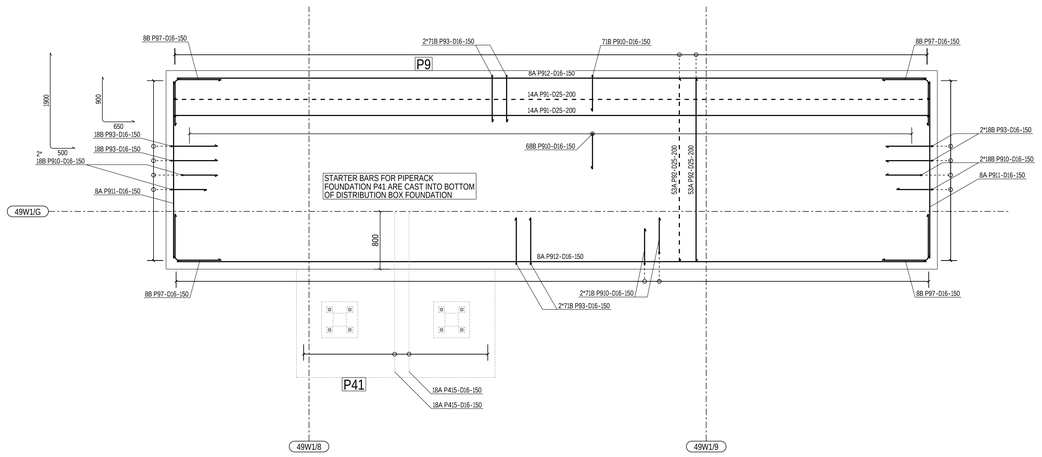


R.C.C BOTTOM SLAB REINFORCEMENT PLAN VIEW
(SCALE 1:30)

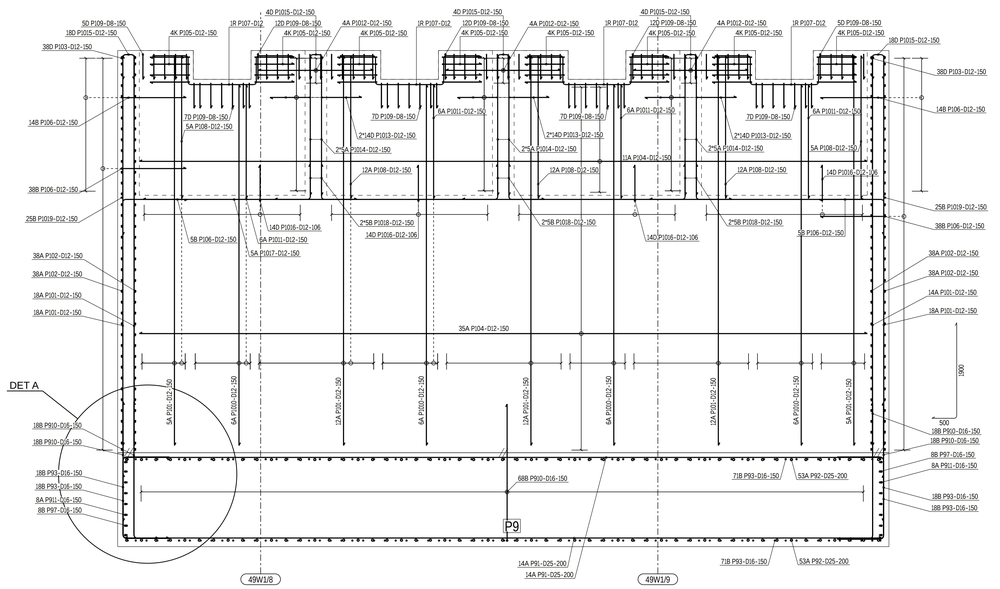


SECTION : B - B
(SCALE 1:30)

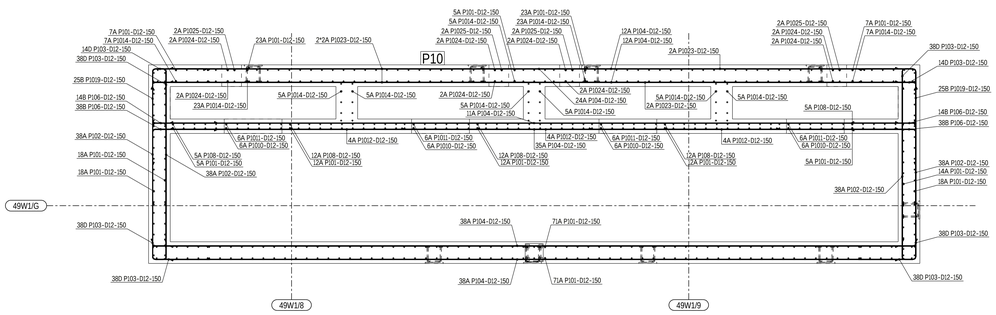


R.C.C WALLS STRAIGHT AND CORNER REINFORCEMENT PLAN VIEW
(SCALE 1:30)

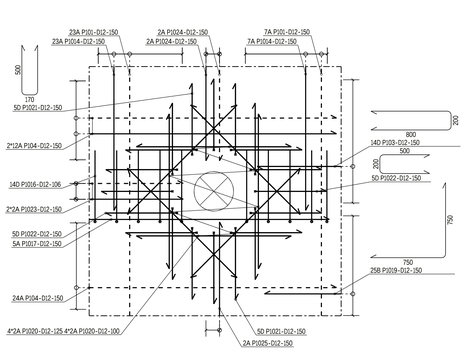


SECTION : D - D
EXTRA REINFORCEMENT AROUND Ø273 HOLES
(SCALE 1:15)

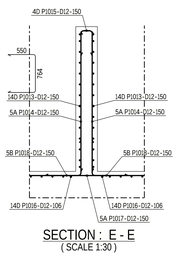


SECTION : E - E
(SCALE 1:30)

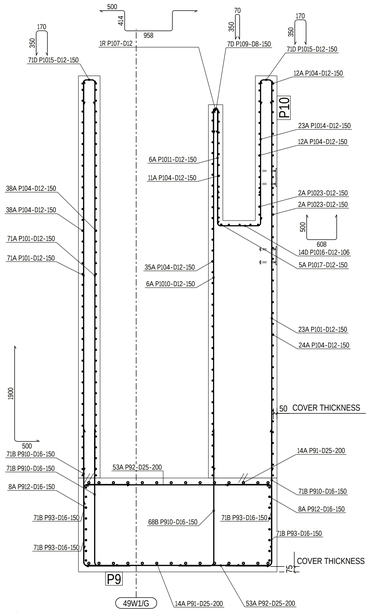

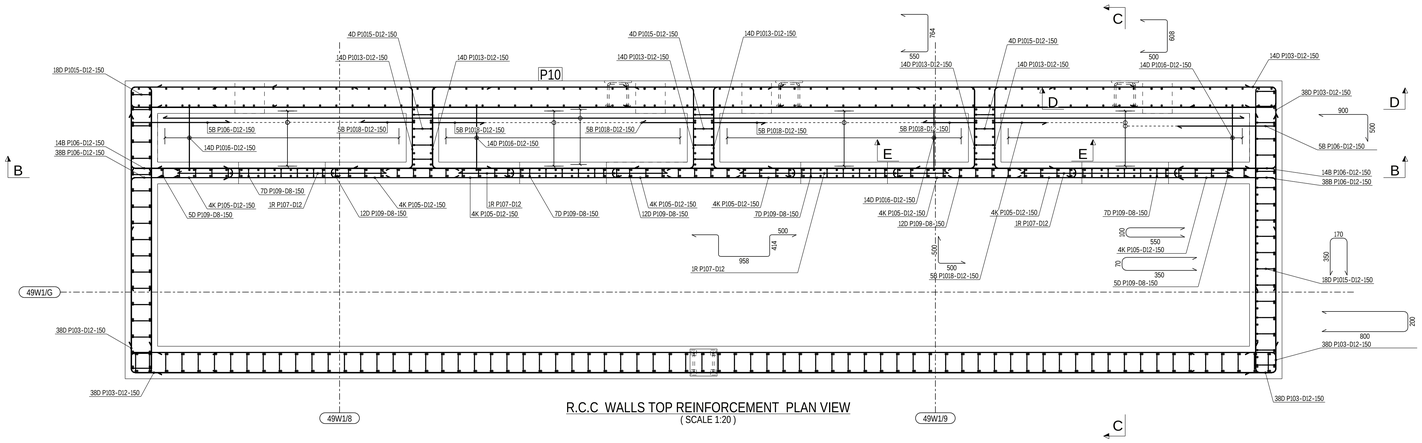

R.C.C WALLS TOP REINFORCEMENT PLAN VIEW
(SCALE 1:20)

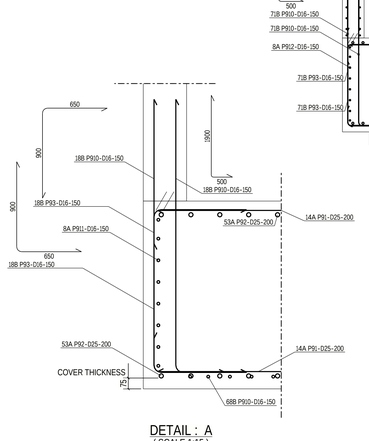

DETAIL : A
(SCALE 1:15)

CONCRETE INFORMATION

Concretes used	C35	
Concrete cover 1	75±10mm	BOTTOM OF SLAB
Concrete cover 2	50±10mm	SIDES AND TOP OF SLAB, WALLS

REINFORCING BAR LIST

CAST UNIT CODE: P9 PCS: 1

REINFORCING BARS TYPE	POS	PCS	GRADE	D [mm]	L [mm]	dL [mm]	WEIGHT SUM [kg]	BENDING DIMENSIONS [mm] a	b	c	d	e	u	v	x	TD	COMMENT
A	P91	28	B500B	25	10480		1129.7	10480									
A	P92	106	B500B	25	2550		1040.7	2550									
B	P93	356	B500B	16	1500		849.2	650	900					90		80	
B	P97	32	B500B	16	1250		63.7	650	650					90		80	
B	P910	353	B500B	16	2350		1316.1	1900	500					90		80	
A	P911	16	B500B	16	2450		61.9	2450									
A	P912	16	B500B	16	10380		262.4	10380									

REINFORCING BAR TOTAL WEIGHT [kg] 4723.7

REINFORCING BAR LIST

CAST UNIT CODE: P10 PCS: 1

REINFORCING BARS TYPE	POS	PCS	GRADE	D [mm]	L [mm]	dL [mm]	WEIGHT SUM [kg]	BENDING DIMENSIONS [mm] a	b	c	d	e	u	v	x	TD	COMMENT
A	P101	321	B500B	12	5400		1539.3	5400									
A	P102	152	B500B	12	2150		290.2	2150									
D	P103	256	B500B	12	1740		395.6	800	200	800						60	
A	P104	170	B500B	12	10080		1521.7	10080									
K	P105	32	B500B	12	1140		32.4	550	550							60	
B	P106	114	B500B	12	1370		138.7	900	500					90		60	
R	P107	4	B500B	12	2660		9.5	500	414	958	414	500				60	
A	P108	46	B500B	12	1980		80.9	1980									
D	P109	74	B500B	8	730		21.4	350	70	350						32	
A	P1010	24	B500B	12	5000		106.6	5000									
A	P1011	24	B500B	12	1580		33.7	1580									
A	P1012	12	B500B	12	1590		17.0	1595									
D	P1013	84	B500B	12	1800		134.6	550	764	550						60	
A	P1014	95	B500B	12	1930		162.9	1930									
D	P1015	190	B500B	12	810		136.7	350	170	350						60	
D	P1016	56	B500B	12	1540		77.0	500	608	500						60	
A	P1017	5	B500B	12	9980		44.3	9980									
B	P1018	30	B500B	12	970		25.8	500	500					90		60	
B	P1019	50	B500B	12	1470		65.3	750	750					90		60	
A	P1020	64	B500B	12	1070		61.0	1073									
D	P1021	40	B500B	12	1110		39.4	500	170	500						60	
D	P1022	40	B500B	12	1140		40.5	500	200	500						60	
A	P1023	8	B500B	12	3270		23.3	3277									
A	P1024	16	B500B	12	1580		22.5	1586									
A	P1025	8	B500B	12	3390		24.1	3391									

REINFORCING BAR TOTAL WEIGHT [kg] 5044.3

REINFORCEMENT BENDING SHAPES:




LEGEND:
- R.L - REDUCED LEVEL
- T.O.C. - TOP OF CONCRETE
- B.O.F. - BOTTOM OF FOUNDATION
- F.G.L. - FINISHED GROUND LEVEL
- P.C.C. - PLAIN CEMENT CONCRETE
- TYP - TYPICAL
- MKD - MARKED
- CL - CENTER LINE
- BOTTOM REINF. (B)
- TOP REINF. (T)
- SBC - SAFE BEARING CAPACITY
- MIN. - MINIMUM
- REF. - REFERED
- GA - GENERAL ARRANGEMENT
- DWG. - DRAWING
- R.C.C. - REINFORCED CEMENT CONCRETE

NOTES:
1. ALL DIMENSIONS ARE IN MILLIMETRES AND LEVELS ARE IN METRES UNLESS OTHERWISE STATED
2. GRADE OF CONCRETE SHALL BE C35 (35MPa) UNLESS NOTED OTHERWISE & C15 (15MPa) FOR BLINDING CONCRETE
3. GRADE OF REINFORCEMENT SHALL BE DEFORMED BAR ASTM A615-GRADE 60 (fy=420MPa)
4. CLEAR COVER TO MAIN REINFORCEMENT SHALL BE AS FOLLOWS:
   a) FOUNDATION: 75 mm (BOTTOM & SIDE)
   b) FOUNDATION: 50 mm (TOP)
   c) COLUMN & PEDESTAL: 50 mm
5. MINIMUM LAP LENGTHS OF REINFORCEMENT SHALL BE 40XBAR DIAMETER
6. FOR STANDARD REINFORCEMENT DETAILS & GENERAL NOTES FOR CIVIL WORKS REFER TO DRAWING NUMBER MD-216-1000-EG-CV-DED-1005 & 1001
7. ANCHOR BOLTS AND EMBEDDED STEELWORK SHALL BE HOT DEEP GALVANIZED
8. T.O.C. & TOP OF SCREED TOLERANCE SHALL BE WITHIN +/- 10MM OF DESIGN LEVEL
9. NET SAFE BEARING CAPACITY OF SOIL AT BOTTOM OF FOUNDATION IS CONSIDERED AS 375 KN/SQ.M.
10. REBARS CAN BE MOVED LOCALLY BY +/- 25mm TO AVOID INTERFERENCE WITH EMBEDDED PARTS

C01

KEYPLAN

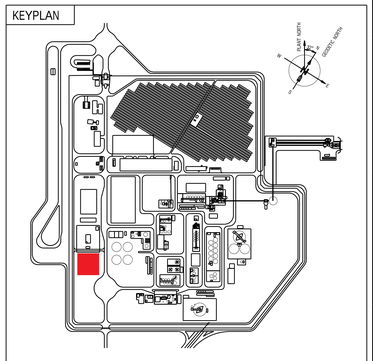

DOCUMENT NUMBER	REFERENCE DOCUMENTS	DOCUMENT NUMBER	REFERENCE DOCUMENTS
MD-216-1000-EG-ST-CRT-1001	DESIGN CRITERIA	MD-216-49WC-EG-ME-GAD-1022	CONCRETE EMBEDDED PARTS OUTLINE DRAWING
MD-216-49W1-EG-CV-DED-1005	SAND FILTER WALLS REINFORCEMENT DRAWING	MD-216-49WC-EG-CV-CAL-1002	SAND FILTER AND DISTRIBUTION BOX CALCULATION REPORT
MD-216-49W1-EG-CV-GAD-1003	1-10/A-E GENERAL ARRANGEMENT DRAWING	MD-216-49WC-EG-CV-DED-1003	SAND FILTER AND DISTRIBUTION BOX DIMENSIONAL DRAWING
MD-216-49W1-EG-CV-GAD-1001	1-8/E-J GENERAL ARRANGEMENT DRAWING	MD-216-49WC-EG-CV-GAD-1002	7-12/D-J GENERAL ARRANGEMENT DRAWING

REV	DATE	REVISION DESCRIPTION	DRN	CHK	ENG	APP	EMP
D01	29.01.2024	AS-BUILT	JonRen	MauNot	NamWu	LuiPiz	
C01	03.10.2022	ISSUED FOR CONSTRUCTION	JonRen	MauNot	NamWu	LuiPiz	
A01	19.11.2021	ISSUED FOR APPROVAL	JonRen	MauNot	NamWu	LuiPiz	

RESERVED FOR VENDOR LOGO AND DRAWING NUMBER

LARSEN & TOUBRO

This drawing is the property of LARSEN & TOUBRO and must not be passed on to any person or body not authorized by us to receive it or be copied or otherwise made use either in full or in part by such person or body without our prior permission in writing.

Outotec

The content of these documents are the sole property of Outotec Oy. Any rights not expressly granted herein are reserved. Reproduction, transfer or distribution of part or all of the contents in any form without prior written permission of Outotec is prohibited.

MA'ADEN معادن — Saudi Arabian Mining Company — شركة معادن العربية السعودية

This document and the information contained herein is Ma'aden proprietary know-how. This document or any part thereof should not be reproduced, stored in a retrieval system or transmitted by any means, electronic or otherwise, or divulged without prior written permission of Ma'aden.

LARSEN & TOUBRO DRAWING NUMBER: O19045_080_C_D_24892_007 — REVISION: 2

OUTOTEC DRAWING NUMBER: 900707_GAU01_AG11_CTB01_49007 — DOCUMENT ID: OU100732639 — REVISION: 2

DRAWN	JonRen	19.11.2021
CHECKED	MauNot	19.11.2021
ENGINEER	NamWu	19.11.2021
APPROVED	LuiPiz	19.11.2021
EMPLOYER		
SCALE		A0

MANSOURAH - MASSARAH GOLD PROJECT
49W1 RAW WATER TREATMENT PLANT
DISTRIBUTION BOX
REINFORCEMENT DRAWING

DRAWING NUMBER: MD-216-49W1-EG-CV-DED-1007 — REV: D01