MD-216-49W1-EG-CV-DED-1008
DRAWING NUMBER
REV
D01

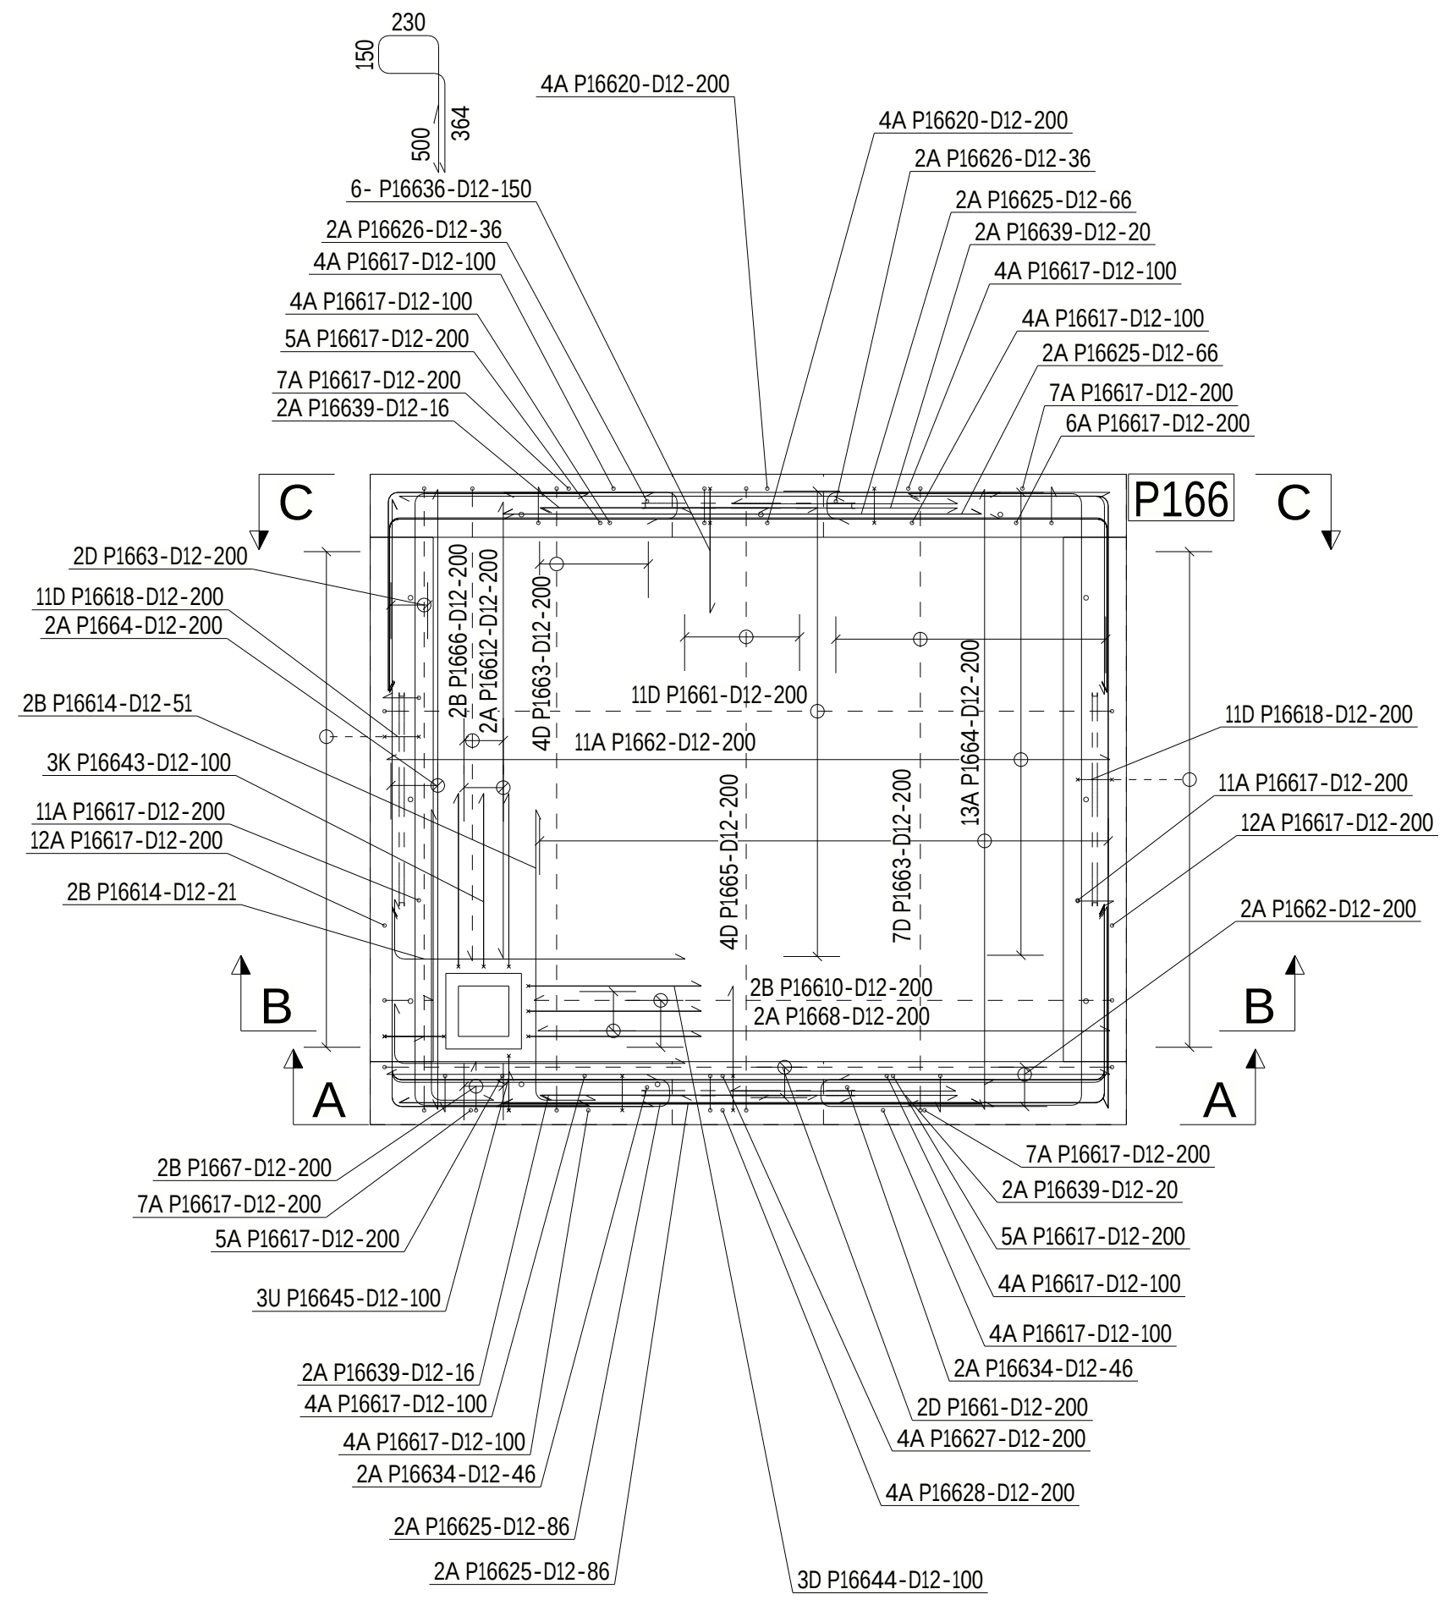

R.C.C. PLAN FOR VALVE PIT MKD. P166
(SCALE 1:30)

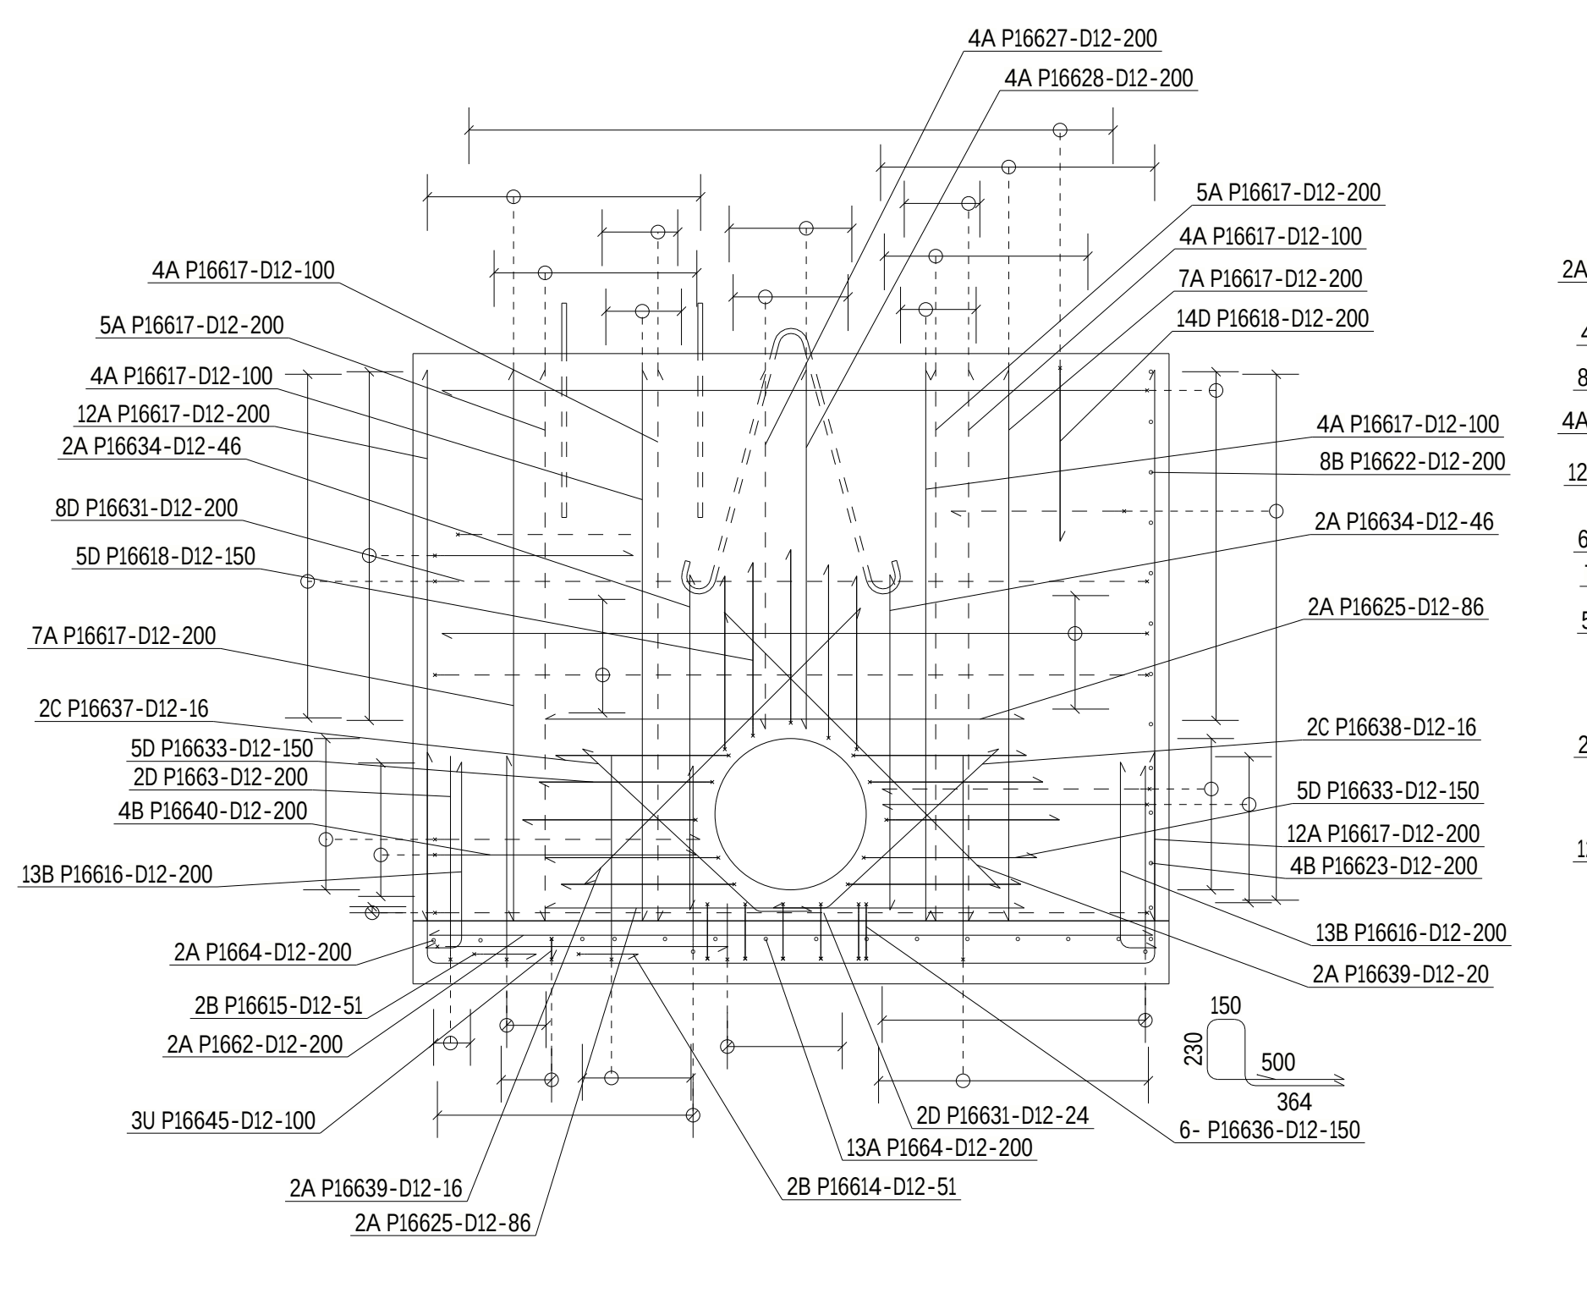

SECTION : A - A
(SCALE 1:30)

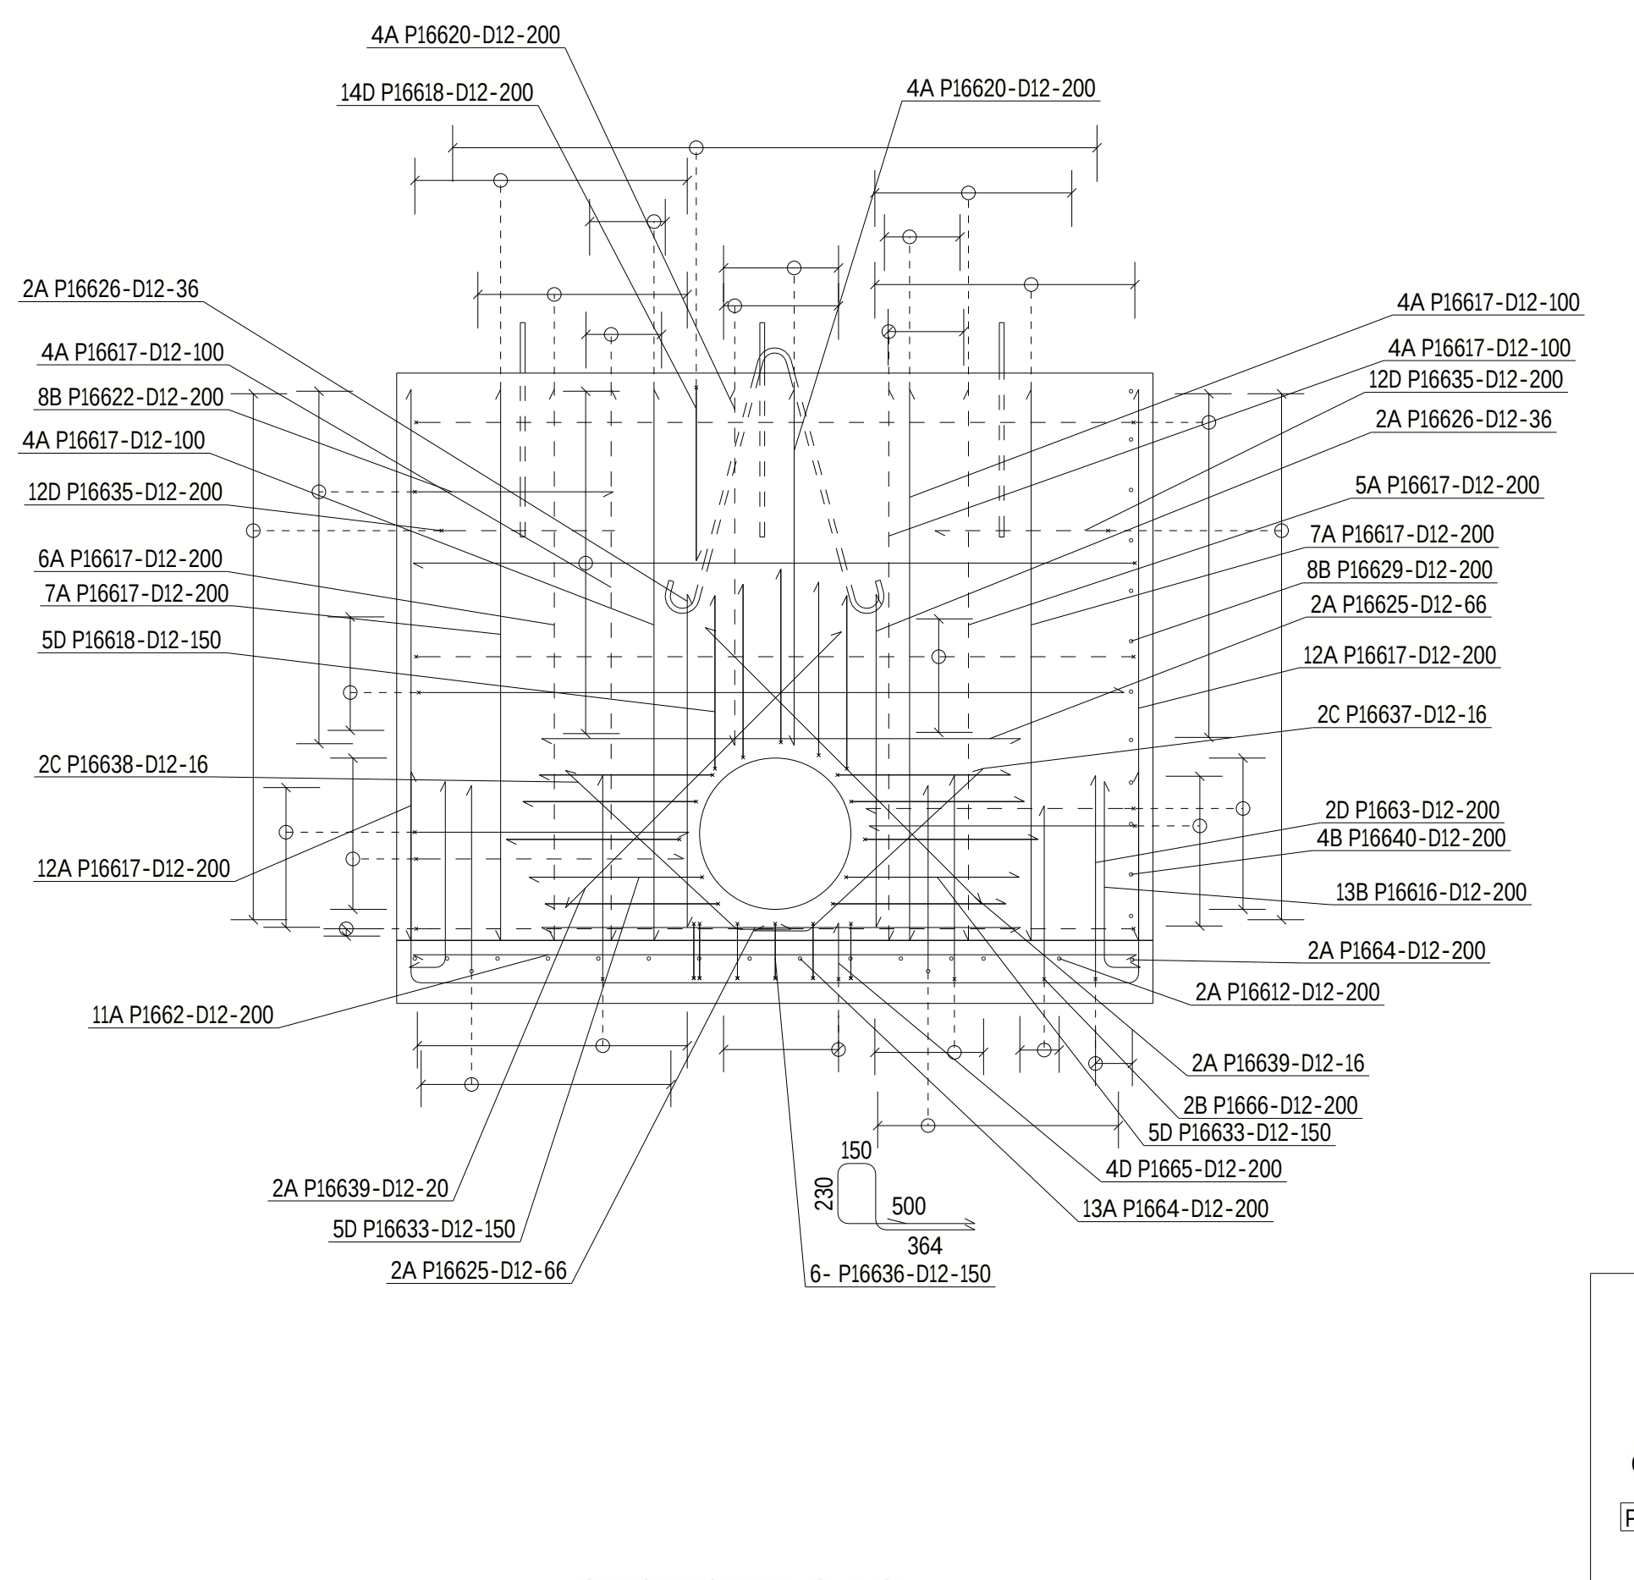

SECTION : C - C
(SCALE 1:30)

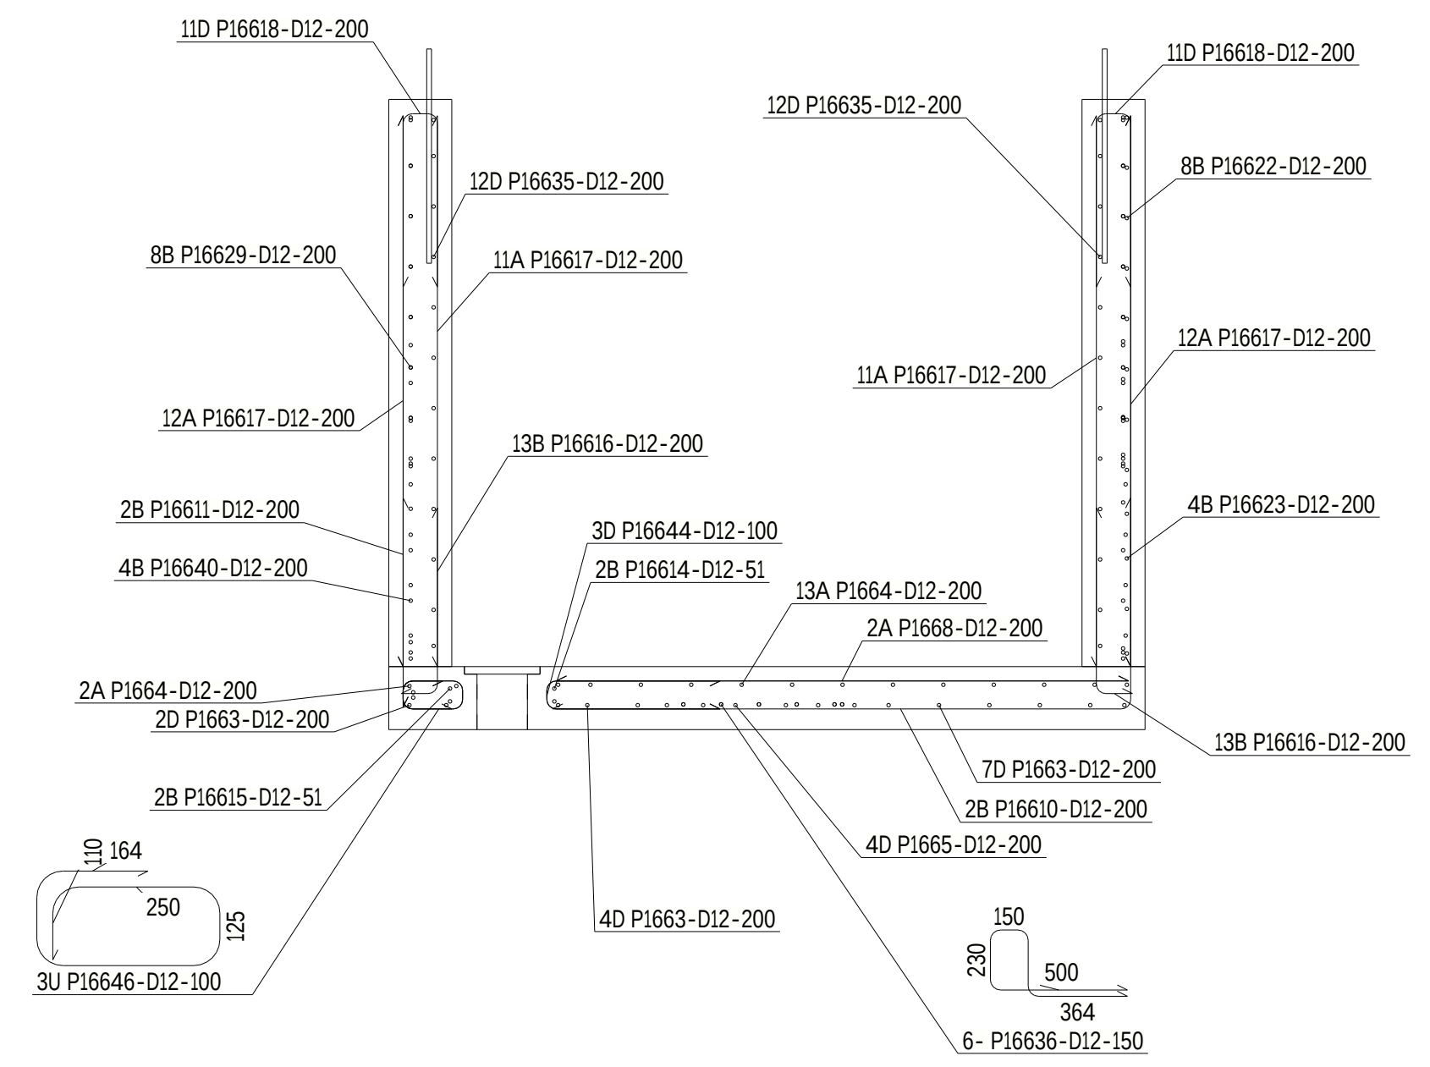

SECTION : B - B
(SCALE 1:30)

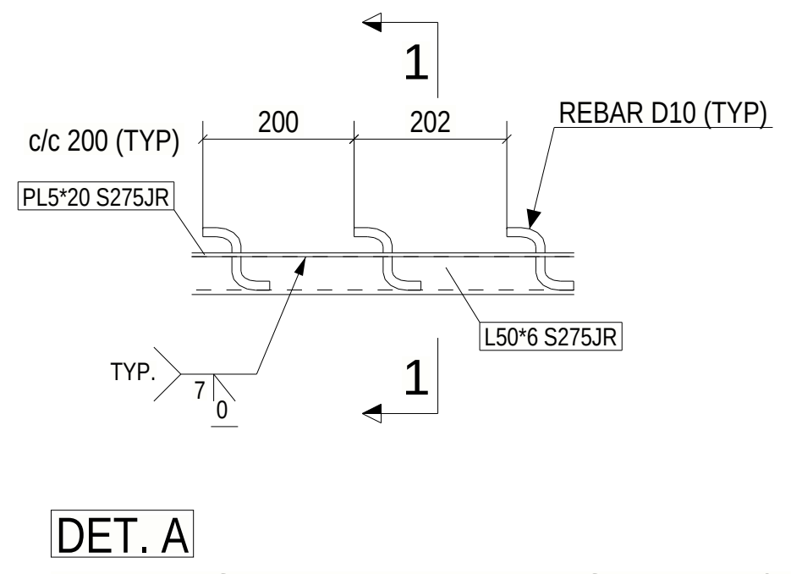

DET. A
DETAIL OF EMBEDDED PROFILE L50X6
(SCALE 1:10)

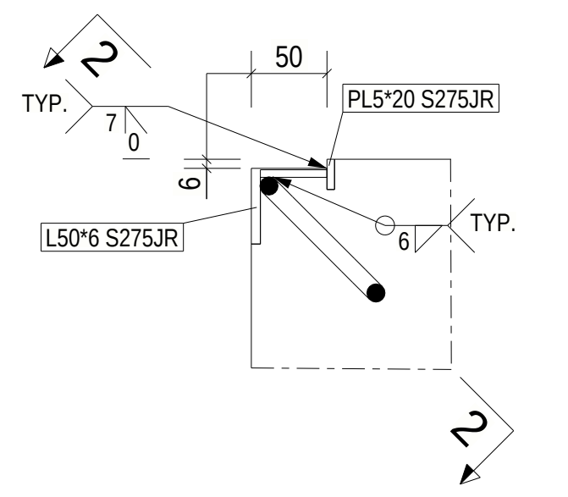

SECTION : 1 - 1
(SCALE 1:5)

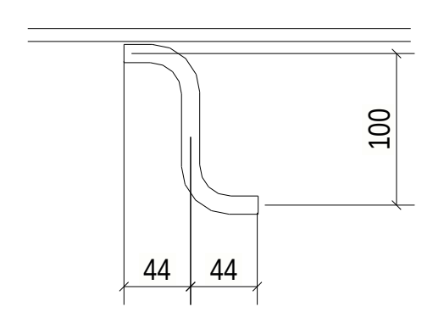

SECTION : 2 - 2
(SCALE 1:5)

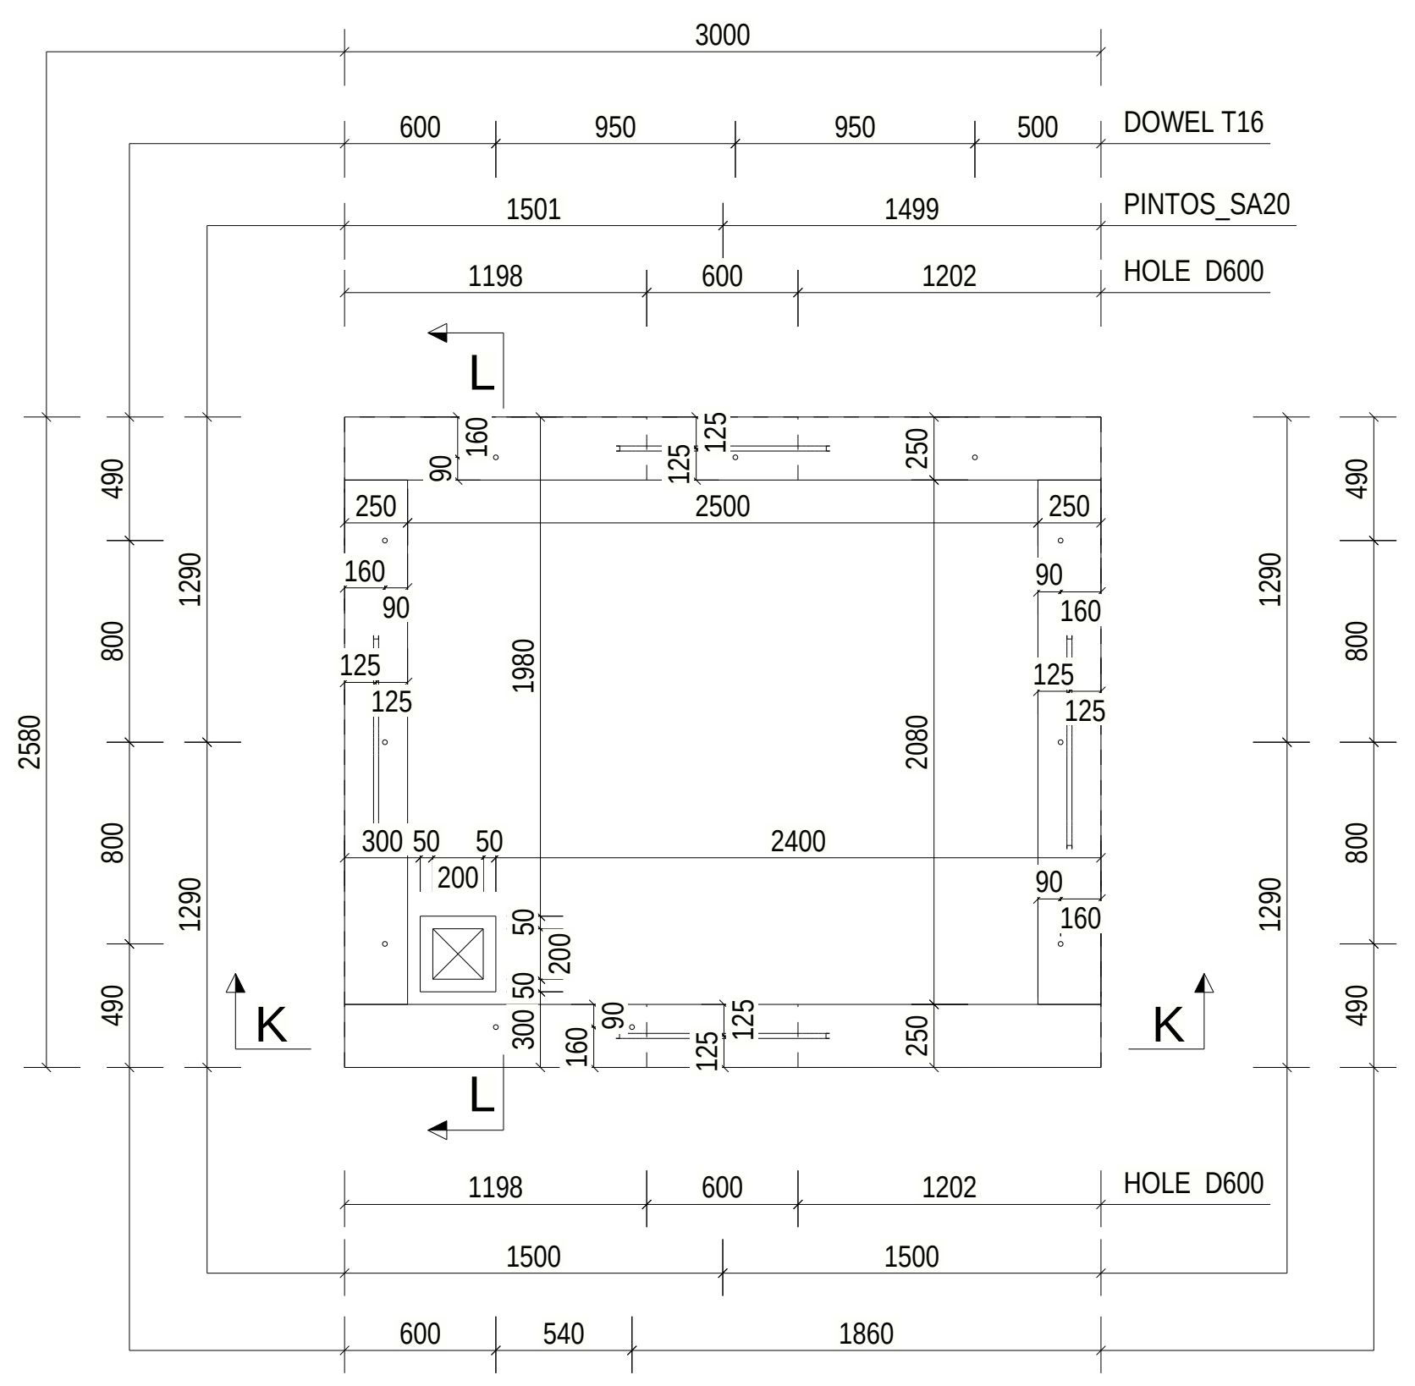

R.C.C. PLAN FOR VALVE PIT MKD. P166
(SCALE 1:30)

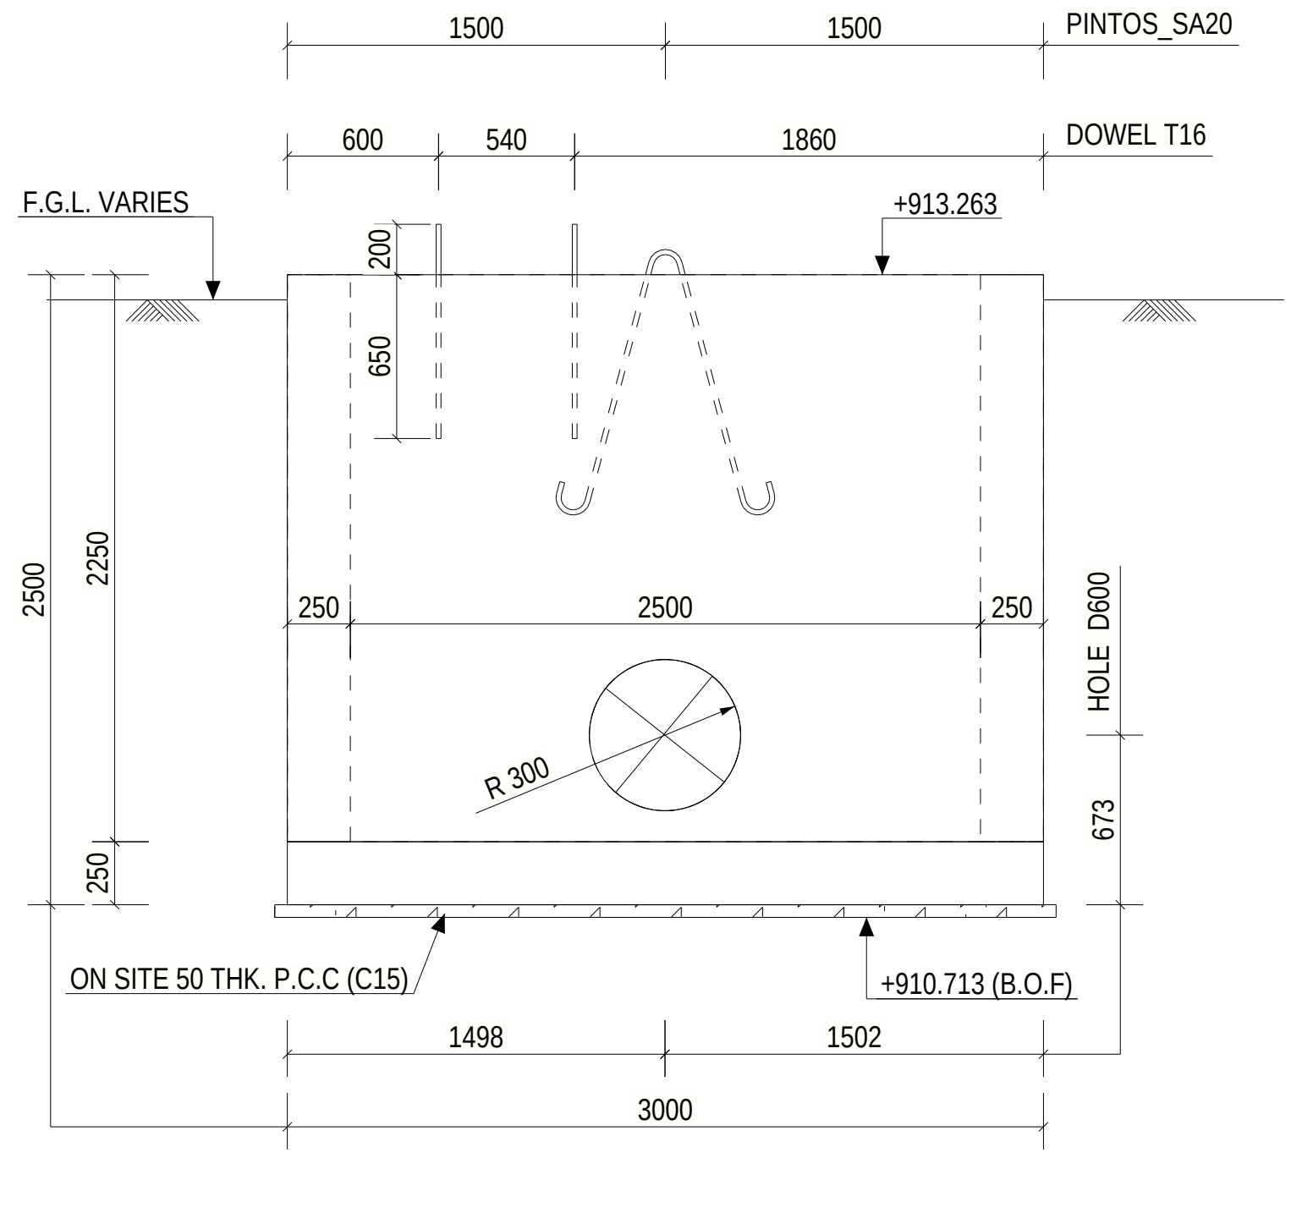

SECTION : K - K
(SCALE 1:30)

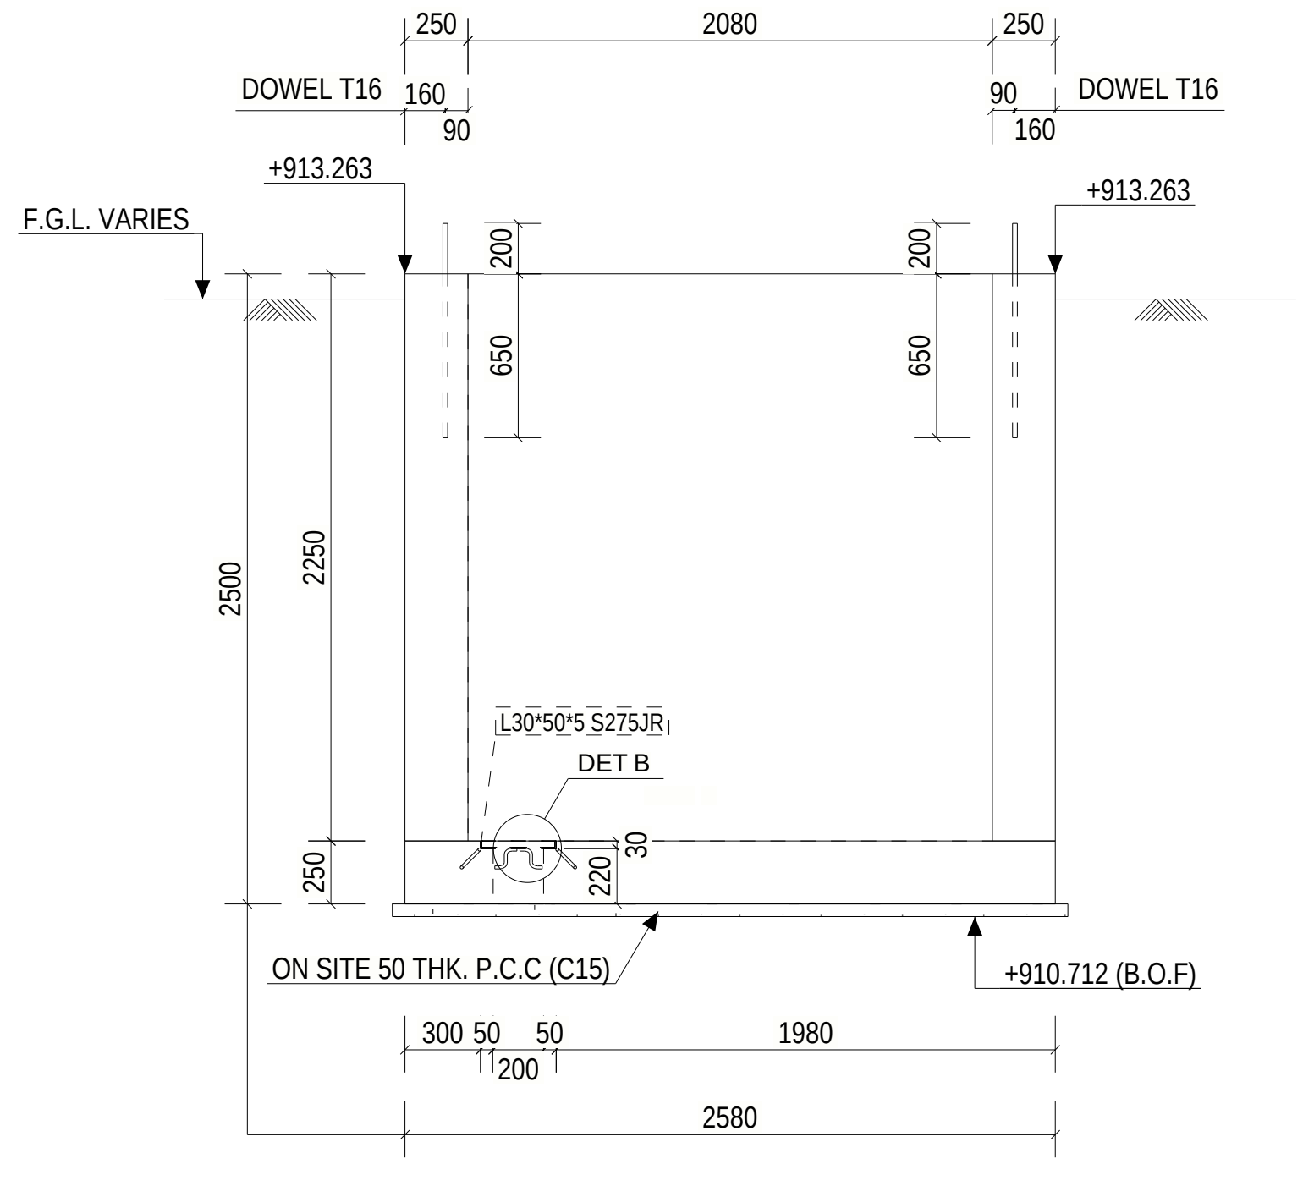

SECTION : L - L
(SCALE 1:30)

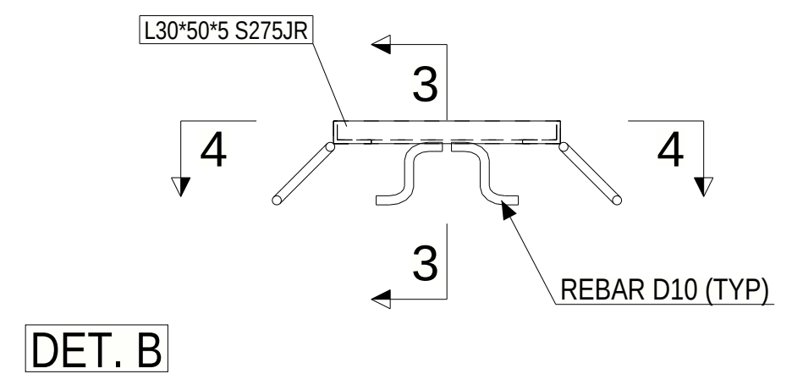

DET. B
DETAIL OF EMBEDDED PROFILE L30X50X5
(SCALE 1:10)

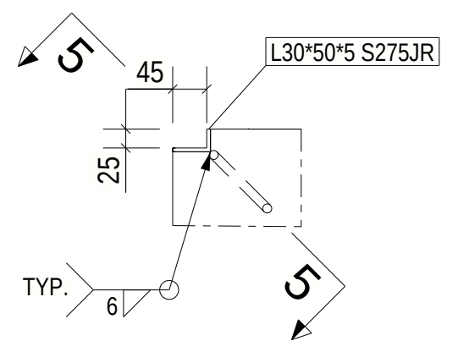

SECTION : 3 - 3
(SCALE 1:10)

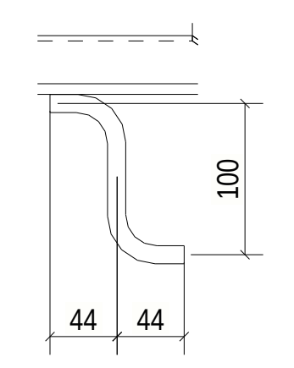

SECTION : 5 - 5
(SCALE 1:5)

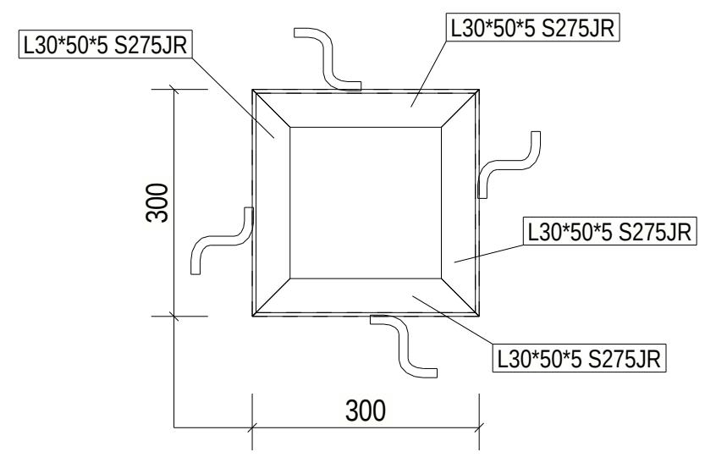

SECTION : 4 - 4
(SCALE 1:10)

EXTRA REBAR FOR LIFTING ANCHOR SEMTU LA24
1:10

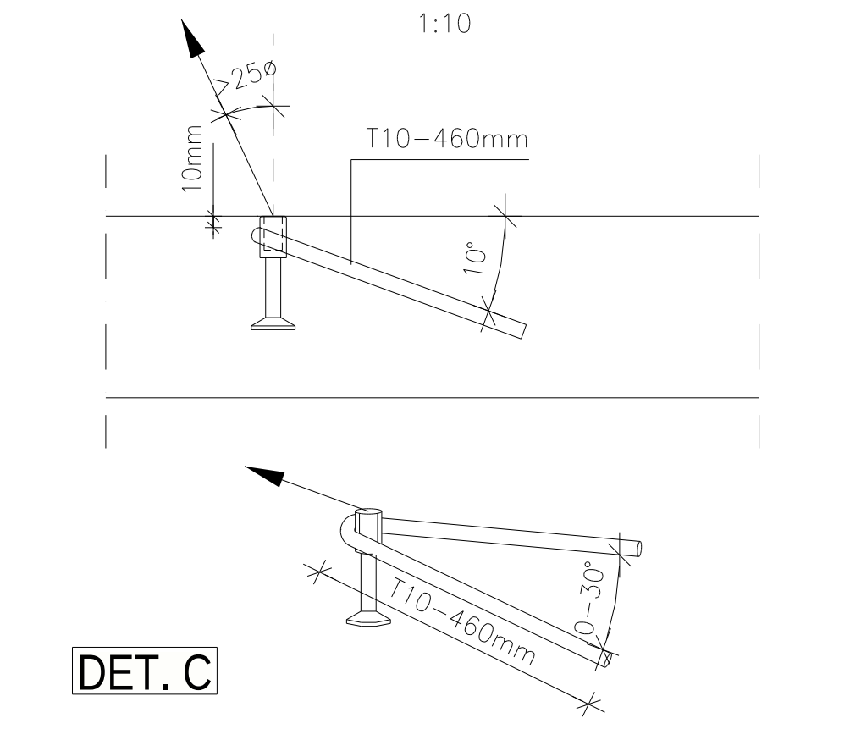

DET. C

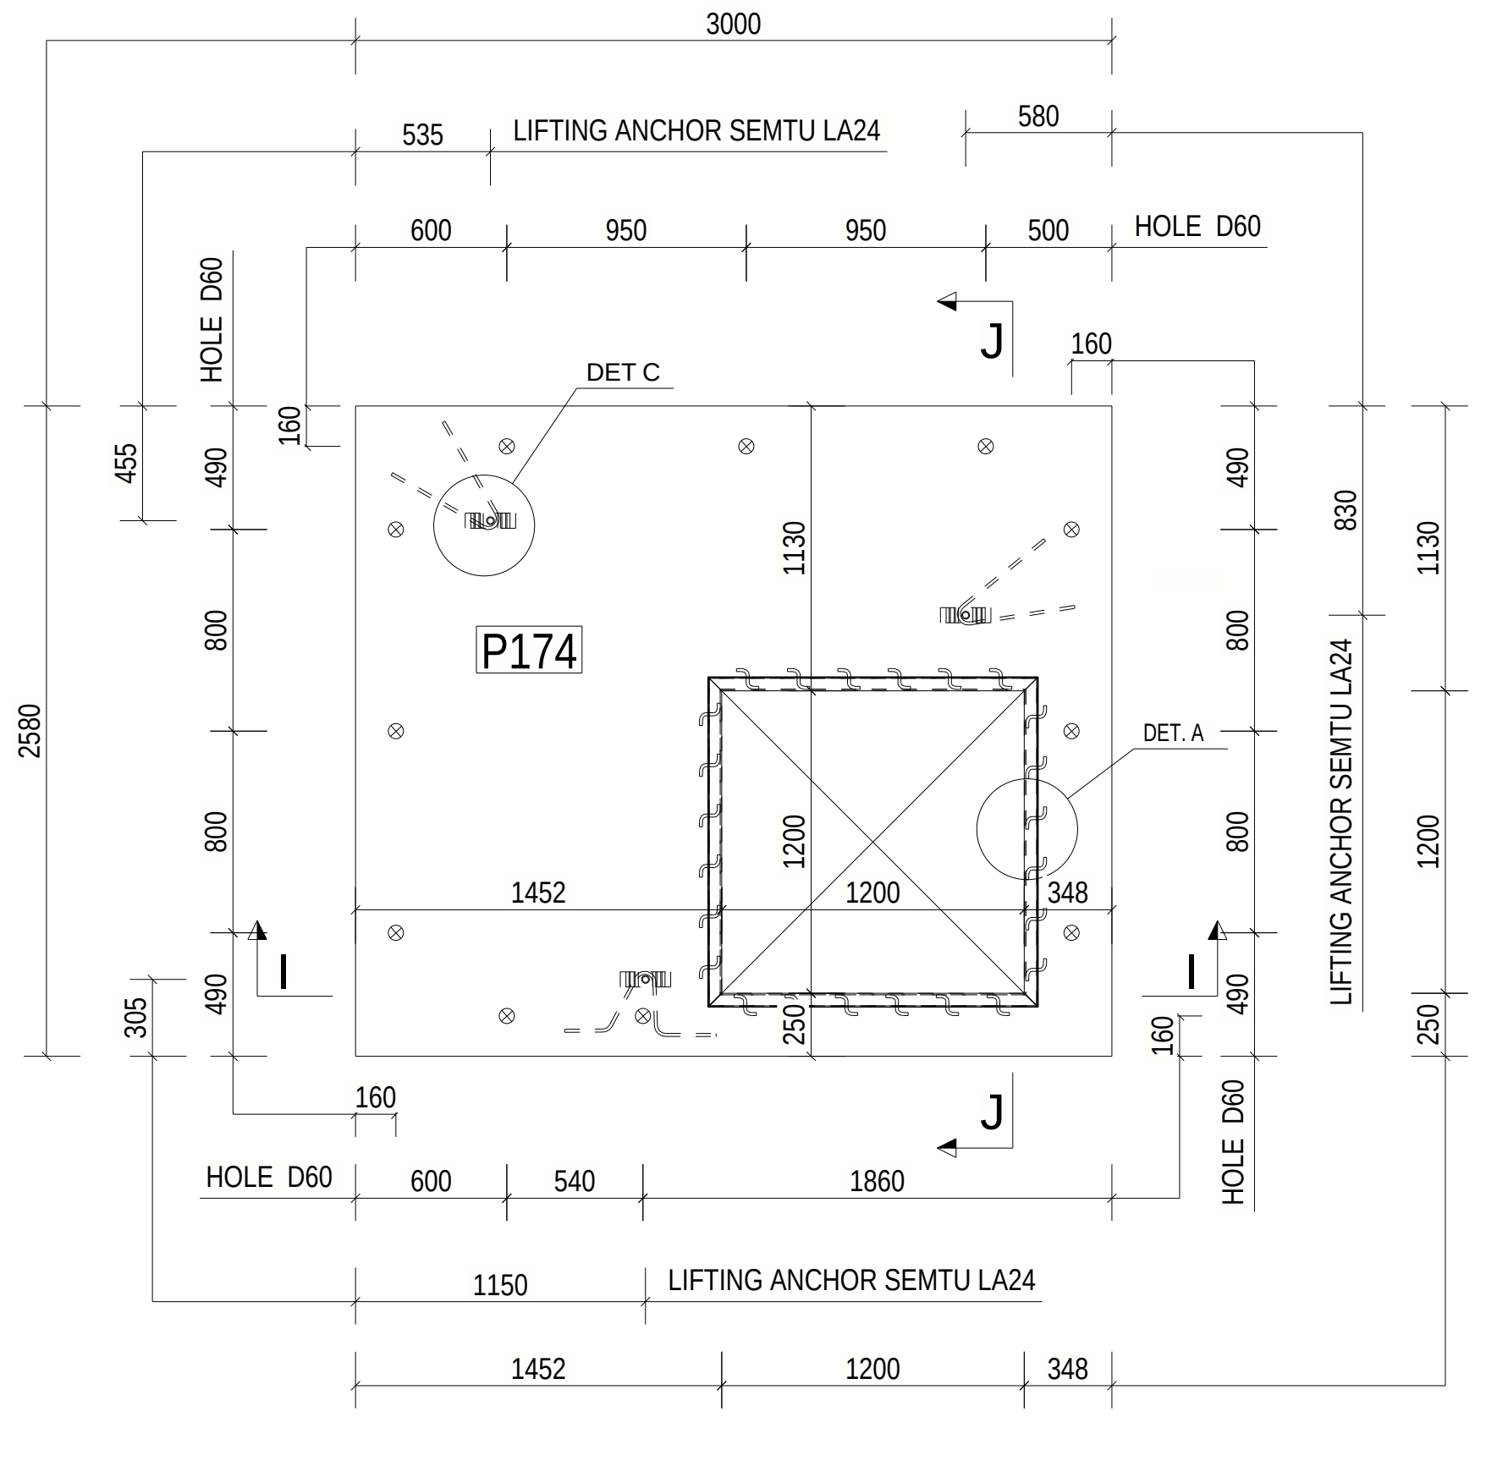

R.C.C. PLAN FOR LID OF VALVE PIT MKD. P174
(SCALE 1:30)

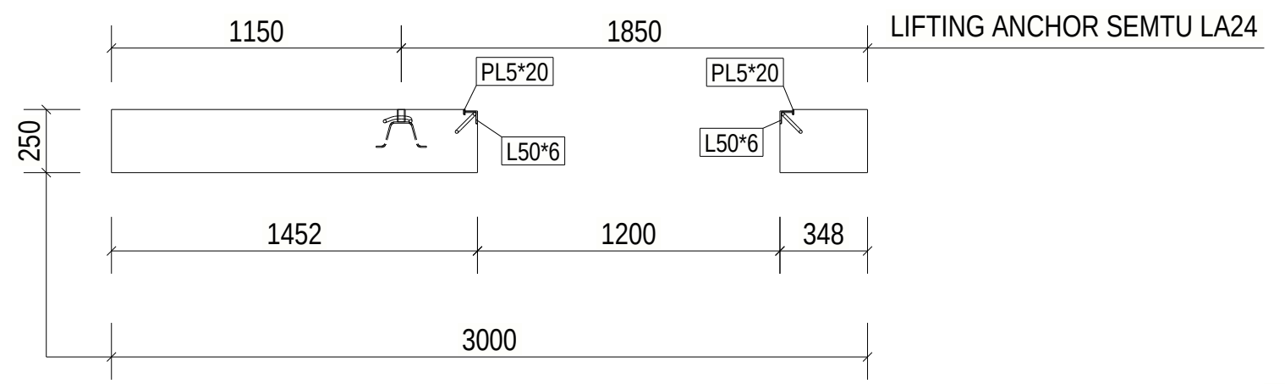

SECTION : I - I
(SCALE 1:30)

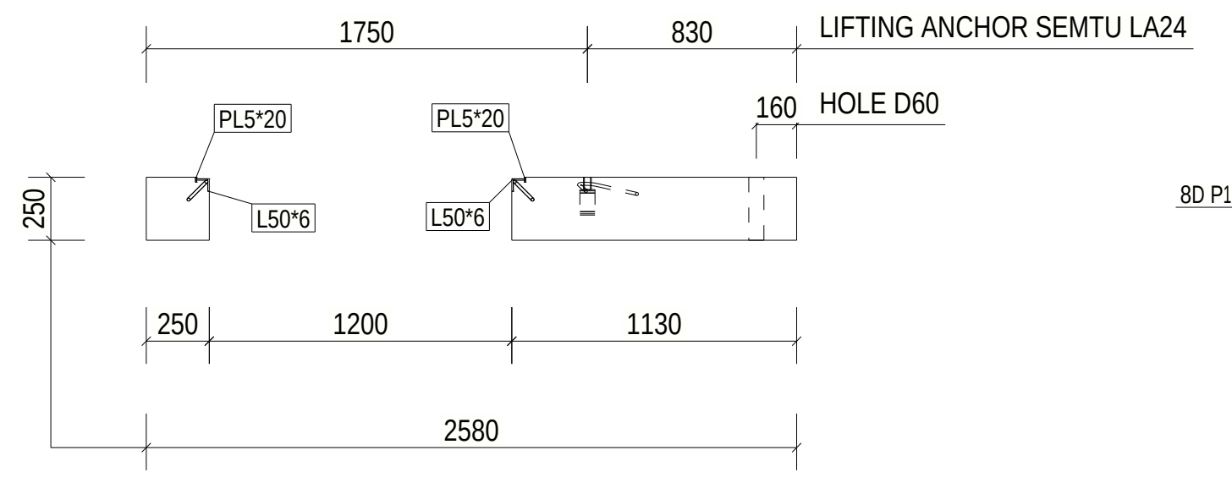

SECTION : J - J
(SCALE 1:30)

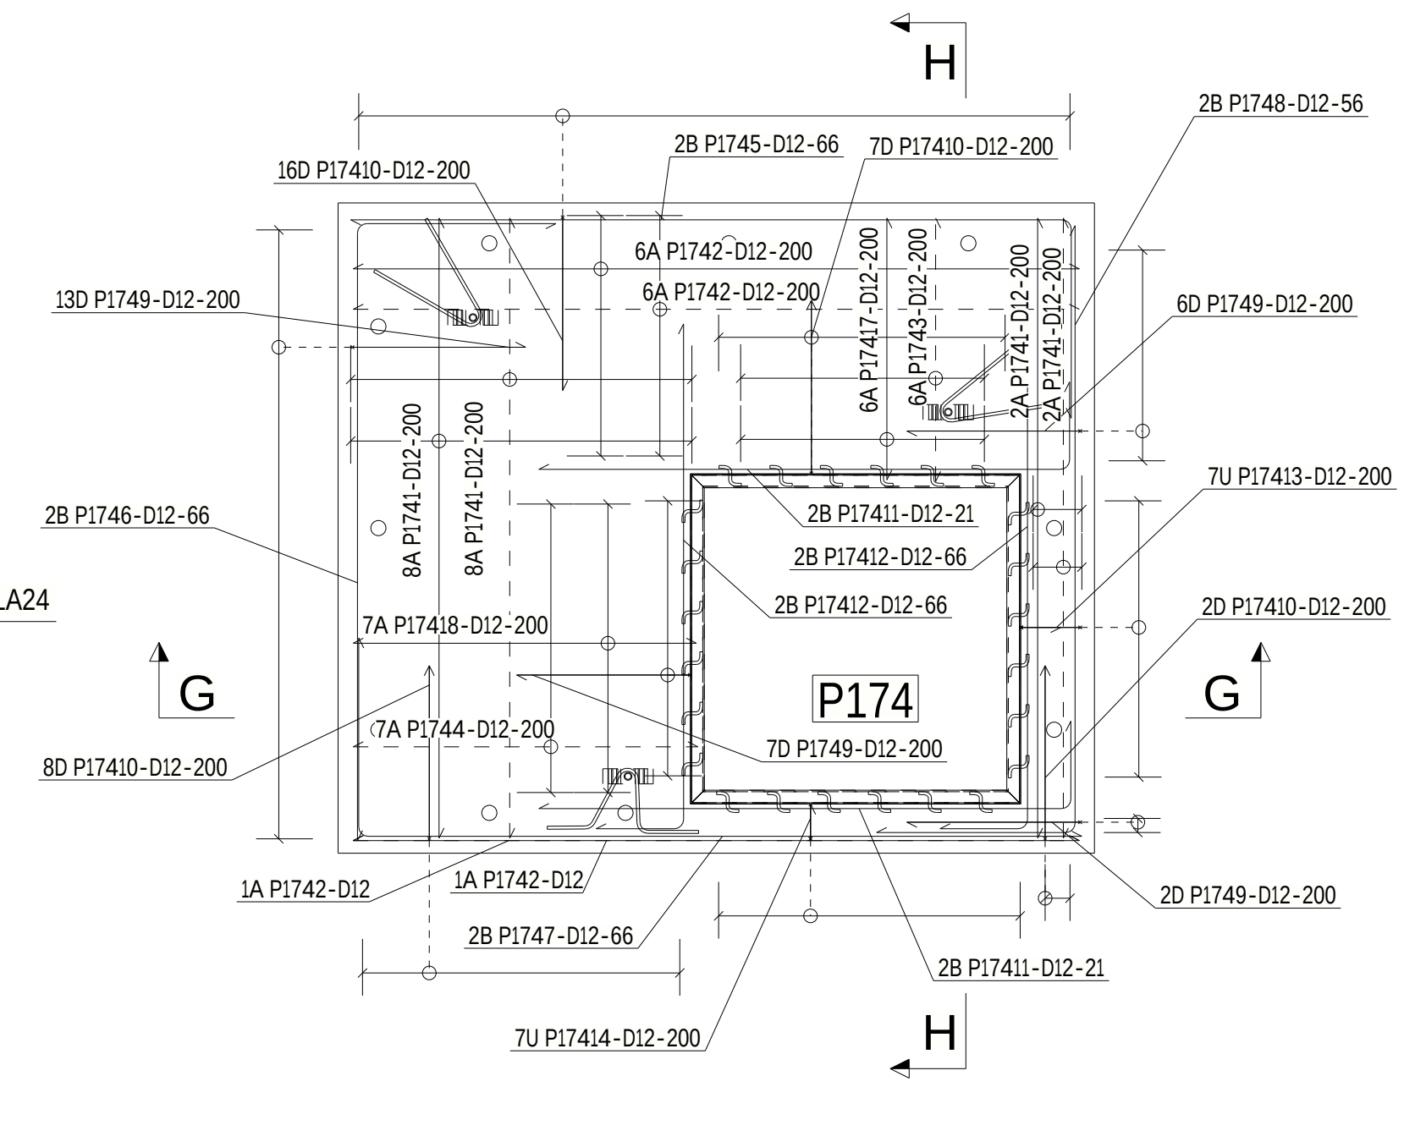

R.C.C. PLAN FOR LID OF VALVE PIT MKD. P174
(SCALE 1:30)

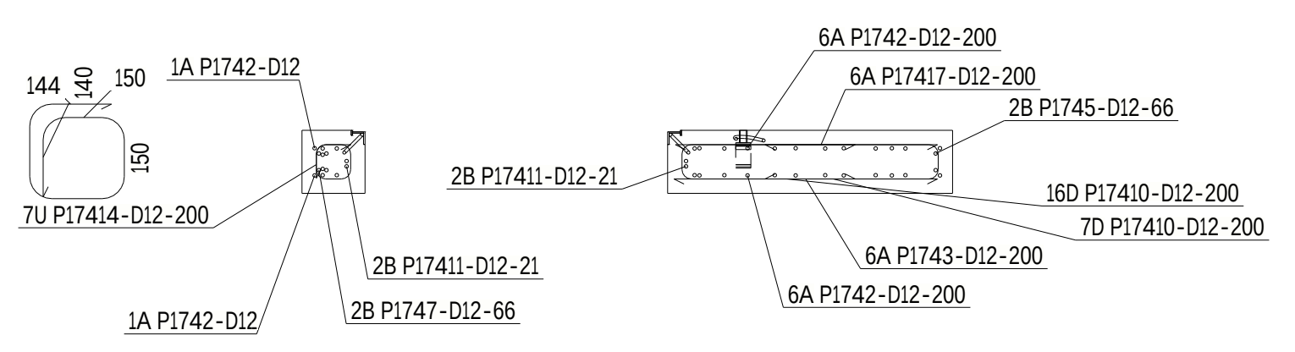

SECTION : H - H
(SCALE 1:30)

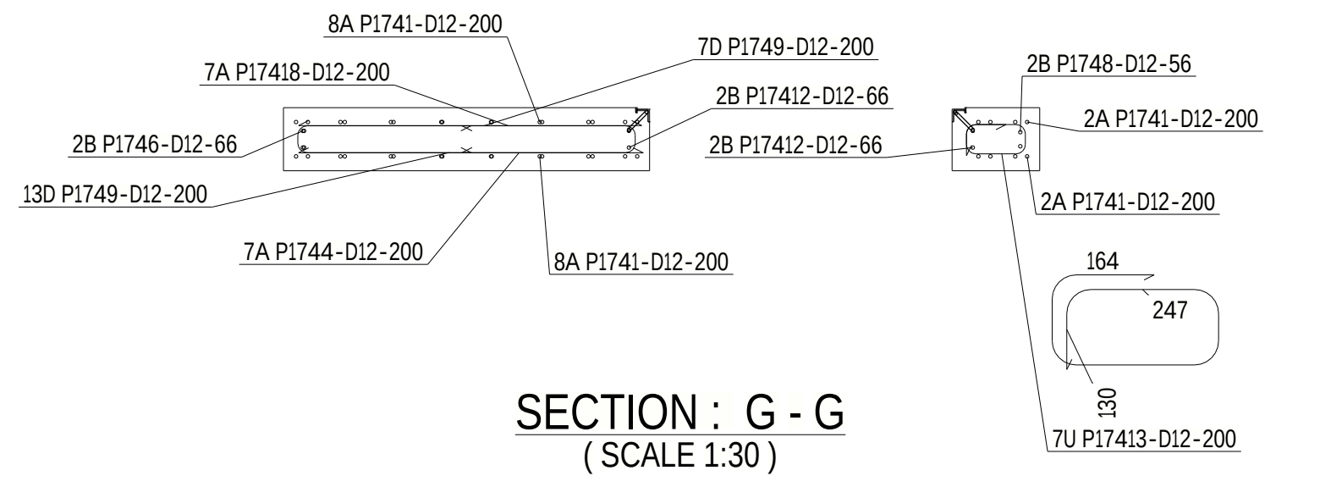

SECTION : G - G
(SCALE 1:30)

FOR LOCATION OF PIT, SEE GENERAL ARRANGEMENT
DRAWING MD-216-49W1-EG-CV-GAD-1005

CONCRETE INFORMATION

Concretes used	C45	
Concrete cover 1	75±10mm	BOTTOM OF SLAB
Concrete cover 2	50±10mm	SIDES AND TOP OF SLAB, WALLS

REINFORCING BAR LIST

CAST UNIT CODE: P166 PCS: 5

TYPE	POS	PCS	GRADE	D [mm]	L [mm]	dL [mm]	WEIGHT SUM [kg]	a	b	c	d	e	u	v	x	TD	COMMENT
D	P1661	13	B500B	12	4520		52.3	844	2900	844						60	
A	P1662	13	B500B	12	2870		33.1	2870									
D	P1663	13	B500B	12	4040		46.7	814	2480	814						60	
A	P1664	15	B500B	12	2460		32.8	2460									
D	P1665	4	B500B	12	2870		10.2	229	2480	229						60	
B	P1666	2	B500B	12	2540		4.5	694	1880				90			60	
B	P1667	2	B500B	12	980		1.7	200	814				90			60	
A	P1668	2	B500B	12	2270		4.0	2270									
B	P16610	2	B500B	12	3110		5.5	844	2300				90			60	
B	P16611	2	B500B	12	1010		1.8	200	844				90			60	
A	P16612	2	B500B	12	1810		3.2	1810									
B	P16614	6	B500B	12	1370		7.3	244	1160				90			60	
B	P16615	2	B500B	12	1380		2.5	1160	254				90			60	
B	P16616	51	B500B	12	860		39.1	744	150				90			60	
A	P16617	127	B500B	12	2180		246.4	2185									
D	P16618	60	B500B	12	1470		78.8	694	150	694						60	
D	P16619	14	B500B	12	4180		52.1	694	2860	694						60	
A	P16620	8	B500B	12	1410		10.0	1411									
B	P16621	8	B500B	12	3630		25.8	2870	794				90			60	
B	P16622	8	B500B	12	3190		22.7	2435	794				90			60	
B	P16623	4	B500B	12	3490		12.4	2435	1094				90			60	
B	P16624	8	B500B	12	1820		12.9	1056	794				90			60	
A	P16625	8	B500B	12	1900		13.5	1900									
A	P16626	4	B500B	12	1320		4.7	1320									
A	P16627	4	B500B	12	1470		5.2	1478									
95	AT GROUP	4	PCS	...	1420	17	...	1423									
A	P16628	4	B500B	12	1480		5.2	1488									
1	AT GROUP	4	PCS	...	1420	20	...	1423									
B	P16629	8	B500B	12	3170		22.6	794	2415				90			60	
B	P16630	16	B500B	12	3560		50.7	2805	794				90			60	
D	P16631	14	B500B	12	4160		51.8	694	2840	694						60	
B	P16632	4	B500B	12	1850		6.4	1189	694				90			60	
10	AT GROUP	4	PCS	...	1720	43	...	1058	694				90				
D	P16633	20	B500B	12	1440		25.7	694	119	694						60	
A	P16634	4	B500B	12	1330		4.7	1330									
D	P16635	24	B500B	12	3760		80.3	694	2440	694						60	
**	P16636	12	B500B	12	1350		14.4										
C	P16637	4	B500B	12	1160		4.1	950	217				43			60	
C	P16638	4	B500B	12	1140		4.1	930	217				43			60	
A	P16639	8	B500B	12	1540		11.0	1548									
B	P16640	4	B500B	12	3420		12.2	1044	2415				90			60	
B	P16641	8	B500B	12	1860		12.8	1199	694				90			60	
22	AT GROUP	4	PCS	...	1730	43	...	1068	694				90				
B	P16642	4	B500B	12	1880		6.4	1219	694				90			60	
1	AT GROUP	4	PCS	...	1730	50	...	1069	694				90				
K	P16643	3	B500B	12	1410		3.8	694	694							60	
D	P16644	3	B500B	12	1450		3.9	694	125	694						60	
U	P16645	3	B500B	12	750		2.0	164	95	230	95	230				60	
U	P16646	3	B500B	12	870		2.3	164	125	250	125	250				60	

REINFORCING BAR TOTAL WEIGHT [kg] 1053.8

REINFORCING BAR LIST

CAST UNIT CODE: P174 PCS: 1

TYPE	POS	PCS	GRADE	D [mm]	L [mm]	dL [mm]	WEIGHT SUM [kg]	a	b	c	d	e	u	v	x	TD	COMMENT
A	P1741	20	B500B	12	2460		43.7	2460									
A	P1742	14	B500B	12	2880		35.8	2880									
A	P1743	6	B500B	12	1040		5.6	1045									
A	P1744	7	B500B	12	1360		8.5	1367									
B	P1745	2	B500B	12	3620		6.4	2865	794				90			60	
B	P1746	2	B500B	12	3210		5.7	794	2455				90			60	
B	P1747	2	B500B	12	3630		6.5	2875	794				90			60	
B	P1748	2	B500B	12	3170		5.6	794	2415				90			60	
D	P1749	28	B500B	12	1440		36.0	694	120	694						60	
D	P17410	33	B500B	12	1470		43.3	694	150	694						60	
B	P17411	4	B500B	12	2430		8.7	354	2112				90			60	
B	P17412	4	B500B	12	2330		8.3	2010	354				90			60	
U	P17413	7	B500B	12	890		5.6	164	130	247	130	247				60	
U	P17414	7	B500B	12	730		4.6	144	150	150	150	150				60	
A	P17417	6	B500B	12	1030		5.5	1039									
A	P17418	7	B500B	12	1360		8.5	1361									

REINFORCING BAR TOTAL WEIGHT [kg] 238.3

REINFORCEMENT BENDING SHAPES:

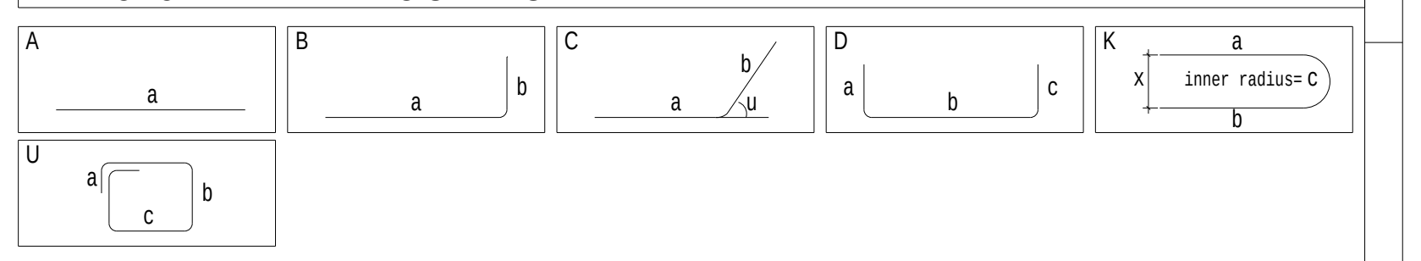

MANUFACTURED PRECAST ELEMENTS

ELEMENT:	PCS:
VALVE PIT MKD. P166	2
LID OF VALVE PIT MKD. P174	2
TOTAL:	4

LEGEND:

R.L. - REDUCED LEVEL
T.O.C. - TOP OF CONCRETE
B.O.F. - BOTTOM OF FOUNDATION
F.G.L. - FINISHED GROUND LEVEL
P.C.C. - PLAIN CEMENT CONCRETE
TYP - TYPICAL
MKD - MARKED
CL - CENTER LINE
BOTTOM REINF. (B)
TOP REINF. (T)
SBC - SAFE BEARING CAPACITY
MIN. - MINIMUM
REF. - REFERED
GA - GENERAL ARRANGEMENT
DWG. - DRAWING
R.C.C. - REINFORCED CEMENT CONCRETE

NOTES:

1. ALL DIMENSIONS ARE IN MILLIMETRES AND LEVELS ARE IN METRES UNLESS OTHERWISE STATED
2. GRADE OF CONCRETE SHALL BE C35 (35MPa) UNLESS NOTED OTHERWISE & C15 (15MPa) FOR BLINDING CONCRETE.
3. GRADE OF REINFORCEMENT SHALL BE DEFORMED BAR ASTM A615-GRADE 60 (fy=420MPa)
4. CLEAR COVER TO MAIN REINFORCEMENT SHALL BE AS FOLLOWS:
a) FOUNDATION: 75 mm (BOTTOM & SIDE)
b) FOUNDATION: 50 mm (TOP)
c) COLUMN & PEDESTAL: 50 mm
5. MINIMUM LAP LENGTHS OF REINFORCEMENT SHALL BE 40XBAR DIAMETER
6. FOR STANDARD REINFORCEMENT DETAILS & GENERAL NOTES FOR CIVIL WORKS REFER TO DRAWING NUMBER MD-216-1000-EG-CV-DED-1005 & 1001
7. ANCHOR BOLTS AND EMBEDDED STEELWORK SHALL BE HOT DIP GALVANIZED
8. T.O.C. & TOP OF SCREED TOLERANCE SHALL BE WITHIN +/- 10MM OF DESIGN LEVEL
9. NET SAFE BEARING CAPACITY OF SOIL AT BOTTOM OF FOUNDATION IS CONSIDERED AS 375 KN/SQ.M.
10. REBARS CAN BE MOVED LOCALLY BY +/- 25mm TO AVOID INTERFERENCE WITH EMBEDDED PARTS
C01 11. STEEL GRADE OF EMBEDDED SECTIONS AND PLATES S275JR

KEYPLAN

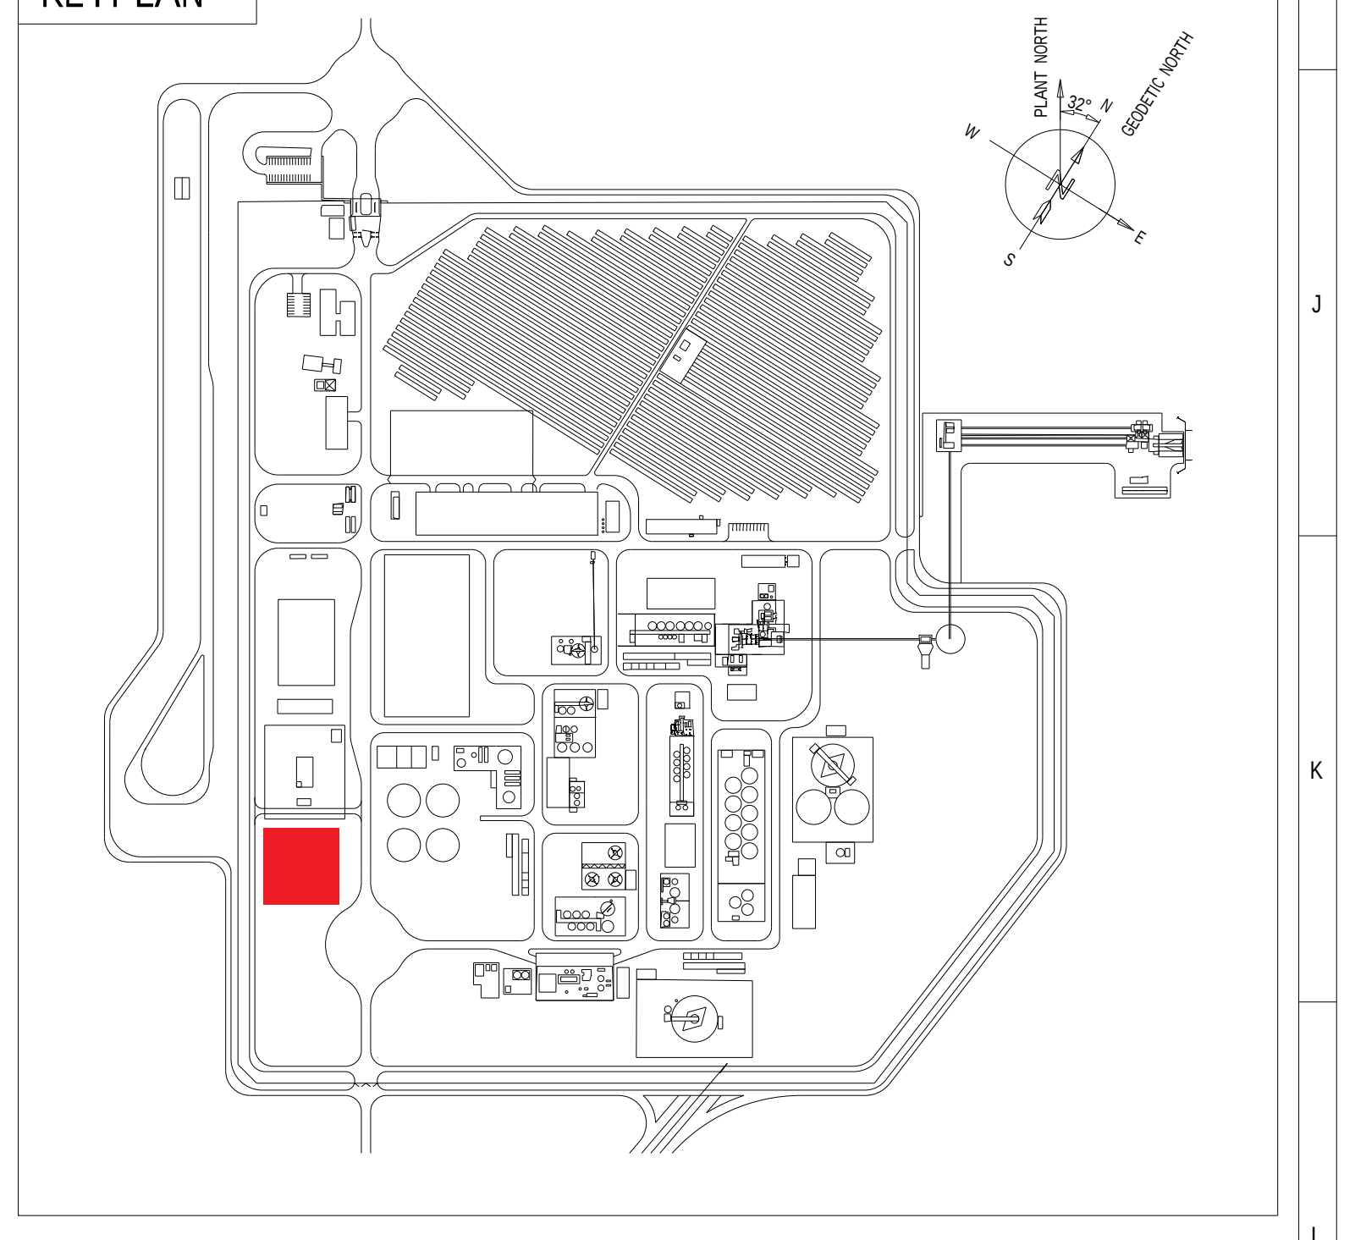

DOCUMENT NUMBER	REFERENCE DOCUMENTS	DOCUMENT NUMBER	REFERENCE DOCUMENTS
MD-216-1000-EG-ST-CRT-1001	DESIGN CRITERIA	MD-216-49W1-EG-CV-CAL-1006	DAF BASIN, COAGULANT BASIN, PIT, SLUDGE BASIN, VESSEL FOUNDATION
MD-216-49W1-EG-CV-GAD-1005	GENERAL ARRANGEMENT DRAWING	MD-216-49W1-EG-CV-DED-1023	REINFORCEMENT DRAWING OF ELECTRICAL PITS

REV	DATE	REVISION DESCRIPTION	DRN	CHK	ENG	APP	EMP
D01	29.01.2024	AS-BUILT	NikJan	MauNot	LuiPiz	SouCha	
C01	10.02.2022	ISSUED FOR CONSTRUCTION	NikJan	MauNot	LuiPiz	SouCha	
A01	14.01.2022	ISSUED FOR APPROVAL	EvgPon	MauNot	NanWu	LuiPiz	

RESERVED FOR VENDOR LOGO AND DRAWING NUMBER

LARSEN & TOUBRO

This drawing is the property of LARSEN & TOUBRO and must not be passed on to any person or body not authorized by us to recieve it or be copied or otherwise made use either in full or in part by such person or body without our prior permission in writing.

Outotec

The content of these documents are the sole property of Outotec Oyj. Any rights not expressly granted herein are reserved. Reproduction, transfer or distribution of part or all of the contents in any form without prior written permission of Outotec is prohibited.

MA'ADEN معادن
Saudi Arabian Mining Company شركة التعدين العربية السعودية

This document and the information contained herein is Ma'aden proprietary know-how. This document or any part thereof should not be reproduced, stored in a retrieval system or transmitted by any means, electronic or otherwise, or divulged without prior written permission of Ma'aden.

LARSEN & TOUBRO DRAWING NUMBER
O19045_080_C_D_24892_008
REVISION 2

OUTOTEC DRAWING NUMBER
900707_GAU01_AG11_CTB01_49008
DOCUMENT ID
OU100732640
REVISION 2

DRAWN	EvgPon	14.01.2022
CHECKED	MauNot	14.01.2022
ENGINEER	NanWu	14.01.2022
APPROVED	LuiPiz	14.01.2022
EMPLOYER		
SCALE	1:30	A0

MANSOURAH - MASSARAH GOLD PROJECT
RAW WATER TREATMENT PLANT
PRECAST VALVE PITS
DETAIL- AND REINFORCEMENT DRAWING

DRAWING NUMBER
MD-216-49W1-EG-CV-DED-1008
REV
D01

Tekla Structures