REV D01 DRAWING NUMBER MD-216-49W1-EG-CV-DED-1009

DETAIL OF SLUDGE BASIN WALL
(SCALE 1:50)

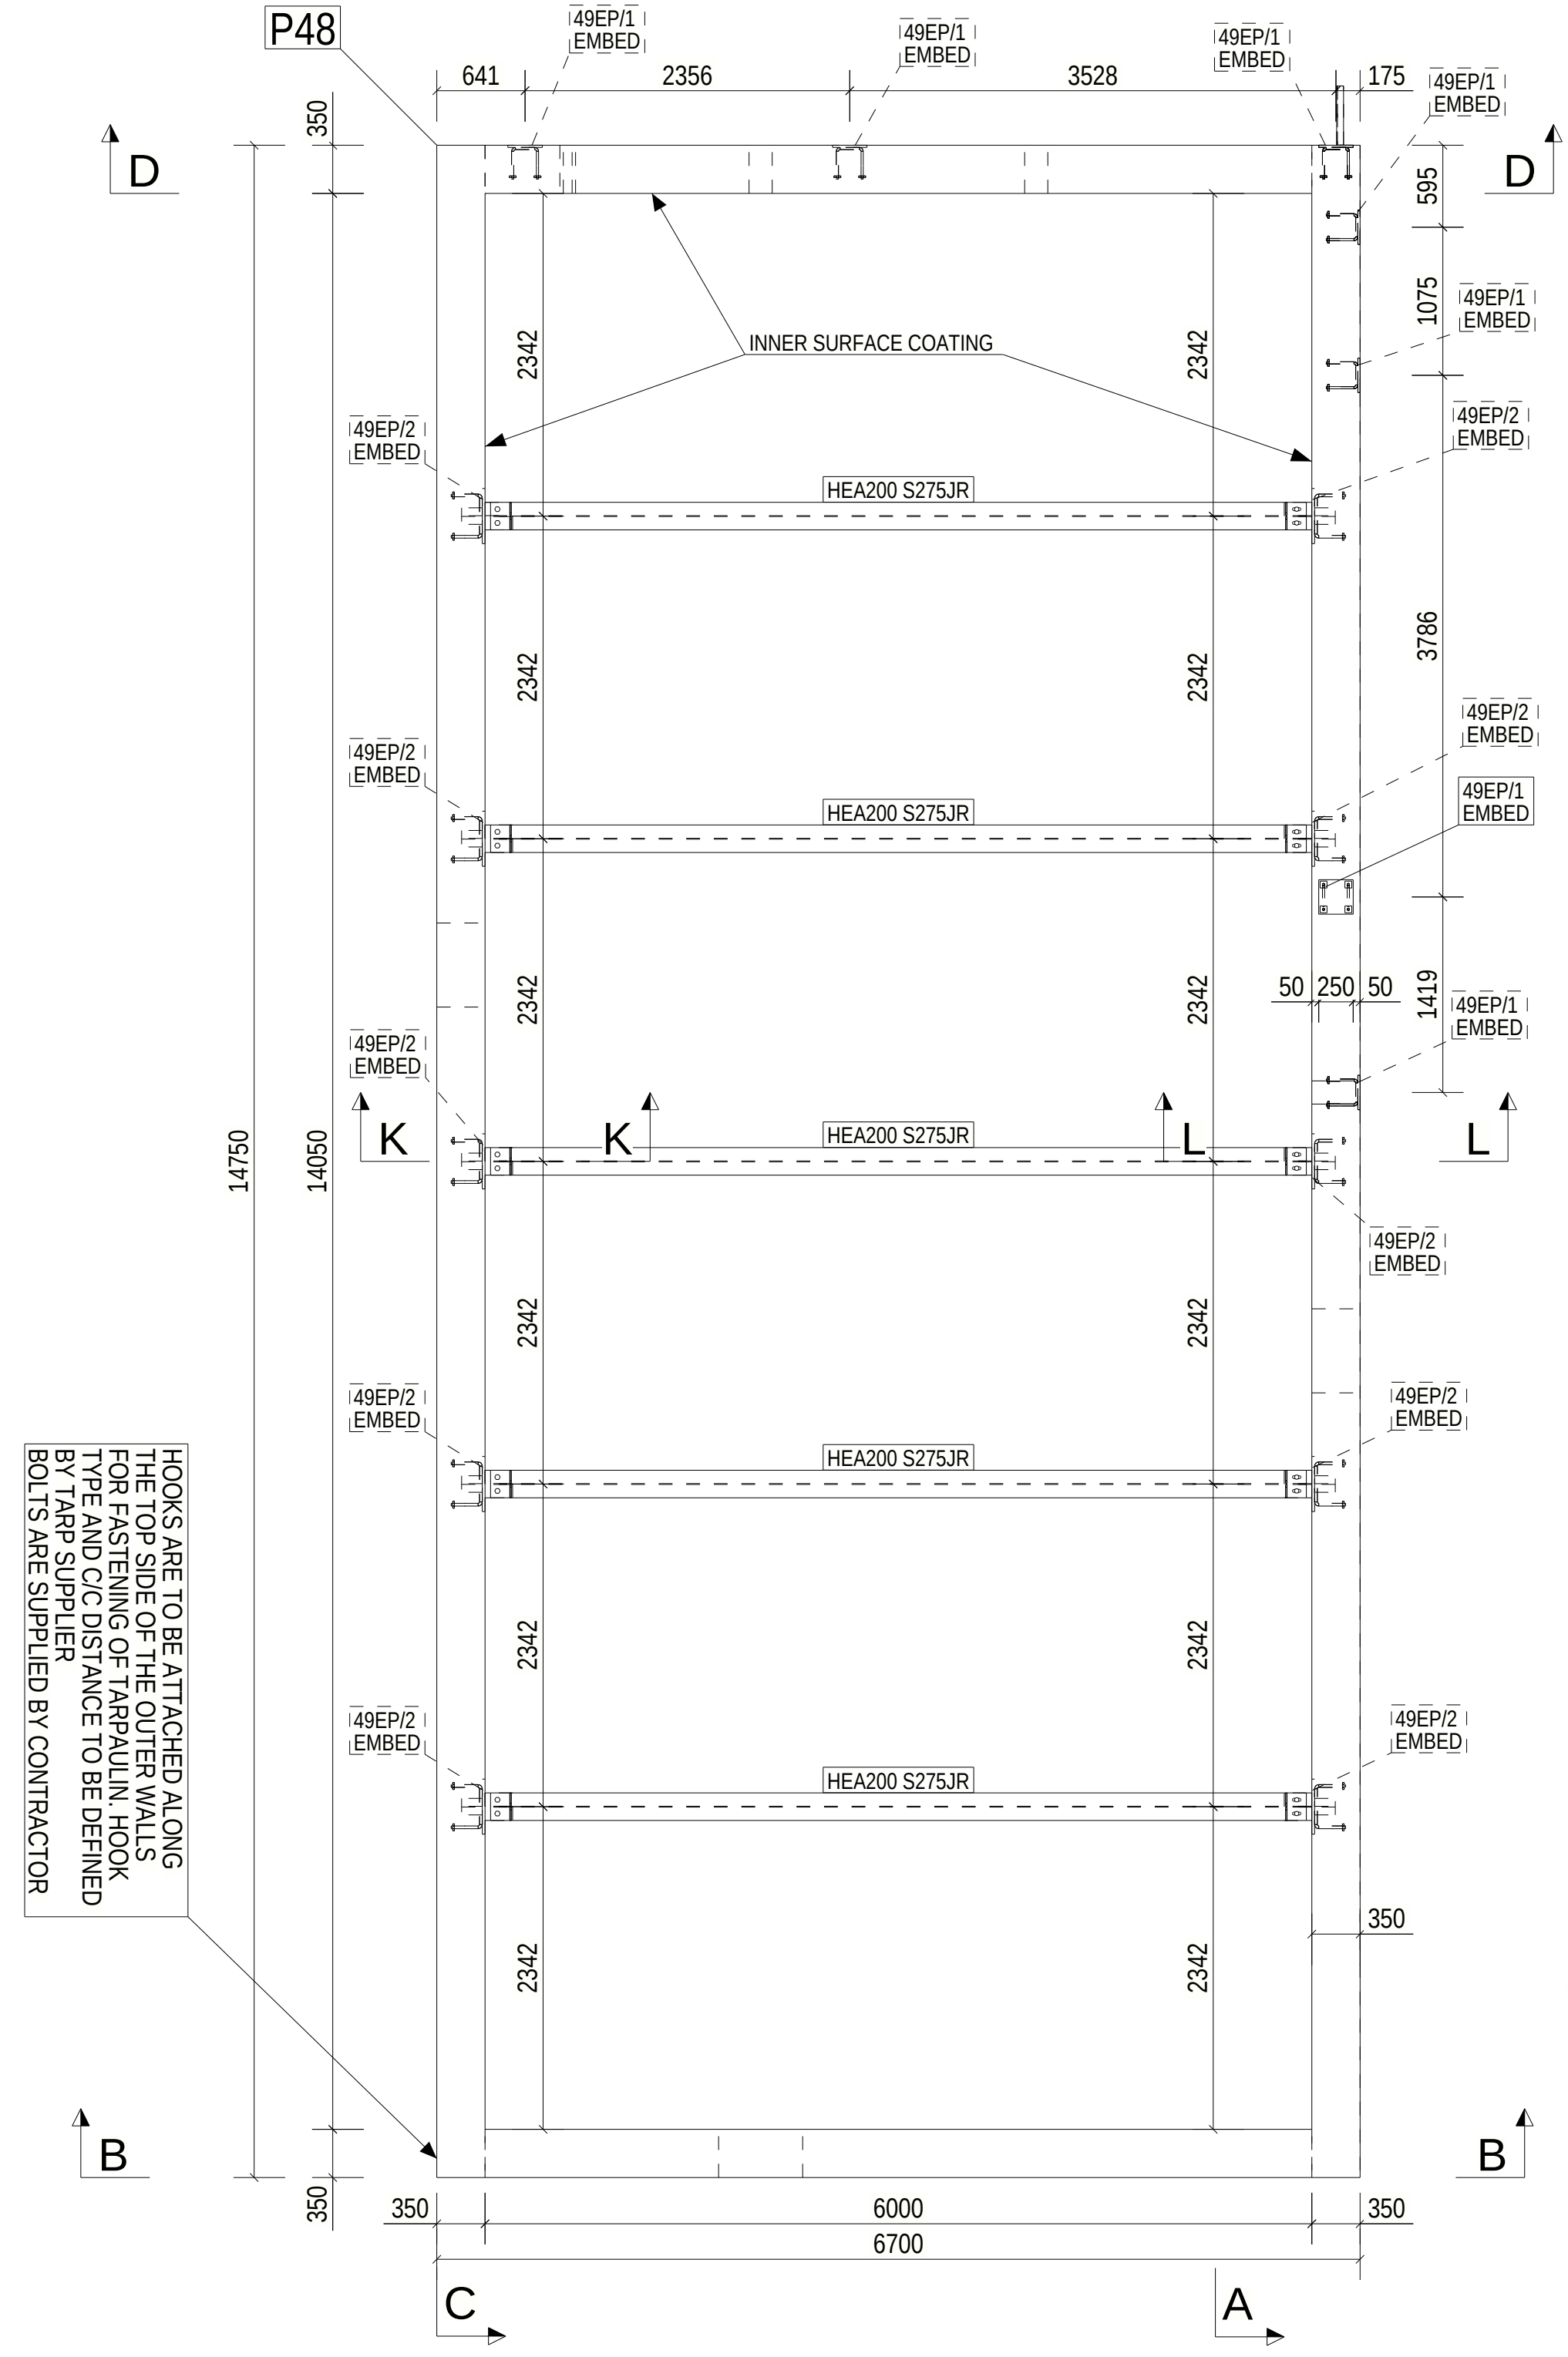
P48
C
A
D
D
K
K
L
L
B
B
C
A
641
2356
3528
175
49EP/1 EMBED
49EP/2 EMBED
INNER SURFACE COATING
HEA200 S275JR
2342
14750
14050
6000
6700
350
HOOKS ARE TO BE ATTACHED ALONG THE TOP SIDE OF THE OUTER WALLS FOR FASTENING OF TARPAULIN. HOOK TYPE AND C/C DISTANCE TO BE DEFINED BY TARP SUPPLIER BOLTS ARE SUPPLIED BY CONTRACTOR

SECTION : B - B
(SCALE 1:50)

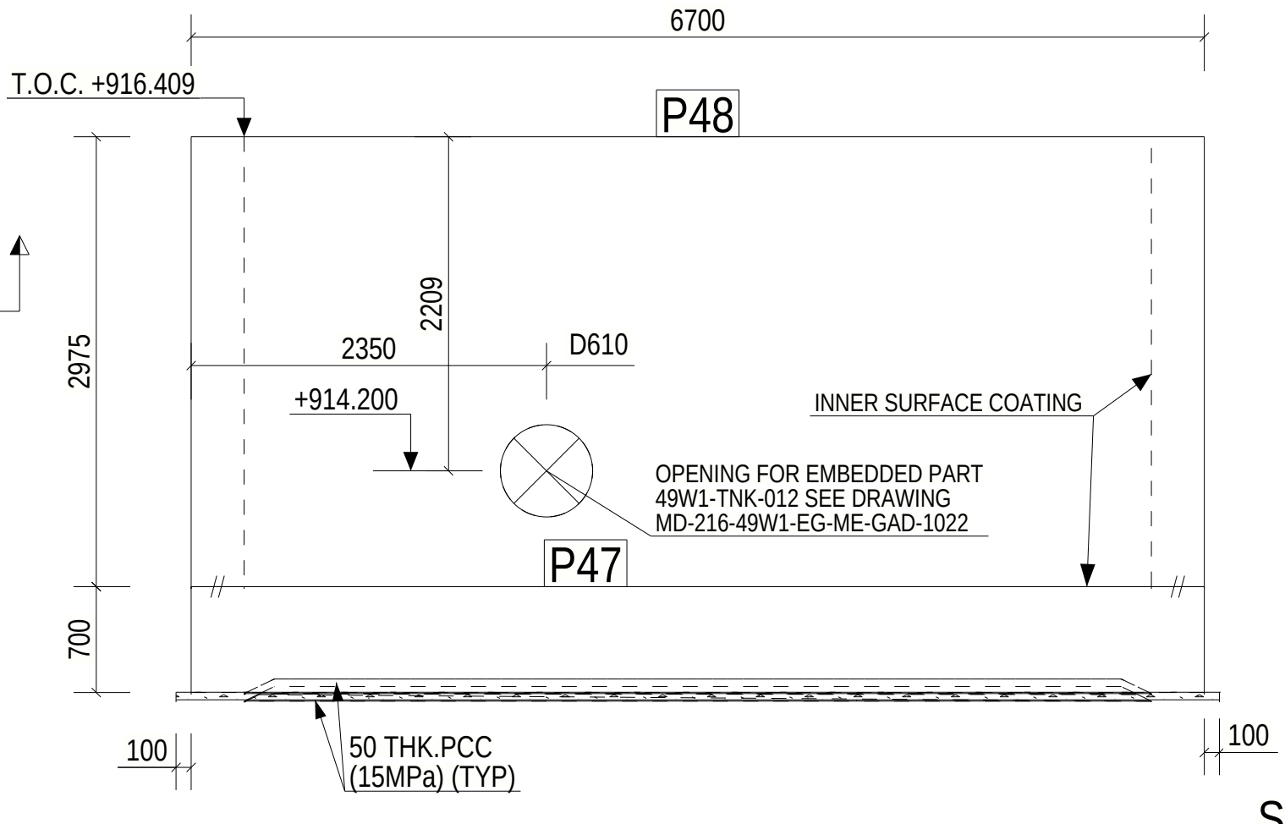

SECTION : D - D
(SCALE 1:50)

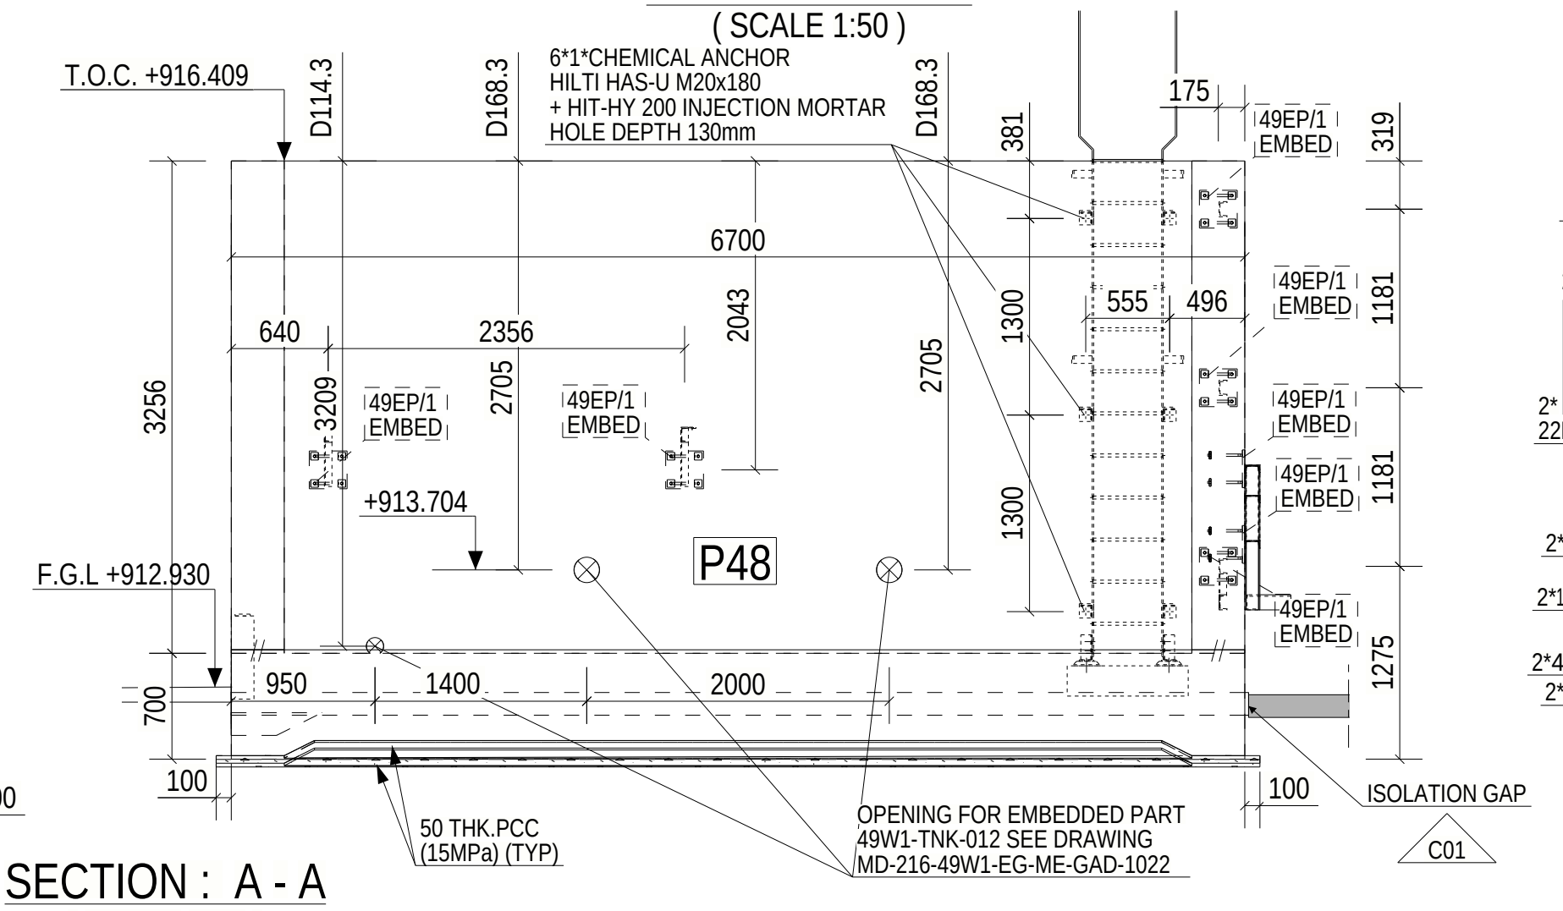

SECTION : A - A
(SCALE 1:50)

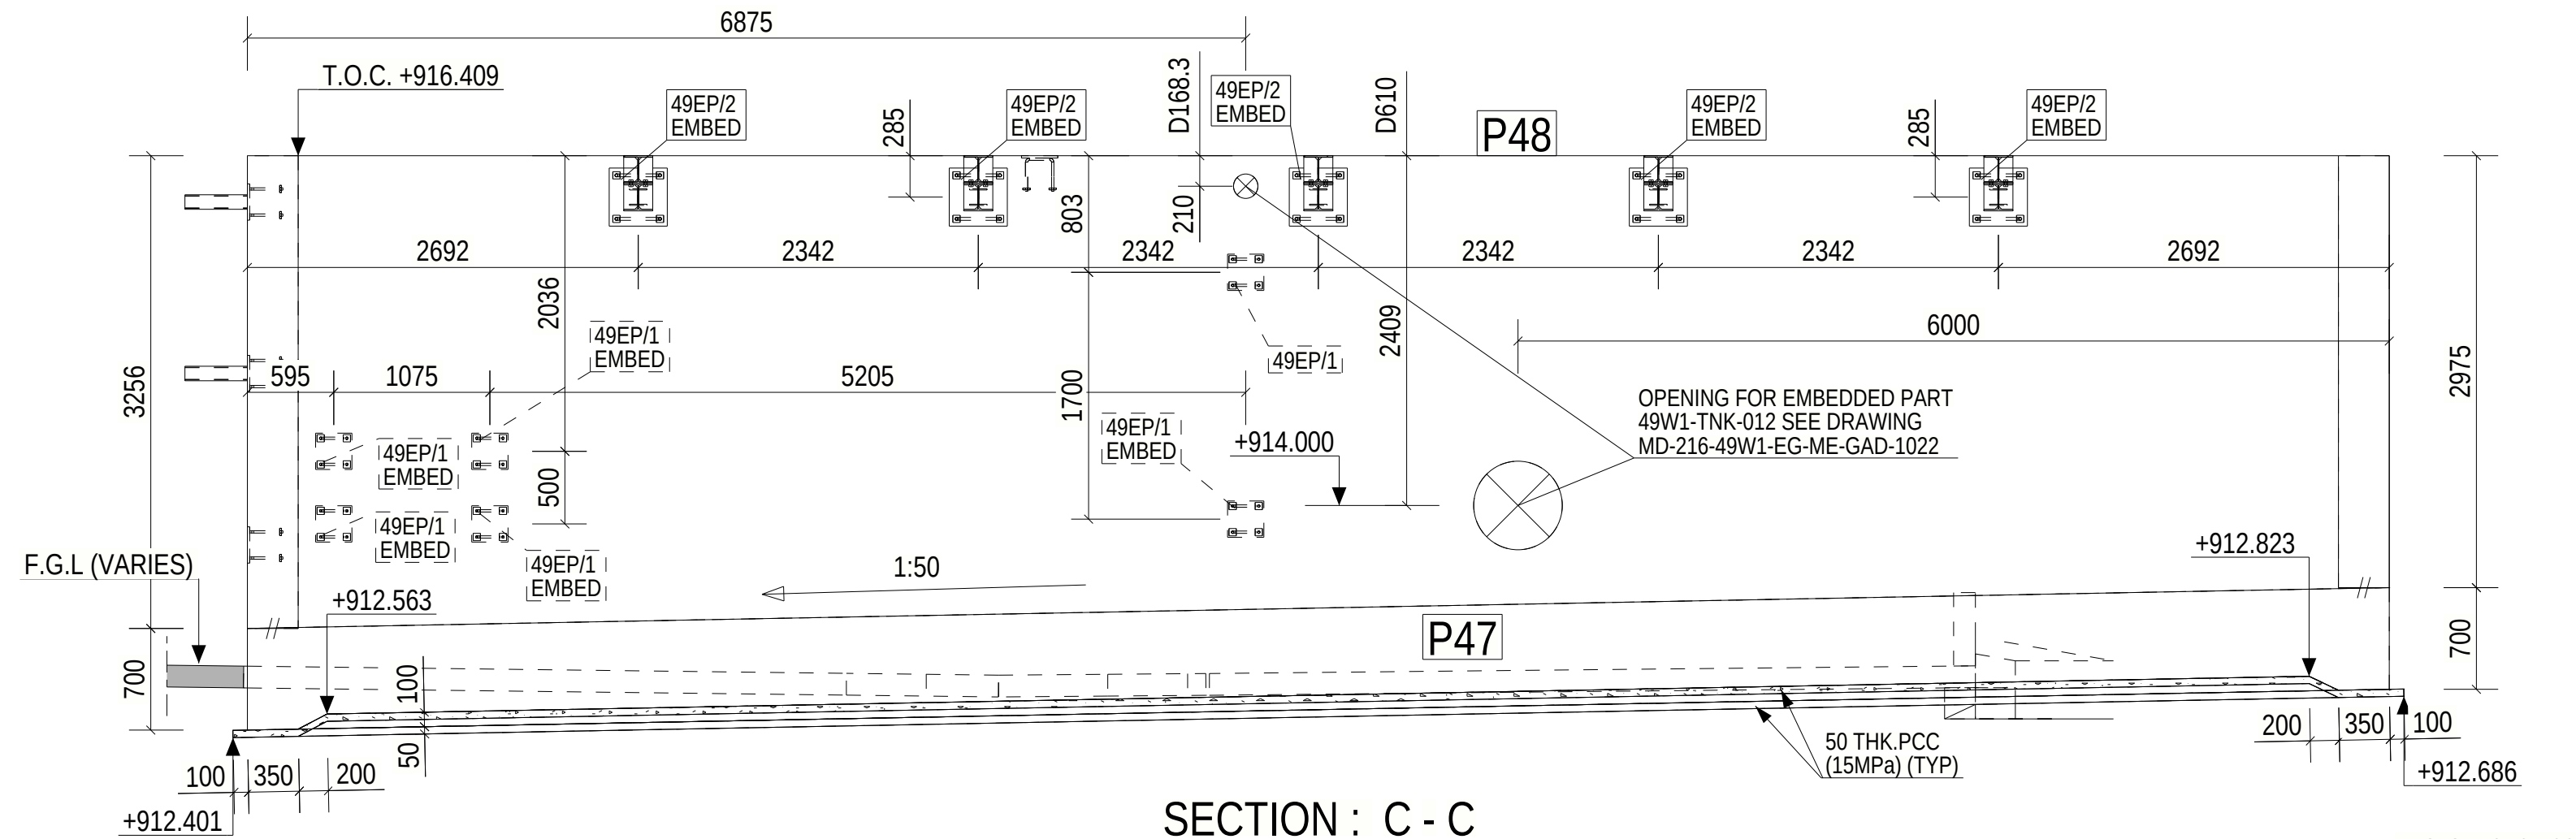

SECTION : C - C
(SCALE 1:50)

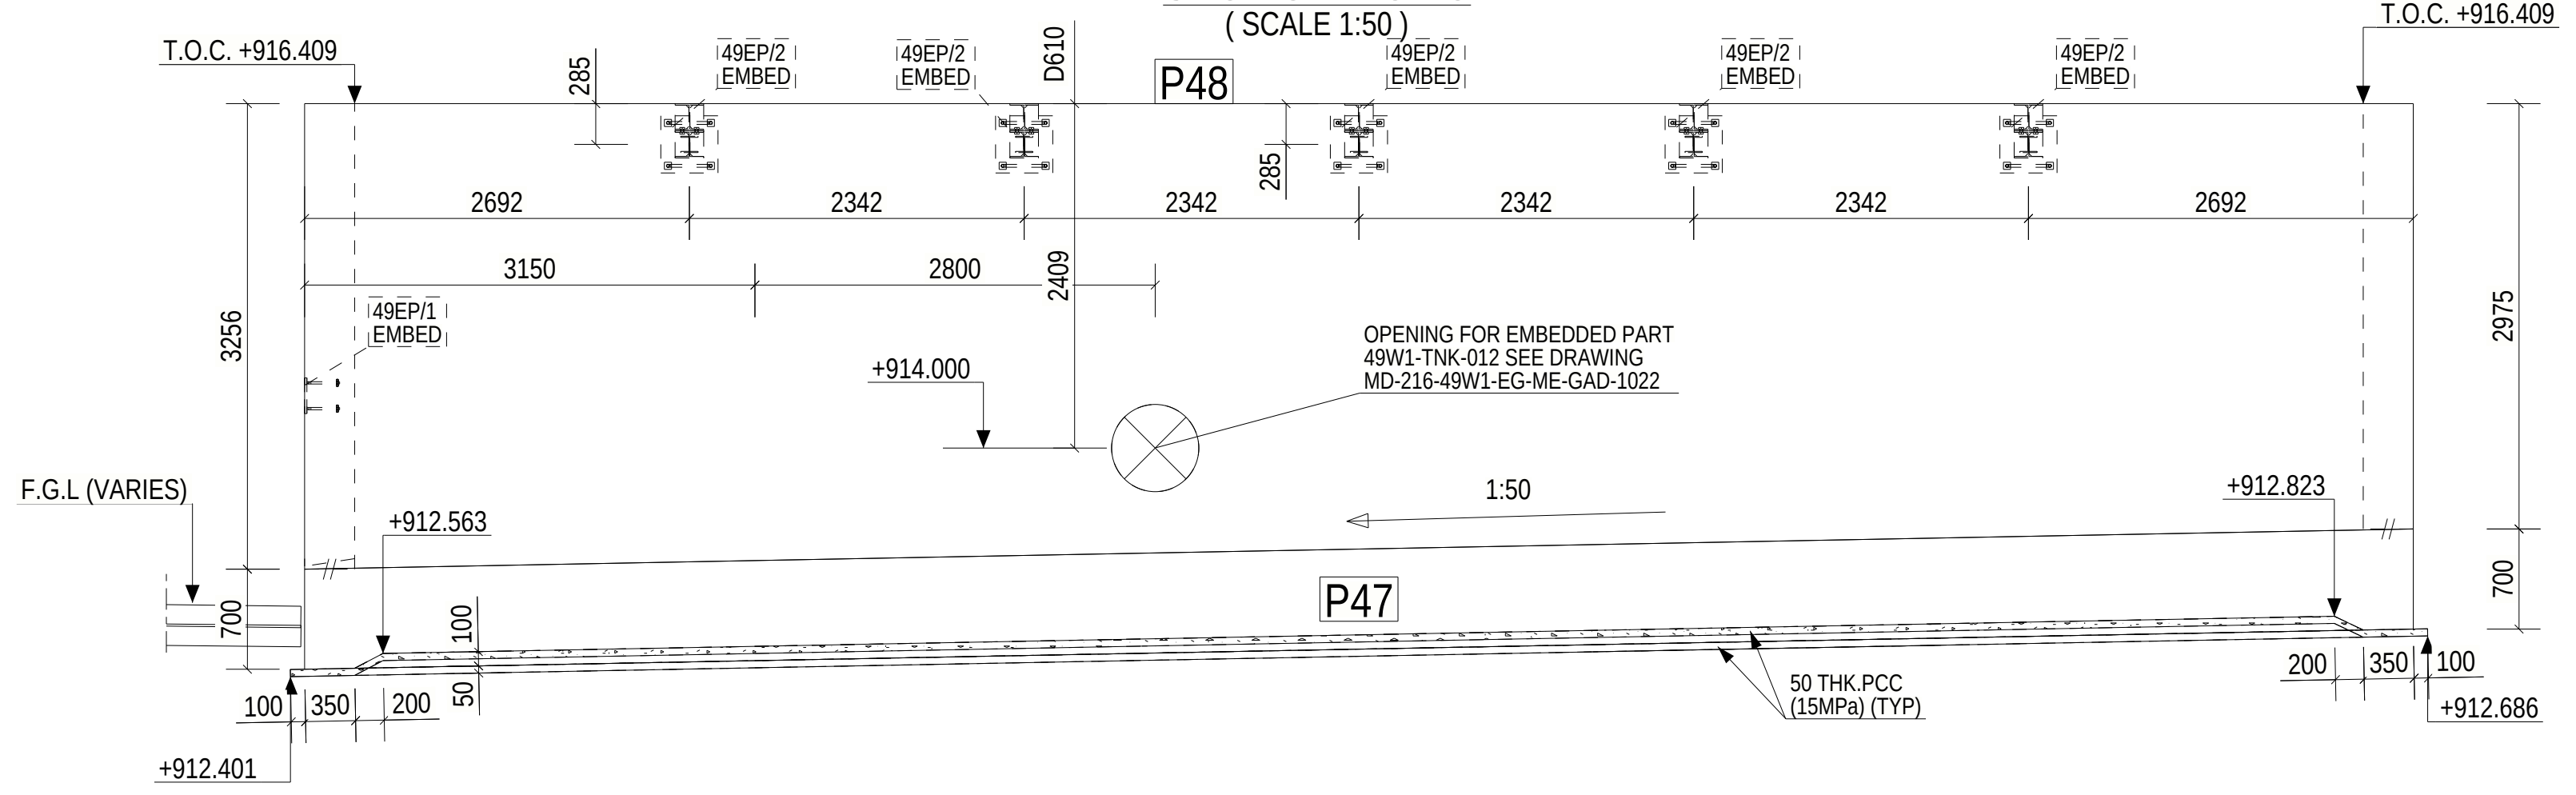

SECTION : E - E
(SCALE 1:50)

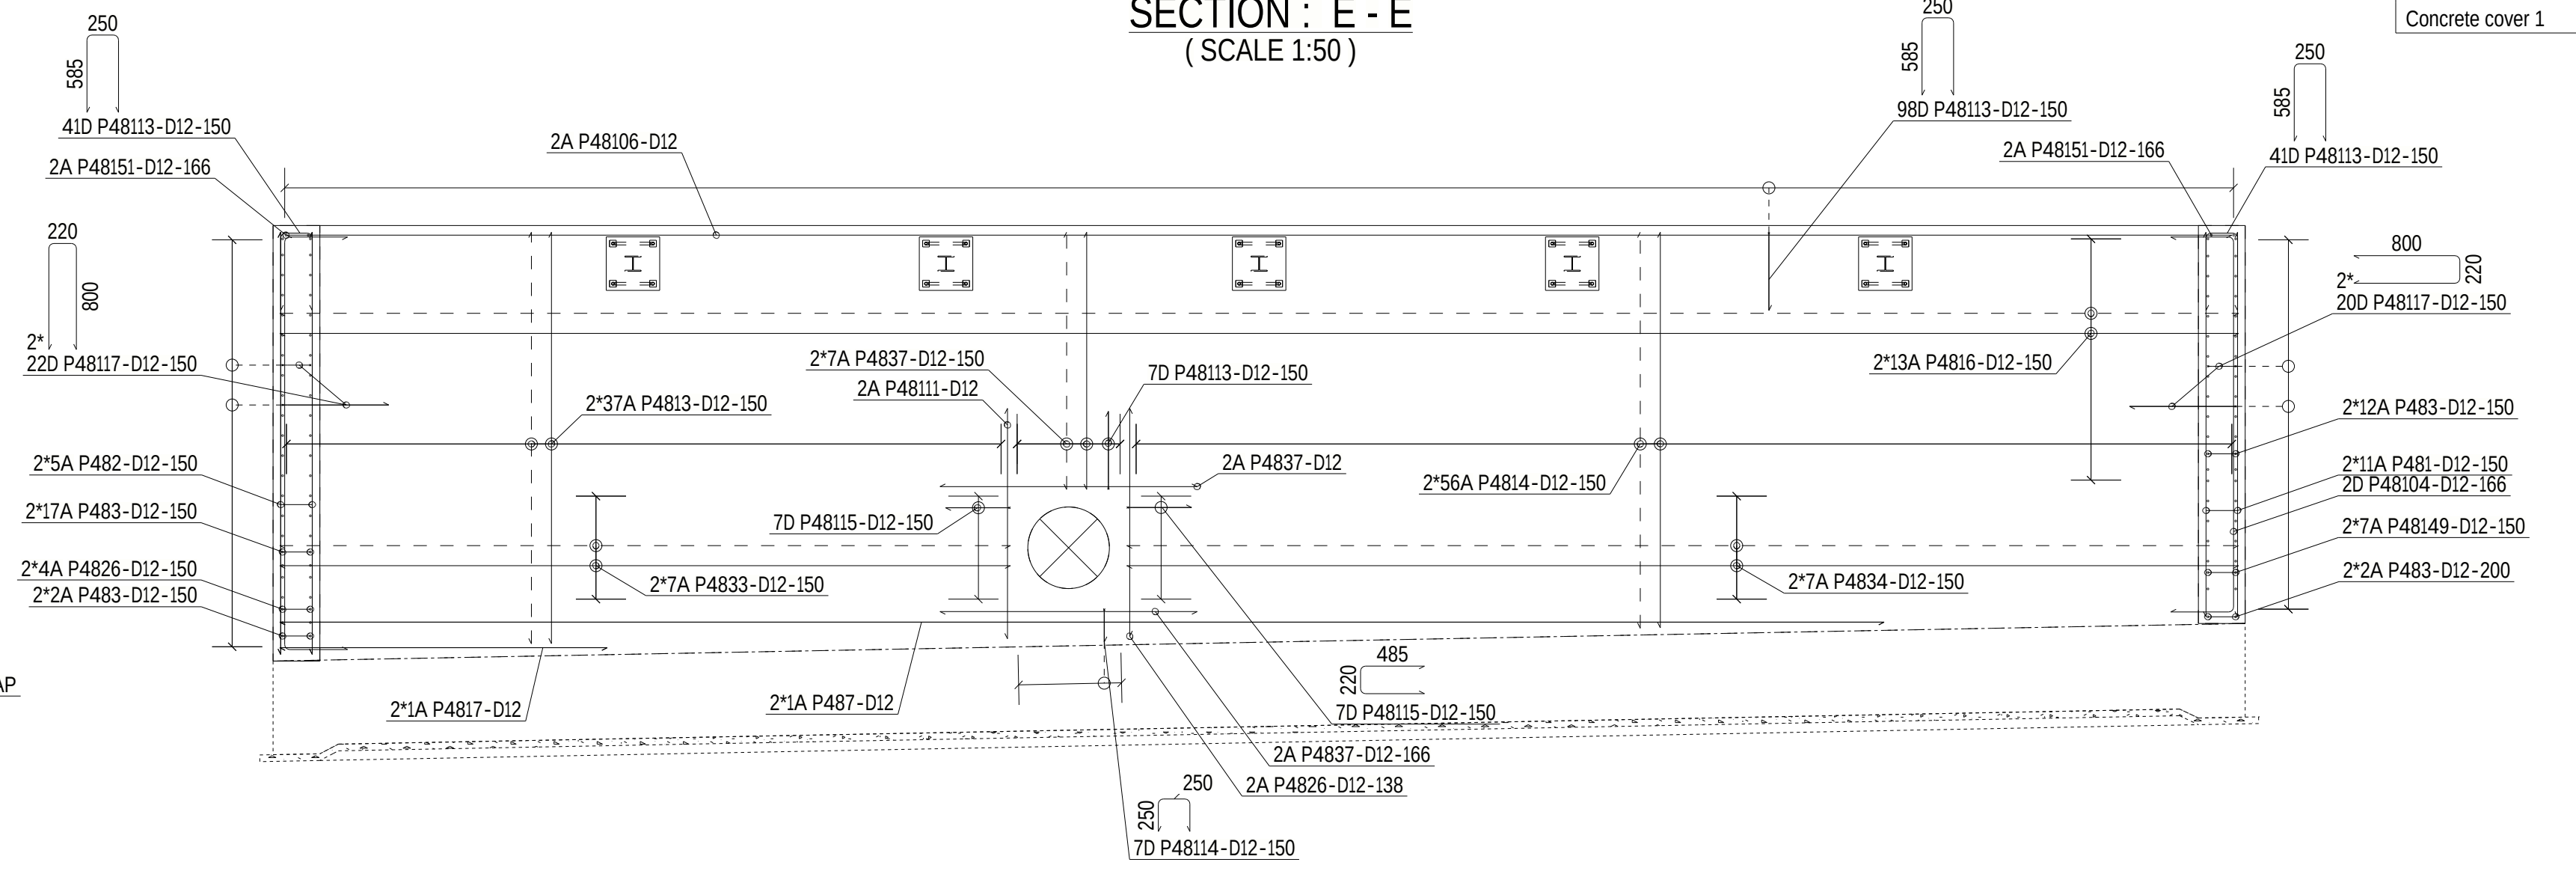

SECTION : F - F
(SCALE 1:50)

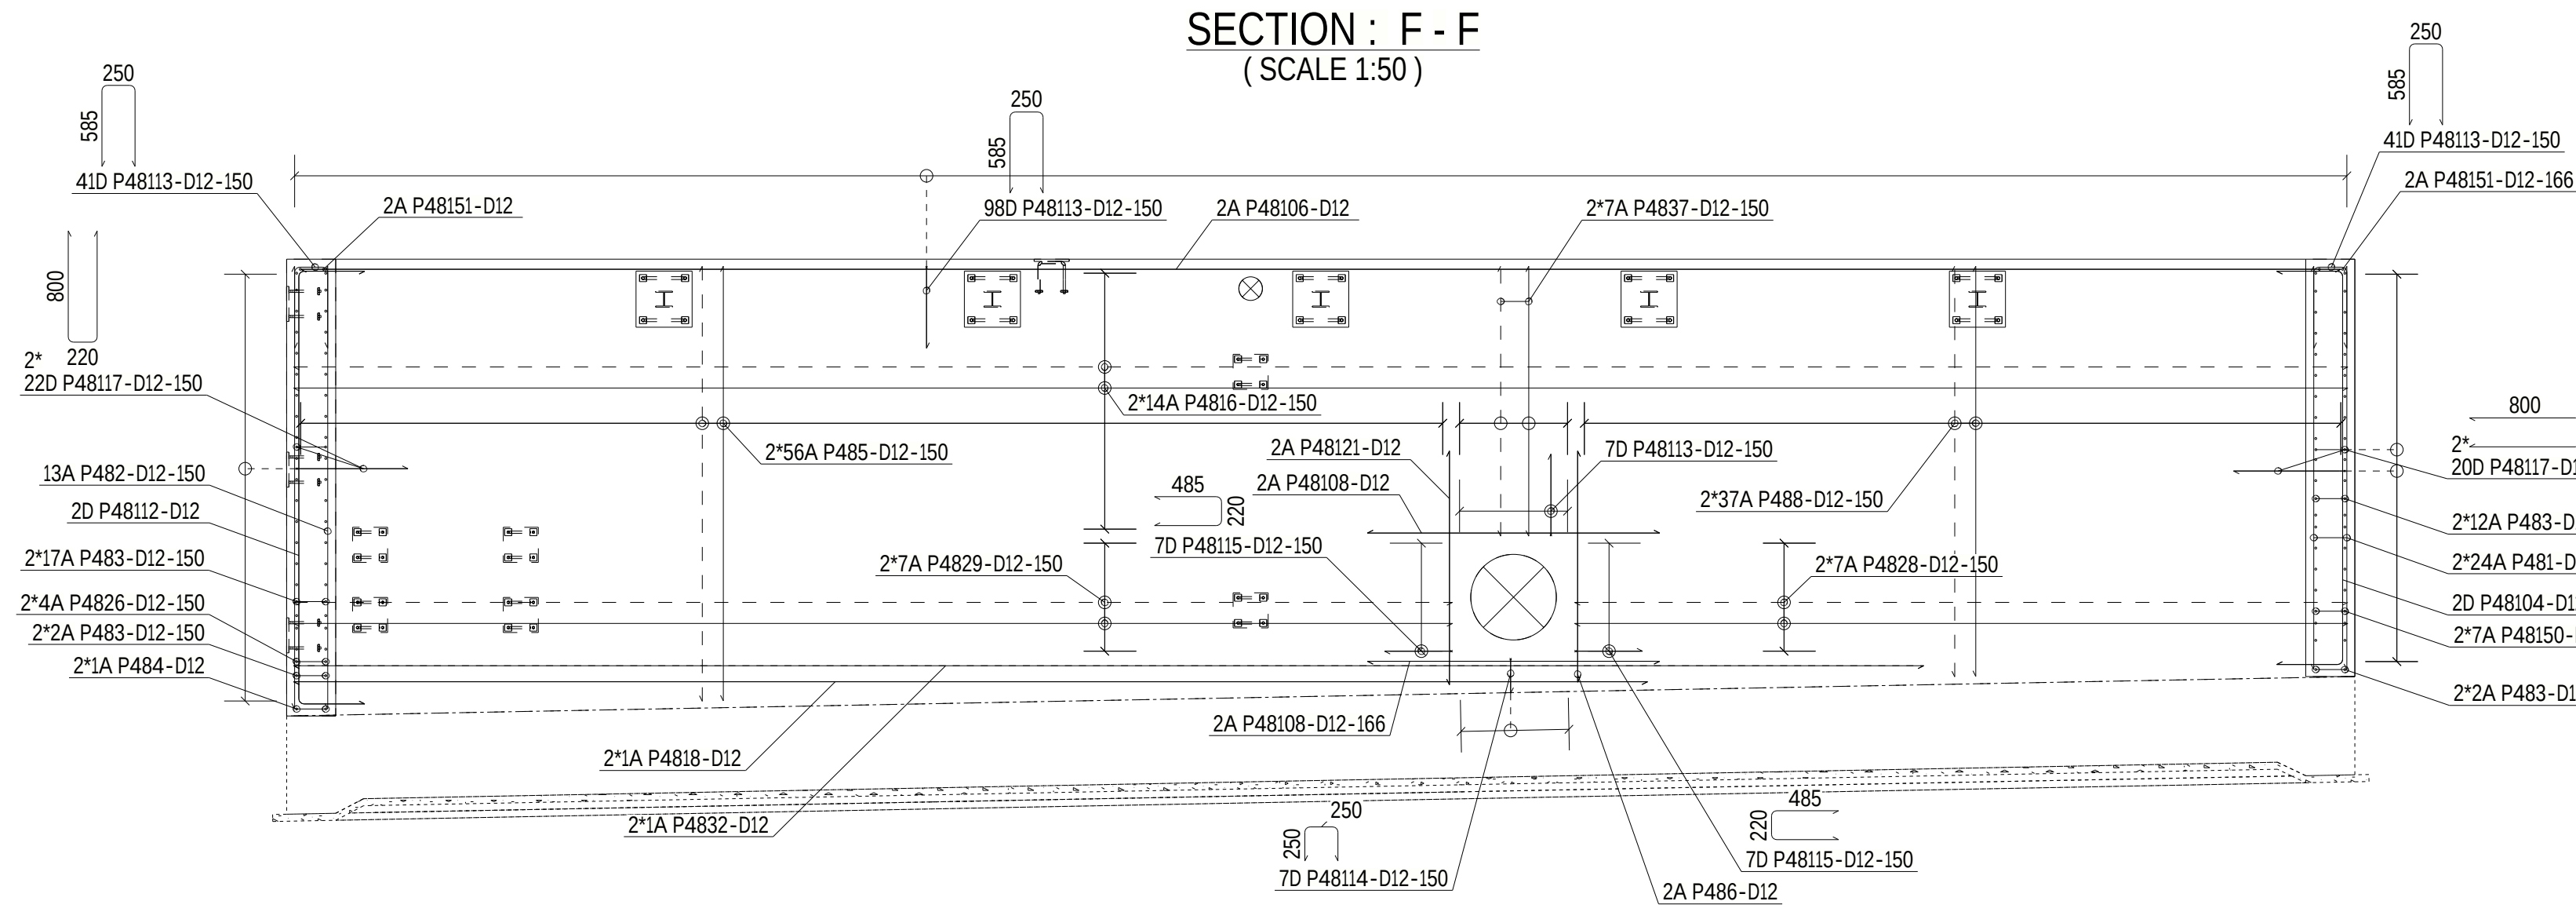

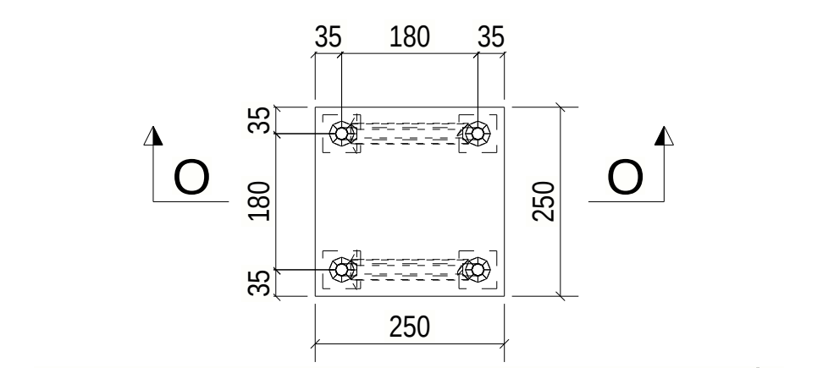

DETAIL OF EMBEDDED PLATE 49EP/1
(SCALE 1:10)

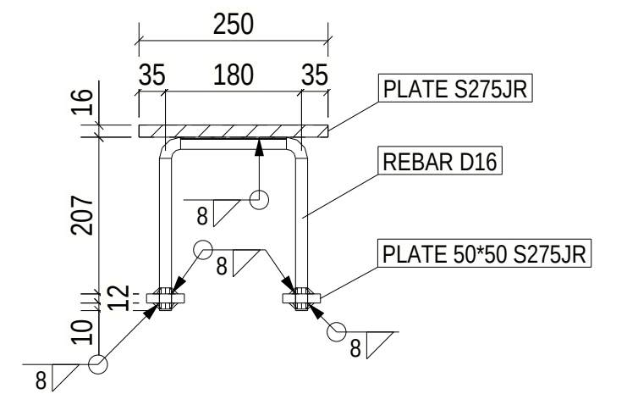

SECTION : O - O
(SCALE 1:10)

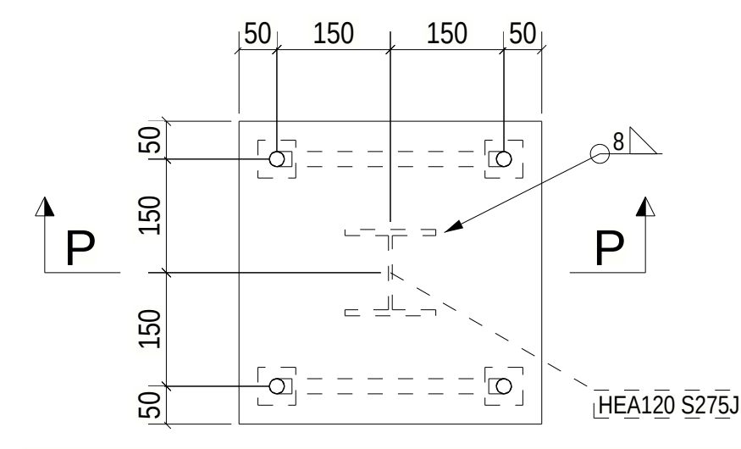

DETAIL OF EMBEDDED PLATE 49EP/2
(SCALE 1:10)

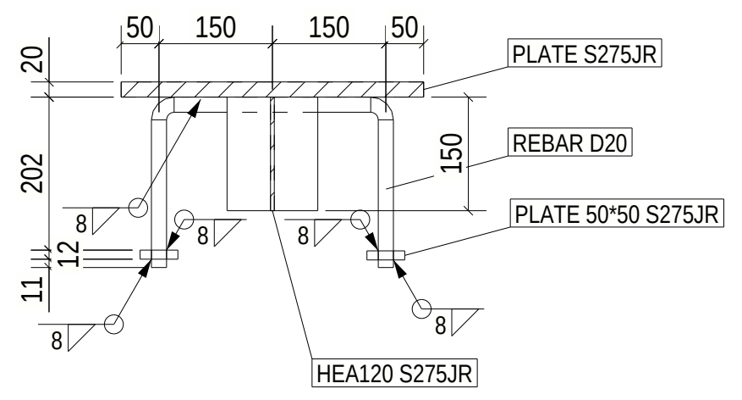

SECTION : P - P
(SCALE 1:10)

SECTION : N - N
(SCALE 1:30)

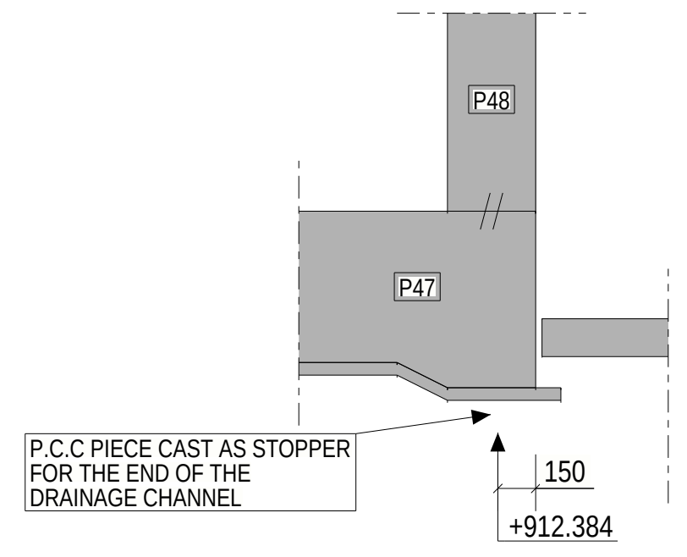
P48
P47
P.C.C PIECE CAST AS STOPPER FOR THE END OF THE DRAINAGE CHANNEL
150
+912.384

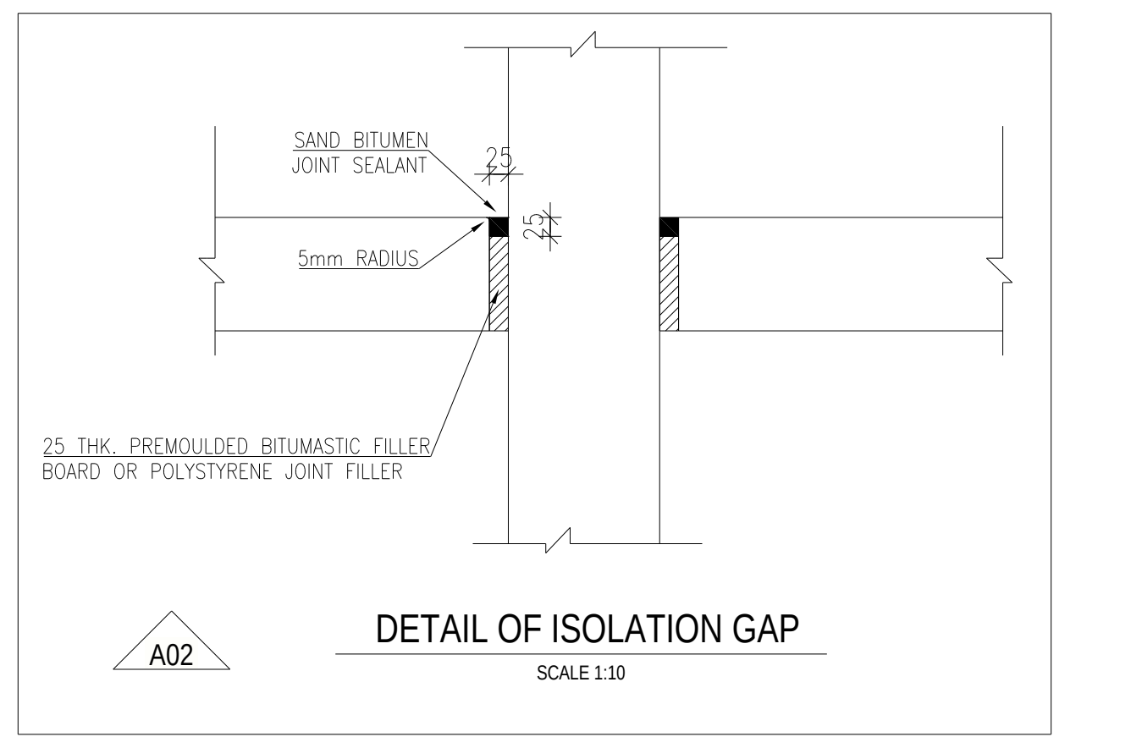
SAND BITUMEN JOINT SEALANT
25
25
5mm RADIUS
25 THK. PREMOULDED BITUMASTIC FILLER BOARD OR POLYSTYRENE JOINT FILLER
A02

DETAIL OF ISOLATION GAP
SCALE 1:10

R.C.C. DETAIL OF SLUDGE BASIN GROUND SLAB
(SCALE 1:50)

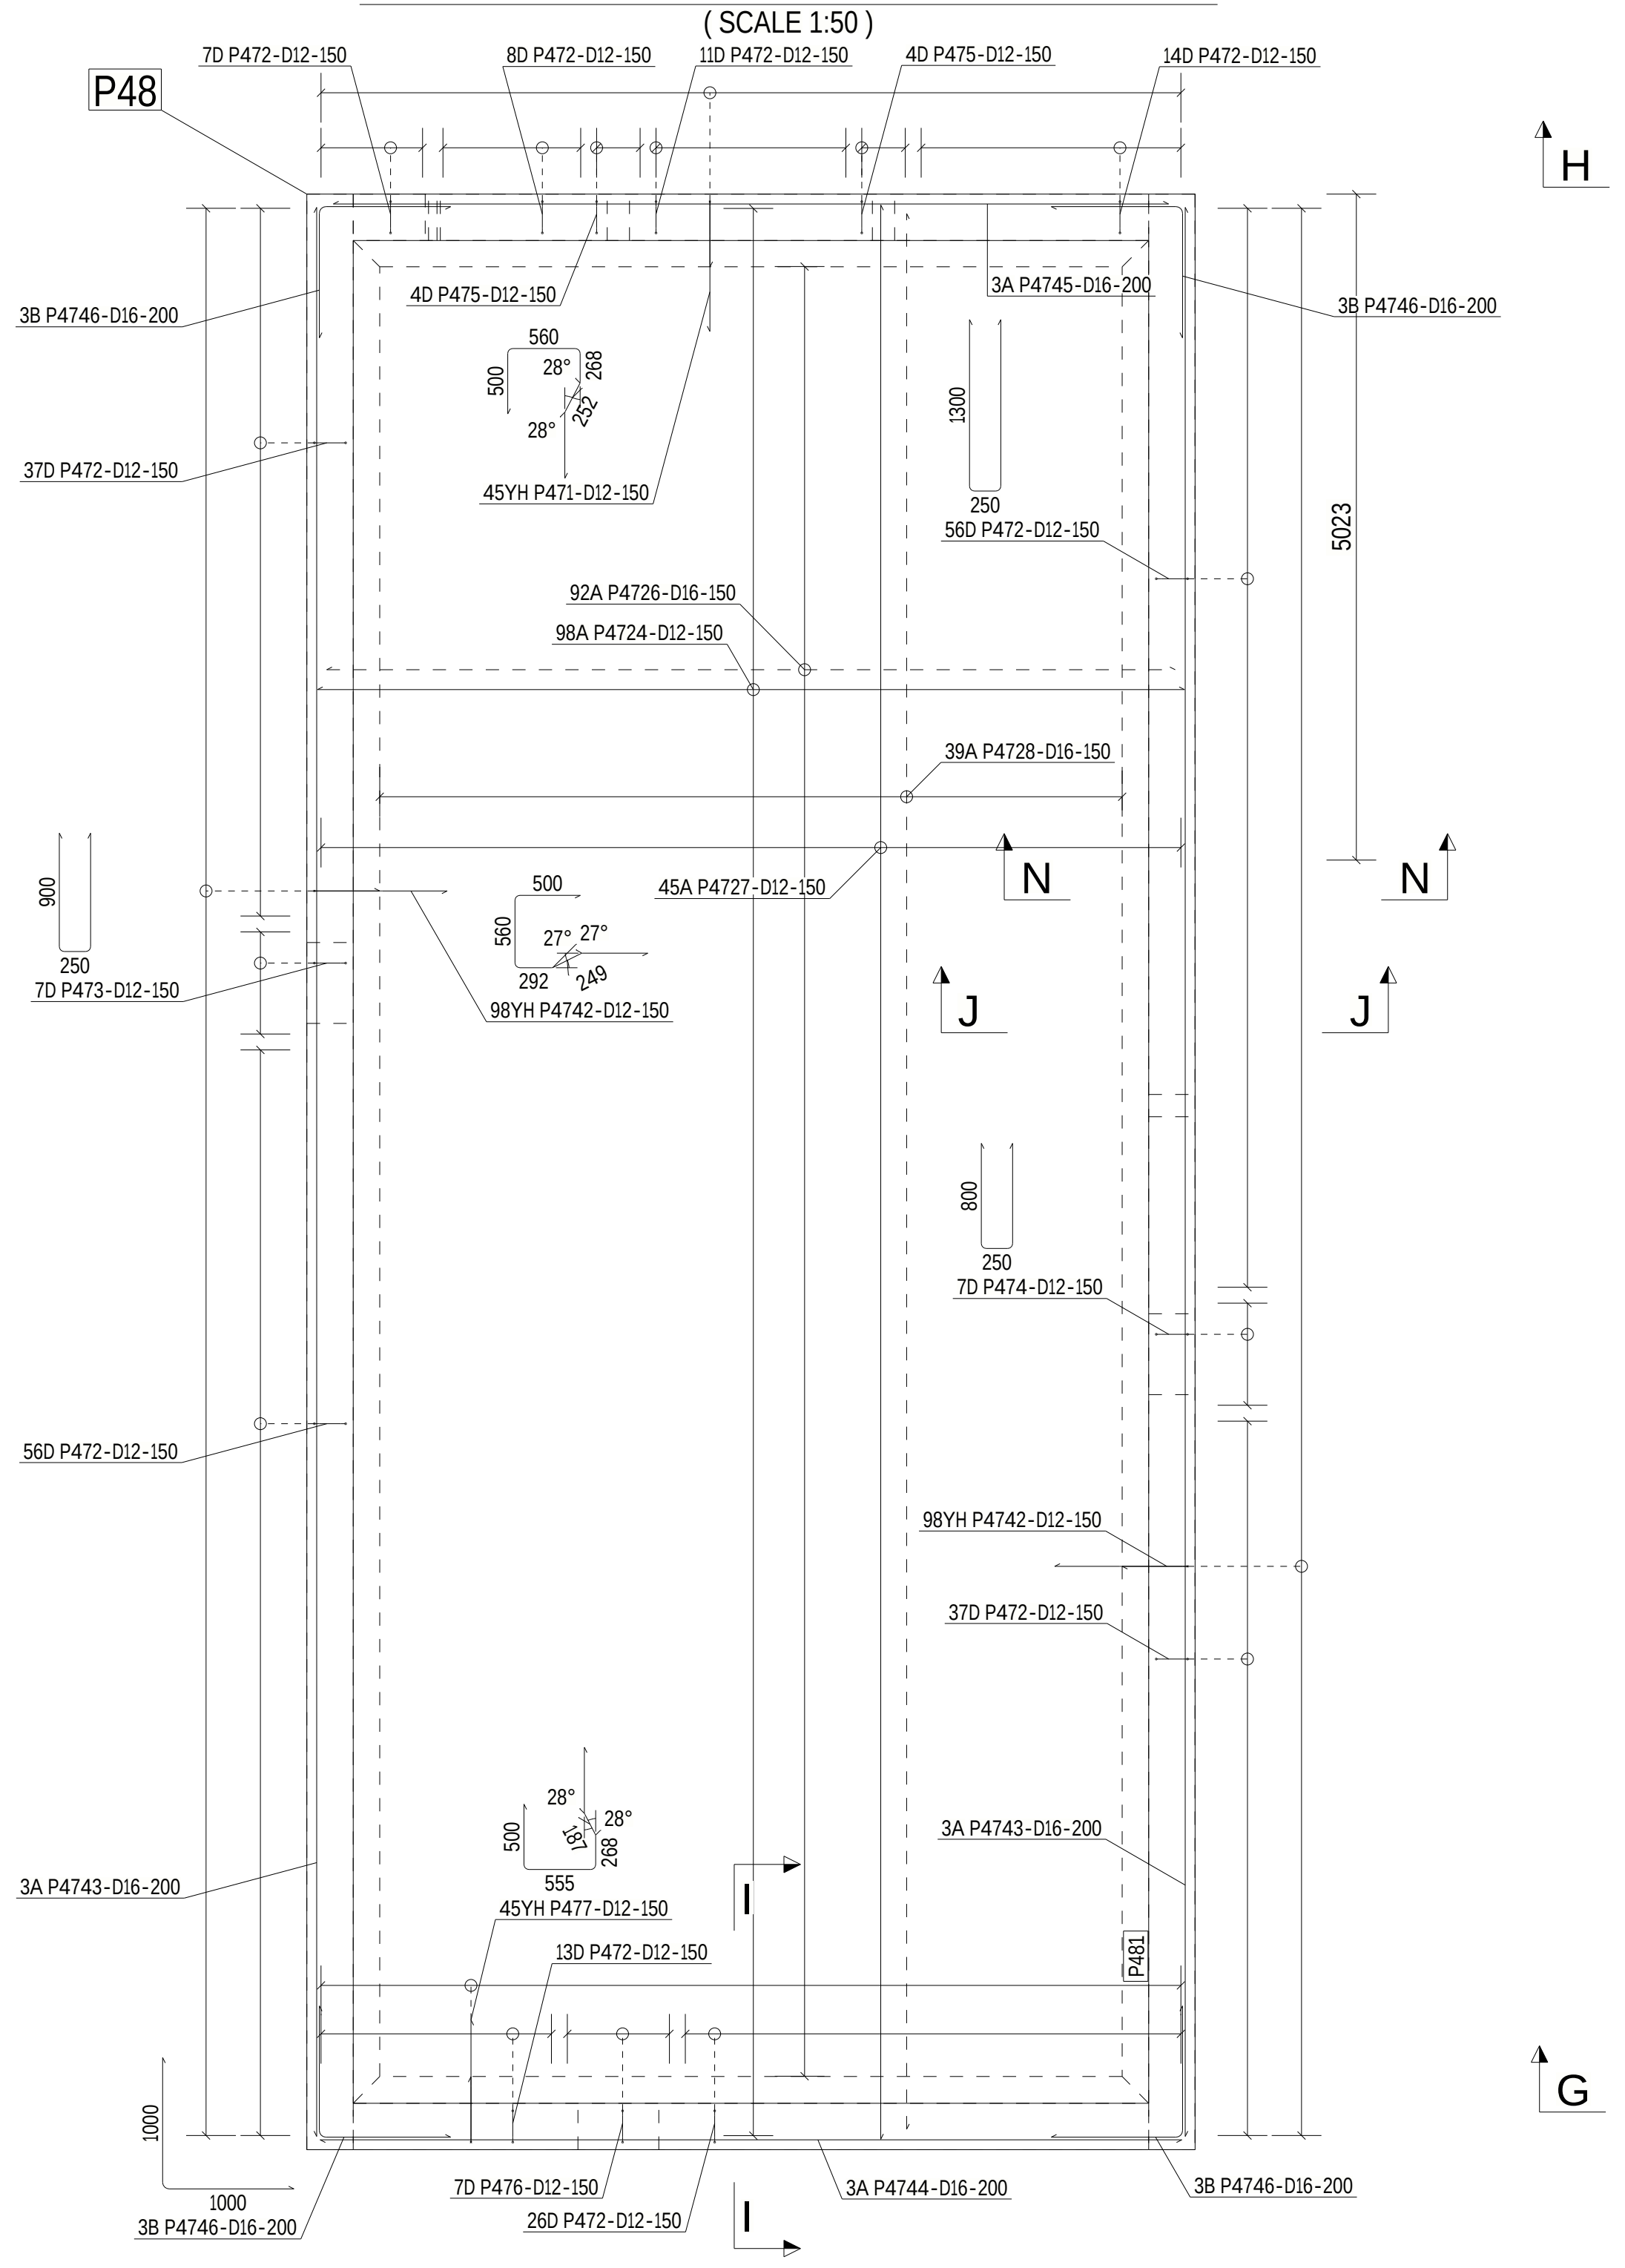

DETAIL OF SLUDGE BASIN WALL
(SCALE 1:50)

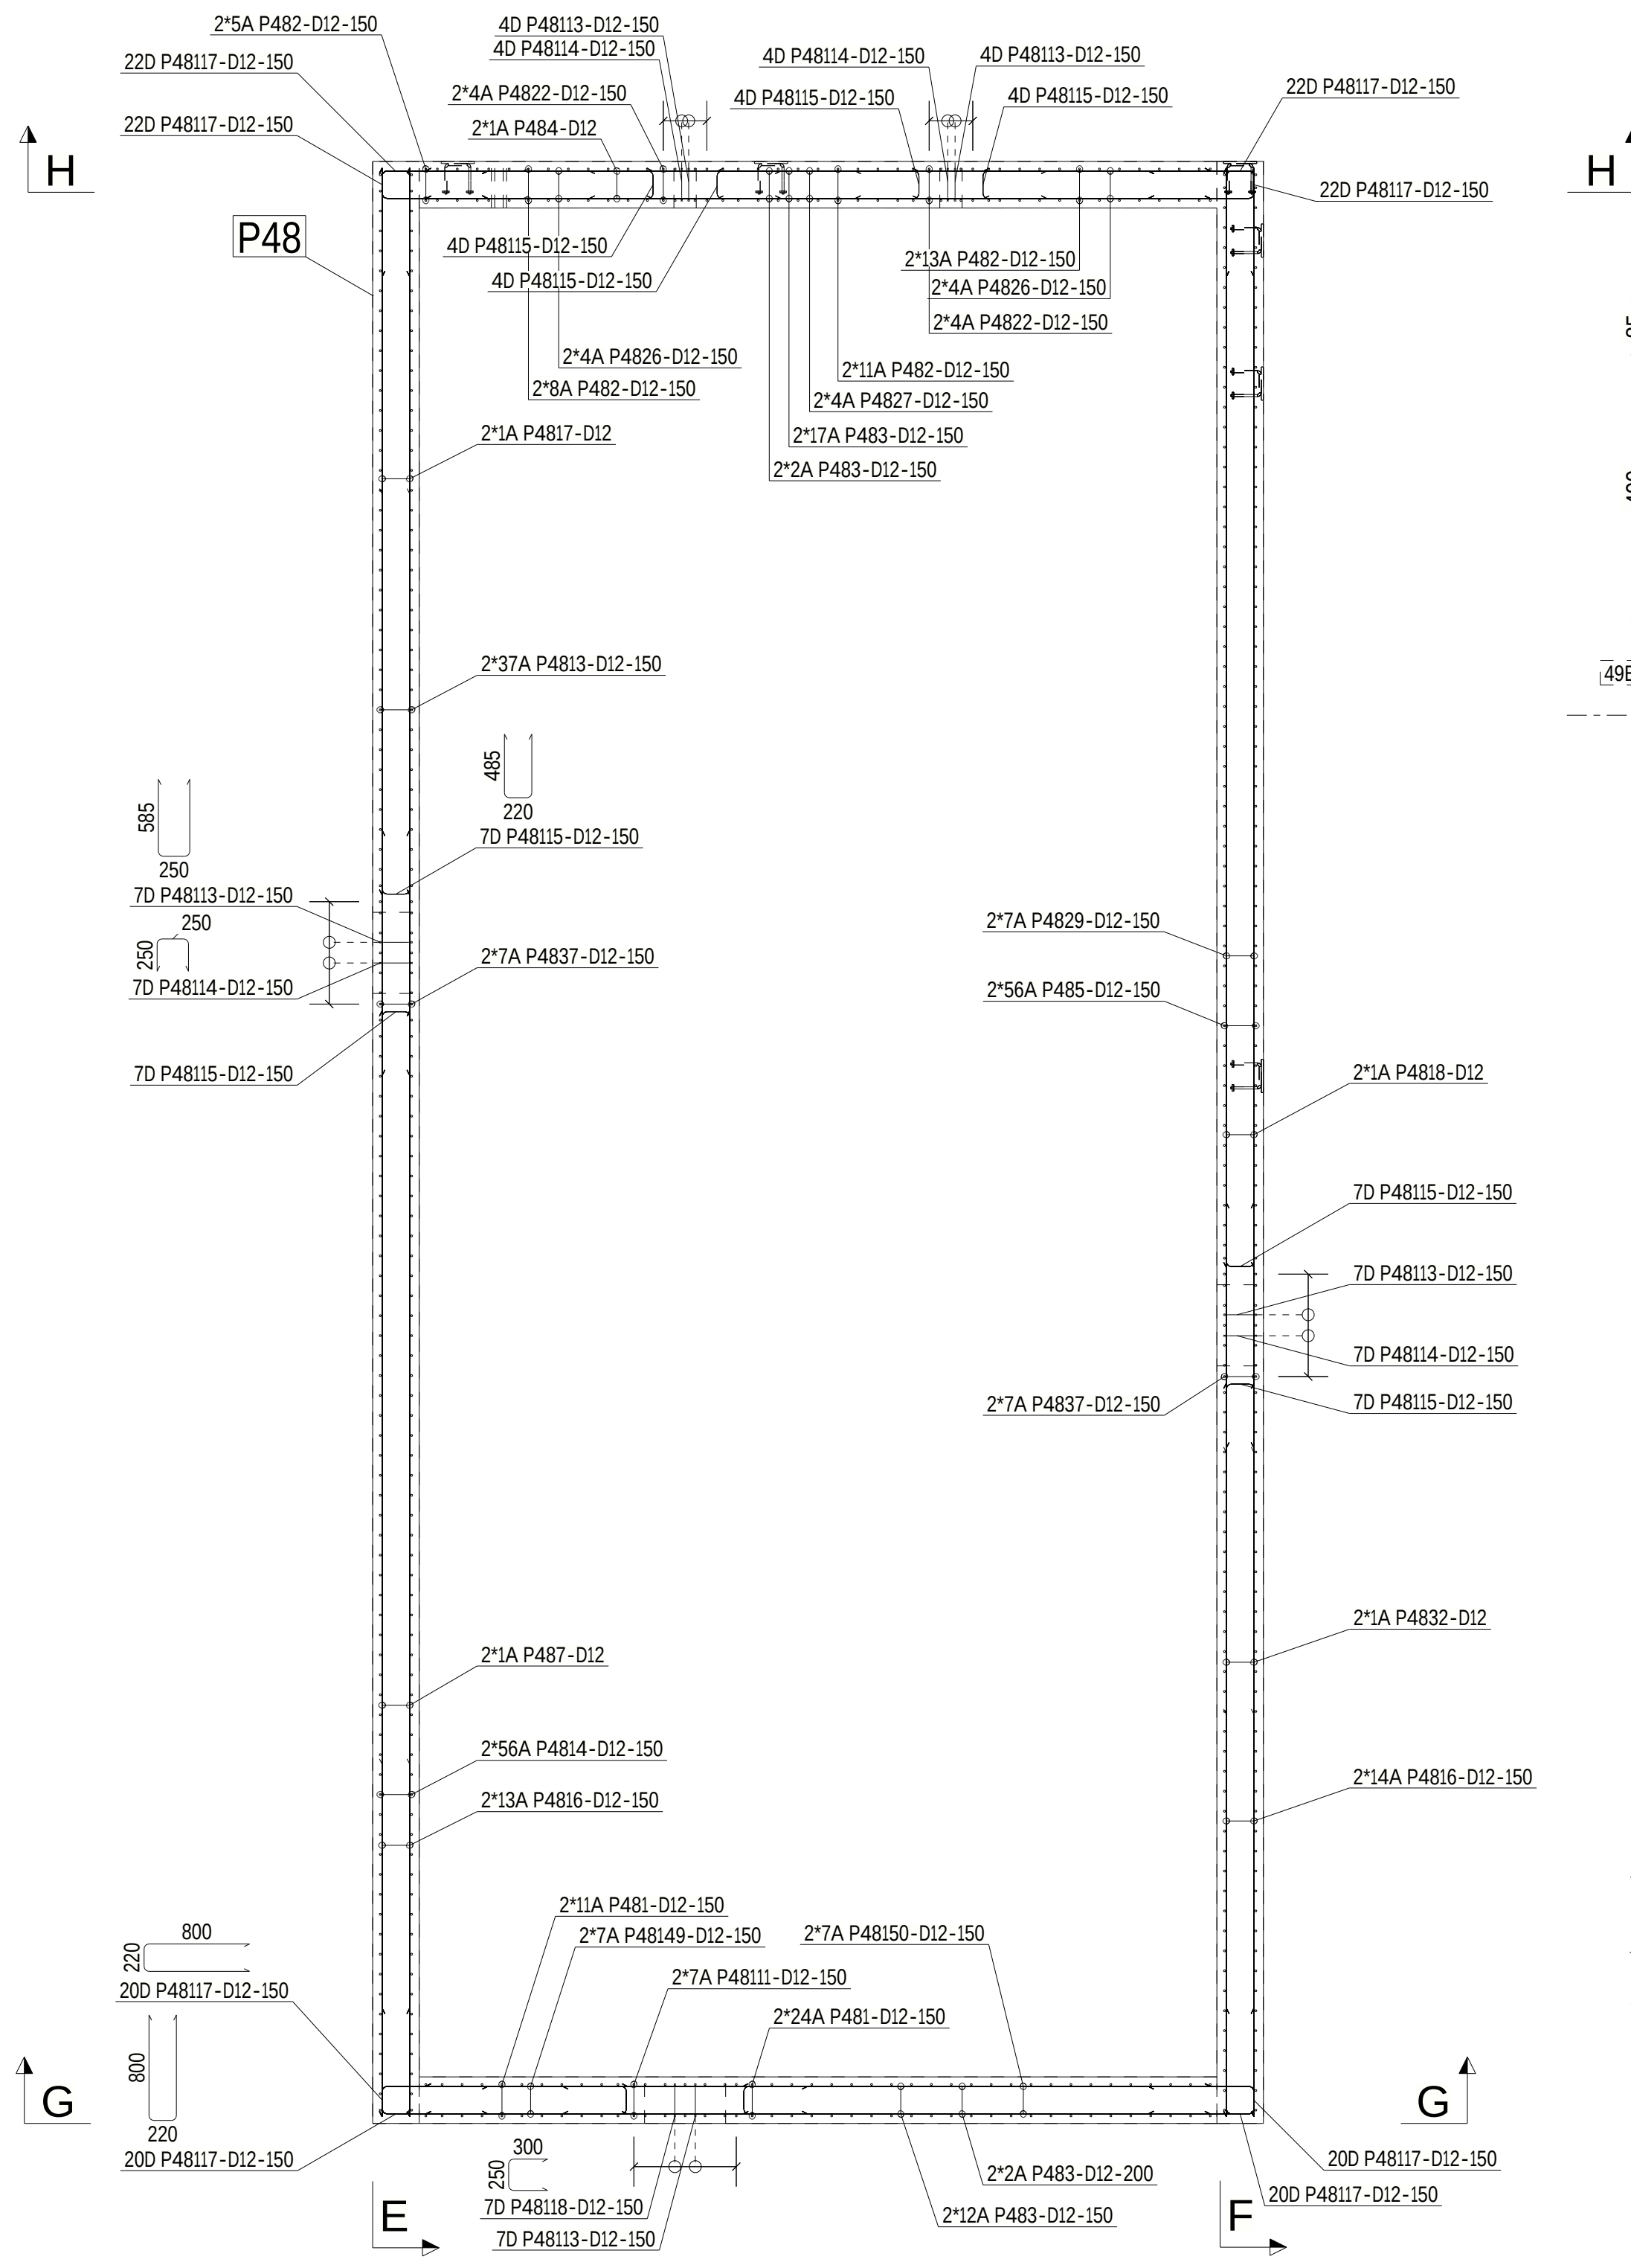

SECTION : K - K
(SCALE 1:10)

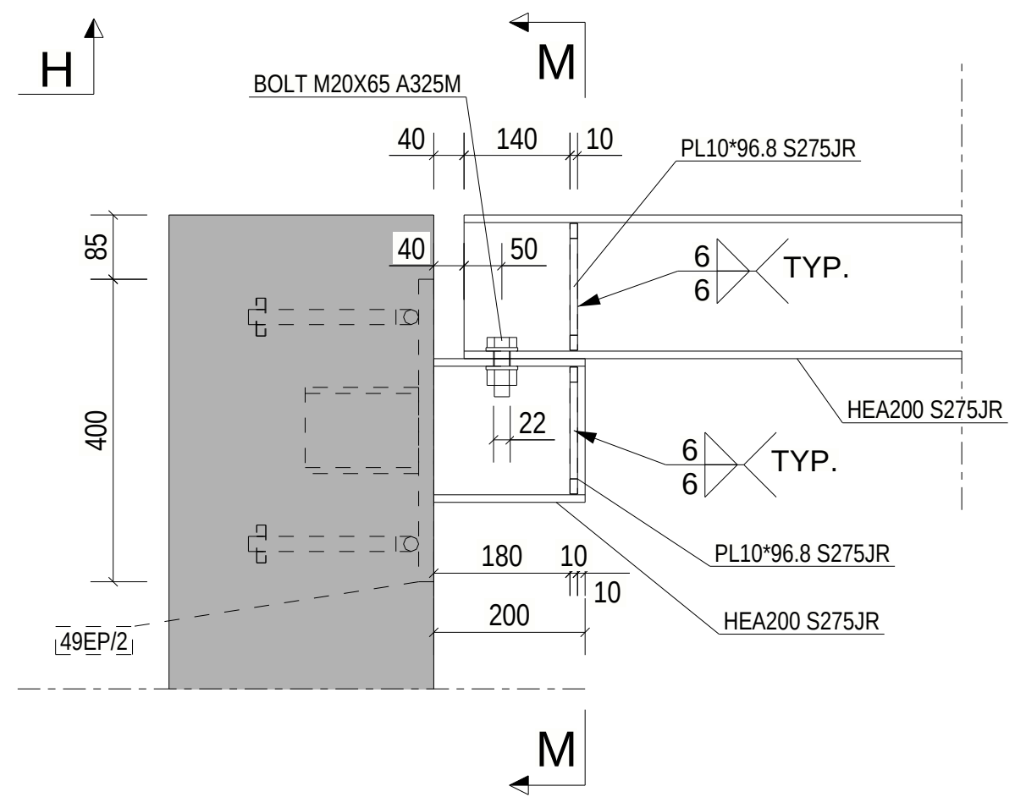

SECTION : L - L
(SCALE 1:10)

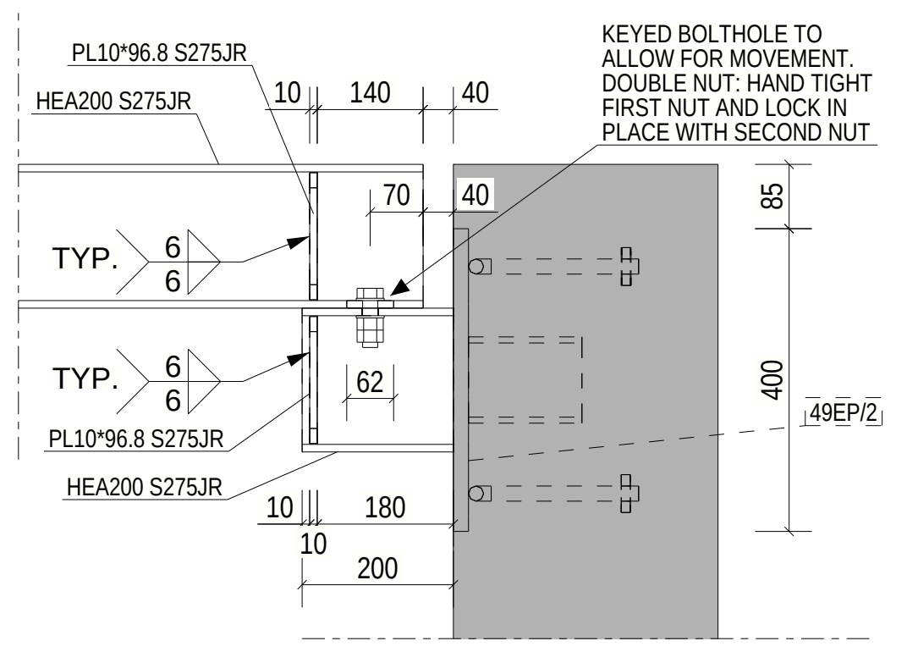
PL10*96.8 S275JR
HEA200 S275JR
KEYED BOLTHOLE TO ALLOW FOR MOVEMENT. DOUBLE NUT: HAND TIGHT FIRST NUT AND LOCK IN PLACE WITH SECOND NUT
TYP.
49EP/2
PL10*96.8 S275JR
HEA200 S275JR
10
180
200

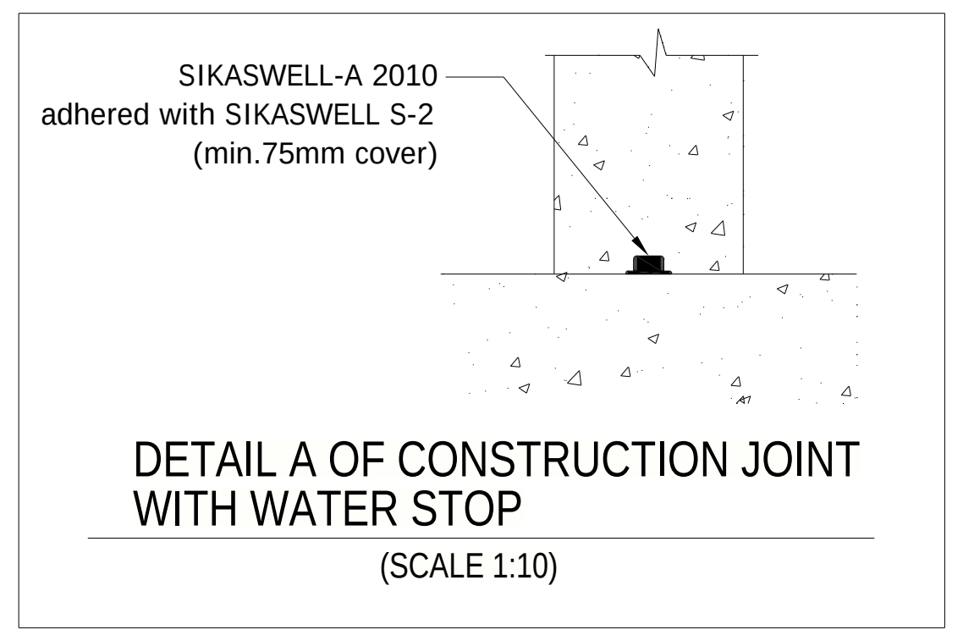
SIKASWELL-A 2010 adhered with SIKASWELL S-2 (min.75mm cover)

DETAIL A OF CONSTRUCTION JOINT WITH WATER STOP
(SCALE 1:10)

SECTION : M - M
(SCALE 1:10)

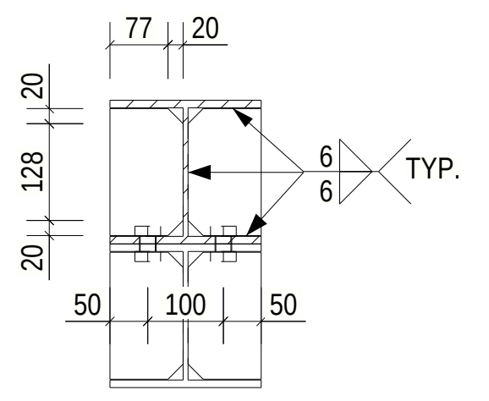

SECTION : G - G
(SCALE 1:50)

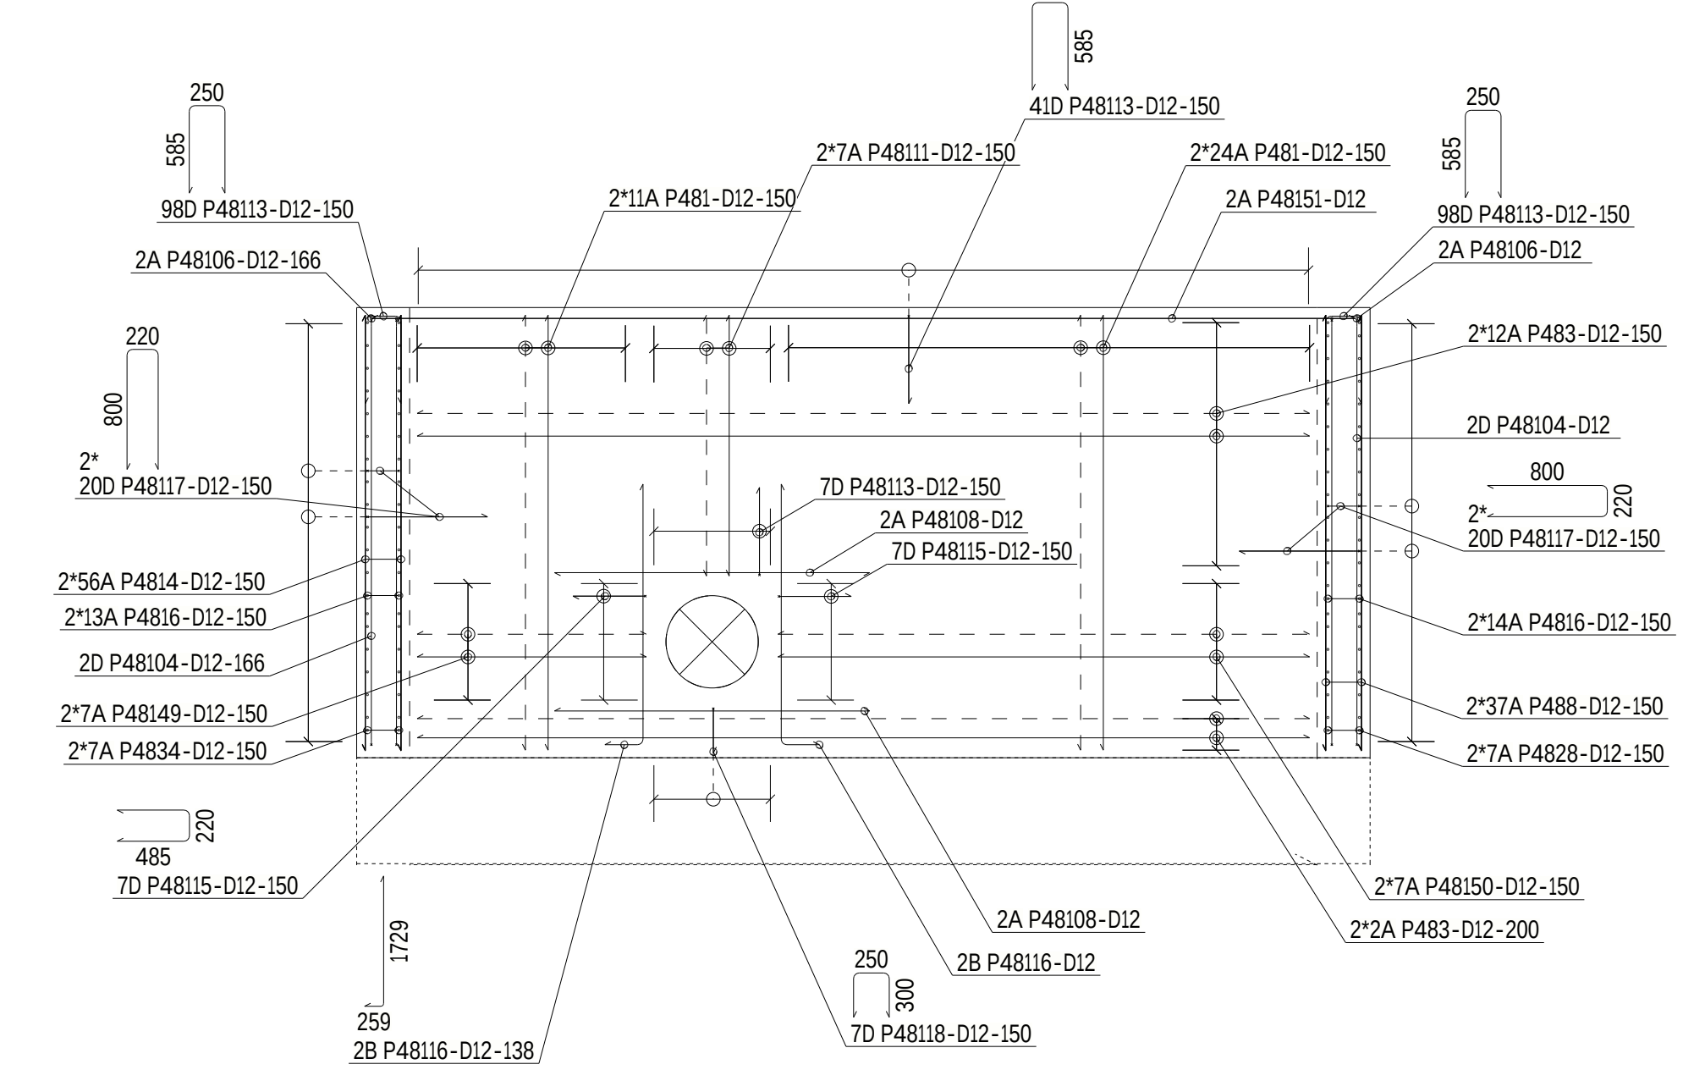

SECTION : I - I
(SCALE 1:30)

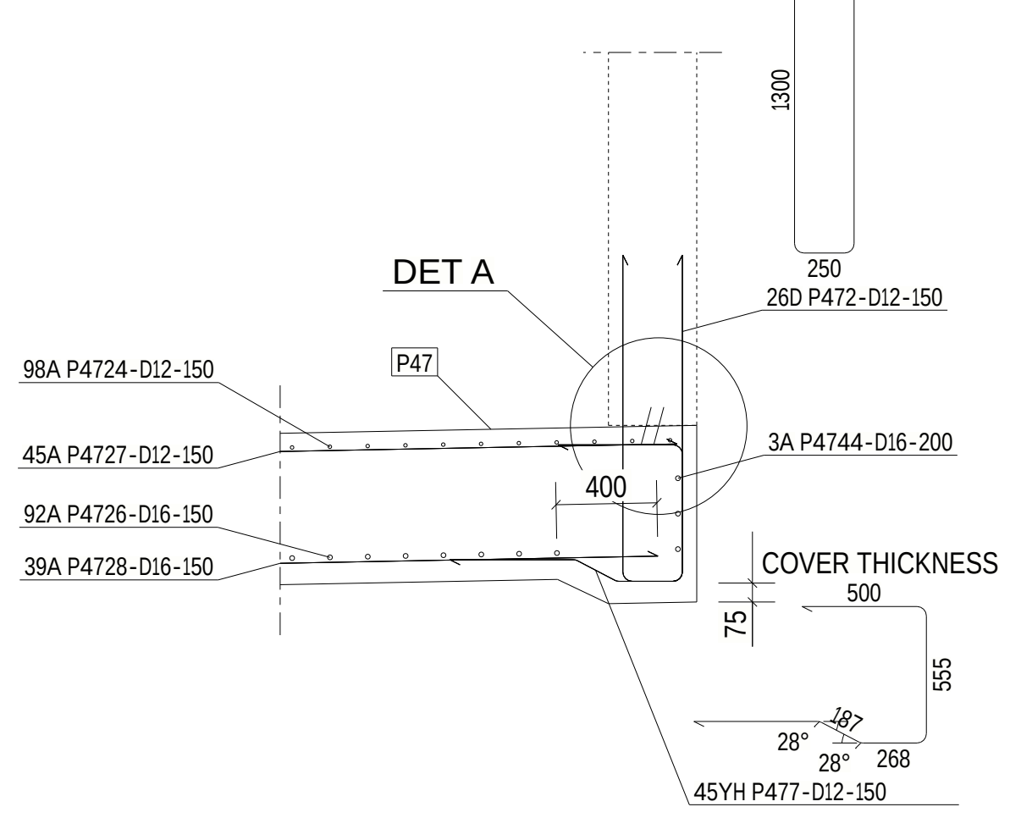

SECTION : J - J
(SCALE 1:30)

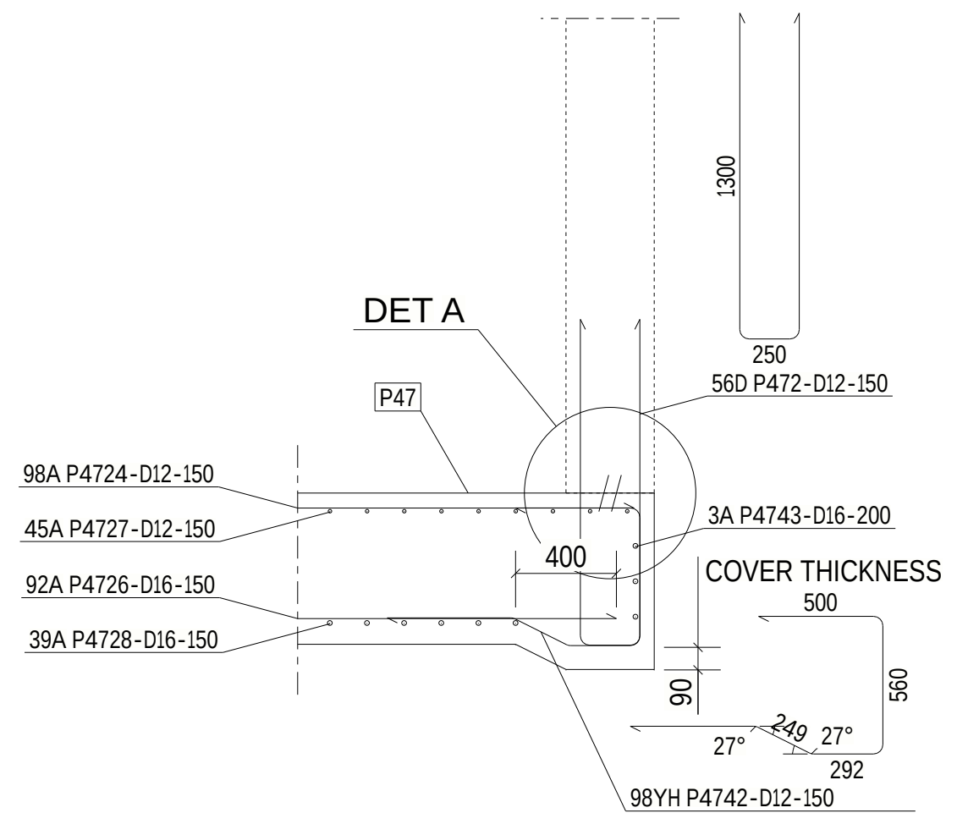

SECTION : H - H
(SCALE 1:50)

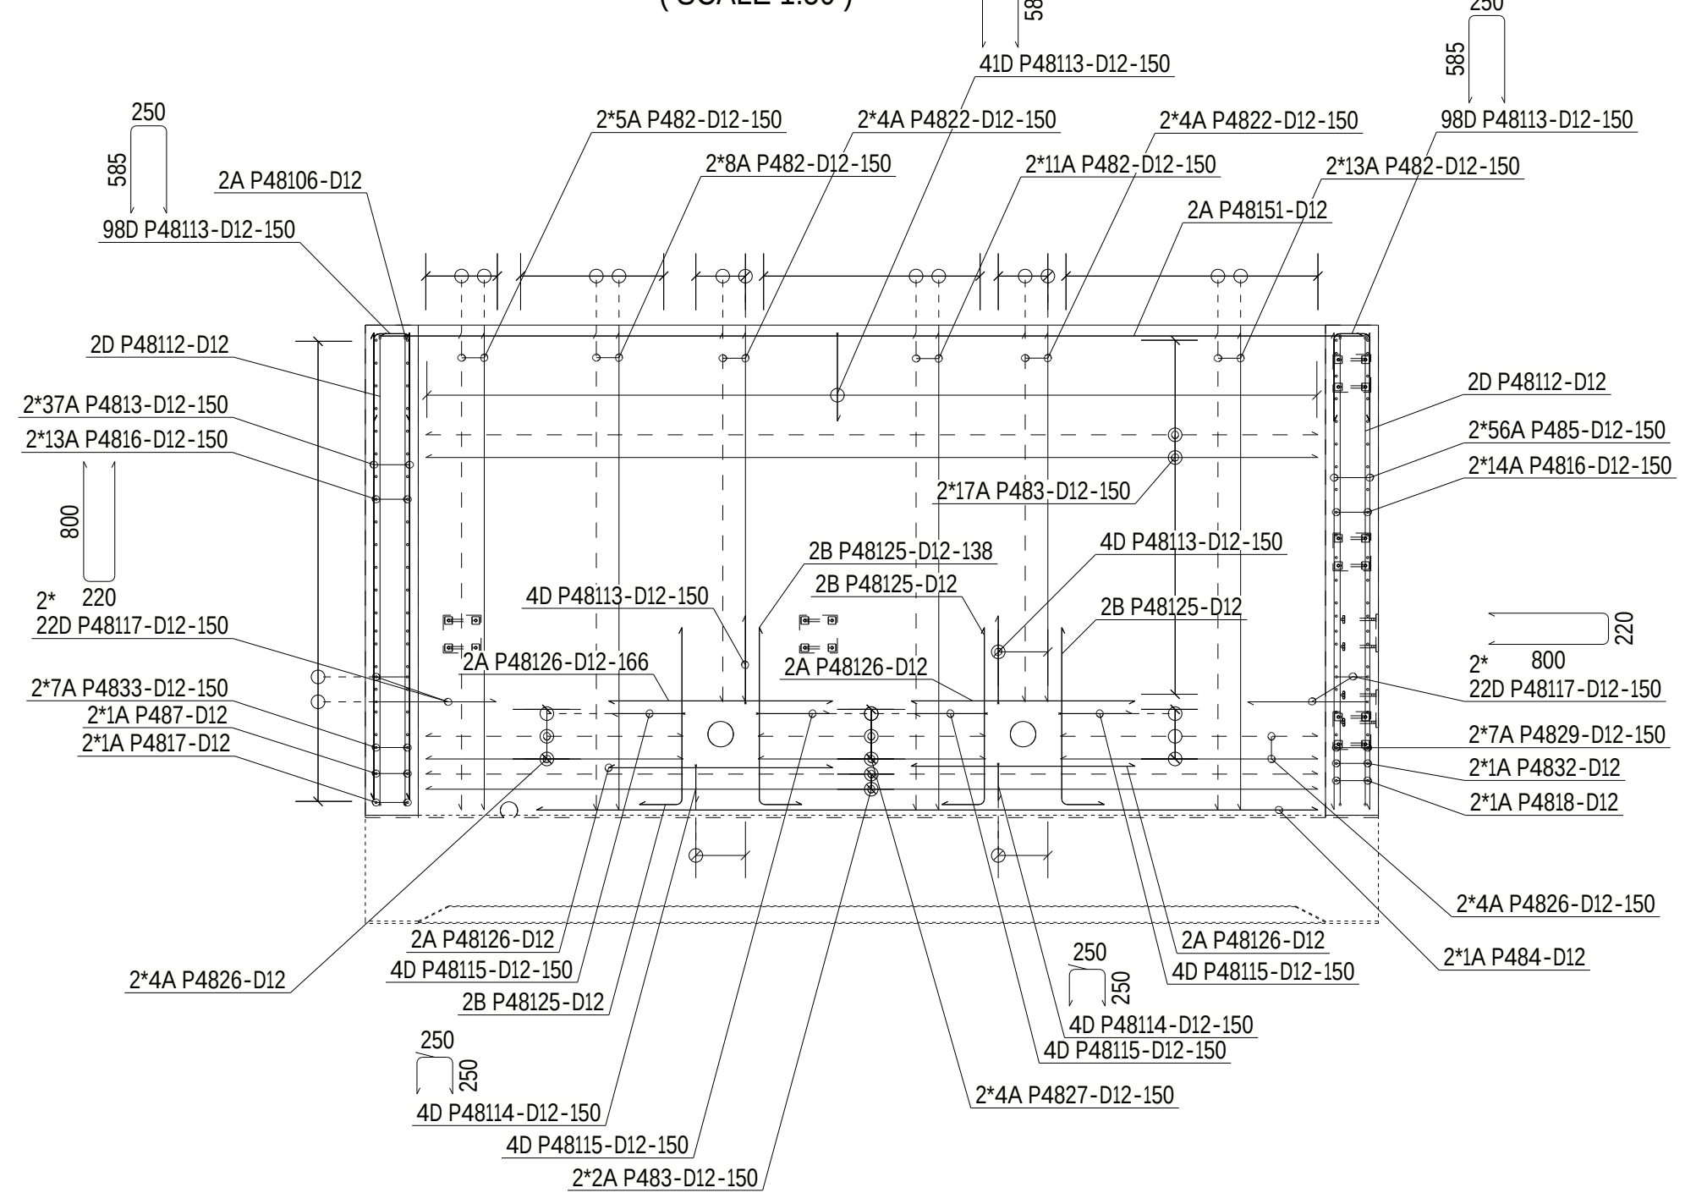

CONCRETE INFORMATION

Concretes used	C35
Concrete cover 1	50±10mm

LEGEND:

R.L. - REDUCED LEVEL
T.O.C. - TOP OF CONCRETE
B.O.F. - BOTTOM OF FOUNDATION
F.G.L. - FINISHED GROUND LEVEL
P.C.C. - PLAIN CEMENT CONCRETE
TYP - TYPICAL
MKD - MARKED
CL - CENTER LINE
BOTTOM REINF. (B)
TOP REINF. (T)
SBC - SAFE BEARING CAPACITY
MIN. - MINIMUM
REF. - REFERED
GA - GENERAL ARRANGEMENT
DWG. - DRAWING
R.C.C. - REINFORCED CEMENT CONCRETE
—//— - CONSTRUCTION JOINT WITH WATER STOP

NOTES:

1. ALL DIMENSIONS ARE IN MILLIMETRES AND LEVELS ARE IN METRES UNLESS OTHERWISE STATED
2. GRADE OF CONCRETE SHALL BE C35 (35MPa) UNLESS NOTED OTHERWISE & C15 (15MPa) FOR BLINDING CONCRETE.
3. GRADE OF REINFORCEMENT SHALL BE DEFORMED BAR ASTM A615-GRADE 60 (fy=420MPa)
4. CLEAR COVER TO MAIN REINFORCEMENT SHALL BE AS FOLLOWS:
   a) FOUNDATION: 75 mm (BOTTOM & SIDE)
   b) FOUNDATION: 50 mm (TOP)
   c) COLUMN & PEDESTAL: 50 mm
5. MINIMUM LAP LENGTHS OF REINFORCEMENT SHALL BE 40XBAR DIAMETER
6. FOR STANDARD REINFORCEMENT DETAILS & GENERAL NOTES FOR CIVIL WORKS REFER TO DRAWING NUMBER MD-216-1000-EG-CV-DED-1005 & 1001
7. ANCHOR BOLTS AND EMBEDDED STEELWORK SHALL BE HOT DIP GALVANIZED
8. T.O.C. & TOP OF SCREED TOLERANCE SHALL BE WITHIN +/- 10MM OF DESIGN LEVEL
9. NET SAFE BEARING CAPACITY OF SOIL AT BOTTOM OF FOUNDATION IS CONSIDERED AS 375 KN/SQ.M.
10. REBARS CAN BE MOVED LOCALLY BY +/- 25mm TO AVOID INTERFERENCE WITH EMBEDDED PARTS
11. INNER SURFACE OF THE SLUDGE BASIN SHOULD BE COATE AS SPECIFIED BY DESIGN CRITERIA MD-216-1000-EG-ST-CRT-1001, COATING FOR WATER RETAINING STRUCTURES.
12. REBARS CAN BE MOVED LOCALLY BY +/- 25MM TO TO AVOID INTERFERENCE WITH EMBEDED PLATES
13. FOR STRUCTURAL WORKS GENERAL NOTES, REFER DRAWING NUMBER MD-216-1000-EG-ST-DED-1001

C01

KEYPLAN

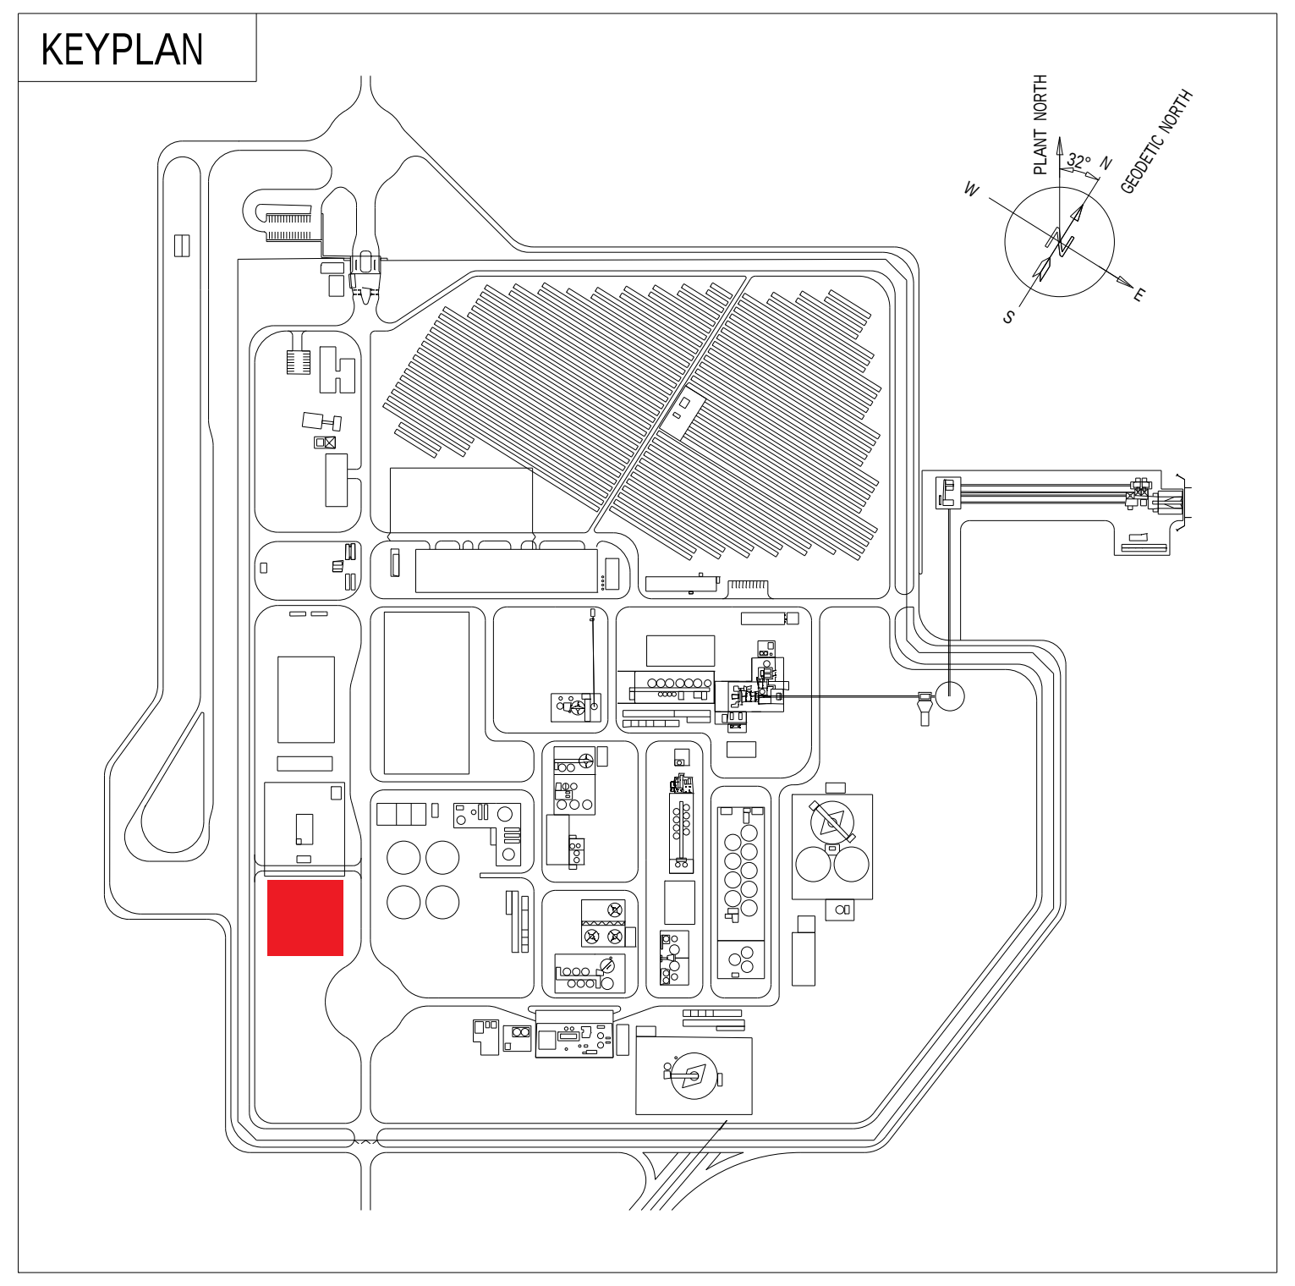

DOCUMENT NUMBER	REFERENCE DOCUMENTS	DOCUMENT NUMBER	REFERENCE DOCUMENTS
MD-216-1000-EG-ST-CRT-1001	CIVIL STRUCTURAL AND ARCHITECTURAL DESIGN CRITERIA	MD-216-49W1-EG-ME-GAD-1022	CONCRETE EMBEDDED PARTS
MD-216-49W1-EG-CV-GAD-1003	1-10/A-E GENERAL ARRANGEMENT DRAWING	MD-216-49W1-EG-CV-CAL-1006	CALCULATION REPORT FOR GRADE SLAB, PITS & SLUDGE BASIN
MD-216-49W1-EG-CV-GAD-1001	1-8/E-J GENERAL ARRANGEMENT DRAWING	MD-216-49W1-EG-CV-GAD-1002	7-12/D-J GENERAL ARRANGEMENT DRAWING

REV	DATE	REVISION DESCRIPTION	DRN	CHK	ENG	APP	EMP
D01	29.01.2024	AS-BUILT	NikJan	MauNot	LuiPiz	SouCha	
C01	10.02.2022	ISSUED FOR CONSTRUCTION	NikJan	MauNot	LuiPiz	SouCha	
A02	21.01.2022	ISSUED FOR APPROVAL	JonRen	PerKoi	LuiPiz	LuiPiz	
A01	07.12.2021	ISSUED FOR APPROVAL	AbdDus	PerKoi	LuiPiz	LuiPiz	

RESERVED FOR VENDOR LOGO AND DRAWING NUMBER

LARSEN & TOUBRO

This drawing is the property of LARSEN & TOUBRO and must not be passed on to any person or body not authorized by us to recieve it or be copied or otherwise made use either in full or in part by such person or body without our prior permission in writing.

Outotec

The content of these documents are the sole property of Outotec Oyj. Any rights not expressly granted herein are reserved. Reproduction, transfer or distribution of part or all of the contents in any form without prior written permission of Outotec is prohibited.

MA'ADEN معادن
Saudi Arabian Mining Company شركة التعدين العربية السعودية

This document and the information contained herein is Ma'aden proprietary know-how. This document or any part thereof should not be reproduced, stored in a retrieval system or transmitted by any means, electronic or otherwise, or divulged without prior written permission of Ma'aden.

LARSEN & TOUBRO DRAWING NUMBER	REVISION
019045_080_C_D_24892_009	3

OUTOTEC DRAWING NUMBER	DOCUMENT ID	REVISION
900707_GAU01_AG11_CTB01_49009	OU100732641	3

DRAWN	AbdDus	07.12.2021
CHECKED	MauNot	07.12.2021
ENGINEER	AbdDus	07.12.2021
APPROVED	LuiPiz	07.12.2021
EMPLOYER		
SCALE	1:50	A0

MANSOURAH - MASSARAH GOLD PROJECT
49W1 RAW WATER TREATMENT PLANT
SLUDGE BASIN
DETAIL AND REINFORCEMENT DRAWING

DRAWING NUMBER	REV
MD-216-49W1-EG-CV-DED-1009	D01

Tekla Structures