

MD-216-49W1-EG-CV-DED-1010 | REV D01


CONCRETE INFORMATION		
Concretes used	C35	
Concrete cover 1	75±10mm	BOTTOM OF SLAB
Concrete cover 2	50±10mm	SIDES AND TOP OF SLAB, WALLS, BEAMS AND COLUMNS

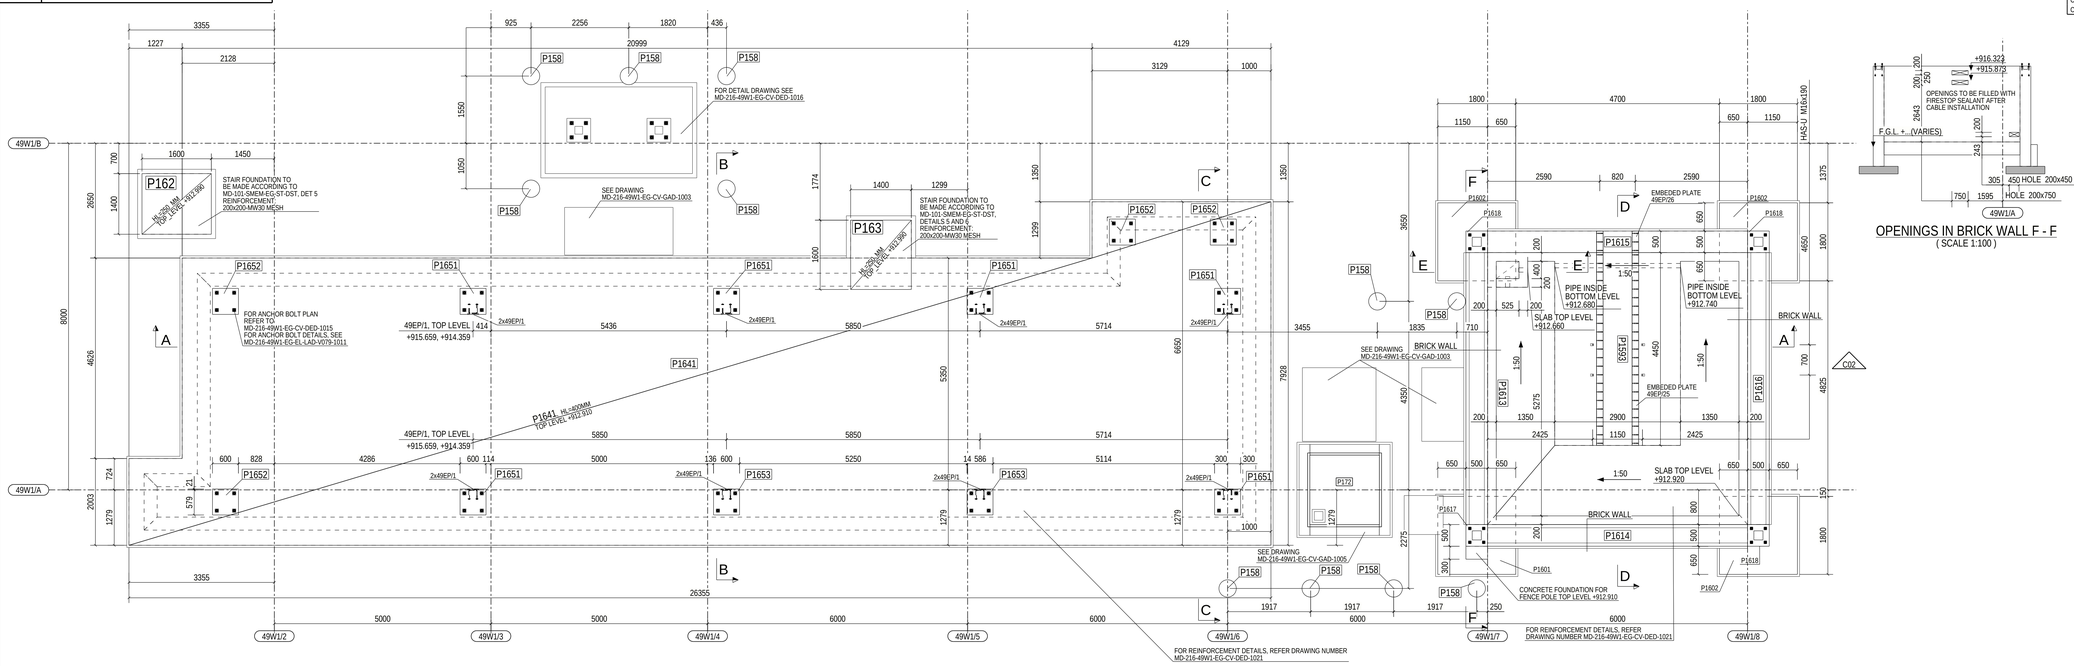


SUBSTATION AND TRANSFORMER ROOM
(SCALE 1:50)

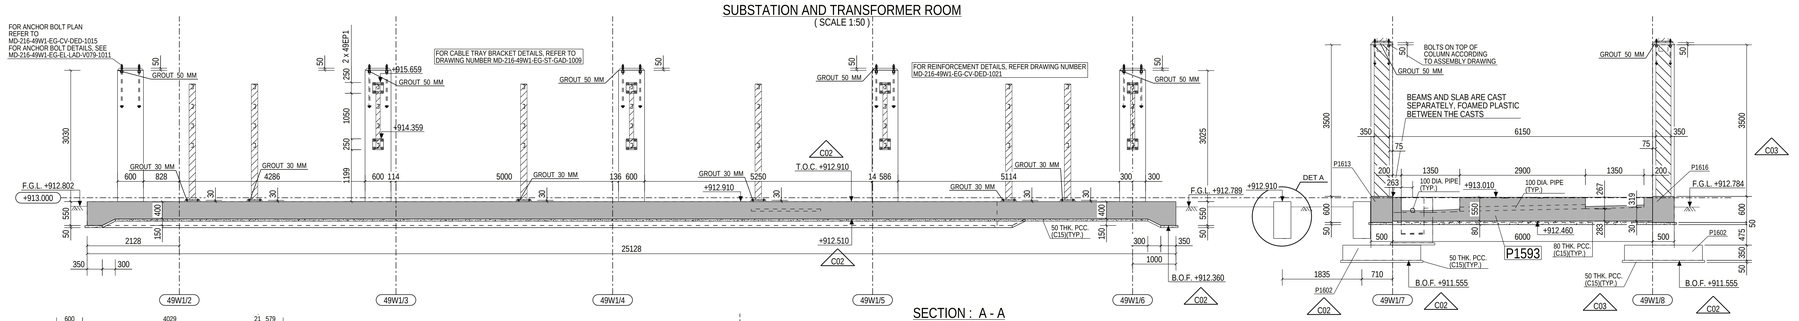


SECTION : A - A
(SCALE 1:50)

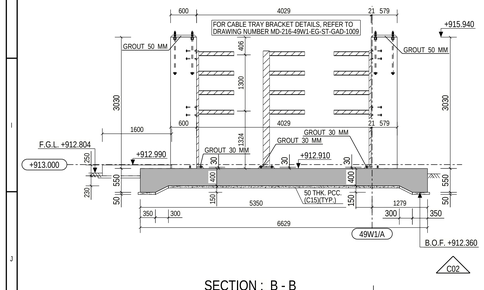


SECTION : B - B
(SCALE 1:50)

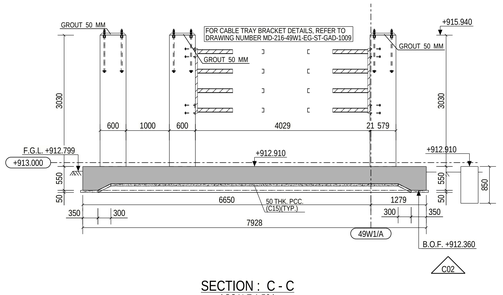

SECTION : C - C
(SCALE 1:50)

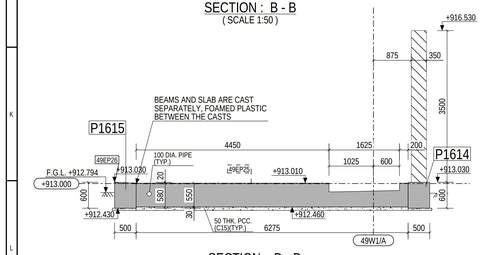


SECTION : D - D
(SCALE 1:50)

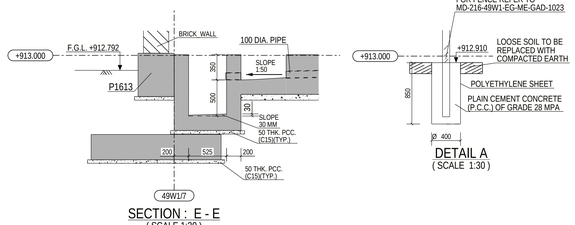


SECTION : E - E
(SCALE 1:30)


DETAIL A
(SCALE 1:30)

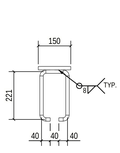


SECTION : 13 - 13
(SCALE 1:10)

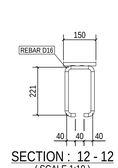


SECTION : 12 - 12
(SCALE 1:10)

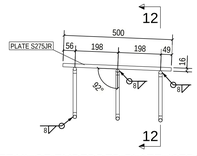


DETAIL OF EMBEDDED PLATE 49EP/26
(SCALE 1:10)

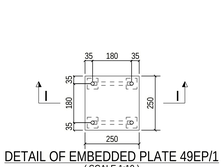

DETAIL OF EMBEDDED PLATE 49EP/1
(SCALE 1:10)

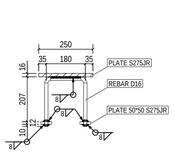

SECTION : I - I
(SCALE 1:10)

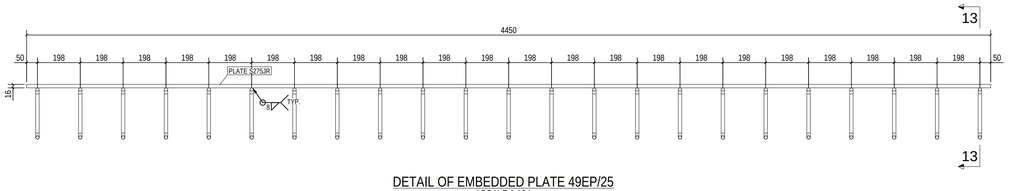


DETAIL OF EMBEDDED PLATE 49EP/25
(SCALE 1:10)

OPENINGS IN BRICK WALL F - F
(SCALE 1:100)

LEGEND:
- R.L - REDUCED LEVEL
- T.O.C. - TOP OF CONCRETE
- B.O.F. - BOTTOM OF FOUNDATION
- F.G.L. - FINISHED GROUND LEVEL
- P.C.C. - PLAIN CEMENT CONCRETE
- TYP - TYPICAL
- MKD - MARKED
- CL - CENTER LINE
- BOTTOM REINF. (B)
- TOP REINF. (T)
- SBC - SAFE BEARING CAPACITY
- MIN. - MINIMUM
- REF. - REFERED
- GA - GENERAL ARRANGEMENT
- DWG. - DRAWING
- R.C.C. - REINFORCED CEMENT CONCRETE

NOTES:
1. ALL DIMENSIONS ARE IN MILLIMETRES AND LEVELS ARE IN METRES UNLESS OTHERWISE STATED
2. GRADE OF CONCRETE SHALL BE C35 (35MPa) UNLESS NOTED OTHERWISE & C15 (15MPa) FOR BLINDING CONCRETE.
3. GRADE OF REINFORCEMENT SHALL BE DEFORMED BAR ASTM A615-GRADE 60 (fy=420MPa)
4. CLEAR COVER TO MAIN REINFORCEMENT SHALL BE AS FOLLOWS:
a) FOUNDATION: 75 mm (BOTTOM & SIDE)
b) FOUNDATION: 50 mm (TOP)
c) COLUMN & PEDESTAL: 50 mm
5. MINIMUM LAP LENGTHS OF REINFORCEMENT SHALL BE 40XBAR DIAMETER
6. FOR STANDARD REINFORCEMENT DETAILS & GENERAL NOTES FOR CIVIL WORKS REFER TO DRAWING NUMBER MD-216-1000-EG-CV-DED-1005 & 1001
7. ANCHOR BOLTS AND EMBEDDED STEELWORK SHALL BE HOT DIP GALVANIZED
8. T.O.C. & TOP OF SCREED TOLERANCE SHALL BE WITHIN +/- 10MM OF DESIGN LEVEL
9. NET SAFE BEARING CAPACITY OF SOIL AT BOTTOM OF FOUNDATION IS CONSIDERED AS 375 KN/SQ.M.
10. REBARS CAN BE MOVED LOCALLY BY +/- 25mm TO AVOID INTERFERENCE WITH EMBEDDED PARTS

KEYPLAN

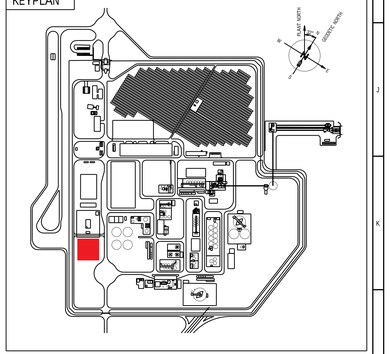

DOCUMENT NUMBER	REFERENCE DOCUMENTS
MD-216-49W1-EG-ST-GAD-1009	TRANSFORMER SHELTER & SUBSTATION STEEL STR.
MD-216-49W1-EG-ME-GAD-1023	ELECTRICAL SUBSTATION DEMARCATION FENCE
MD-216-49W1-EG-EL-GAD-V079-1001	1200KVA, 13.8/0.417 KV TRANSFORMER
MD-216-49W1-EG-CV-CAL-1003	DESIGN CALCULATION FOR SUBSTATION FOUNDATION
MD-216-49W1-EG-EL-GAD-V079-1004	EQUIPMENT LAYOUT OF PREFAB BUILDING

DOCUMENT NUMBER	REFERENCE DOCUMENTS
MD-216-49W1-EG-CV-DED-1010	SUBSTATION AND TRANSFORMER FOUNDATION, DIMENSIONAL DRAWING
MD-216-1000-EG-ST-CRT-1001	DESIGN CRITERIA
MD-216-49W1-EG-CV-GAD-1003	GENERAL ARRANGEMENT DRAWING GL 1-10/A-E
MD-216-49W1-EG-EL-GAD-V079-1015	ANCHOR BOLT PLAN2

REV	DATE	REVISION DESCRIPTION	DRN	CHK	ENG	APP	EMP
D01	29.01.2024	AS-BUILT	JonRen	MauNot	NamWu	LuiPz	
C03	04.03.2022	DIMENSION AND MARKS ADDED	JonRen	MauNot	NamWu	LuiPz	
C02	03.03.2022	LEVEL MARKS ADDED, ANCHOR PLATES MOVED	JonRen	MauNot	NamWu	LuiPz	
C01	14.02.2022	ISSUED FOR CONSTRUCTION	NikJan	MauNot	LuiPz	SouCha	
A02	27.01.2022	ISSUED FOR APPROVAL	KalKar	MauNot	NamWu	LuiPz	
A01	22.12.2021	ISSUED FOR APPROVAL	KalKar	MauNot	NamWu	LuiPz	

RESERVED FOR VENDOR LOGO AND DRAWING NUMBER

LARSEN & TOUBRO

This drawing is the property of LARSEN & TOUBRO and must not be passed on to any person or body not authorized by us to receive it or be copied or otherwise made use either in full or in part by such person or body without our prior permission in writing.

Outotec

The content of these documents are the sole property of Outotec Oy. Any rights not expressly granted herein are reserved. Reproduction, transfer or distribution of part or all of the contents in any form without prior written permission of Outotec is prohibited.

MA'ADEN معادن
Saudi Arabian Mining Company شركة معادن السعودية

This document and the information contained herein is Ma'aden proprietary know-how. This document or any part thereof should not be reproduced, stored in a retrieval system or transmitted by any means, electronic or otherwise, or divulged without prior written permission of Ma'aden.

LARSEN & TOUBRO DRAWING NUMBER	0I9045_080_C_D_24892_010	REVISION 5
OUTOTEC DRAWING NUMBER	900707_GAU01_AG11_CTB01_49010	DOCUMENT ID OU100732642 / REVISION 5
DRAWN	KalKar	22.12.2021
CHECKED	MauNot	22.12.2021
ENGINEER	KalKar	22.12.2021
APPROVED	LuiPz	22.12.2021
EMPLOYER		
SCALE	1:50	A0

MANSOURAH - MASSARAH GOLD PROJECT
49W1 RAW WATER TREATMENT PLANT
SUBSTATION AND TRANSFORMER FOUNDATION DIMENSIONAL DRAWING

DRAWING NUMBER: MD-216-49W1-EG-CV-DED-1010 | REV D01

Tekla Structures