


CONCRETE INFORMATION		
Concretes used	C35	
Concrete cover 1	75±10mm	BOTTOM OF SLAB
Concrete cover 2	50±10mm	SIDES AND TOP OF SLAB, WALLS

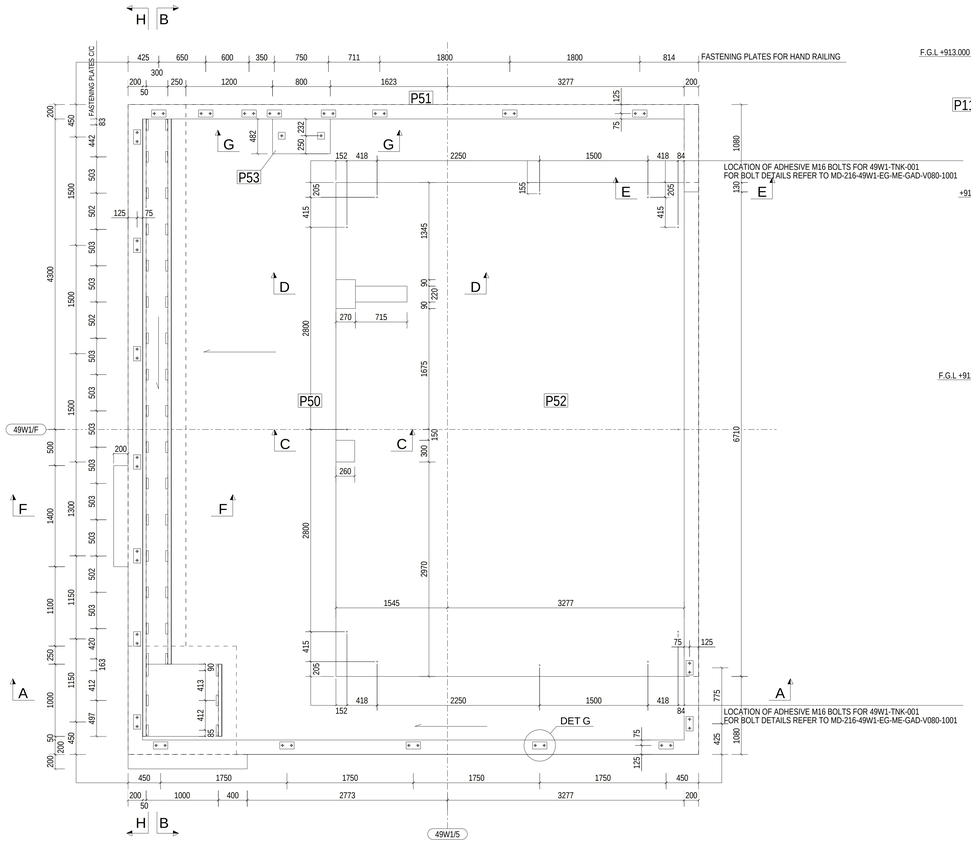


R.C.C 49W1-TNK-001 PIT DIMENSIONS
(SCALE 1:30)

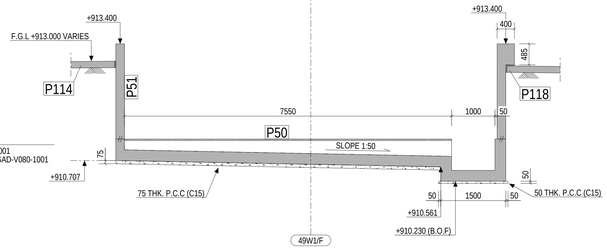


SECTION : B - B
(SCALE 1:50)

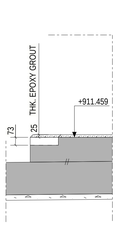


SECTION : C - C
(SCALE 1:20)

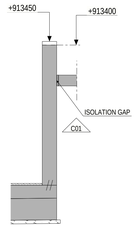


SECTION : E - E
(SCALE 1:30)

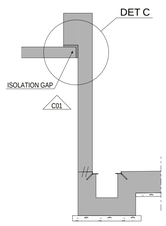


SECTION : F - F
(SCALE 1:30)

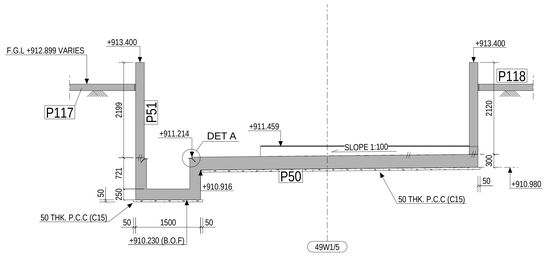


SECTION : A - A
(SCALE 1:50)

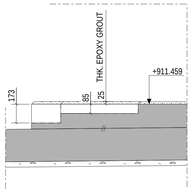


SECTION : D - D
(SCALE 1:20)

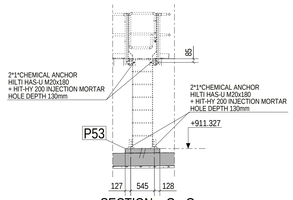

SECTION : G - G
(SCALE 1:50)

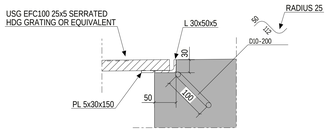


DETAIL : A
(SCALE 1:5)

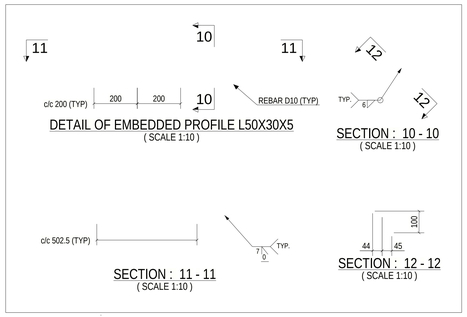


(SCALE 1:10)

LEGEND:
R.L - REDUCED LEVEL
T.O.C. - TOP OF CONCRETE
B.O.F. - BOTTOM OF FOUNDATION
F.G.L. - FINISHED GROUND LEVEL
P.C.C. - PLAIN CEMENT CONCRETE
TYP - TYPICAL
MKD - MARKED
CL - CENTER LINE
BOTTOM REINF. (B)
TOP REINF. (T)
SBC - SAFE BEARING CAPACITY
MIN. - MINIMUM
REF. - REFERED
GA - GENERAL ARRANGEMENT
DWG. - DRAWING
R.C.C. - REINFORCED CEMENT CONCRETE
// - CONSTRUCTION JOINT


NOTES:
1. ALL DIMENSIONS ARE IN MILLIMETRES AND LEVELS ARE IN METRES UNLESS OTHERWISE STATED
2. GRADE OF CONCRETE SHALL BE C35 (35MPa) UNLESS NOTED OTHERWISE & C15 (15MPa) FOR BLINDING CONCRETE.
3. GRADE OF REINFORCEMENT SHALL BE DEFORMED BAR ASTM A615-GRADE 60 (fy=420MPa)
4. CLEAR COVER TO MAIN REINFORCEMENT SHALL BE AS FOLLOWS:
a) FOUNDATION: 75 mm (BOTTOM & SIDE)
b) FOUNDATION TOP: 50 mm
c) COLUMN & PEDESTAL: 50 mm
5. MINIMUM LAP LENGTHS OF REINFORCEMENT SHALL BE 40XBAR DIAMETER
6. FOR STANDARD REINFORCEMENT DETAILS & GENERAL NOTES FOR CIVIL WORKS REFER TO DRAWING NUMBER MD-216-1000-EG-CV-DED-1005 & 1001
7. ANCHOR BOLTS AND EMBEDDED STEELWORK SHALL BE HOT DIP GALVANIZED
8. T.O.C. & TOP OF SCREED TOLERANCE SHALL BE WITHIN +/- 10MM OF DESIGN LEVEL
9. NET SAFE BEARING CAPACITY OF SOIL AT BOTTOM OF FOUNDATION IS CONSIDERED AS 375 KN/SQ.M.
10. REBARS CAN BE MOVED LOCALLY BY +/- 25mm TO AVOID INTERFERENCE WITH EMBEDDED PARTS
11. FOR REINFORCEMENT REFER TO DOCUMENT MD-216-49W1-EG-CV-DED-1020

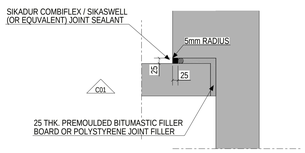


DETAIL : C
(SCALE 1:10)

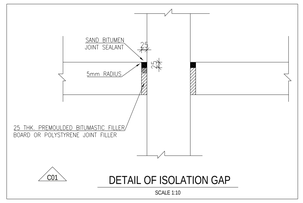


SCALE 1:10

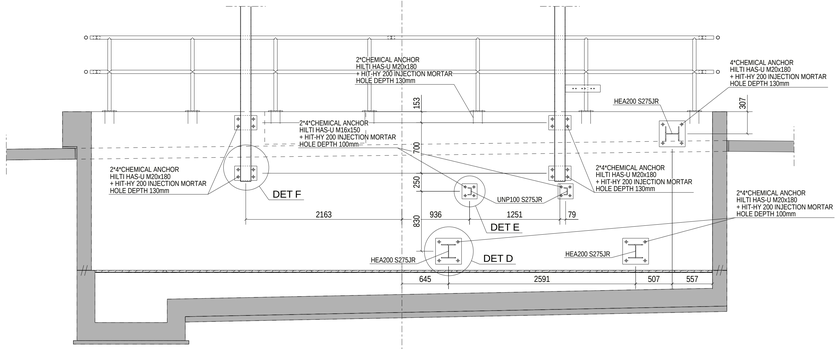


SECTION : H - H
(SCALE 1:30)

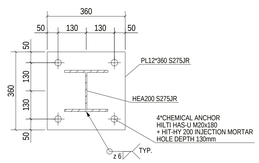


DETAIL : D
(SCALE 1:10)

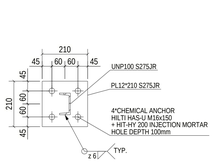

DETAIL : E
(SCALE 1:10)

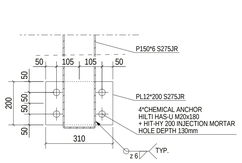


DETAIL : F
(SCALE 1:10)

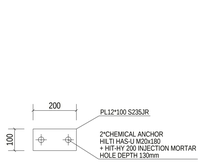

DETAIL : G
(SCALE 1:10)

KEYPLAN

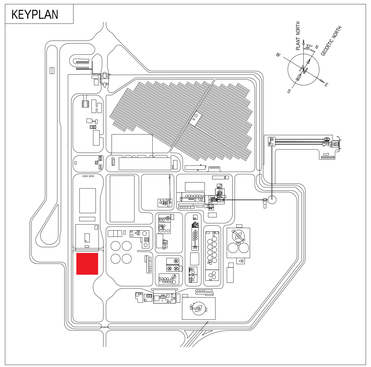

DOCUMENT NUMBER	REFERENCE DOCUMENTS
MD-216-49W1-EG-CV-DED-1020	49W1-TNK-001 PIT REINFORCEMENT DRAWING
MD-216-49W1-EG-ME-GAD-V080-1001	49W1-TNK-001, Coagulant Mixin Basin
MD-216-49W1-EG-CV-GAD-1003	1-10/A-E GENERAL ARRANGEMENT DRAWING
MD-216-49W1-EG-CV-GAD-1001	1-8/E-J GENERAL ARRANGEMENT DRAWING

DOCUMENT NUMBER	REFERENCE DOCUMENTS
MD-216-49W1-EG-CV-CAL-1006	DAF BASIN, COAGULANT BASIN, PIT, SLUDGE BASIN, VESSEL FOUNDATION
MD-216-1000-EG-ST-CRT-1001	DESIGN CRITERIA
MD-216-49W1-EG-CV-GAD-1002	7-12/J-J GENERAL ARRANGEMENT DRAWING

REV	DATE	REVISION DESCRIPTION	DRN	CHK	ENG	APP	EMP
D01	29.01.2024	AS-BUILT	NikJan	MauNot	LuiPiz	SouCha	
C01	10.02.2022	ISSUED FOR CONSTRUCTION	NikJan	MauNot	LuiPiz	SouCha	
A02	12.01.2022	ISSUED FOR APPROVAL	JonRen	MauNot	NanWu	LuiPiz	
A01	17.12.2021	ISSUED FOR APPROVAL	JonRen	MauNot	NanWu	LuiPiz	

RESERVED FOR VENDOR LOGO AND DRAWING NUMBER

LARSEN & TOUBRO

This drawing is the property of LARSEN & TOUBRO and must not be passed on to any person or body not authorized by us to receive it or be copied or otherwise made use either in full or in part by such person or body without our prior permission in writing.

Outotec

The content of these documents are the sole property of Outotec Oyj. Any rights not expressly granted herein are reserved. Reproduction, transfer or distribution of part or all of the contents in any form without prior written permission of Outotec is prohibited.

MA'ADEN معادن — Saudi Arabian Mining Company

This document and the information contained herein is Ma'aden proprietary know-how. This document or any part thereof should not be reproduced, stored in a retrieval system or transmitted by any means, electronic or otherwise, or divulged without prior written permission of Ma'aden.

LARSEN & TOUBRO DRAWING NUMBER	O19045_080_C_D_24892_011		REVISION 3
OUTOTEC DRAWING NUMBER	900707_GAU01_AG11_CTB01_49011	DOCUMENT ID OU100732643	REVISION 3
DRAWN	JonRen	17.12.2021	
CHECKED	MauNot	17.12.2021	
ENGINEER	NanWu	17.12.2021	
APPROVED	LuiPiz	17.12.2021	
EMPLOYER			
SCALE 1:30		A0	

MANSOURAH - MASSARAH GOLD PROJECT
49W1 RAW WATER TREATMENT PLANT
49W1-TNK-001 PIT
DIMENSIONAL DRAWING

DRAWING NUMBER: MD-216-49W1-EG-CV-DED-1011 | REV: D01

Trimble Structures