MD-216-49W1-EG-CV-DED-1012
DRAWING NUMBER
D01
REV

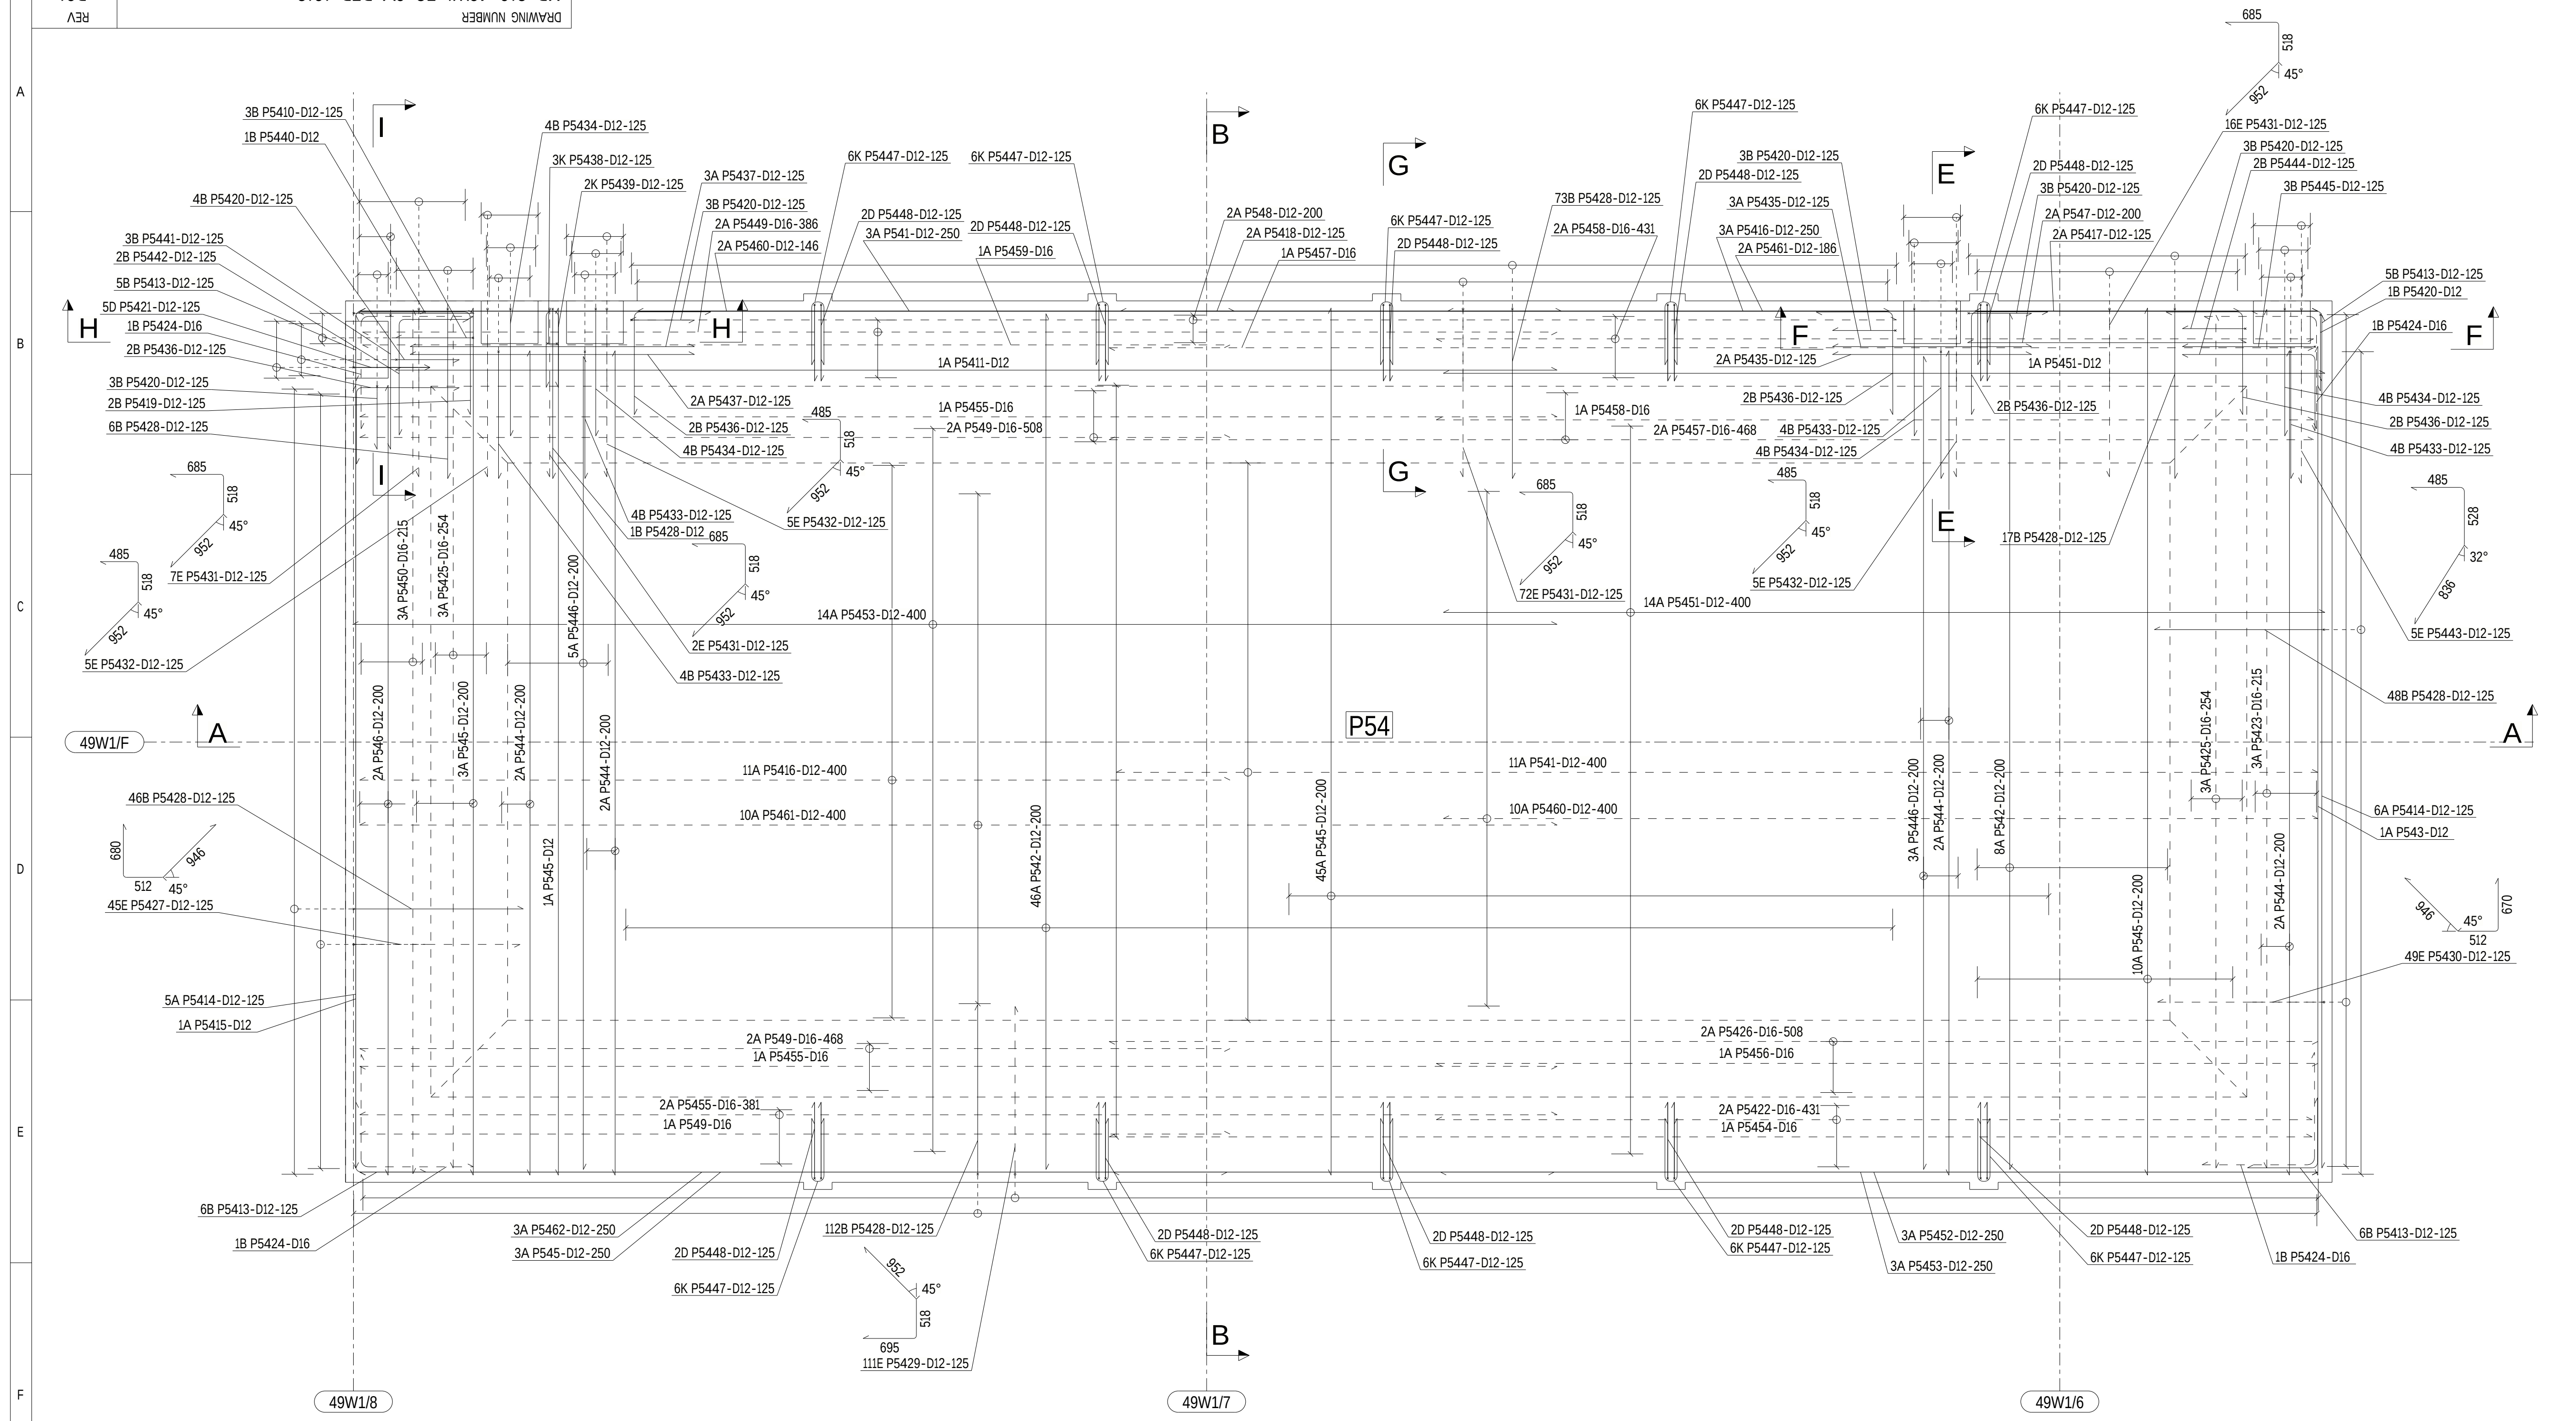

R.C.C GROUND SLAB REINFORCEMENT

(SCALE 1:30)

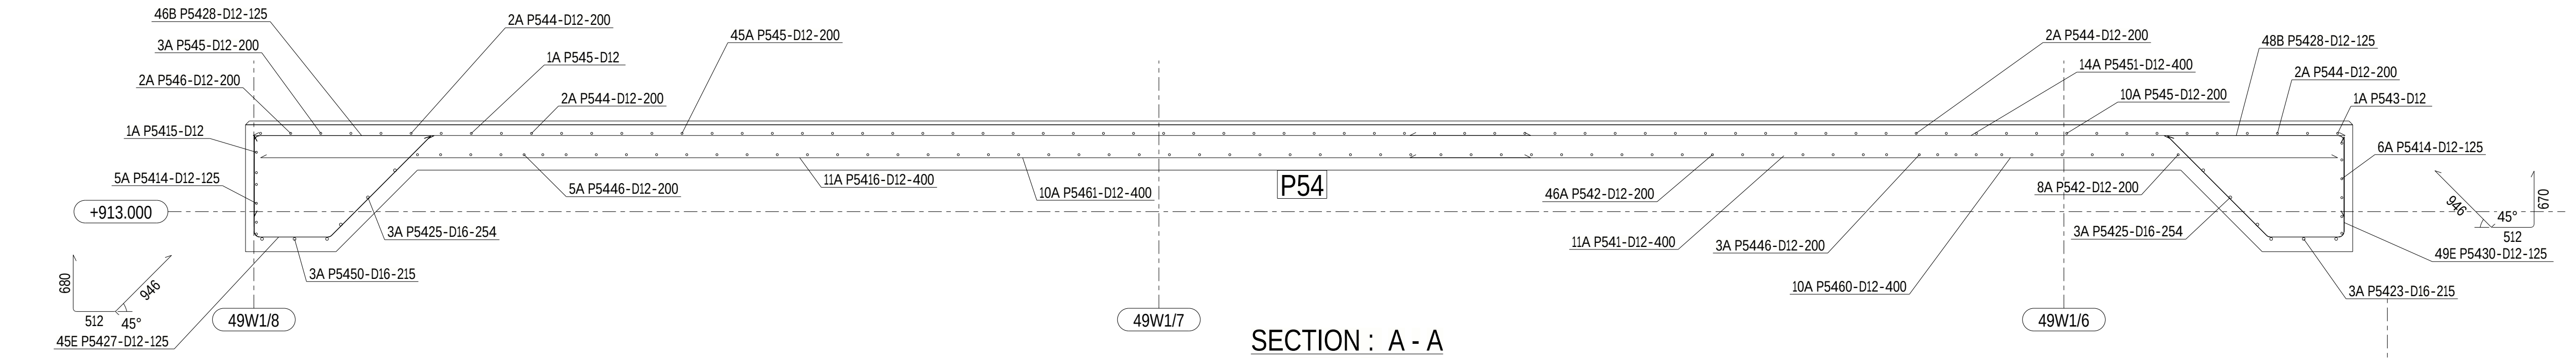

SECTION : A - A

(SCALE 1:30)

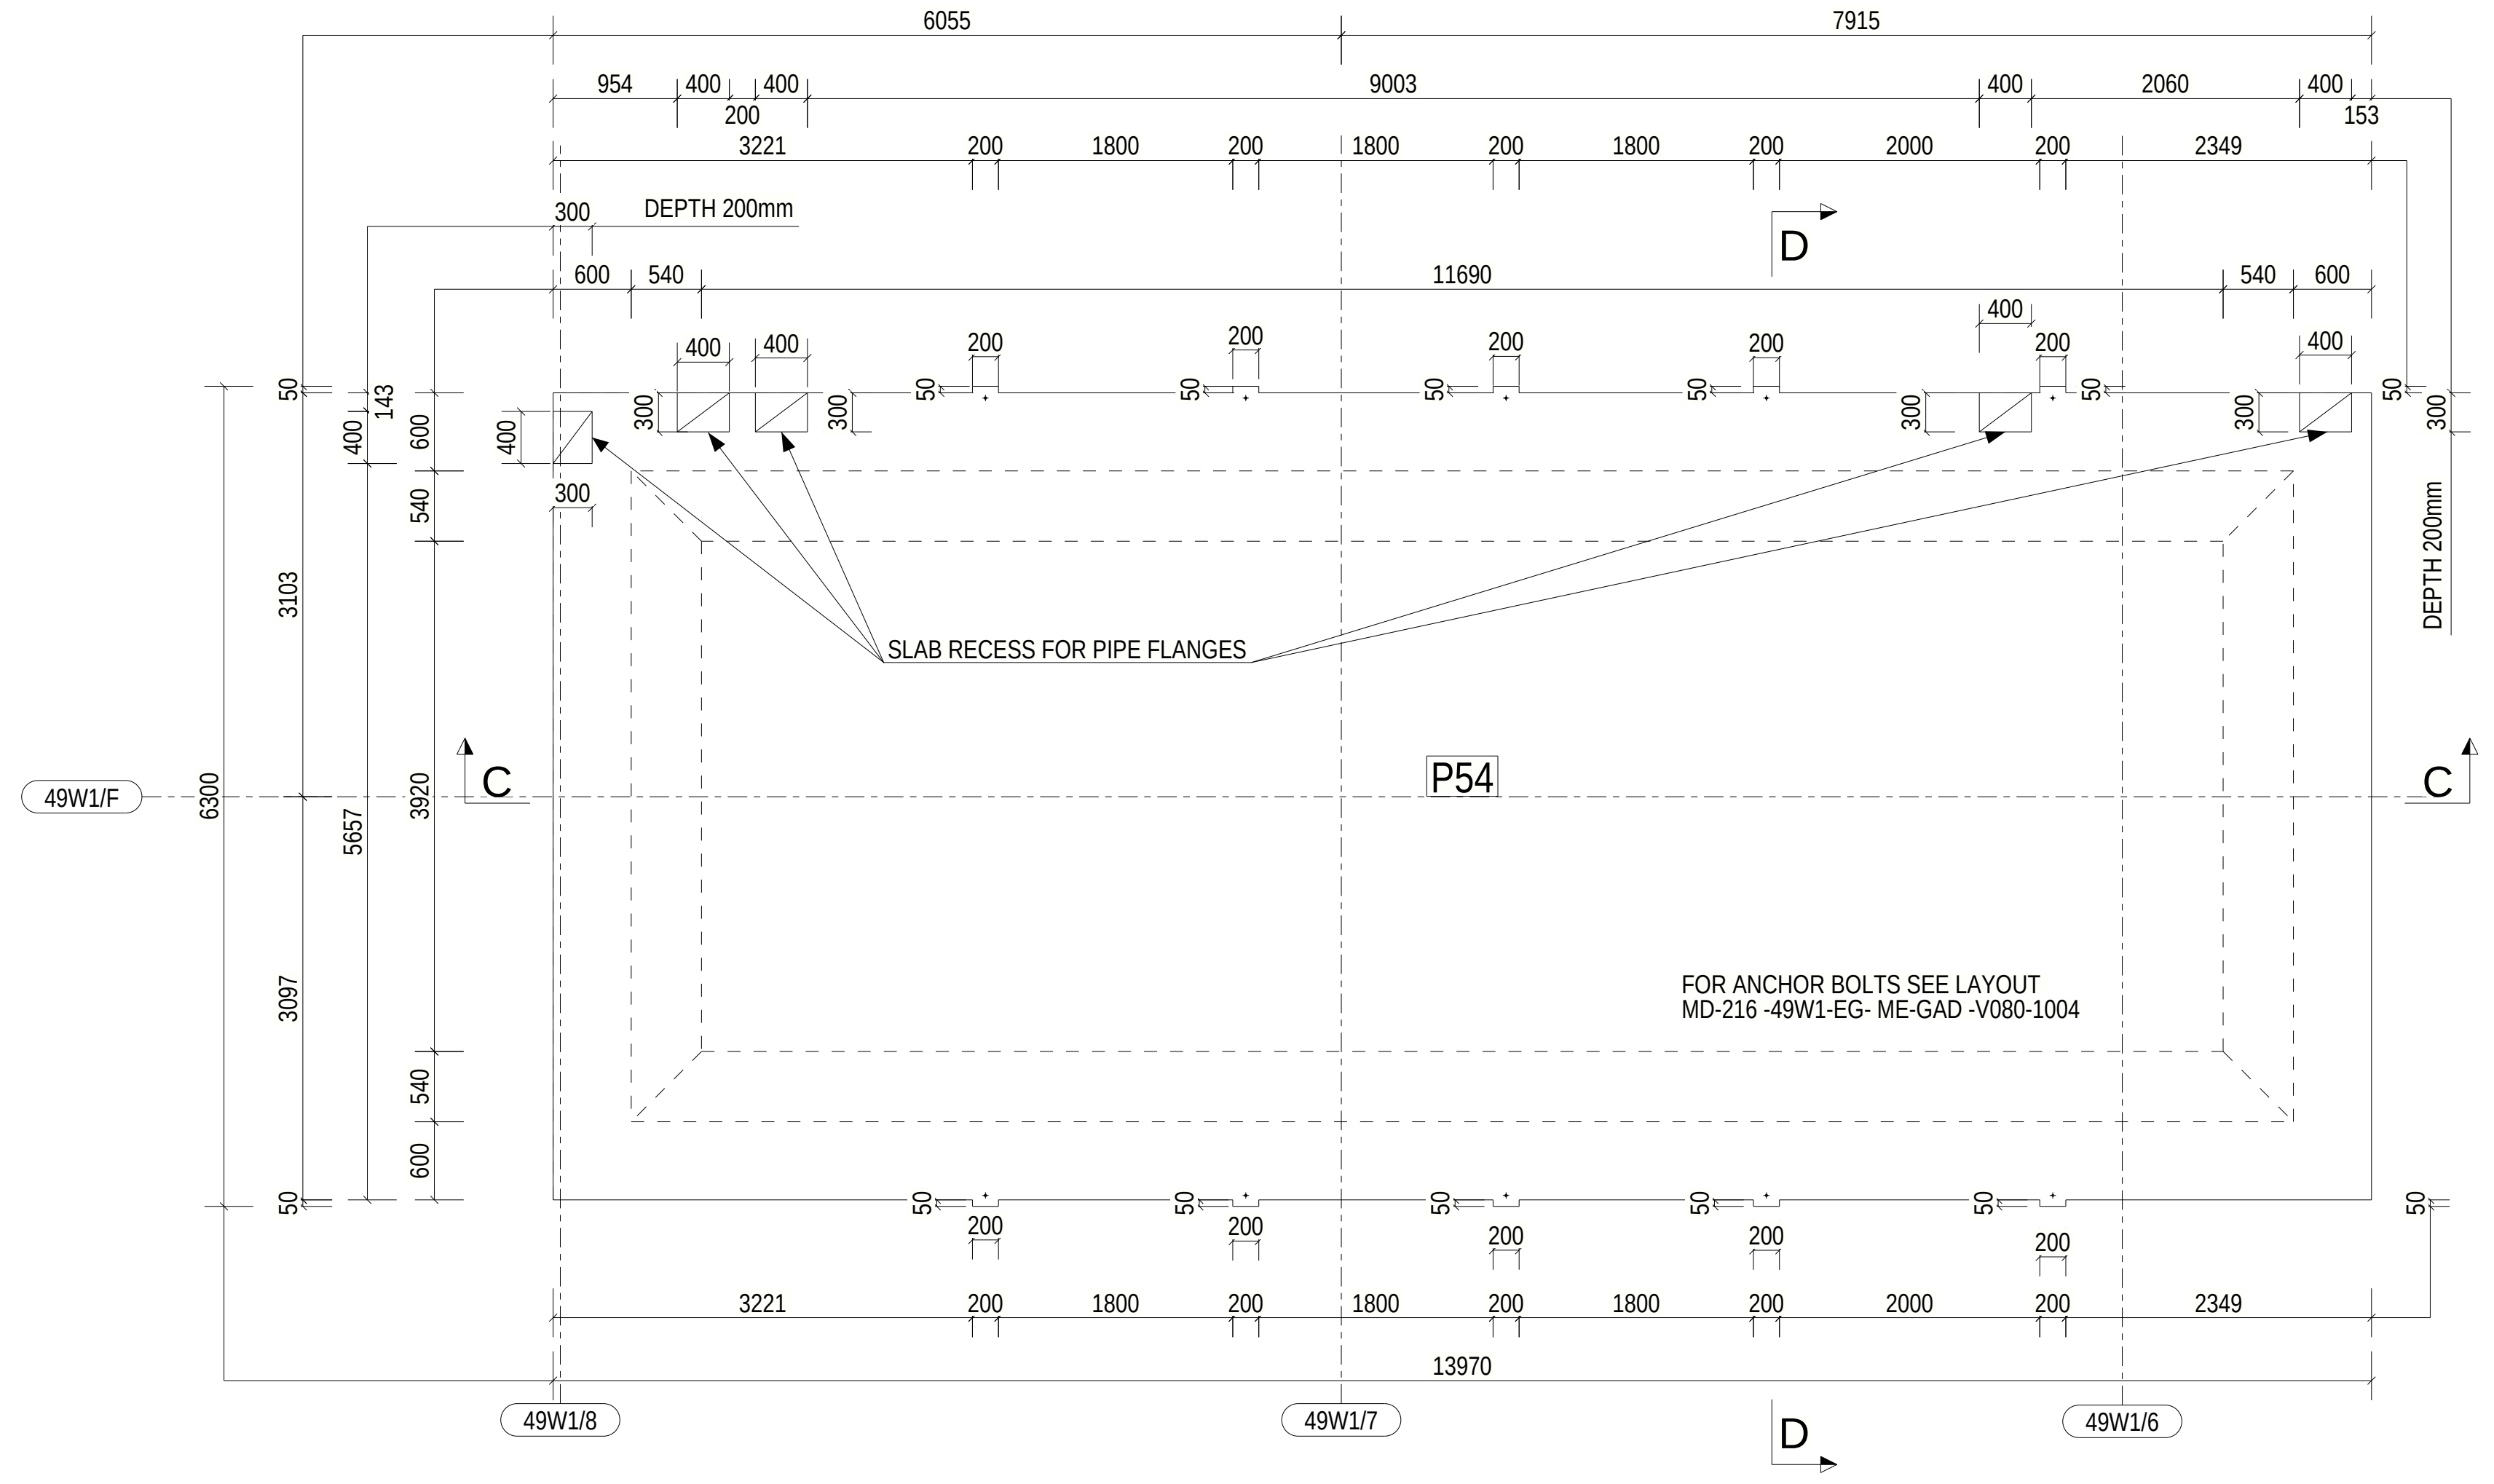

R.C.C

(SCALE 1:50)

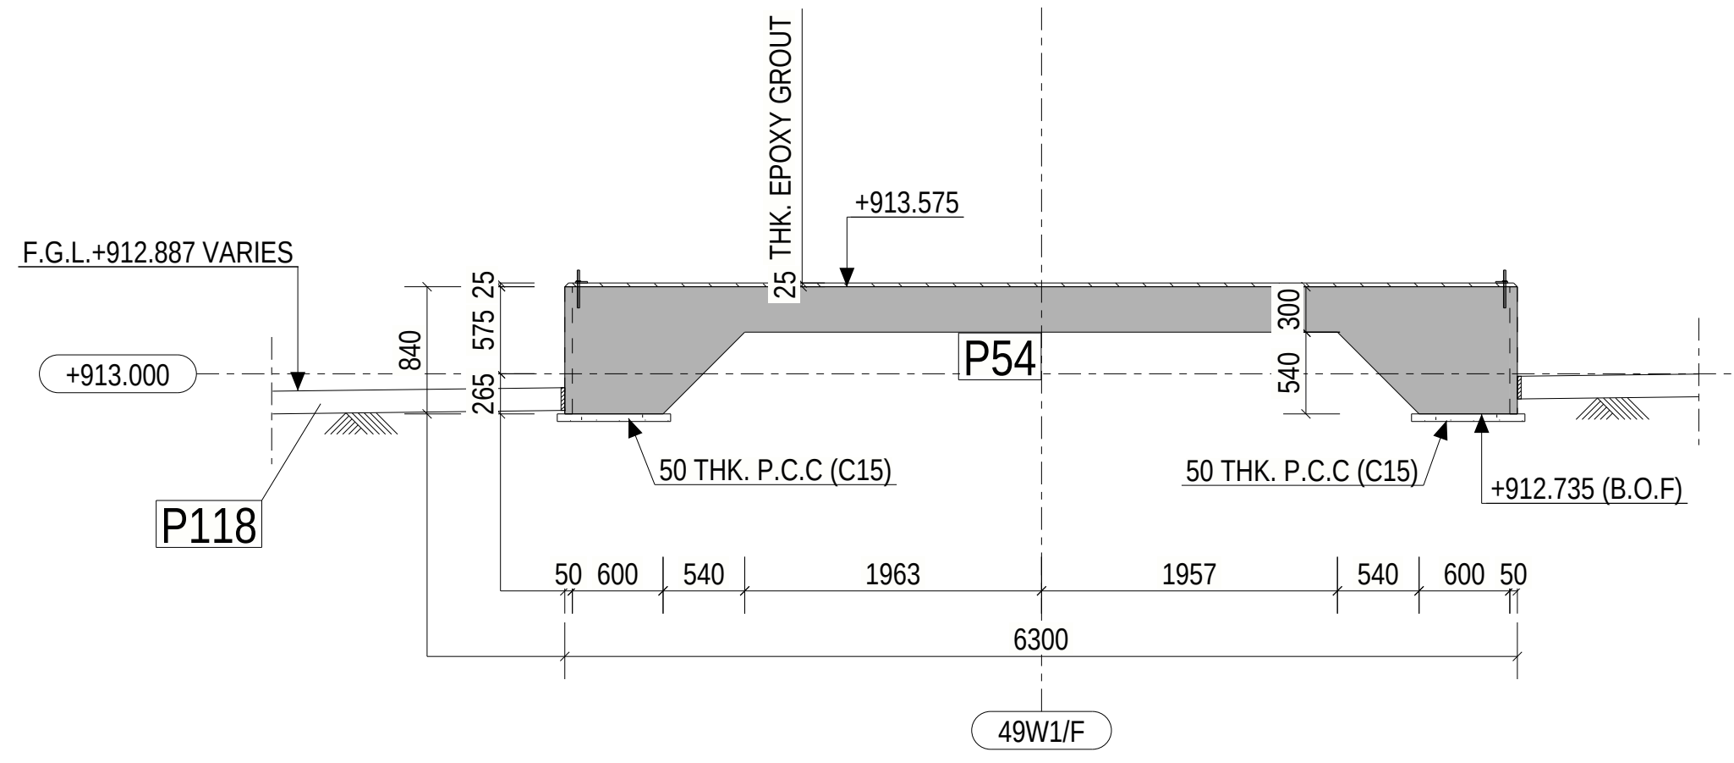

SECTION : D - D

(SCALE 1:50)

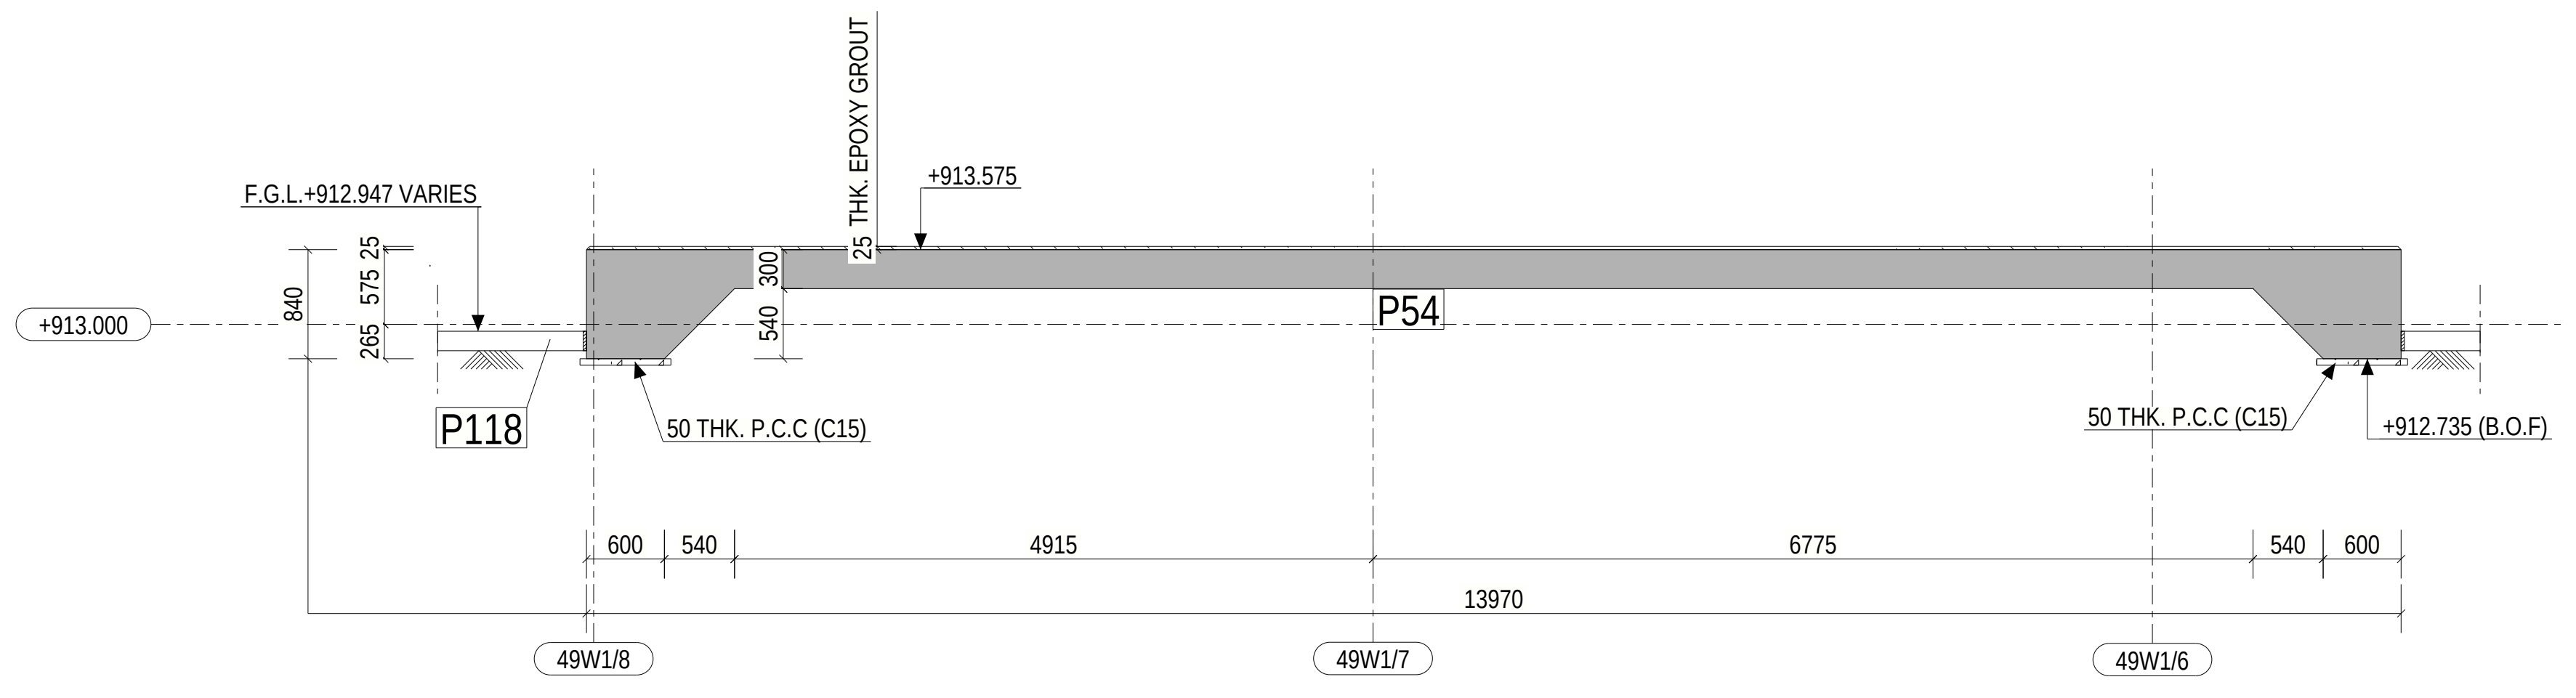

SECTION : C - C

(SCALE 1:50)

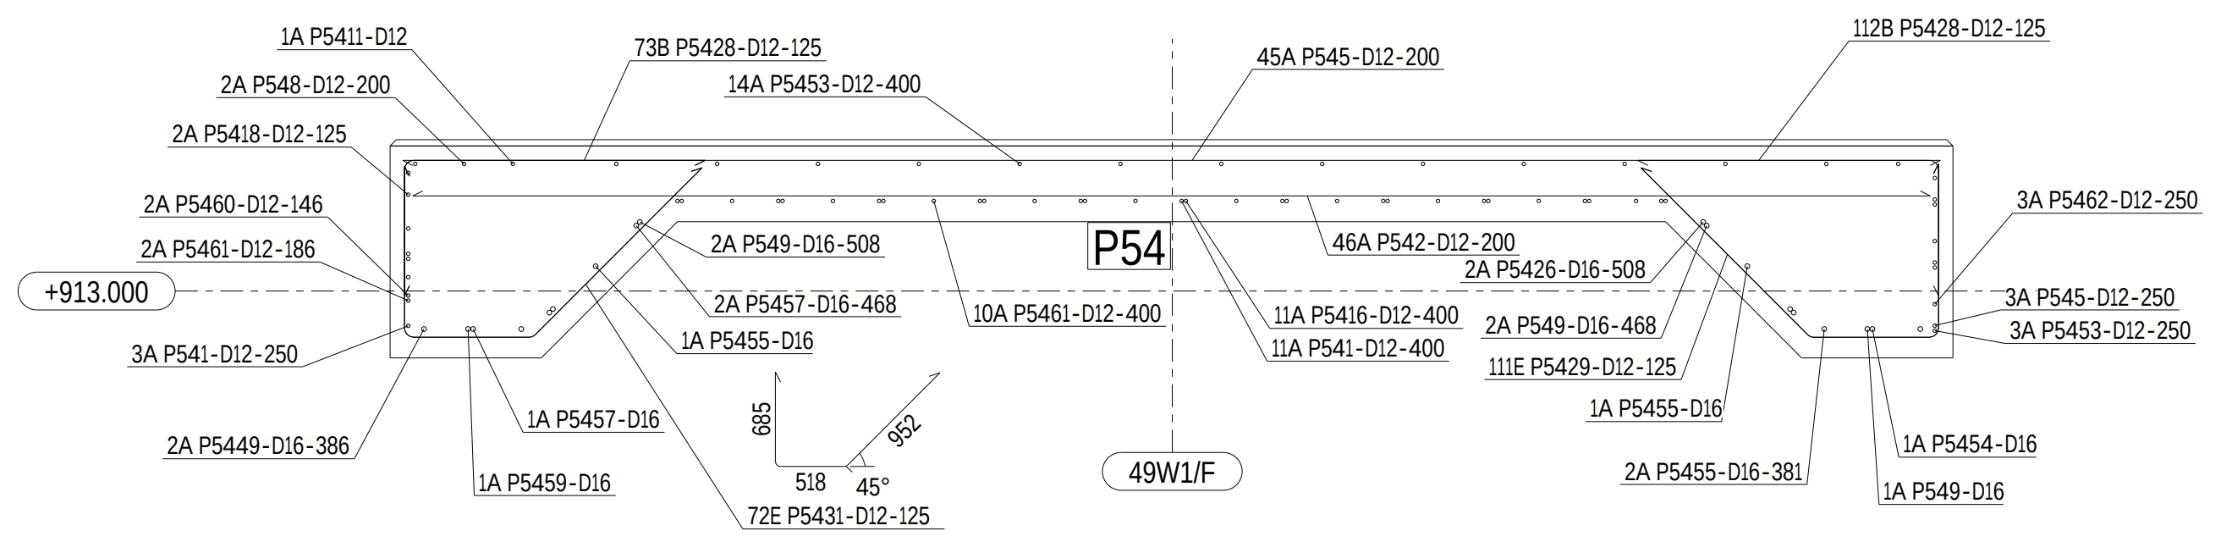

SECTION : B - B

(SCALE 1:30)

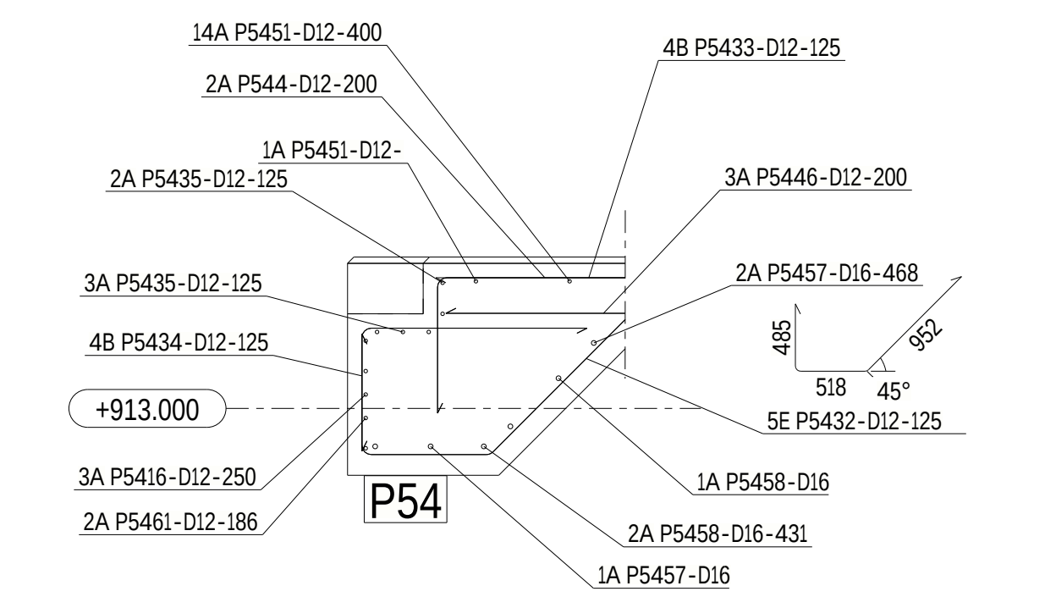

SECTION : E - E

(SCALE 1:30)

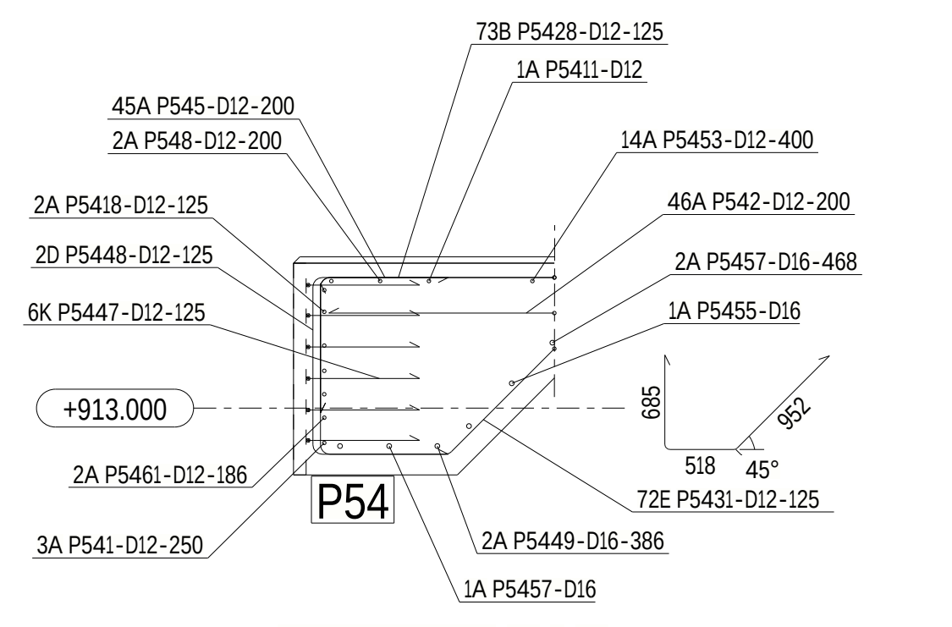

SECTION : G - G

(SCALE 1:30)

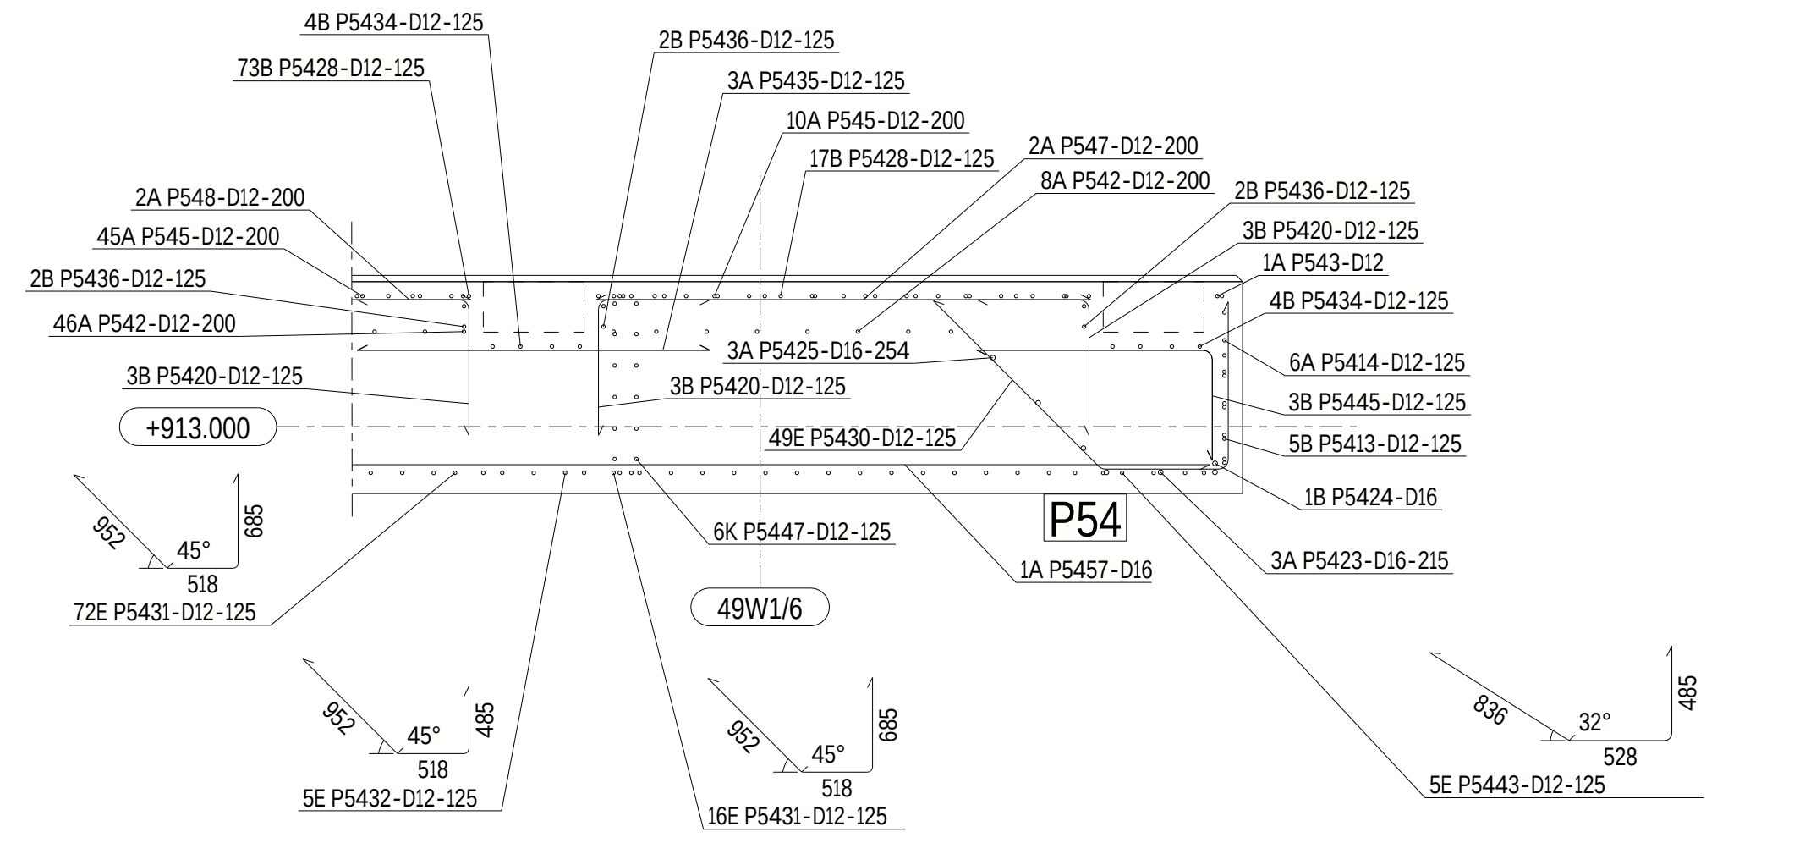

SECTION : F - F

(SCALE 1:30)

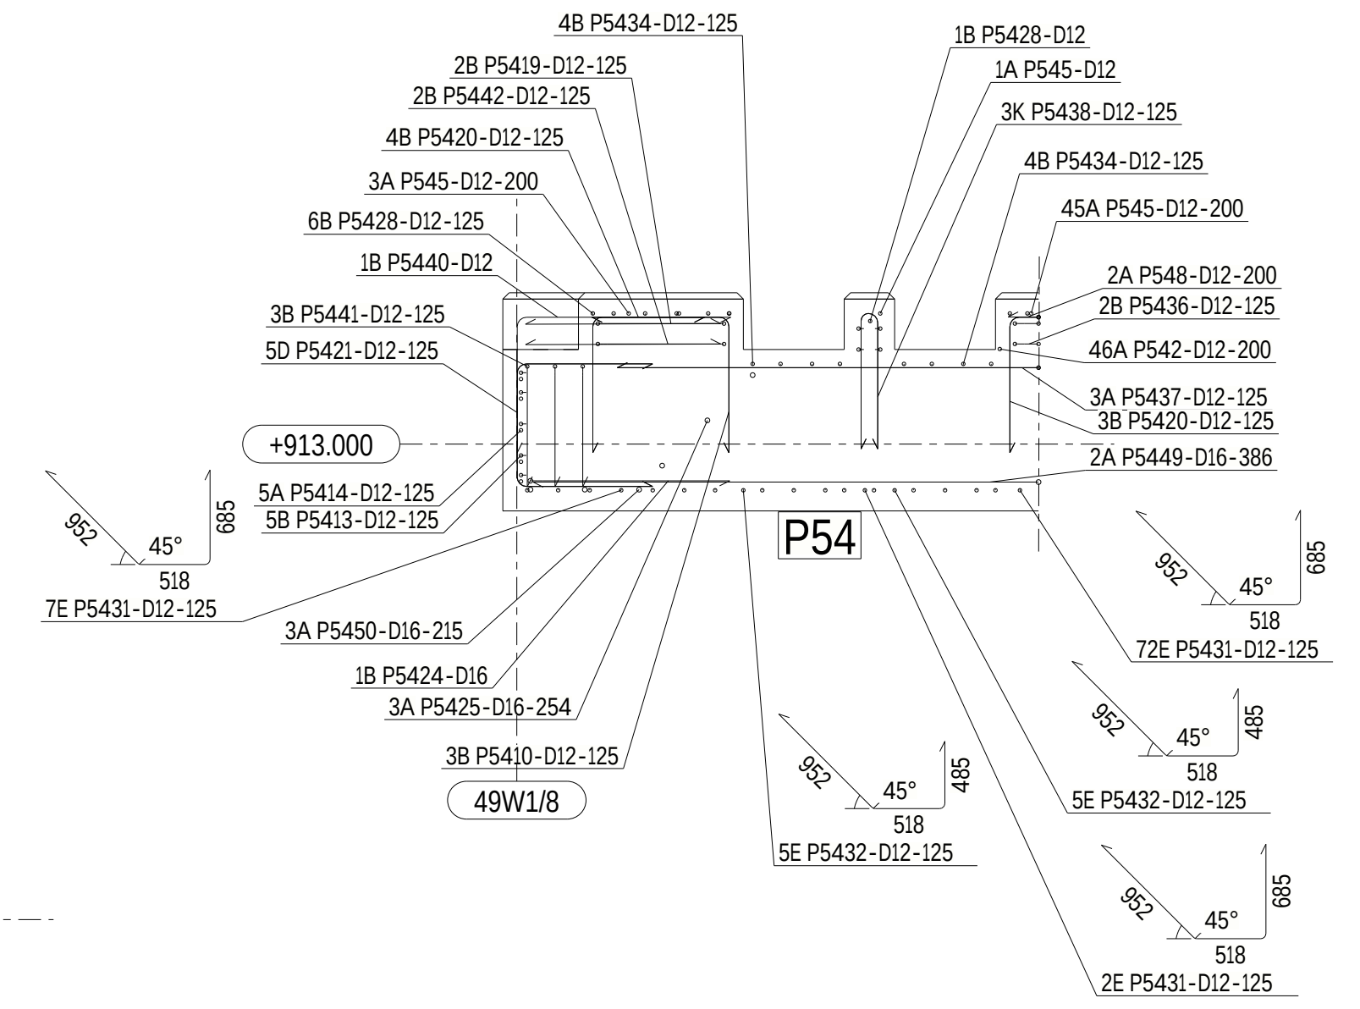

SECTION : H - H

(SCALE 1:30)

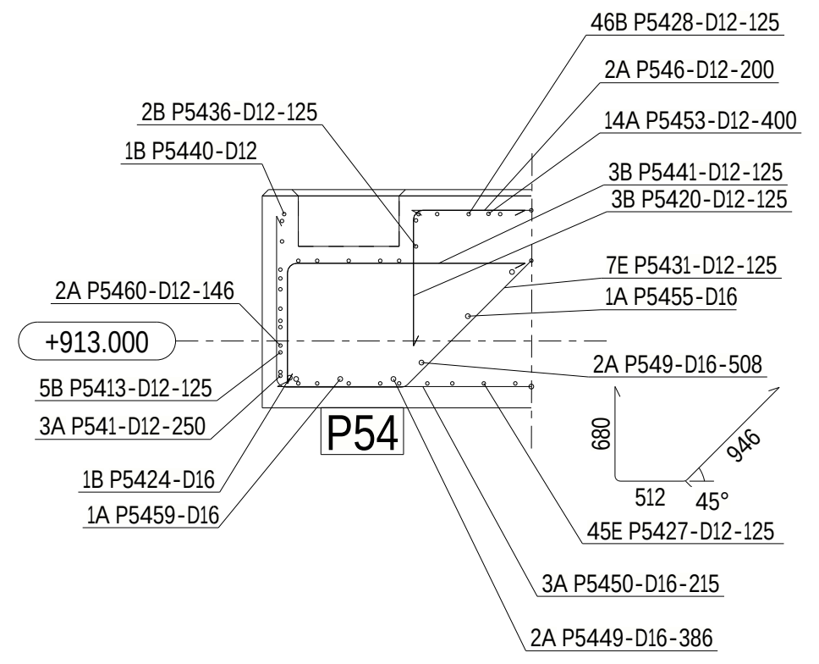

SECTION : I - I

(SCALE 1:30)

CONCRETE INFORMATION

Concretes used	C35	
Concrete cover 1	75±10mm	BOTTOM OF SLAB
Concrete cover 2	50±10mm	SIDES AND TOP OF SLAB, WALLS

REINFORCING BAR LIST

CAST UNIT CODE: P54 PCS: 1

REINFORCING BARS				D	L	dL	WEIGHT	BENDING DIMENSIONS [mm]									COMMENT
TYPE	POS	PCS	GRADE	[mm]	[mm]	[mm]	SUM [kg]	a	b	c	d	e	u	v	x	TD	
A	P541	14	B500B	12	8450		105.1	8450									
A	P542	54	B500B	12	6020		288.7	6020									
A	P543	1	B500B	12	5830		5.2	5830									
A	P544	8	B500B	12	5800		41.2	5800									
A	P545	62	B500B	12	6100		335.8	6100									
A	P546	2	B500B	12	5550		9.9	5556									
A	P547	2	B500B	12	1960		3.5	1960									
A	P548	2	B500B	12	8900		15.8	8903									
A	P549	5	B500B	16	6120		48.3	6120									
B	P5410	3	B500B	12	1060		2.8	544	550				90			60	
A	P5411	1	B500B	12	8170		7.3	8170									
B	P5413	22	B500B	12	970		18.9	500	500				90			60	
A	P5414	11	B500B	12	6000		58.6	6000									
A	P5415	1	B500B	12	5500		4.9	5506									
A	P5416	14	B500B	12	6120		76.1	6120									
A	P5417	2	B500B	12	1860		3.3	1860									
A	P5418	2	B500B	12	8800		15.6	8803									
B	P5419	2	B500B	12	1490		2.7	730	794				90			60	
B	P5420	20	B500B	12	960		17.1	450	544				90			60	
D	P5421	5	B500B	12	1520		6.8	544	500	544						60	
A	P5422	2	B500B	16	6160		19.5	6160									
A	P5423	3	B500B	16	6040		28.6	6040									
B	P5424	4	B500B	16	1550		9.9	800	800				90			80	
A	P5425	6	B500B	16	6000		56.9	6000									
A	P5426	2	B500B	16	8500		26.9	8500									
E	P5427	45	B500B	12	2100		84.0	680	512	946			45			60	
B	P5428	303	B500B	12	1710		461.2	1200	544				90			60	
E	P5429	111	B500B	12	2120		209.9	695	518	952			45			60	
E	P5430	49	B500B	12	2090		91.0	670	512	946			45			60	
E	P5431	97	B500B	12	2110		182.5	685	518	952			45			60	
E	P5432	15	B500B	12	1910		25.6	485	518	952			45			60	
B	P5433	16	B500B	12	1410		20.1	900	544				90			60	
B	P5434	16	B500B	12	1360		19.4	900	494				90			60	
A	P5435	5	B500B	12	1400		6.2	1400									
B	P5436	10	B500B	12	1240		11.0	730	544				90			60	
A	P5437	5	B500B	12	2000		8.9	2000									
K	P5438	3	B500B	12	1100		3.0	544	544							60	
K	P5439	2	B500B	12	1120		2.0	544	544							60	
B	P5440	1	B500B	12	1360		1.2	853	544				90			60	
B	P5441	3	B500B	12	1400		3.7	484	950				90			60	
B	P5442	2	B500B	12	1280		2.3	494	820				90			60	
E	P5443	5	B500B	12	1810		8.1	485	528	836			32			60	
B	P5444	2	B500B	12	1450		2.6	544	940				90			60	
B	P5445	3	B500B	12	1350		3.6	444	940				90			60	
A	P5446	8	B500B	12	5720		40.6	5720									
K	P5447	60	B500B	12	940		50.1	450	450							60	
D	P5448	20	B500B	12	1740		31.0	544	715	544						60	
A	P5449	2	B500B	16	8400		26.5	8400									
A	P5450	3	B500B	16	6080		28.8	6080									
A	P5451	15	B500B	12	6200		82.6	6200									
A	P5452	3	B500B	12	6170		16.4	6170									
A	P5453	17	B500B	12	8470		127.9	8470									
A	P5454	1	B500B	16	8460		13.4	8460									
A	P5455	4	B500B	16	8420		53.2	8420									
A	P5456	1	B500B	16	6200		9.8	6200									
A	P5457	3	B500B	16	8470		40.1	8470									
A	P5458	3	B500B	16	6170		29.2	6170									
A	P5459	1	B500B	16	6100		9.6	6100									
A	P5460	12	B500B	12	6150		65.5	6150									
A	P5461	12	B500B	12	8420		89.7	8420									
A	P5462	3	B500B	12	8400		22.4	8400									

REINFORCING BAR TOTAL WEIGHT [kg] 3092.5

REINFORCEMENT BENDING SHAPES:

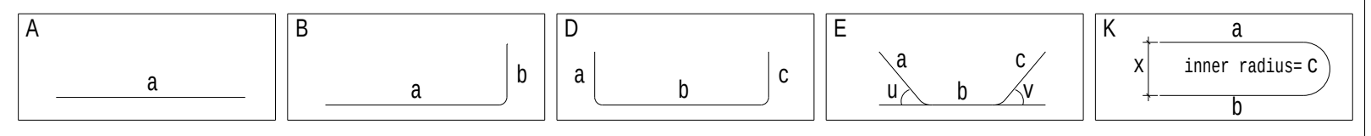

LEGEND:

R.L. - REDUCED LEVEL
T.O.C. - TOP OF CONCRETE
B.O.F. - BOTTOM OF FOUNDATION
F.G.L. - FINISHED GROUND LEVEL
P.C.C. - PLAIN CEMENT CONCRETE
TYP - TYPICAL
MKD - MARKED
CL - CENTER LINE
BOTTOM REINF. (B)
TOP REINF. (T)
SBC - SAFE BEARING CAPACITY
MIN. - MINIMUM
REF. - REFERED
GA - GENERAL ARRANGEMENT
DWG. - DRAWING
R.C.C. - REINFORCED CEMENT CONCRETE

NOTES:

1. ALL DIMENSIONS ARE IN MILLIMETRES AND LEVELS ARE IN METRES UNLESS OTHERWISE STATED

2. GRADE OF CONCRETE SHALL BE C35 (35MPa) UNLESS NOTED OTHERWISE & C15 (15MPa) FOR BLINDING CONCRETE.

3. GRADE OF REINFORCEMENT SHALL BE DEFORMED BAR ASTM A615-GRADE 60 (fy=420MPa)

4. CLEAR COVER TO MAIN REINFORCEMENT SHALL BE AS FOLLOWS:
a) FOUNDATION: 75 mm (BOTTOM & SIDE)
b) FOUNDATION: 50 mm (TOP)
c) COLUMN & PEDESTAL: 50 mm

5. MINIMUM LAP LENGTHS OF REINFORCEMENT SHALL BE 40XBAR DIAMETER

6. FOR STANDARD REINFORCEMENT DETAILS & GENERAL NOTES FOR CIVIL WORKS REFER TO DRAWING NUMBER MD-216-1000-EG-CV-DED-1005 & 1001

7. ANCHOR BOLTS AND EMBEDDED STEELWORK SHALL BE HOT DIP GALVANIZED

8. T.O.C. & TOP OF SCREED TOLERANCE SHALL BE WITHIN +/- 10MM OF DESIGN LEVEL

9. NET SAFE BEARING CAPACITY OF SOIL AT BOTTOM OF FOUNDATION IS CONSIDERED AS 375 KN/SQ.M.

10. REBARS CAN BE MOVED LOCALLY BY +/- 25mm TO AVOID INTERFERENCE WITH EMBEDDED PARTS

KEYPLAN

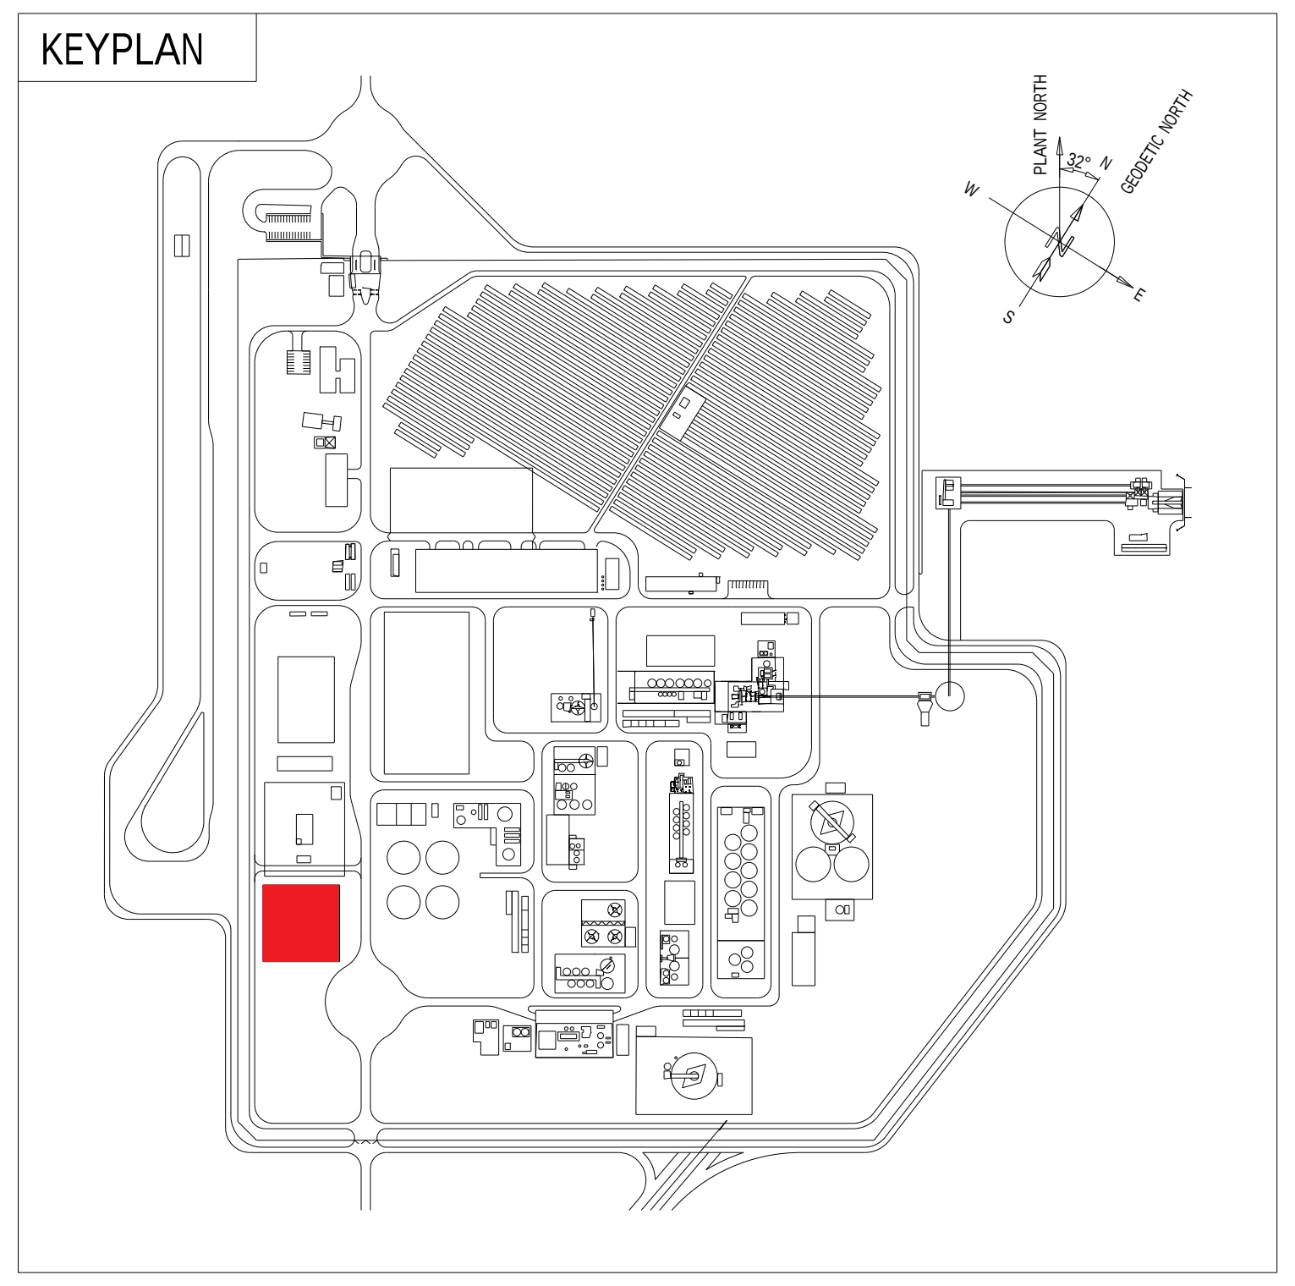

DOCUMENT NUMBER	REFERENCE DOCUMENTS	DOCUMENT NUMBER	REFERENCE DOCUMENTS
MD-216-1000-EG-ST-CRT-1001	DESIGN CRITERIA	MD-216-49W1-EG-CV-CAL-1006	DAF BASIN, COAGULANT BASIN, PIT, SLUDGE BASIN, VESSEL FOUNDATION
MD-216-49W1-EG-CV-GAD-1003	1-10/A-E GENERAL ARRANGEMENT DRAWING	MD-216-49W1-EG-ME-GAD-V080-1004	MICROFLOTATION BASIN FLOODAF B-74
MD-216-49W1-EG-CV-GAD-1001	1-8/E-J GENERAL ARRANGEMENT DRAWING	MD-216-49W1-EG-CV-GAD-1002	7-12/D-J GENERAL ARRANGEMENT DRAWING

REV	DATE	REVISION DESCRIPTION	DRN	CHK	ENG	APP	EMP
D01	29.01.2024	AS-BUILT	EvgPon	MauNot	LuiPiz	SouCha	
C01	18.01.2022	ISSUED FOR CONSTRUCTION	EvgPon	MauNot	NanWu	LuiPiz	
A01	17.12.2021	ISSUED FOR APPROVAL	EvgPon	MauNot	NanWu	LuiPiz	

RESERVED FOR VENDOR LOGO AND DRAWING NUMBER

LARSEN & TOUBRO

This drawing is the property of LARSEN & TOUBRO and must not be passed on to any person or body not authorized by us to recieve it or be copied or otherwise made use either in full or in part by such person or body without our prior permission in writing.

Outotec

The content of these documents are the sole property of Outotec Oyj. Any rights not expressly granted herein are reserved. Reproduction, transfer or distribution of part or all of the contents in any form without prior written permission of Outotec is prohibited.

MA'ADEN معادن
Saudi Arabian Mining Company شركة التعدين العربية السعودية

This document and the information contained herein is Ma'aden proprietary know-how. This document or any part thereof should not be reproduced, stored in a retrieval system or transmitted by any means, electronic or otherwise, or divulged without prior written permission of Ma'aden.

LARSEN & TOUBRO DRAWING NUMBER
019045_080_C_D_24892_012_R0
REVISION 2

OUTOTEC DRAWING NUMBER
900707_GAU01_AG11_CTB01_49012
DOCUMENT ID
OU100732644
REVISION 2

DRAWN	EvgPon	17.12.2021
CHECKED	MauNot	17.12.2021
ENGINEER	NanWu	17.12.2021
APPROVED	LuiPiz	17.12.2021
EMPLOYER		
SCALE		A0

MANSOURAH - MASSARAH GOLD PROJECT
49W1 RAW WATER TREATMENT PLANT
49W1-TNK-002 DAF BASIN
DIMENSIONAL AND REINFORCEMENT DRAWING

DRAWING NUMBER
MD-216-49W1-EG-CV-DED-1012
REV
D01

Tekla Structures