


MD-216-49W1-EG-CV-DED-1015 | REV D01

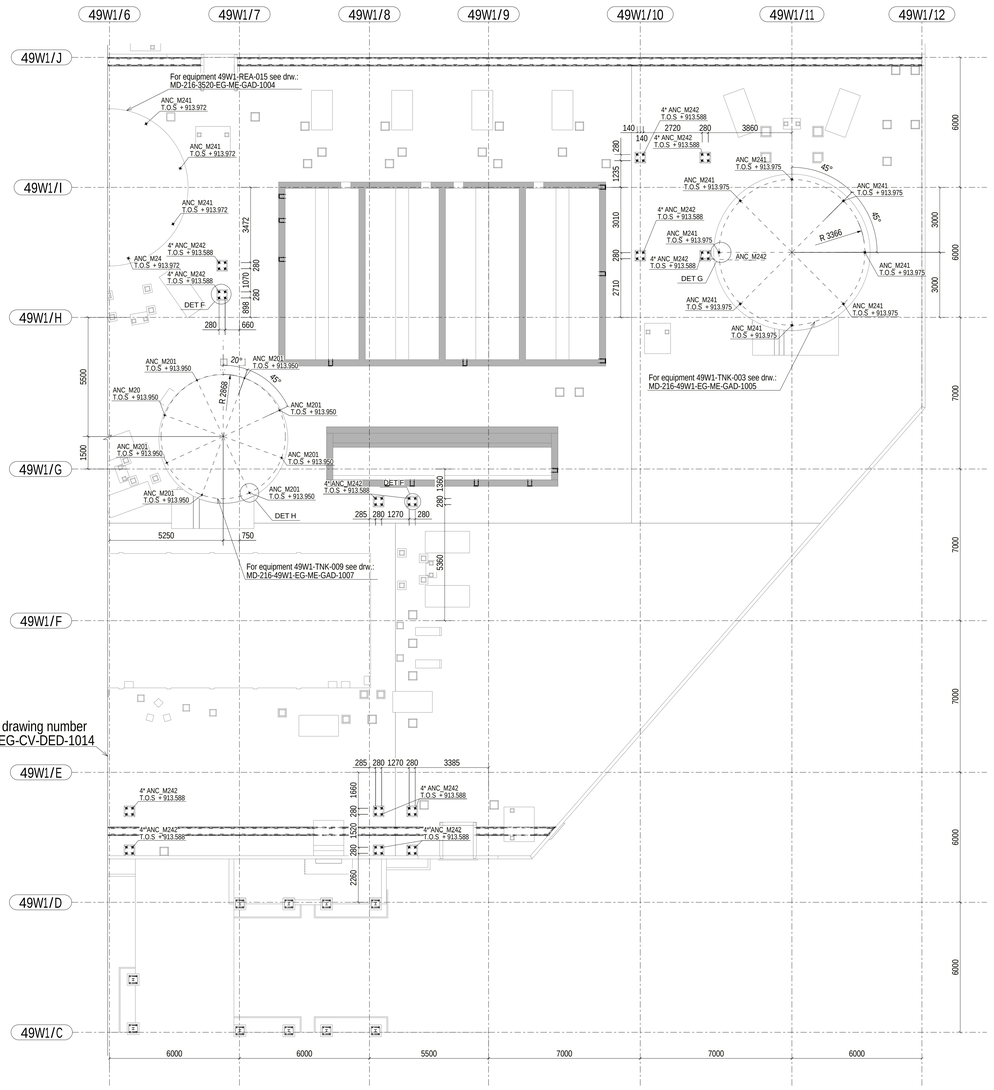


ANCHOR BOLT PLAN
1:100

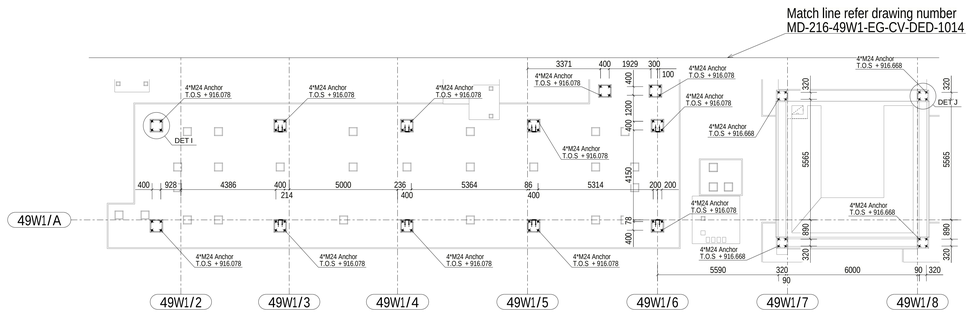

ANCHOR BOLT PLAN
1:100

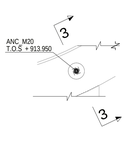

DETAIL F
1:20

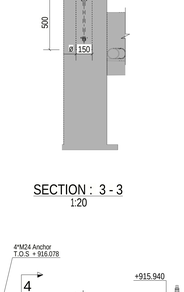


SECTION : 1 - 1
1:20


DETAIL G
1:20



SECTION : 2 - 2
1:20

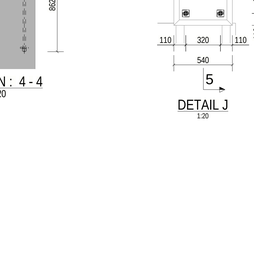

ANCHOR_M201
1:10

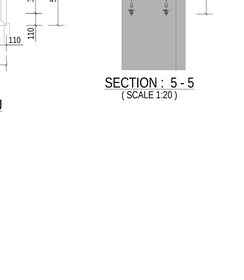


ANCHOR_M241
1:10

SECTION : 3 - 3
1:20


ANCHOR_M242
1:10




DETAIL H
1:20

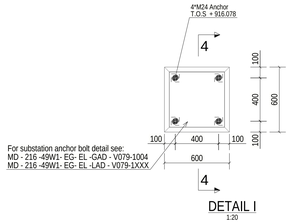

DETAIL I
1:20

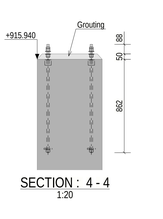

SECTION : 4 - 4
1:20

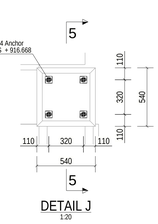

DETAIL J
1:20

SECTION : 5 - 5
(SCALE 1:20)

ANCHOR BOLT NOTES:

1. ALL DIMENSIONS ARE IN MILLIMETERS UNLESS OTHERWISE STATED.
2. GRADE OF CONCRETE FO RCC WORK CNSIDERED TO BE M35 UNLESS OTHERWISE NOTED.
3. ALL BOLTS SHALL CONFORM TO ASTM F1554 GRADE 36.
4. *ALL NUTS SHALL CONFORM TO ASTM A563, GRADE A HEX/HEAVY HEX.
5. WASHERS SHALL BE IN GENERAL SUPPLIED ALONG WITH STRUCTURE TO SUIT DIA OF HOLE PROVIDED IN STUCRTURAL BASE PLATE.
6. WASHERS SHALL BE ASTM S275JR OR EQUIVALENT IF SUPPLIED WITH ANCHOR BOLT.
7. DIA OF HDPE SLEEVE SHALL BE MIN. 2.5xDIA OF BOLT. PIPE SLEEVE SHALL CONFORM TO ASTM D3350.
8. ** PROJECTION LENGTH FOR TANK ANCHOR BOLTS SHALL BE FOLLOWED AS PROVIDED IN RESPECTIVE TANK FOUNDATION G. A DRAWINGS.
9. THE CONTENTS OF THIS DRAWING SHALL CONFORM TO PROVISION OF DOC. #MD-216-1000-EG-ST-CRT-1001.
10. ***HDPE SLEEVE SHALL CONFORM TO ASTM D3350. ACID/ ALKALI/ CYANIDE RESISTANT PAINTING AS PER PAINTING SPECIFICATOIN CAN BE APPLIED AS AN ALTERNATIVE TO HDPE SLEVE.
11. UNLESS NOTED OTHERWISE ON DESIGN DRAWINGS, ANCHOR BOLT SLEEVES FOR STATIONARY EQUIPMENT AND STRUCTURAL BASE PLATES SHALL BE FILLED WITH GROUT AFTER THE COLUMN OR QUIPMENT IS IN PLACE AND THE ANCHOR BOLTS ARE ALIGNED. WATER OR OTHER LOOSE PARTICLES SHALL NOT BE ALLOWED TO COLLECT IN THE SLEEVE BEFORE THE SLEEVE IS GROUTED.
12. ANCHOR BOLTS SHALL BE TIGHTENED TO A SNUG CONDITION UNLESS NOTED OTHERWISE ON THE DESIGN DRAWINGS, AT SLIDE PLATE LOCATIONS, NUTS SHALL BE BACKED OFF HALF A TURN AND A SECOND NUT SHALL BE ADDED.


LEGEND:

R.L - REDUCED LEVEL
T.O.C. - TOP OF CONCRETE
B.O.F. - BOTTOM OF FOUNDATION
F.G.L - FINISHED GROUND LEVEL
P.C.C. - PLAIN CEMENT CONCRETE
TYP - TYPICAL
MKD - MARKED
CL - CENTER LINE
BOTTOM REINF. (B)
TOP REINF. (T)
SBC - SAFE BEARING CAPACITY
MIN. - MINIMUM
REF. - REFERED
GA - GENERAL ARRANGEMENT
DWG. - DRAWING
R.C.C. - REINFORCED CEMENT CONCRETE

NOTES:

1. ALL DIMENSIONS ARE IN MILLIMETRES AND LEVELS ARE IN METRES UNLESS OTHERWISE STATED
2. GRADE OF CONCRETE SHALL BE C35 (35MPa) UNLESS NOTED OTHERWISE & C15 (15MPa) FOR BUNDING CONCRETE.
3. GRADE OF REINFORCEMENT SHALL BE DEFORMED BAR ASTM A615-GRADE 60 (fy=420MPa)
4. CLEAR COVER TO MAIN REINFORCEMENT SHALL BE AS FOLLOWS:
a) FOUNDATION: 75 mm (BOTTOM & SIDE)
b) FOUNDATION: 50 mm (TOP)
c) COLUMN & PEDESTAL: 50 mm
5. MINIMUM LAP LENGTHS OF REINFORCEMENT SHALL BE 40XBAR DIAMETER
6. FOR STANDARD REINFORCEMENT DETAILS & GENERAL NOTES FOR CIVIL WORKS REFER TO DRAWING NUMBER MD-216-1000-EG-CV-DED-1005 & 1001
7. ANCHOR BOLTS AND EMBEDDED STEELWORK SHALL BE HOT DEEP GALVANIZED
8. T.O.C. & TOP OF SCREED TOLERANCE SHALL BE WITHIN +/- 10MM OF DESIGN LEVEL
9. NET SAFE BEARING CAPACITY OF SOIL AT BOTTOM OF FOUNDATION IS CONSIDERED AS 375 KN/SQ.M.
10. REBARS CAN BE MOVED LOCALLY BY +/- 25mm TO AVOID INTERFERENCE WITH EMBEDDED PARTS
11. FOR CONCRETE GENERAL ARRANGEMENT REFER DRAWING NUMBER MD-216-49W1-EG-CV-GAD-1001

KEYPLAN

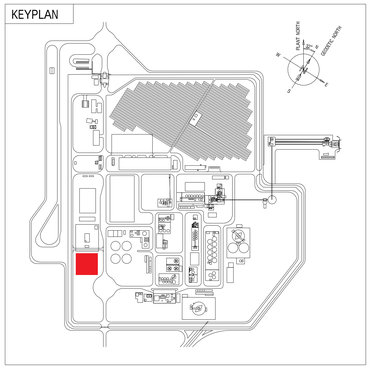

DOCUMENT NUMBER	REFERENCE DOCUMENTS	DOCUMENT NUMBER	REFERENCE DOCUMENTS
MD-216-49W1-EG-CV-DED-1019	PIPERACK FOUNDATION 2		
MD-216-49W1-EG-CV-DED-1010	SUBSTATION AND TRANSFORMER FOUNDATION	MD-216-49W1-EG-CV-DED-1014	ANCHOR BOLT PLAN 1
MD-216-49W1-EG-CV-DED-1017	EQUIPMENT FOUNDATIONS PUMPS1	MD-216-49W1-EG-CV-DED-1018	EQUIPMENT FOUNDATIONS PUMPS2
MD-216-49W1-EG-CV-DED-1006	STAIRCASE FOUNDATIONS	MD-216-49W1-EG-CV-DED-1016	PIPERACK FOUNDATION 1
MD-216-49W1-EG-CV-DED-1001	BUFFER TANK FOUNDATIONS	MD-216-49W1-EG-CV-DED-1002	BACKWASH & REJECT TANK FOUNDATIONS

REV	DATE	REVISION DESCRIPTION	DRN	CHK	ENG	APP	EMP
D01	29.01.2024	AS-BUILT	MaxCh	MauNot	LuiPiz	SouCha	
C01	29.12.2021	ISSUED FOR CONSTRUCTION, UPDATED TANK GROUTINGS	MaxCh	MauNot	LuiPiz	SouCha	
A01	22.11.2021	ISSUED FOR APPROVAL	JusRak	MauNot	LuiPiz	SouCha	

RESERVED FOR VENDOR LOGO AND DRAWING NUMBER

LARSEN & TOUBRO

This drawing is the property of LARSEN & TOUBRO and must not be passed on to any person or body not authorized by us to receive it or be copied or otherwise made use either in full or in part by such person or body without our prior permission in writing.

Outotec

The content of these documents are the sole property of Outotec Oyj. Any rights not expressly granted herein are reserved. Reproduction, transfer or distribution of part or all of the contents in any form without prior written permission of Outotec is prohibited.

MA'ADEN معادن
Saudi Arabian Mining Company شركة معادن العربية السعودية

This document and the information contained herein is Ma'aden proprietary know-how. This document or any part thereof should not be reproduced, stored in a retrieval system or transmitted by any means, electronic or otherwise, or divulged without prior written permission of Ma'aden.

LARSEN & TOUBRO DRAWING NUMBER: 019045_080_C_D_24892_015 | REVISION: 2
OUTOTEC DRAWING NUMBER: 900707_GAU01_AG11_CTB01_49015 | DOCUMENT ID: OU100732647 | REVISION: 2

DRAWN	JusRak	22.11.2021
CHECKED	MauNot	22.11.2021
ENGINEER	LuiPiz	22.11.2021
APPROVED	SouCha	22.11.2021
EMPLOYER		
SCALE	1:100	A0

MANSOURAH - MASSARAH GOLD PROJECT
GENERAL ARRANGEMENT DRAWING
49W1 RAW WATER TREATMENT PLANT
ANCHOR BOLT PLAN2

DRAWING NUMBER: MD-216-49W1-EG-CV-DED-1015 | REV: D01

Tekla Structures