


DETAIL OF FOUNDATION MKD. P41
(SCALE 1:25)

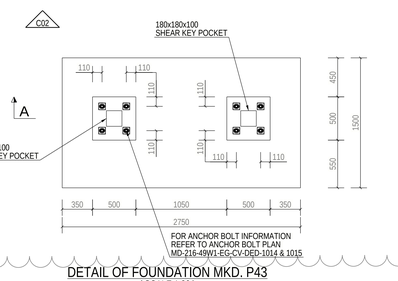


SECTION : A - A
(SCALE 1:30)

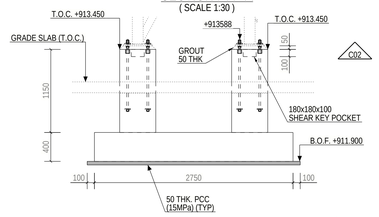


R.C.C. DETAIL OF FOUNDATION MKD. P41
(SCALE 1:30)

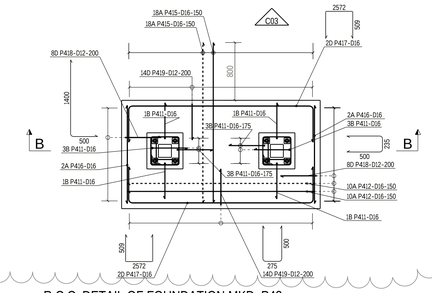


SECTION : B - B
(SCALE 1:30)

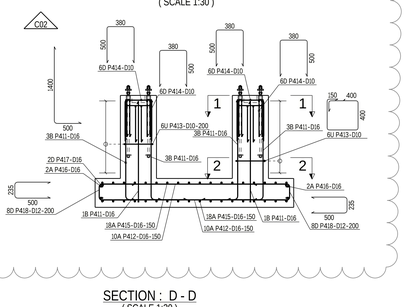


SECTION : 2 - 2
(SCALE 1:15)

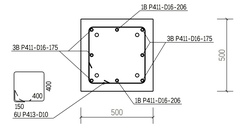


SECTION : 1 - 1
(SCALE 1:15)

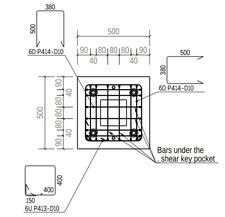


DETAIL OF FOUNDATION MKD. P43
(SCALE 1:30)

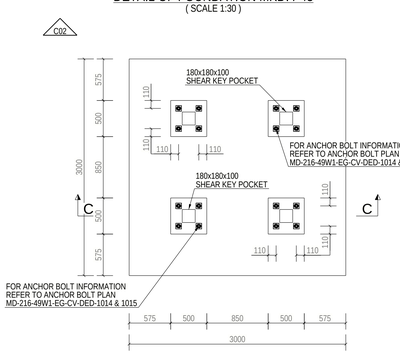


SECTION : C - C
(SCALE 1:30)

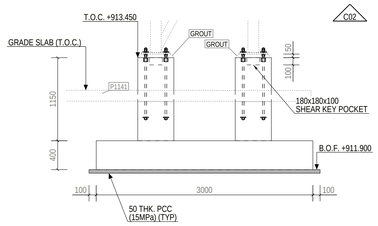


R.C.C. DETAIL OF FOUNDATION MKD. P43
(SCALE 1:30)

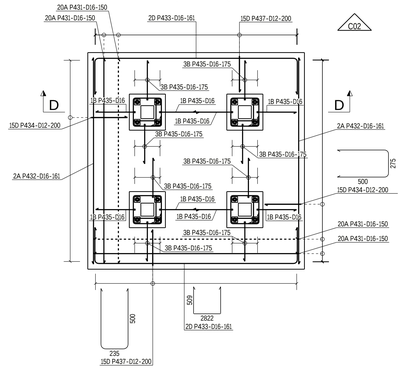


SECTION : D - D
(SCALE 1:30)

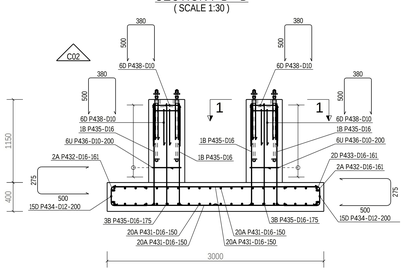


SECTION : 3 - 3
(SCALE 1:15)

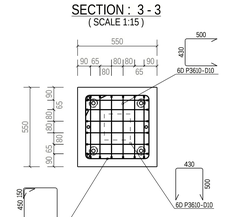


SECTION : E - E
(SCALE 1:30)

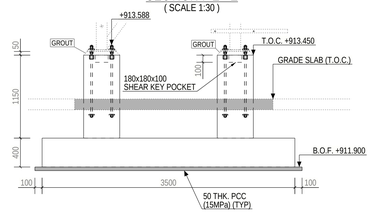


R.C.C. DETAIL OF FOUNDATION MKD. P37
(SCALE 1:30)

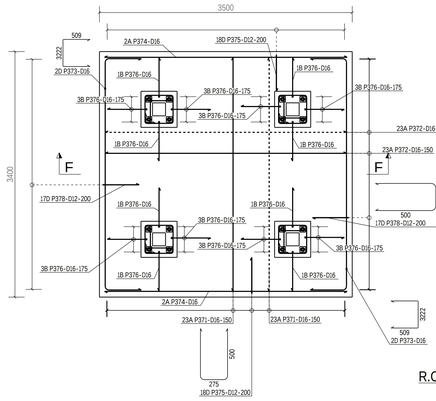


SECTION : F - F
(SCALE 1:30)

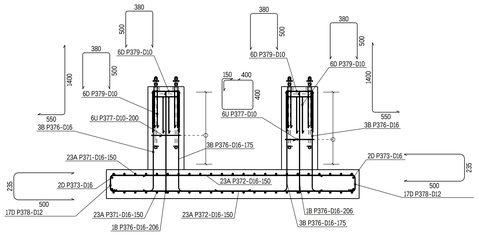


DETAIL OF FOUNDATION MKD. P36 & P46
(SCALE 1:30)

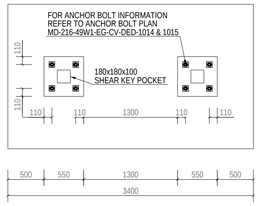


SECTION : G - G
(SCALE 1:30)

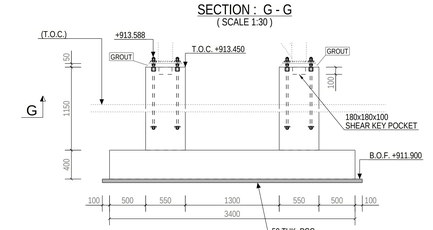


SECTION : 4 - 4
(SCALE 1:15)

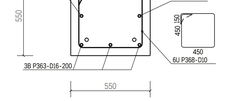


DETAIL OF FOUNDATION MKD. P38
(SCALE 1:30)

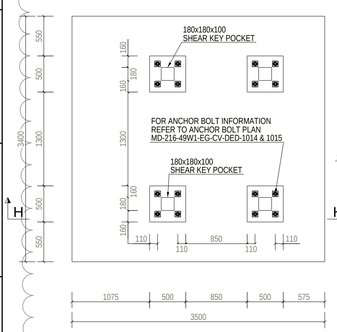


R.C.C. DETAIL OF FOUNDATION MKD. P38
(SCALE 1:30)

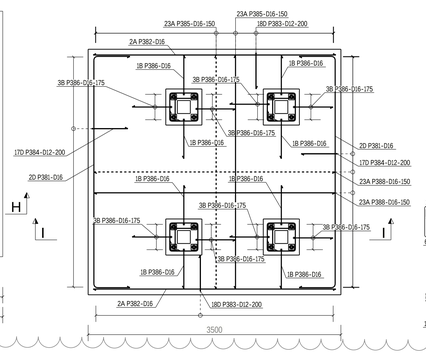


SECTION : I - I
(SCALE 1:30)

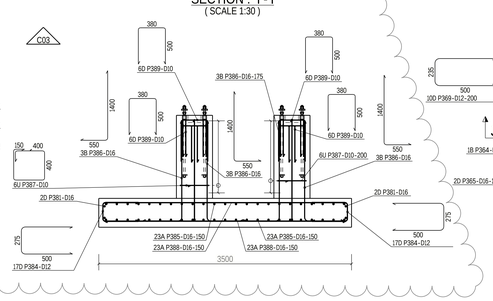


R.C.C. DETAIL OF FOUNDATION MKD. P36 & P46
(SCALE 1:30)

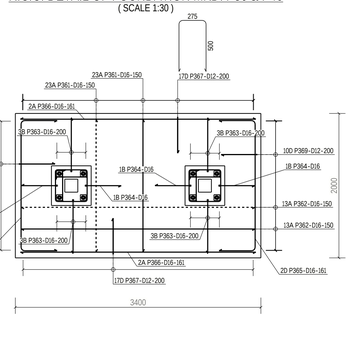

SECTION : J - J
(SCALE 1:30)

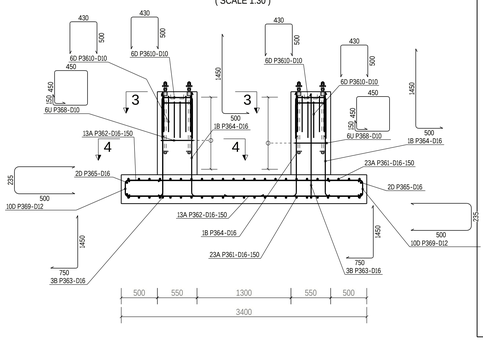

KEYPLAN

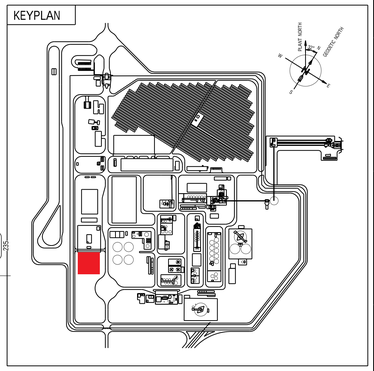

CONCRETE INFORMATION

Concretes used	C35
Concrete cover 1	50x10mm

REINFORCING BAR LIST

CAST UNIT CODE: P36 | PCS: 1

REINFORCING BARS TYPE	POS	PCS	GRADE	D [mm]	L [mm]	dL [mm]	WEIGHT SUM [kg]	BENDING DIMENSIONS [mm] a	b	c	d	e	u	v	x	TD	COMMENT
A	P361	46	B500B	16	1840		133.7	1840									
A	P362	26	B500B	16	3240		133.1	3240									
B	P363	12	B500B	16	2150		40.9	1450	750						90		80	
B	P364	4	B500B	16	1900		12.1	1450	500						90		80	
D	P365	4	B500B	16	2760		17.4	509	1822	509							80	
A	P366	4	B500B	16	3260		20.6	3260										
D	P367	34	B500B	12	1210		36.7	500	275	500							60	
U	P368	12	B500B	10	1980		14.7	150	450	450	450	450					60	
D	P369	20	B500B	12	1170		20.9	500	235	500							60	
D	P3610	24	B500B	10	1380		20.5	500	430	500							40	

REINFORCING BAR TOTAL WEIGHT [kg] 450.6

REINFORCING BAR LIST

CAST UNIT CODE: P37 | PCS: 1

REINFORCING BARS TYPE	POS	PCS	GRADE	D [mm]	L [mm]	dL [mm]	WEIGHT SUM [kg]	BENDING DIMENSIONS [mm] a	b	c	d	e	u	v	x	TD	COMMENT
A	P371	46	B500B	16	3240		235.5	3240									
A	P372	46	B500B	16	3340		242.8	3340									
D	P373	4	B500B	16	4160		26.3	509	3222	509							80	
A	P374	4	B500B	16	3360		21.2	3360										
D	P375	36	B500B	12	1210		38.8	500	275	500							60	
B	P376	32	B500B	16	1900		96.5	1400	550						90		80	
U	P377	24	B500B	10	1780		26.4	150	400	400	400	400					40	
D	P378	34	B500B	12	1170		35.5	500	235	500							60	
D	P379	48	B500B	10	1330		39.5	500	380	500							40	

REINFORCING BAR TOTAL WEIGHT [kg] 762.6

REINFORCING BAR LIST

CAST UNIT CODE: P38 | PCS: 1

REINFORCING BARS TYPE	POS	PCS	GRADE	D [mm]	L [mm]	dL [mm]	WEIGHT SUM [kg]	BENDING DIMENSIONS [mm] a	b	c	d	e	u	v	x	TD	COMMENT
D	P381	4	B500B	16	4160		26.3	509	3222	509							80	
A	P382	4	B500B	16	3360		21.2	3360										
D	P383	36	B500B	12	1170		37.6	500	235	500							60	
D	P384	34	B500B	12	1210		36.7	500	275	500							60	
A	P385	46	B500B	16	3240		235.5	3240										
B	P386	32	B500B	16	1900		96.5	1400	550						90		80	
U	P387	24	B500B	10	1780		26.4	150	400	400	400	400					40	
A	P388	46	B500B	16	3340		242.8	3340										
D	P389	48	B500B	10	1330		39.5	500	380	500							40	

REINFORCING BAR TOTAL WEIGHT [kg] 762.5

REINFORCING BAR LIST

CAST UNIT CODE: P41 | PCS: 1

REINFORCING BARS TYPE	POS	PCS	GRADE	D [mm]	L [mm]	dL [mm]	WEIGHT SUM [kg]	BENDING DIMENSIONS [mm] a	b	c	d	e	u	v	x	TD	COMMENT
B	P411	16	B500B	16	1850		47.0	1400	500						90		80	
A	P412	20	B500B	16	2590		81.8	2590										
U	P413	12	B500B	10	1780		13.2	150	400	400	400	400					40	
D	P414	54	B500B	10	1330		19.7	500	380	500							40	
A	P415	36	B500B	16	2220		126.3	2220										
A	P416	4	B500B	16	1360		8.6	1360										
D	P417	4	B500B	16	3510		22.2	509	2572	509							80	
D	P418	16	B500B	12	1170		16.7	500	235	500							60	
D	P419	28	B500B	12	1210		30.2	500	275	500							60	

REINFORCING BAR TOTAL WEIGHT [kg] 365.8

REINFORCING BAR LIST

CAST UNIT CODE: P43 | PCS: 1

REINFORCING BARS TYPE	POS	PCS	GRADE	D [mm]	L [mm]	dL [mm]	WEIGHT SUM [kg]	BENDING DIMENSIONS [mm] a	b	c	d	e	u	v	x	TD	COMMENT
A	P431	80	B500B	16	2840		359.0	2840									
A	P432	4	B500B	16	2860		18.1	2860										
D	P433	4	B500B	16	3760		23.8	509	2822	509							80	
D	P434	30	B500B	12	1210		32.4	500	275	500							60	
B	P435	32	B500B	16	1900		96.5	1400	550						90		80	
U	P436	24	B500B	10	1780		26.4	150	400	400	400	400					40	
D	P437	30	B500B	12	1170		31.3	500	235	500							60	
D	P438	48	B500B	10	1330		39.5	500	380	500							40	

REINFORCING BAR TOTAL WEIGHT [kg] 627.0

REINFORCEMENT BENDING SHAPES:



LEGEND:

R.L - REDUCED LEVEL
T.O.C. - TOP OF CONCRETE
B.O.F. - BOTTOM OF FOUNDATION
F.G.L. - FINISHED GROUND LEVEL
P.C.C. - PLAIN CEMENT CONCRETE
TYP - TYPICAL
MKD - MARKED
CL - CENTER LINE
BOTTOM REINF. (B)
TOP REINF. (T)
SBC - SAFE BEARING CAPACITY
MIN. - MINIMUM
REF. - REFERED
GA - GENERAL ARRANGEMENT
DWG. - DRAWING
R.C.C. - REINFORCED CEMENT CONCRETE

NOTES:

1. ALL DIMENSIONS ARE IN MILLIMETRES AND LEVELS ARE IN METRES UNLESS OTHERWISE STATED
2. GRADE OF CONCRETE SHALL BE C35 (35MPa) UNLESS NOTED OTHERWISE & C15 (15MPa) FOR BLINDING CONCRETE.
3. GRADE OF REINFORCEMENT SHALL BE DEFORMED BAR ASTM A615-GRADE 60 (fy=420MPa)
4. CLEAR COVER TO MAIN REINFORCEMENT SHALL BE AS FOLLOWS:
a) FOUNDATION: 75 mm (BOTTOM & SIDE)
b) FOUNDATION: 50 mm (TOP)
c) COLUMN & PEDESTAL: 50 mm
5. MINIMUM LAP LENGTHS OF REINFORCEMENT SHALL BE 40XBAR DIAMETER
6. FOR STANDARD REINFORCEMENT DETAILS & GENERAL NOTES FOR CIVIL WORKS REFER TO DRAWING NUMBER MD-216-1000-EG-CV-DED-1005 & 1001
7. ANCHOR BOLTS AND EMBEDDED STEELWORK SHALL BE HOT DIP GALVANIZED
8. T.O.C. & TOP OF SCREED TOLERANCE SHALL BE WITHIN +/- 10MM OF DESIGN LEVEL
9. NET SAFE BEARING CAPACITY OF SOIL AT BOTTOM OF FOUNDATION IS CONSIDERED AS 375 KN/SQ.M.
10. REBARS CAN BE MOVED LOCALLY BY +/- 25mm TO AVOID INTERFERENCE WITH EMBEDDED PARTS

DOCUMENT NUMBER	REFERENCE DOCUMENTS
MD-216-49W1-EG-CV-DED-1019	PIPERACK FOUNDATION 2
MD-216-49W1-EG-CV-DED-1017	EQUIPMENT FOUNDATION PUMPS 1
MD-216-49W1-EG-CV-DED-1004	SAND FILTER BOTTOM SLAB REINFORCEMENT DRAWING
MD-216-49W1-EG-CV-GAD-1003	1-10/A-E GENERAL ARRANGEMENT DRAWING
MD-216-49W1-EG-CV-GAD-1001	1-8/E-J GENERAL ARRANGEMENT DRAWING

DOCUMENT NUMBER	REFERENCE DOCUMENTS
MD-216-49W1-EG-CV-DED-1018	EQUIPMENT FOUNDATION PUMPS 2
MD-216-49W1-EG-CV-CAL-1002	SAND FILTER AND DISTRIBUTION BOX CALCULATION REPORT
MD-216-49W1-EG-CV-DED-1003	SAND FILTER AND DISTRIBUTION BOX DIMENSIONAL DRAWING
MD-216-49W1-EG-CV-GAD-1002	7-12/D-J GENERAL ARRANGEMENT DRAWING

REV	DATE	REVISION DESCRIPTION	DRN	CHK	ENG	APP	EMP
D01	29.01.2024	AS-BUILT	JoriRen	MauNot	NamWu	LuiPiz	
C03	23.12.2021	P38 & P41 FOUNDATIONS UPDATED	JoriRen	MauNot	NamWu	LuiPiz	
C02	23.12.2021	COVER THICKNESS CHANGED: P44 & P41 UPDATED	JoriRen	MauNot	NamWu	LuiPiz	
C01	08.12.2021	ISSUED FOR CONSTRUCTION, REVISED AS PER COMMENTS	AbdDus	MauNot	LuiPiz	SouCha	
A01	23.11.2021	ISUED FOR APPROVAL	AbdDus	MauNot	LuiPiz	SouCha	

RESERVED FOR VENDOR LOGO AND DRAWING NUMBER

LARSEN & TOUBRO

This drawing is the property of LARSEN & TOUBRO and must not be passed on to any person or body not authorized by us to receive it or be copied or otherwise made use either in full or in part by such person or body without our prior permission in writing.

Outotec

The content of these documents are the sole property of Outotec Oyj. Any rights not expressly granted herein are reserved. Reproduction, transfer or distribution of part or all of the contents in any form without prior written permission of Outotec is prohibited.

MA'ADEN معادن
Saudi Arabian Mining Company شركة معادن السعودية

This document and the information contained herein is MA'aden proprietary know-how. This document or any part thereof should not be reproduced, stored in a retrieval system or transmitted by any means, electronic or otherwise, or divulged without prior written permission of Ma'aden.

LARSEN & TOUBRO DRAWING NUMBER: 019045_080_C_D_24892_016 | REVISION: 4
OUTOTEC DRAWING NUMBER: 900707_GAU01_AG11_CTB01_49016 | DOCUMENT ID: OU100734422 | REVISION: 4

DRAWN	AbdDus	23.11.2021
CHECKED	MauNot	23.11.2021
ENGINEER	NamWu	23.11.2021
APPROVED	LuiPiz	23.11.2021
EMPLOYER		
SCALE	1:30	A0

MANSOURAH - MASSARAH GOLD PROJECT
49W1 RAW WATER TREATMENT PLANT
PIPERACK FOUNDATION 1
DETAIL AND REINFORCEMENT DRAWING

DRAWING NUMBER: MD-216-49W1-EG-CV-DED-1016 | REV: D01