


DRAWING NUMBER: MD-216-4000-EG-CV-DED-1076
REV: D01

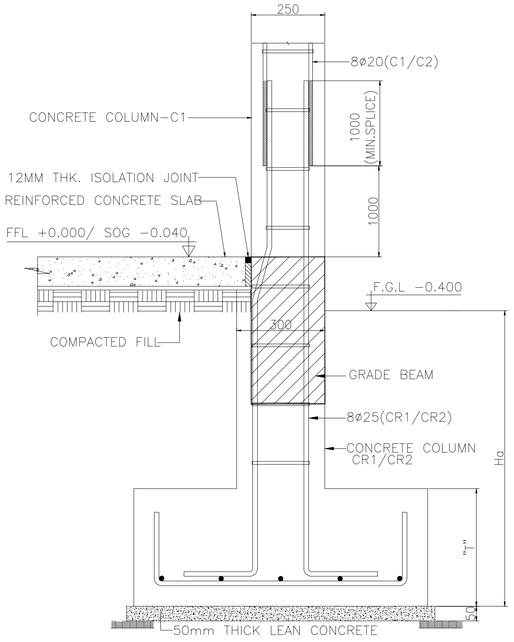


FOUNDATION SECTION
NTS

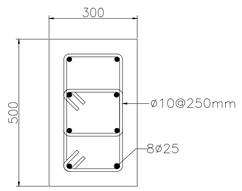


COLUMN DETAIL CR1 (GAD-1074)
(TILL NECK) SCALE 1:10

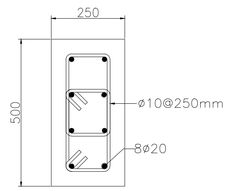


COLUMN DETAIL C1 (GAD-1074)
SCALE 1:10

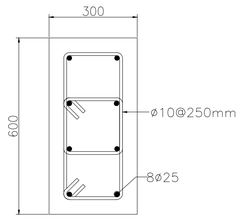

COLUMN DETAIL CR2 (GAD-1074)
(TILL NECK) SCALE 1:10

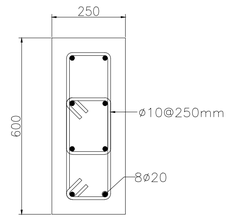

COLUMN DETAIL C2 (GAD-1074)
SCALE 1:10

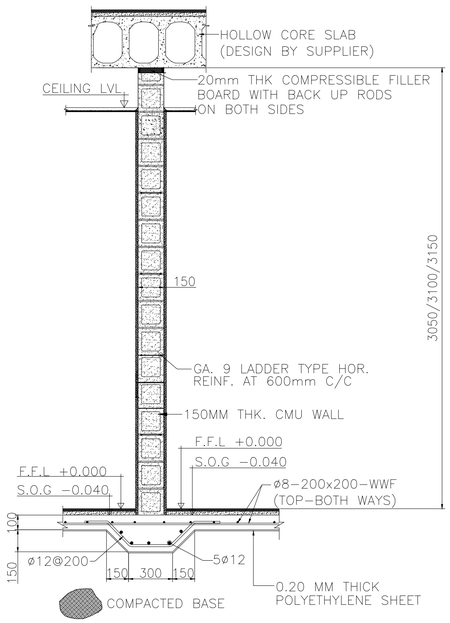


TYPICAL INTERNAL WALL DETAIL W (GAD-1075)
SCALE 1:10

SCHEDULE OF FOOTINGS


FOOTING MARK	PLAIN CONCRETE			REINFORCED CONCRETE			BOTTOM REINFORCEMENT		TOP REINFORCEMENT		Ha	REMARKS
	L	W	T	L	W	T	SHORT BARS	LONG BARS	SHORT BARS	LONG BARS		
F1	1800	1800	50	1600	1600	400	ø12@150	ø12@150	–	–	1200	
F2	1700	1700	50	1500	1500	400	ø12@150	ø12@150	–	–	1200	
F3	1600	1600	50	1400	1400	400	ø12@150	ø12@150	–	–	1200	
F4	1500	1500	50	1300	1300	400	ø12@150	ø12@150	–	–	1200	
F5	1300	1300	50	1100	1100	400	ø12@150	ø12@150	–	–	1200	

SCHEDULE OF GRADE BEAMS


BEAM MARK	DIMENSIONS		STEEL REINFORCEMENT				STIRRUPS
			BOTTOM		TOP		
	WIDTH	DEPTH	STRAIGHT	ADD.	STRAIGHT	ADD.	
GB1	250	500	3ø16	–	3ø16	–	PROVIDE ø10@250 AT MID SPAN & ø10@200@END SPAN

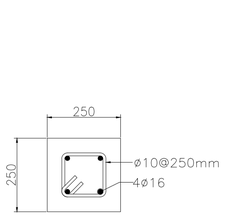

COLUMN DETAIL CR3 (GAD-1074)
(TILL NECK) SCALE 1:10

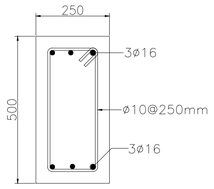


GRADE BEAM@MIDSPAN GB1 (GAD-1074)
SCALE 1:10

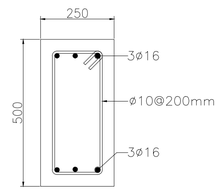

GRADE BEAM@ENDSPAN GB1 (GAD-1074)
SCALE 1:10

MASTER KEY PLAN

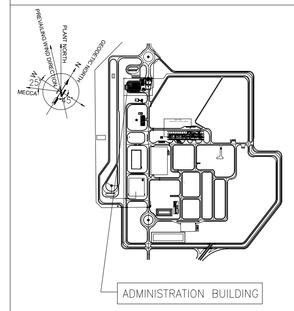

NOTES

1.) ALL DIMENSIONS ARE GIVEN IN MILLIMETRES AND ELEVATIONS ARE IN METRES UNLESS OTHERWISE NOTED.
2.) MINIMUM REINFORCED CONCRETE GRADE TO BE USED FOR SUPERSTRUCTURE & SUBSTRUCTURES IS M35(5000 PSI).
3.) MINIMUM LEAN CONCRETE GRADE TO BE USED FOR THE SUB-STRUCTURES IS M15(2175 PSI).
4.) ALL REINFORCING STEEL SHALL BE DEFORMED BILLET STEEL BARS CONFORMING TO ASTM-A615, WITH MINIMUM YIELD STRENGTHOF FY420 MPA .
5.) THE NET SOIL BEARING CAPACITY CONSIDERED IN FOUNDATION DESIGN IS 570 KPA(REFER DOC 216-3000-EG-)CV-CAL-1008-A02
6.) WATER PROOFING INSULATION SHALL BE AS PER PROJECT SPECIFICATIONS & ITS MATERIAL TO BE APPROVED BY ENGINEER@SITE.
7.) MINIMUM CONCRETE COVER AS PER SBC-304-2018(TABLE 20.6.1.3.1) MEASURED FROM REBAR SHALL BE
   a) CONCRETE CAST AGAINST & PERMANENTLY EXPOSED TO EARTH (INCLUDING FOUNDATIONS OVER SUB-SLAB) FORMED CONCRETE EXPOSED TO EARTH OR WEATHER.....50MM
   b.) CONCRETE NOT EXPOSED TO WEATHER NOR IN CONTACT WITH GROUND
   BEAMS, COLUMNS.....40MM
   SLABS, WALLS, JOISTS.....20MM
   c.) CONCRETE SLAB OVER 50MM SUB-SLAB.....20MM
8.) ALL DRAWINGS MUST BE READ IN CONJUNCTION WITH RELEVANT ARCHITECTURAL AND ENGINEERING DRAWINGS RELATED TO THE SAME SHEET AND ANY ITEM ON IT.
9.) F.F.L +0.00 MENTIONED IS EQUIVALENT TO RL 915.900 AS PER THE CIVIL DRAWING MD-216-1000-EG-ME-PPD-1002.

LEGENDS
F-FOUNDATION
CR-COLUMN NECK
C-COLUMN
FFL-FINISH FLOOR LVL
FGL-FINISH GRADE LVL
TOS-TOP OF SCREED
WWF-WELDED WIRE FABRIC
HCS-HOLLOW CORE SLAB
GB-GRADE BEAM
IJ-ISOLATION JOINT
CJ-CONTROL JOINT
GA-GALVANIZED
S.O.G-SLAB ON GRADE
ARCH-ARCHITECTURAL
HOR.-HORIZONTAL
REINF.-REINFORCEMENT
LVL.-LEVEL
RL.-REDUCED LEVEL

DOCUMENT NUMBER	REFERENCE DOCUMENTS	REV	DATE	REVISION DESCRIPTION	DRN	CHK	ENG	APP	EMP
		D01	22/02/2023	AS-BUILT	--	AVG	--	SJM	
MD-216-6000-EG-CV-STD-1002	HOLLOW CORE SLAB STANDARD	C01	12/05/2020	ISSUED FOR CONSTRUCTION	--	AVG	--	SJM	
MD-216-6000-EG-CV-STD-1001	REINFORCEMENT STANDARD	A02	10/04/2020	REVISED AS PER PMC COMMENTS DATED 26/03/2020	--	AVG	--	SJM	
MD-216-4000-EG-AR-GAD-1075	BUILDING PLANS	A01	26/02/2020	ISSUED FOR APPROVAL	--	AVG	--	SJM	

DESIGNER: مكتب الخليج للاستشارات الهندسية – الغير المملكة العربية السعودية — GULF CONSULT ARCHITECTS AND ENGINEERS

DRAWING NUMBER					REVISION
NON-ADMIN-ST-003					1
DATE	04/04/2020	DATE	07/04/2020	DATE	08/04/2020
DRAWN	MAH	CHECKED	MF	APPROVED	FK

LARSEN & TOUBRO DRAWING NUMBER: O19045_900_C_D_24036_001 — REVISION: 3
OUTOTEC DRAWING NUMBER: 900707 _GAU01 _AN03_MTL01_ 60058 — DOCUMENT ID: OU100665651 — REVISION: 3

LARSEN & TOUBRO
This drawing is the property of LARSEN & TOUBRO and must not be passed on to any person or body not authorized by us to receive it nor be copied or otherwise made use either in full or in part by such person or body without our prior permission in writing.

Outotec
The content of these documents are the sole property of Outotec Oyj. Any rights not expressly granted herein are reserved. Reproduction, transfer or distribution of part or all of the contents in any form without prior written permission of Outotec is prohibited.

MA'ADEN معادن
Saudi Arabian Mining Company شركة المعادن العربية السعودية
This document and the information contained herein is Ma'aden proprietary know-how. This document or any part thereof should not be reproduced, stored in a retrieval system or transmitted by any means, electronic or otherwise, or divulged without prior written permission of Ma'aden.

DRAWN	--	--	MANSOURAH - MASSARAH GOLD PROJECT
CHECKED	AVG	09/04/2020	DETAIL DRAWING
ENGINEER	--	--	PROCESS AREA-ADMINISTRATION BUILDING
APPROVED	SJM	10/04/2020	DETAIL OF FDN, COL & GRADE BEAM
EMPLOYER			
SCALE	1:50	A1	

DRAWING NUMBER: MD-216-4000-EG-CV-DED-1076 — REV: D01