


DRAWING NUMBER	REV
MD-216-4000-EG-CV-DED-1077	D01

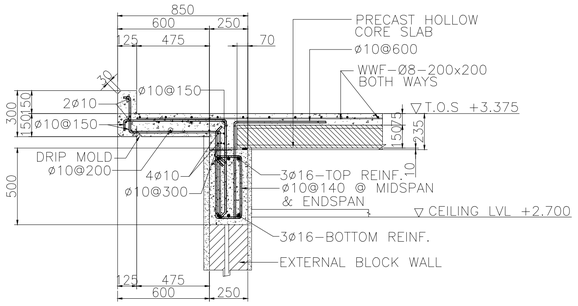


TYPICAL SECTION FOR LEDGER BEAM(LB1) X
SCALE 1:20 GAD-1075

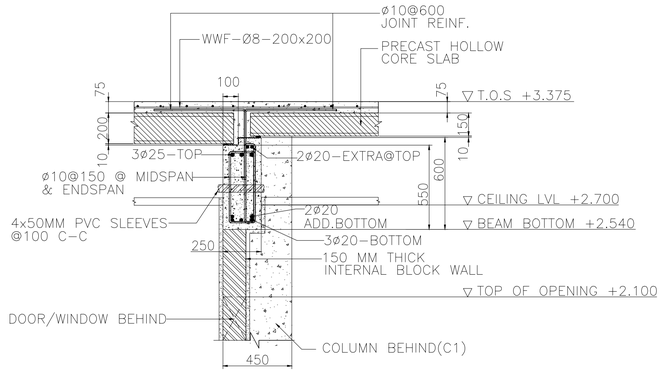


TYPICAL SECTION FOR LEDGER BEAM(LB2) Y
SCALE 1:20 GAD-1075

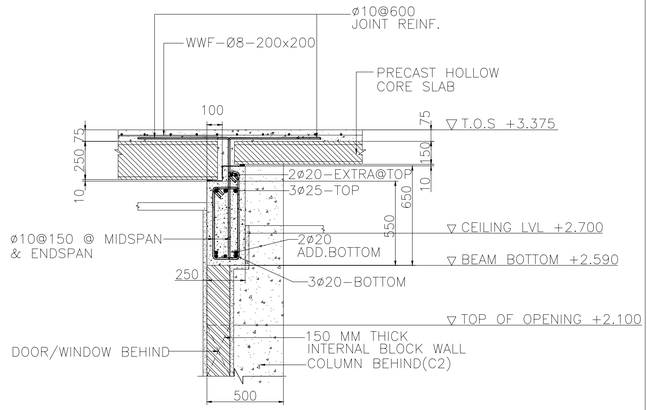


TYPICAL SECTION FOR LEDGER BEAM(LB3) Z
SCALE 1:20 GAD-1075

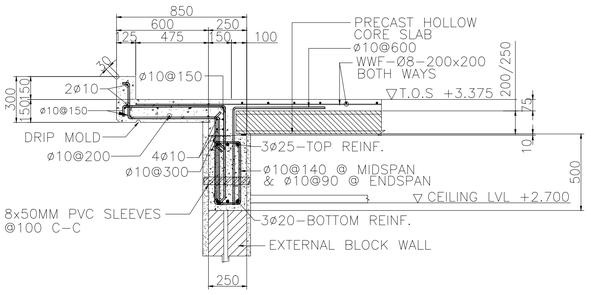


TYPICAL SECTION FOR LEDGER BEAM(LB4) M
SCALE 1:20 GAD-1075

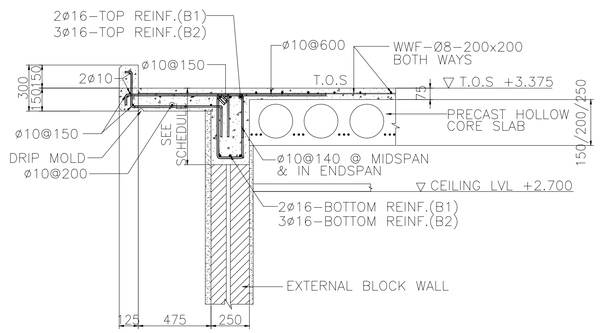


TYPICAL DETAIL FOR DROP BEAM(B1 & B2) N
SCALE 1:20 GAD-1075

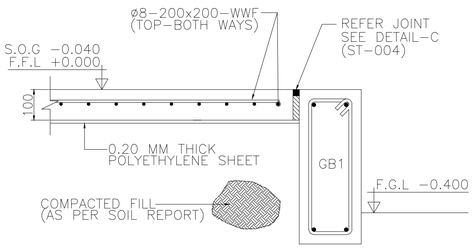


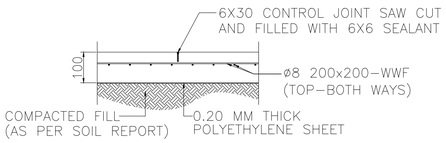

TYP CONTROL JOINT(CJ) DETAIL B
SCALE 1:10 GAD-1075

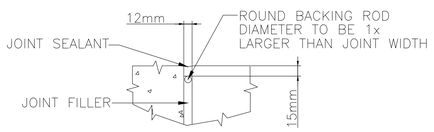

TYP JOINT SEAL DETAIL-C
NTS

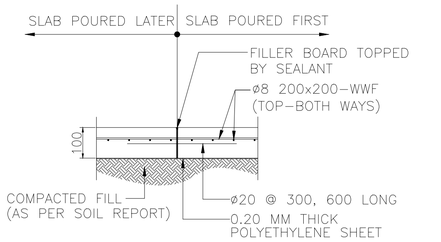


TYP CONSTRUCTION JOINT(SCJ) DETAIL D
SCALE 1:10 GAD-1075

NOTE: ABOVE DETAILS TO BE FOLLOWED IF SCJ LOCATION IS ADJUSTED ON SITE AS PER CONCRETE POUR.

SCHEDULE OF ROOF BEAMS

BEAM MARK	DIMENSIONS		STEEL REINFORCEMENT				STIRRUPS	REMARKS
			TOP		BOTTOM			
	WIDTH	DEPTH	STRAIGHT	ADD.	STRAIGHT	ADD.		
LB1	250	500	3ø16	–	3ø16	–	PROVIDE ø10@140 BOTH IN THE ENDSPAN & MIDSPAN	REFER DETAIL-X
LB2	250	550/600	3ø25+2ø20	–	3ø20	2ø20	PROVIDE ø10@150 BOTH IN THE ENDSPAN & MIDSPAN	REFER DETAIL-Y
LB3	250	550/650	3ø25+2ø20	–	3ø20	2ø20	PROVIDE ø10@150 BOTH IN THE ENDSPAN & MIDSPAN	REFER DETAIL-Z
LB4	250	500	3ø25	–	3ø20	–	PROVIDE ø10@90 AT THE @DISTANCE OF L/3 FROM THE SUPPORT IN END SPAN & ø10@140 IN THE MID SPAN	REFER DETAIL-M
B1	250	400	2ø16	–	2ø16	–	PROVIDE ø10@140 BOTH IN THE ENDSPAN & MIDSPAN	REFER DETAIL-N
B2	250	500	3ø16	–	3ø16	–	PROVIDE ø10@140 BOTH IN THE ENDSPAN & MIDSPAN	REFER DETAIL-N

MASTER KEY PLAN

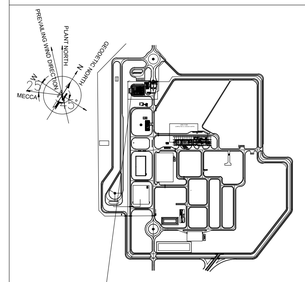

NOTES

1.) ALL DIMENSIONS ARE GIVEN IN MILLIMETRES AND ELEVATIONS ARE IN METRES UNLESS OTHERWISE NOTED.
2.) MINIMUM REINFORCED CONCRETE GRADE TO BE USED FOR SUPERSTRUCTURE & SUBSTRUCTURES IS M35(5000 PSI).
3.) MINIMUM LEAN CONCRETE GRADE TO BE USED FOR THE SUB-STRUCTURES IS M15(2175 PSI).
4.) ALL REINFORCING STEEL SHALL BE DEFORMED BILLET STEEL BARS CONFORMING TO ASTM-A615, WITH MINIMUM YIELD STRENGTHOF FY420 MPA .
5.) THE NET SOIL BEARING CAPACITY CONSIDERED IN FOUNDATION DESIGN IS 570 KPA(REFER DOC 216-3000-EG-CV-CAL-1008-A02
6.) WATER PROOFING INSULATION SHALL BE AS PER PROJECT SPECIFICATIONS & ITS MATERIAL TO BE APPROVED BY ENGINEER@SITE.
7.) MINIMUM CONCRETE COVER AS PER SBC-304-2018(TABLE 20.6.1.3.1) MEASURED FROM REBAR SHALL BE
   a) CONCRETE CAST AGAINST & PERMANENTLY EXPOSED TO EARTH (INCLUDING FOUNDATIONS OVER SUB-SLAB) FORMED CONCRETE EXPOSED TO EARTH OR WEATHER.....50MM
   b.) CONCRETE NOT EXPOSED TO WEATHER NOR IN CONTACT WITH GROUND
   BEAMS, COLUMNS.....40MM
   SLABS, WALLS, JOISTS.....20MM
   c.) CONCRETE SLAB OVER 50MM SUB-SLAB.....20MM
8.) ALL DRAWINGS MUST BE READ IN CONJUNCTION WITH RELEVANT ARCHITECTURAL AND ENGINEERING DRAWINGS RELATED TO THE SAME SHEET AND ANY ITEM ON IT.
9.) F.F.L +0.00 MENTIONED IS EQUIVALENT TO RL 915.900 AS PER THE CIVIL DRAWING MD-216-1000-EG-ME-PPD-1002.

LEGENDS
F-FOUNDATION
CR-COLUMN NECK
C-COLUMN
FFL-FINISH FLOOR LVL
FGL-FINISH GRADE LVL
TOS-TOP OF SCREED
WWF-WELDED WIRE FABRIC
HCS-HOLLOW CORE SLAB
GB-GRADE BEAM
I.J-ISOLATION JOINT
CJ-CONTROL JOINT
GA-GALVANIZED
S.O.G-SLAB ON GRADE
SCJ-SLAB CONSTRUCTION JOINT
HOR.-HORIZONTAL
REINF.-REINFORCEMENT
LVL.-LEVEL
RL.-REDUCED LEVEL

DOCUMENT NUMBER	REFERENCE DOCUMENTS	REV	DATE	REVISION DESCRIPTION	DRN	CHK	ENG	APP	EMP
MD-216-6000-EG-CV-STD-1002	HOLLOW CORE SLAB STANDARD	D01	22/02/2023	AS-BUILT	--	AVG	--	SJM	
MD-216-6000-EG-CV-STD-1001	REINFORCEMENT STANDARD	C01	10/04/2020	ISSUED FOR CONSTRUCTION	--	AVG	--	SJM	
MD-216-4000-EG-AR-GAD-1075	BUILDING PLANS	A01	26/02/2020	ISSUED FOR APPROVAL	--	AVG	--	SJM	

DESIGNER: مكتب الخليج للاستشارات الهندسية الغير، المملكة العربية السعودية GULF CONSULT ARCHITECTS AND ENGINEERS

DRAWING NUMBER					REVISION
NON-ADMIN-ST-004					0
DATE	22/02/2020	DATE	23/02/2020	DATE	24/02/2020
DRAWN	MAH	CHECKED	MF	APPROVED	FK

LARSEN & TOUBRO DRAWING NUMBER: 019045_900_C_D_24036_002 — REVISION 2
OUTOTEC DRAWING NUMBER: 900707__GAU01__AN03__CTB17__40001 — DOCUMENT ID: 0U100670822 — REVISION 2

DRAWN	--	--
CHECKED	AVG	25/02/2020
ENGINEER	--	--
APPROVED	SJM	26/02/2020
EMPLOYER		
SCALE	1:50	A1

MANSOURAH - MASSARAH GOLD PROJECT
DETAIL DRAWING
PROCESS AREA-ADMINISTRATION BUILDING
DETAIL OF ROOF & GRADE SLAB

DRAWING NUMBER: MD-216-4000-EG-CV-DED-1077 — REV: D01

LARSEN & TOUBRO
This drawing is the property of LARSEN & TOUBRO and must not be passed on to any person or body not authorized by us to receive it nor be copied or otherwise made use either in full or in part by such person or body without our prior permission in writing.

Outotec
The content of these documents are the sole property of Outotec Oyj. Any rights not expressly granted herein are reserved. Reproduction, transfer or distribution of part or all of the contents in any form without prior written permission of Outotec is prohibited.

MA'ADEN معادن
Saudi Arabian Mining Company شركة التعدين العربية السعودية
This document and the information contained herein is Ma'aden proprietary know-how. This document or any part thereof should not be reproduced, stored in a retrieval system or transmitted by any means, electronic or otherwise, or divulged without prior written permission of Ma'aden.