
DRAWING NUMBER: MD-216-4000-EG-CV-DED-1079
REV: D01

SCHEDULE OF FOOTINGS


FOOTING MARK	PLAIN CONCRETE			REINFORCED CONCRETE			BOTTOM REINFORCEMENT		TOP REINFORCEMENT		Ha	REMARKS
	L	W	T	L	W	T	SHORT BARS	LONG BARS	SHORT BARS	LONG BARS		
F1	2200	2200	100	2000	2000	400	ø12@150	ø12@150	–	–	1200	
F2	2400	2400	100	2200	2200	400	ø12@150	ø12@150	–	–	1200	
F3	2400	2400	100	2200	2200	450	ø12@125	ø12@125	–	–	1200	

SCHEDULE OF GRADE BEAMS


BEAM MARK	DIMENSIONS		STEEL REINFORCEMENT				STIRRUPS
			BOTTOM		TOP		
	WIDTH	DEPTH	STRAIGHT	ADD.	STRAIGHT	ADD.	
GB1	250	500	3ø16	–	3ø16	–	PROVIDE ø10@150 AT END SPAN@DISTANCE OF L/3 FROM THE SUPPORT & ø10@200 AT MIDSPAN

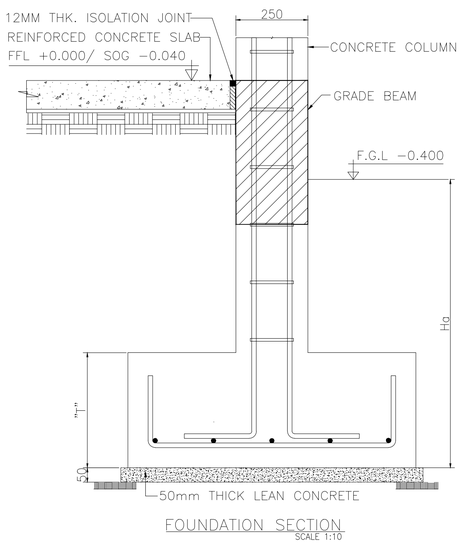


FOUNDATION SECTION
SCALE 1:10

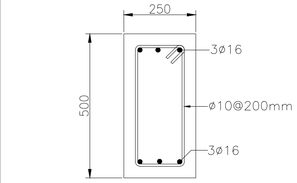


GRADE BEAM@MIDSPAN GB1 (GAD-1078)
SCALE 1:10

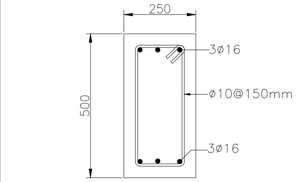


GRADE BEAM@ENDSPAN GB1 (GAD-1078)
SCALE 1:10

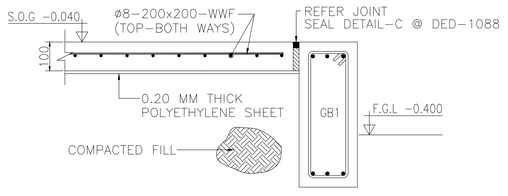


TYP SECTION FOR GRADE SLAB A (GAD-1078)
SCALE 1:10

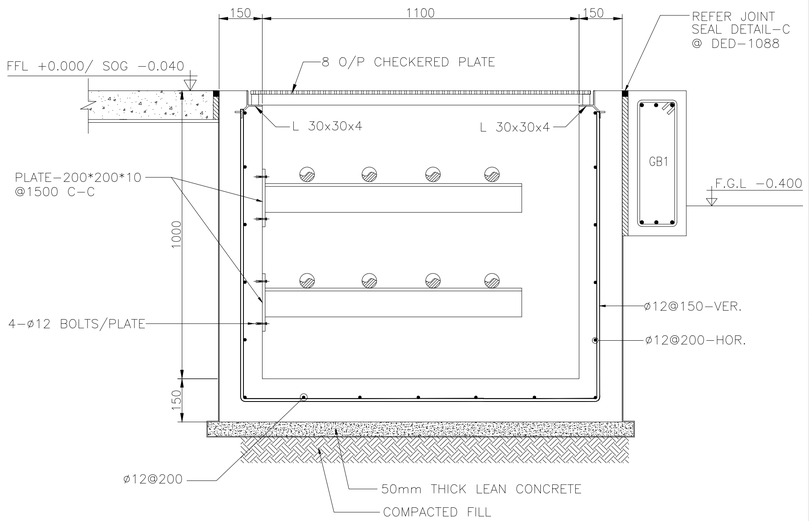

TYP. TRENCH SECTION H (GAD-1087)
SCALE 1:10

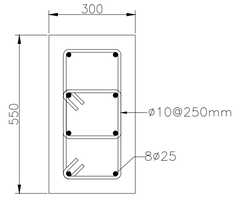

COLUMN DETAIL CR (GAD-1078)
SCALE 1:10

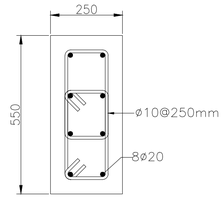

COLUMN DETAIL C1 (GAD-1078)
SCALE 1:10

NOTES

1.) ALL DIMENSIONS ARE GIVEN IN MILLIMETRES AND ELEVATIONS ARE IN METRES UNLESS OTHERWISE NOTED.
2.) MINIMUM REINFORCED CONCRETE GRADE TO BE USED FOR SUPERSTRUCTURE & SUBSTRUCTURES IS C35(5000 PSI).
3.) MINIMUM LEAN CONCRETE GRADE TO BE USED FOR THE SUB-STRUCTURES IS C15(2175 PSI).
4.) ALL REINFORCING STEEL SHALL BE DEFORMED BILLET STEEL BARS CONFORMING TO ASTM-A615, WITH MINIMUM YIELD STRENGTH OF FY420 MPA .
5.) THE NET SOIL BEARING CAPACITY CONSIDERED IN FOUNDATION DESIGN IS 570 KPA(REFER DOC 216-3000-EG-CV-RPT-1008)
6.) WATER PROOFING INSULATION SHALL BE AS PER PROJECT SPECIFICATIONS & ITS MATERIAL TO BE APPROVED BY SITE ENGINEER.
7.) MINIMUM CONCRETE COVER AS PER SBC-304-2018(TABLE 20.6.1.3.1) MEASURED FROM REBAR SHALL BE
   a) CONCRETE CAST AGAINST & PERMANENTLY EXPOSED TO EARTH (INCLUDING FOUNDATIONS OVER SUB-SLAB) FORMED CONCRETE EXPOSED TO EARTH OR WEATHER.....50MM
   b.) CONCRETE NOT EXPOSED TO WEATHER NOR IN CONTACT WITH GROUND
   BEAMS, COLUMNS.....40MM
   SLABS, WALLS, JOISTS.....20MM
   c.) CONCRETE SLAB OVER 50MM SUB-SLAB.....20MM
8.) ALL DRAWINGS MUST BE READ IN CONJUNCTION WITH RELEVANT ARCHITECTURAL AND ENGINEERING DRAWINGS RELATED TO THE SAME SHEET AND ANY ITEM ON IT.
9.) F.F.L +0.00 MENTIONED IS EQUIVALENT TO RL 913.400

LEGENDS
F/FDN.-FOUNDATION
CR-COLUMN NECK
C/COL.-COLUMN
FFL-FINISH FLOOR LVL
FGL-FINISH GROUND LVL
VER-VERTICAL
WWF-WELDED WIRE FABRIC
HCS-HOLLOW CORE SLAB
GB-GRADE BEAM
IJ-ISOLATION JOINT
CJ-CONTROL JOINT
BW's-BOTH WAYS
S.O.G-SLAB ON GRADE
TYP-TYPICAL
HOR.-HORIZONTAL
REINF.-REINFORCEMENT
LVL.-LEVEL
RL.-REDUCED LEVEL
P.-PEDESTAL
℄ - CENTRE LINE OF COLUMN

DOCUMENT NUMBER	REFERENCE DOCUMENTS	REV	DATE	REVISION DESCRIPTION	DRN	CHK	ENG	APP	EMP
MD-216-4000-EG-AR-GAD-3040	BUILDING ELEVATIONS & SECTIONS	D01	24/05/2023	AS-BUILT	--	AVG	--	SJM	
MD-216-4000-EG-AR-GAD-3039	BUILDING PLANS	C01	06/07/2020	ISSUED FOR CONSTRUCTION	--	AVG	--	SJM	
MD-216-6000-EG-CV-GAD-1535	OVERALL LAYOUT PLAN	A01	10/06/2020	ISSUED FOR APPROVAL	--	AVG	--	SJM	

DESIGNER: مكتب الخليج للاستشارات الهندسية – الخبر، المملكة العربية السعودية
GULF CONSULT ARCHITECTS AND ENGINEERS

DATE	02/06/2020	DATE	03/06/2020	DATE	04/06/2020
DRAWN	MAH	CHECKED	MF	APPROVED	FK

DRAWING NUMBER: ST-NON-ENGINEERING OFFICE-ST-002
REVISION: 0

LARSEN & TOUBRO DRAWING NUMBER: 019045_900_C_D_24039_001
REVISION: 02
OUTOTEC DRAWING NUMBER: 900707__GAU01__AN03__CTB17__40008
DOCUMENT ID: OU100683339
REVISION: 02

LARSEN & TOUBRO
This drawing is the property of LARSEN & TOUBRO and must not be passed on to any person or body not authorized by us to receive it nor be copied or otherwise made use either in full or in part by such person or body without our prior permission in writing.

Outotec
The content of these documents are the sole property of Outotec Oyj. Any rights not expressly granted herein are reserved. Reproduction, transfer or distribution of part or all of the contents in any form without prior written permission of Outotec is prohibited.

MA'ADEN معادن
Saudi Arabian Mining Company شركة التعدين العربية السعودية
This document and the information contained herein is Ma'aden proprietary know-how. This document or any part thereof should not be reproduced, stored in a retrieval system or transmitted by any means, electronic or otherwise, or divulged without prior written permission of Ma'aden.

DRAWN	--	--	MANSOURAH - MASSARAH GOLD PROJECT
CHECKED	AVG	09/06/2020	DETAIL DRAWING
ENGINEER	--	--	PROCESS PLANT-ENGINEERING OFFICE CUM CCR
APPROVED	SJM	10/06/2020	DETAIL OF FDN. COL. & GRADE BEAM
EMPLOYER			
SCALE	1:50	A1	DRAWING NUMBER: MD-216-4000-EG-CV-DED-1079
			REV: D01