


DRAWING NUMBER MD-216-4000-EG-CV-DED-1082 REV D01

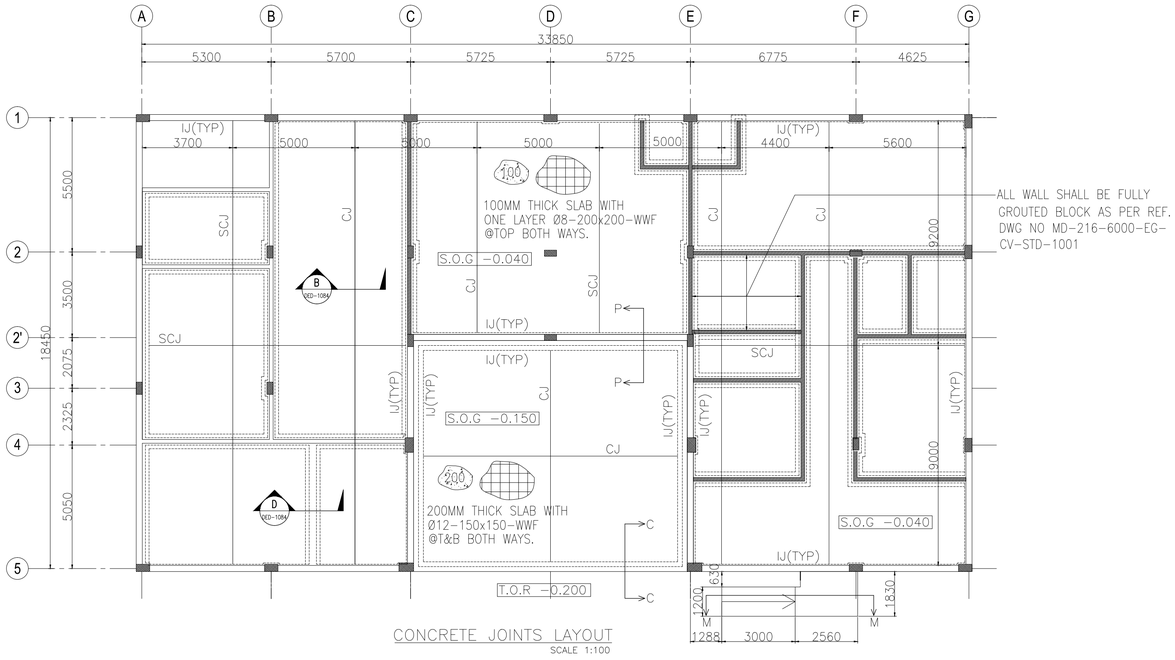


CONCRETE JOINTS LAYOUT
SCALE 1:100

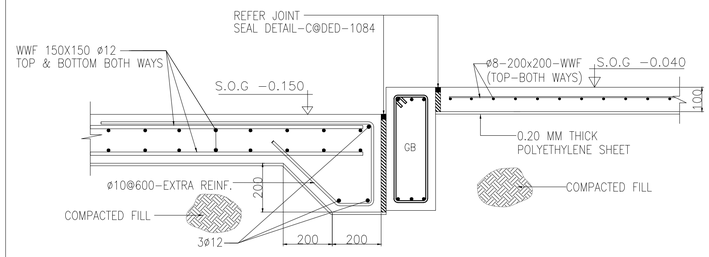

TYP SECTION (P) FOR GRADE SLAB
SCALE 1:10

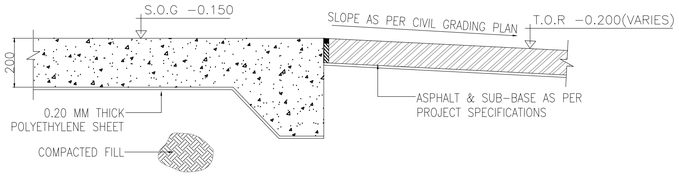


TYP SECTION (C) FOR GRADE SLAB
SCALE 1:10

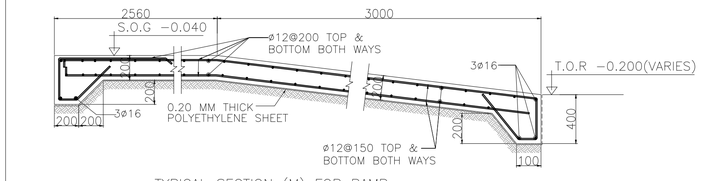


TYPICAL SECTION (M) FOR RAMP
SCALE N.T.S

MASTER KEY PLAN

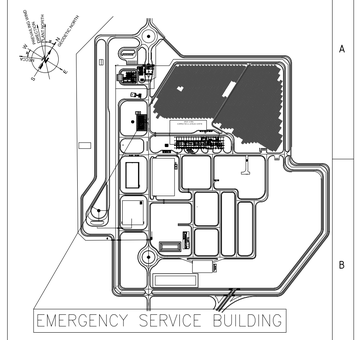


LEGENDS

F/FDN.–FOUNDATION
CR–COLUMN NECK
C/COL.–COLUMN
FFL–FINISH FLOOR LEVEL
FGL–FINISH GROUND LEVEL
TOS–TOP OF SCREED
WWF–WELDED WIRE FABRIC
HCS–HOLLOW CORE SLAB
GB–GRADE BEAM
IJ–ISOLATION JOINT
CJ–CONTROL JOINT
BW's–BOTH WAYS
S.O.G–SLAB ON GRADE
TYP–TYPICAL
HOR.–HORIZONTAL
REINF.–REINFORCEMENT
LVL.–LEVEL
RL.–REDUCED LEVEL
P.–PEDESTAL
℄–CENTRE LINE
T.O.R–TOP OF ROAD
ø–DIAMETER

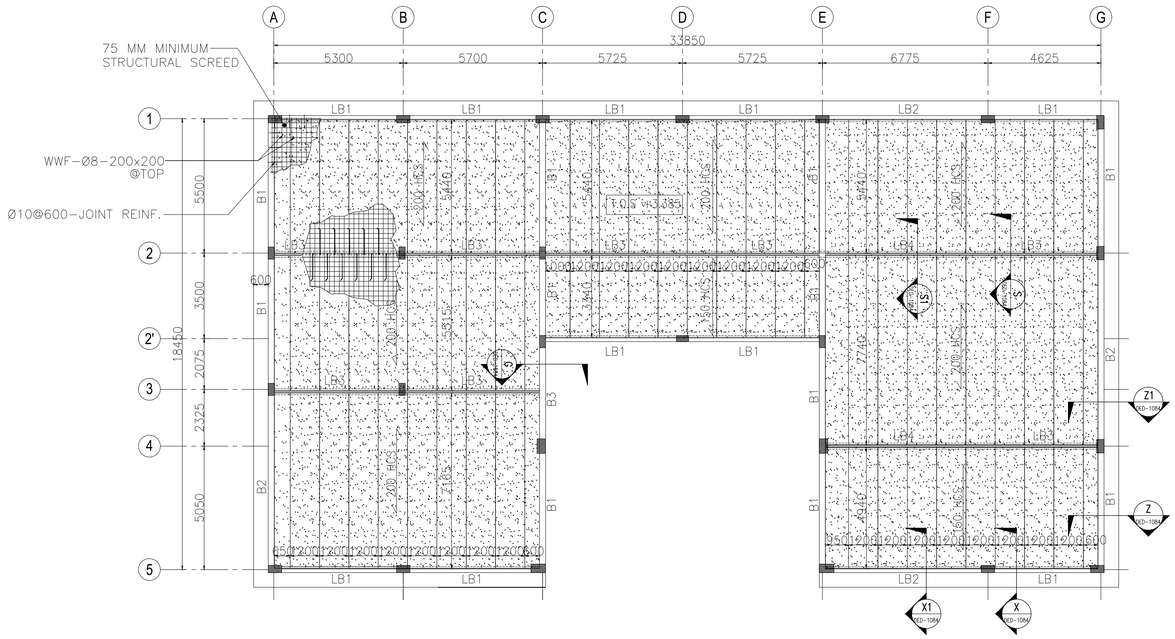

ROOF HOLLOW CORE SLAB LAYOUT AT LVL. +3.385M
SCALE 1:100

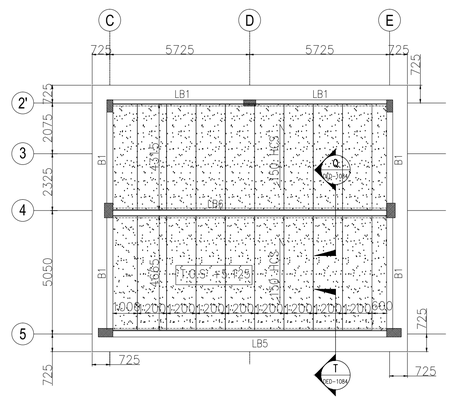

ROOF HOLLOW CORE SLAB LAYOUT AT LVL. +5.125M
SCALE 1:100

NOTES

1 ALL DIMENSIONS ARE GIVEN IN MILLIMETRES AND ELEVATIONS ARE IN METRES UNLESS OTHERWISE NOTED.
2 MINIMUM REINFORCED CONCRETE GRADE TO BE USED FOR SUPERSTRUCTURE & SUBSTRUCTURES IS C35(5000 PSI).
3 MINIMUM LEAN CONCRETE GRADE TO BE USED FOR THE SUB-STRUCTURES IS C15(2175 PSI).
4 ALL REINFORCING STEEL SHALL BE DEFORMED BILLET STEEL BARS CONFORMING TO ASTM-A615, WITH MINIMUM YIELD STRENGTH OF FY420 MPA .
5 THE NET SOIL BEARING CAPACITY CONSIDERED IN FOUNDATION DESIGN IS 570 KPA(REFER DOC 216-3000-EG-CV-RPT-1008)
6 WATER PROOFING INSULATION SHALL BE AS PER PROJECT SPECIFICATIONS & ITS MATERIAL TO BE APPROVED BY SITE ENGINEER.
7 MINIMUM CONCRETE COVER AS PER SBC-304-2018(TABLE 20.6.1.3.1) MEASURED FROM REBAR SHALL BE
   a. CONCRETE CAST AGAINST & PERMANENTLY EXPOSED TO EARTH (INCLUDING FOUNDATIONS OVER SUB-SLAB) FORMED CONCRETE EXPOSED TO EARTH OR WEATHER.....50MM
   b. CONCRETE NOT EXPOSED TO WEATHER NOR IN CONTACT WITH GROUND
      BEAMS, COLUMNS.....40MM
      SLABS, WALLS, JOISTS.....20MM
   c. CONCRETE SLAB OVER 50MM SUB-SLAB.....20MM
8. ALL DRAWINGS MUST BE READ IN CONJUNCTION WITH RELEVANT ARCHITECTURAL AND ENGINEERING DRAWINGS RELATED TO THE SAME SHEET AND ANY ITEM ON IT.
9. F.F.L +0.00 MENTIONED IS EQUIVALENT TO RL 915.200

DOCUMENT NUMBER	REFERENCE DOCUMENTS	REV	DATE	REVISION DESCRIPTION	DRN	CHK	ENG	APP	EMP
MD-216-4000-EG-CV-DED-1084	DETAIL OF ROOF & GRADE SLAB								
MD-216-4000-EG-CV-DED-1083	DETAIL OF FDN. COL. & GRADE BEAM								
MD-216-4000-EG-CV-GAD-1081	LAYOUT OF FDN. COL. & GRADE BEAM	D01	24/05/2023	AS-BUILT	--	AVG	--	SJM	
MD-216-6000-EG-CV-STD-1001	REINFORCEMENT STANDARD	C02	09/11/2020	ISSUED FOR CONSTRUCTION & REVISED AS MARKED C02	--	AVG	--	SJM	
MD-216-4000-EG-AR-GAD-3045	BUILDING ELEVATIONS & SECTIONS	C01	26/07/2020	ISSUED FOR CONSTRUCTION AND REVISED AS PER					
MD-216-4000-EG-AR-GAD-3043	BUILDING PLANS			EMPLOYER COMMENT ON 18/07/2020	--	AVG	--	SJM	
MD-216-6000-EG-CV-STD-1002	HOLLOW CORE SLAB STANDARD	A01	24/06/2020	ISSUED FOR APPROVAL	--	AVG	--	SJM	

DESIGNER: مكتب الخليج للاستشارات الهندسية، المملكة العربية السعودية
GULF CONSULT ARCHITECTS AND ENGINEERS

DRAWING NUMBER						REVISION
EMERGENCY-SERVICE-BUILDING-ST-002						A01
DATE	20/06/2020	DATE	21/06/2020	DATE	22/06/2020	
DRAWN	MAH	CHECKED	MF	APPROVED	FK	

LARSEN & TOUBRO DRAWING NUMBER		REVISION
019045_900_C_D_24042_001		3
OUTOTEC DRAWING NUMBER	DOCUMENT ID	REVISION
900707__GAU01__AN03__CTB17__40004	OU100670826	3

LARSEN & TOUBRO

This drawing is the property of LARSEN & TOUBRO and must not be passed on to any person or body not authorized by us to receive it nor be copied or otherwise made use either in full or in part by such person or body without our prior permission in writing.

Outotec

The content of these documents are the sole property of Outotec Oyj. Any rights not expressly granted herein are reserved. Reproduction, transfer or distribution of part or all of the contents in any form without prior written permission of Outotec is prohibited.

MA'ADEN معادن
Saudi Arabian Mining Company شركة التعدين العربية السعودية

This document and the information contained herein is Ma'aden proprietary know-how. This document or any part thereof should not be reproduced, stored in a retrieval system or transmitted by any means, electronic or otherwise, or divulged without prior written permission of Ma'aden.

DRAWN	-	-	MANSOURAH - MASSARAH GOLD PROJECT
CHECKED	AVG	23/06/2020	DETAIL DRAWING
ENGINEER	-	-	PROCESS PLANT: EMERGENCY SERVICES BUILDING
APPROVED	SJM	24/06/2020	LAYOUT OF ROOF & GRADE SLAB
EMPLOYER			
SCALE	1:125	A1	DRAWING NUMBER: MD-216-4000-EG-CV-DED-1082 REV: D01