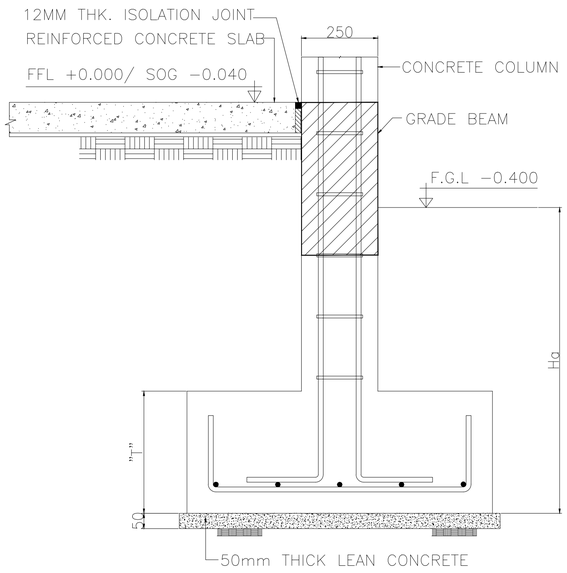
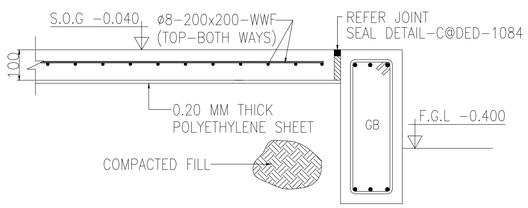
DRAWING NUMBER: MD-216-4000-EG-CV-DED-1083
REV: D01




FOUNDATION SECTION (GAD 1081)
SCALE 1:10





TYP SECTION (A) FOR GRADE SLAB
SCALE 1:10

## SCHEDULE OF FOOTINGS

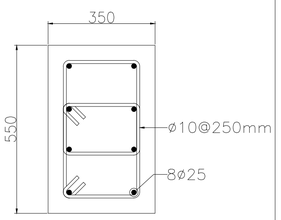
| FOOTING MARK | PLAIN CONCRETE | | | REINFORCED CONCRETE | | | BOTTOM REINFORCEMENT | | TOP REINFORCEMENT | | Ha | REMARKS |
|---|---|---|---|---|---|---|---|---|---|---|---|---|
| | L | W | T | L | W | T | SHORT BARS | LONG BARS | SHORT BARS | LONG BARS | | |
| F1 | 2300 | 2300 | 50 | 2100 | 2100 | 400 | ø12@150 | ø12@150 | – | – | 1200 | |
| F2 | 2000 | 2000 | 50 | 1800 | 1800 | 400 | ø12@150 | ø12@150 | – | – | 1200 | |
| F3 | 2000 | 2000 | 50 | 1800 | 1800 | 450 | ø12@125 | ø12@125 | – | – | 1200 | |
| F4 | 2500 | 2500 | 50 | 2300 | 2300 | 450 | ø12@125 | ø12@125 | – | – | 1200 | |
| F5 | 2400 | 2400 | 50 | 2200 | 2200 | 400 | ø12@150 | ø12@150 | – | – | 1200 | |
| F6 | 2000 | 2000 | 50 | 1800 | 1800 | 400 | ø12@150 | ø12@150 | – | – | 1200 | |

## SCHEDULE OF GRADE BEAMS


| BEAM MARK | DIMENSIONS | | STEEL REINFORCEMENT | | | | STIRRUPS |
|---|---|---|---|---|---|---|---|
| | | | BOTTOM | | TOP | | |
| | WIDTH | DEPTH | STRAIGHT | ADD. | STRAIGHT | ADD. | |
| GB1 | 250 | 500 | 3ø16 | – | 3ø16 | – | PROVIDE ø10@150 AT END SPAN@DISTANCE OF L/3 FROM THE SUPPORT & ø10@200 AT MIDSPAN |
| GB2 | 250 | 500 | 3ø20 | – | 3ø20 | – | |





COLUMN DETAIL CR (GAD 1081)
SCALE 1:10

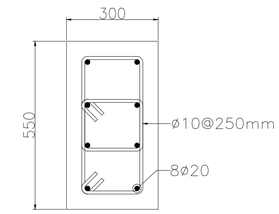



COLUMN DETAIL C1 (GAD 1081)
SCALE 1:10

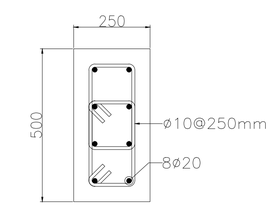



COLUMN DETAIL C2 (GAD 1081)
SCALE 1:10

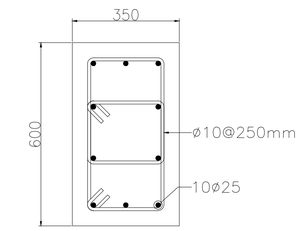



COLUMN DETAIL C3 (GAD 1081)
SCALE 1:10

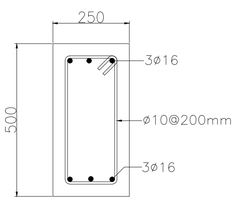

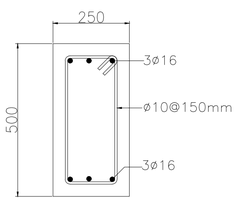

GRADE BEAM AT MIDSPAN GB1 (GAD 1081)
SCALE 1:10



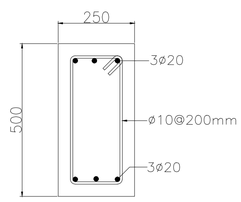
GRADE BEAM AT ENDSPAN GB1 (GAD 1081)
SCALE 1:10



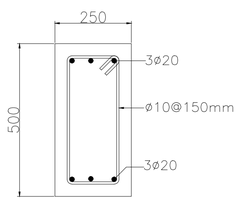
GRADE BEAM AT MIDSPAN GB2 (GAD 1081)
SCALE 1:10




SCALE 1:10

## NOTES

1 ALL DIMENSIONS ARE GIVEN IN MILLIMETRES AND ELEVATIONS ARE IN METRES UNLESS OTHERWISE NOTED.
2 MINIMUM REINFORCED CONCRETE GRADE TO BE USED FOR SUPERSTRUCTURE & SUBSTRUCTURES IS C35(5000 PSI).
3 MINIMUM LEAN CONCRETE GRADE TO BE USED FOR THE SUB-STRUCTURES IS C15(2175 PSI).
4 ALL REINFORCING STEEL SHALL BE DEFORMED BILLET STEEL BARS CONFORMING TO ASTM-A615, WITH MINIMUM YIELD STRENGTH OF FY420 MPA .
5 THE NET SOIL BEARING CAPACITY CONSIDERED IN FOUNDATION DESIGN IS 570 KPA(REFER DOC 216-3000-EG-CV-RPT-1008)
6 WATER PROOFING INSULATION SHALL BE AS PER PROJECT SPECIFICATIONS & ITS MATERIAL TO BE APPROVED BY SITE ENGINEER.
7 MINIMUM CONCRETE COVER AS PER SBC-304-2018(TABLE 20.6.1.3.1) MEASURED FROM REBAR SHALL BE
  a. CONCRETE CAST AGAINST & PERMANENTLY EXPOSED TO EARTH (INCLUDING FOUNDATIONS OVER SUB-SLAB) FORMED CONCRETE EXPOSED TO EARTH OR WEATHER.....50MM
  b. CONCRETE NOT EXPOSED TO WEATHER NOR IN CONTACT WITH GROUND
  BEAMS, COLUMNS.....40MM
  SLABS, WALLS, JOISTS.....20MM
  c. CONCRETE SLAB OVER 50MM SUB-SLAB.....20MM
8. ALL DRAWINGS MUST BE READ IN CONJUNCTION WITH RELEVANT ARCHITECTURAL AND ENGINEERING DRAWINGS RELATED TO THE SAME SHEET AND ANY ITEM ON IT.
9. F.F.L +0.00 MENTIONED IS EQUIVALENT TO RL 915.200

LEGENDS
F/FDN.-FOUNDATION
CR-COLUMN NECK
C/COL.-COLUMN
FFL-FINISH FLOOR LEVEL
FGL-FINISH GROUND LEVEL
THK.-THICK
WWF-WELDED WIRE FABRIC
HCS-HOLLOW CORE SLAB
GB-GRADE BEAM
IJ-ISOLATION JOINT
CJ-CONTROL JOINT
BW'S-BOTH WAYS
S.O.G-SLAB ON GRADE
TYP.-TYPICAL
HOR.-HORIZONTAL
REINF.-REINFORCEMENT
LVL.-LEVEL
RL.-REDUCED LEVEL
P.-PEDESTAL
℄-CENTRE LINE
ø-DIAMETER

| DOCUMENT NUMBER | REFERENCE DOCUMENTS | REV | DATE | REVISION DESCRIPTION | DRN | CHK | ENG | APP | EMP |
|---|---|---|---|---|---|---|---|---|---|
| MD-216-4000-EG-CV-DED-1084 | DETAIL OF ROOF & GRADE SLAB | | | | | | | | |
| MD-216-4000-EG-CV-DED-1082 | LAYOUT OF ROOF & GRADE SLAB | | | | | | | | |
| MD-216-4000-EG-CV-GAD-1081 | LAYOUT OF FDN. COL. & GRADE BEAM | | | | | | | | |
| MD-216-6000-EG-CV-STD-1001 | REINFORCEMENT STANDARD | | | | | | | | |
| MD-216-4000-EG-AR-GAD-3045 | BUILDING ELEVATIONS & SECTIONS | D01 | 24/05/2023 | AS-BUILT | -- | AVG | -- | SJM | |
| MD-216-4000-EG-AR-GAD-3043 | BUILDING PLANS | C01 | 26/07/2020 | ISSUED FOR CONSTRUCTION | -- | AVG | -- | SJM | |
| MD-216-6000-EG-CV-STD-1002 | HOLLOW CORE SLAB STANDARD | A01 | 24/06/2020 | ISSUED FOR APPROVAL | -- | AVG | -- | SJM | |

DESIGNER: مكتب الخليج للاستشارات الهندسية الخبر، المملكة العربية السودية — GULF CONSULT ARCHITECTS AND ENGINEERS

| DRAWING NUMBER | | | | | REVISION |
|---|---|---|---|---|---|
| EMERGENCY-SERVICE-BUILDING-ST-003 | | | | | A01 |
| DATE | 20/06/2020 | DATE | 21/06/2020 | DATE | 22/06/2020 |
| DRAWN | MAH | CHECKED | MF | APPROVED | FK |

LARSEN & TOUBRO DRAWING NUMBER: O19045_900_C_D_24042_002 — REVISION: 2
OUTOTEC DRAWING NUMBER: 900707__GAU01__AN03__CTB17__40002 — DOCUMENT ID: OU100670823 — REVISION: 2

LARSEN & TOUBRO
This drawing is the property of LARSEN & TOUBRO and must not be passed on to any person or body not authorized by us to receive it nor be copied or otherwise made use either in full or in part by such person or body without our prior permission in writing.

Outotec
The content of these documents are the sole property of Outotec Oyj. Any rights not expressly granted herein are reserved. Reproduction, transfer or distribution of part or all of the contents in any form without prior written permission of Outotec is prohibited.

MA'ADEN معادن
Saudi Arabian Mining Company شركة معادن العربية السعودية
This document and the information contained herein is Ma'aden proprietary know-how. This document or any part thereof should not be reproduced, stored in a retrieval system or transmitted by any means, electronic or otherwise, or divulged without prior written permission of Ma'aden.

| | | |
|---|---|---|
| DRAWN | - | - |
| CHECKED | AVG | 23/03/2020 |
| ENGINEER | - | - |
| APPROVED | SJM | 24/06/2020 |
| EMPLOYER | | |
| SCALE | 1:125 | A1 |

MANSOURAH - MASSARAH GOLD PROJECT
DETAIL DRAWING
PROCESS PLANT: EMERGENCY SERVICES BUILDING
DETAIL OF FDN. COL. & GRADE BEAM

DRAWING NUMBER: MD-216-4000-EG-CV-DED-1083 — REV: D01