


DRAWING NUMBER: MD-216-4000-EG-CV-DED-1085
REV: D01

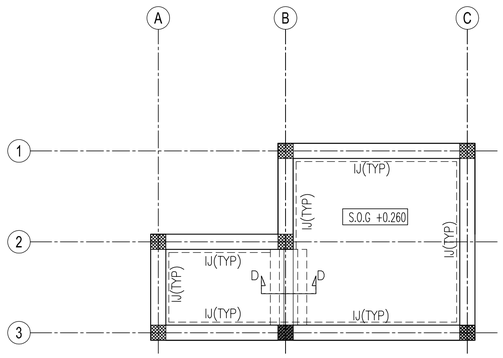


CONCRETE JOINTS LAYOUT
SCALE 1:50

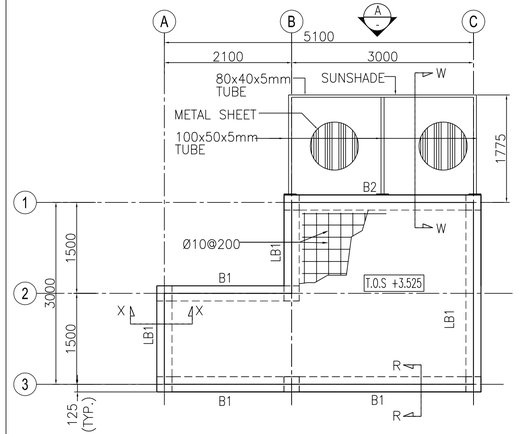

ROOF HOLLOW CORE SLAB LAYOUT
SCALE 1:50

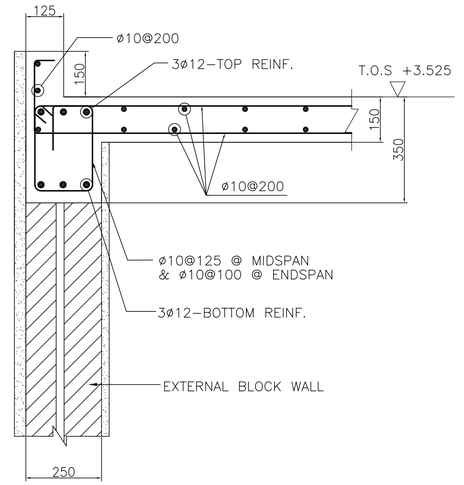


TYPICAL SECTION (R) FOR DROP BEAM(B1)
SCALE 1:10

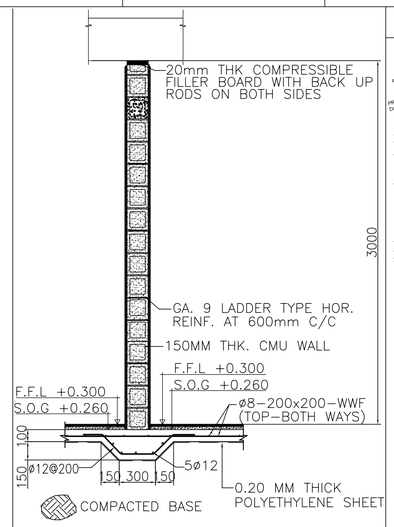


TYP INTERNAL WALL SECTION–D
SCALE 1:25


KEY PLAN

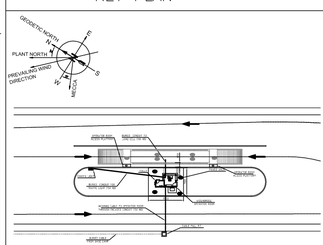


WEIGHBRIDGE CONTROL ROOM

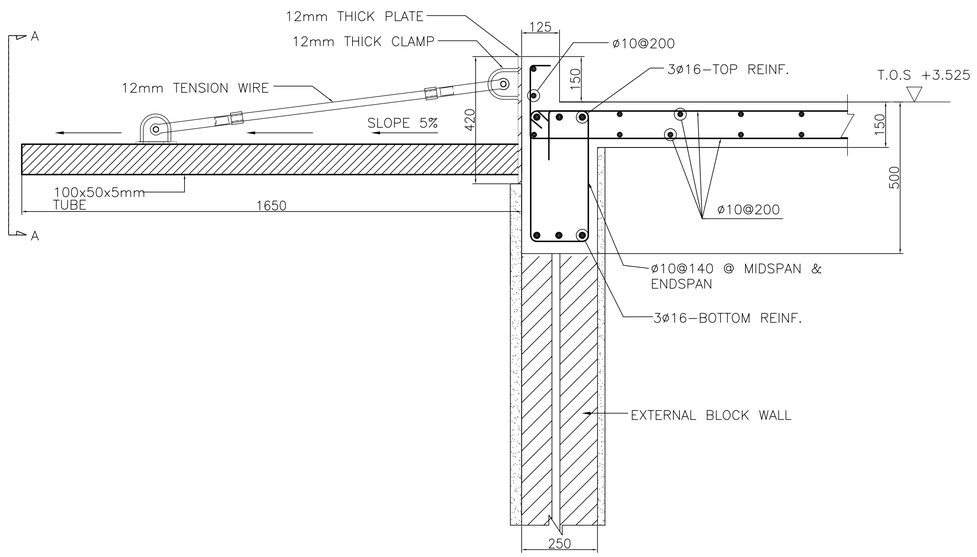

TYPICAL SECTION (W) FOR DROP BEAM(B2)
SCALE 1:10

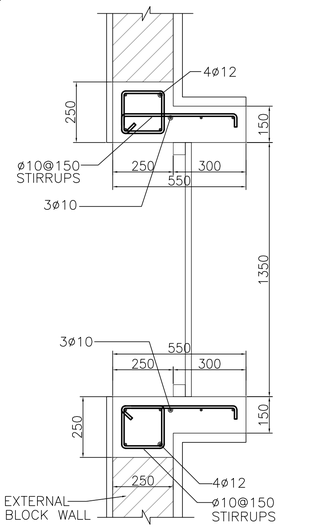

TYPICAL SECTION FOR WINDOW OPENINGS
SCALE 1:10

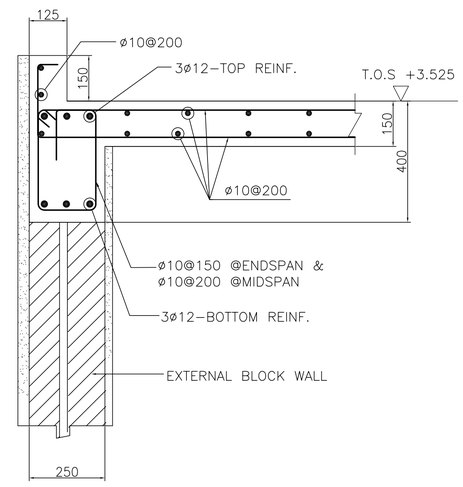


TYPICAL SECTION (X) FOR DROP BEAM(LB1)
SCALE 1:10

NOTES

1. ALL DIMENSIONS ARE GIVEN IN MILLIMETRES AND ELEVATIONS ARE IN METRES UNLESS OTHERWISE NOTED.
2. MINIMUM REINFORCED CONCRETE GRADE TO BE USED FOR SUPERSTRUCTURE & SUBSTRUCTURES IS C35(5000 PSI).
3. MINIMUM LEAN CONCRETE GRADE TO BE USED FOR THE SUB–STRUCTURES IS C15(2175 PSI).
4. ALL REINFORCING STEEL SHALL BE DEFORMED BILLET STEEL BARS CONFORMING TO ASTM–A615, WITH MINIMUM YIELD STRENGTH OF FY420 MPA .
5. THE NET SOIL BEARING CAPACITY CONSIDERED IN FOUNDATION DESIGN IS 570 KPA(REFER DOC 216–3000–EG–CV–RPT–1008)
6. WATER PROOFING INSULATION SHALL BE AS PER PROJECT SPECIFICATIONS & ITS MATERIAL TO BE APPROVED BY SITE ENGINEER.
7. MINIMUM CONCRETE COVER AS PER SBC–304–2018(TABLE 20.6.1.3.1) MEASURED FROM REBAR SHALL BE
   a. CONCRETE CAST AGAINST & PERMANENTLY EXPOSED TO EARTH (INCLUDING FOUNDATIONS OVER SUB–SLAB) FORMED CONCRETE EXPOSED TO EARTH OR WEATHER.....50MM
   b. CONCRETE NOT EXPOSED TO WEATHER NOR IN CONTACT WITH GROUND
      BEAMS, COLUMNS.....40MM
      SLABS, WALLS, JOISTS.....20MM
   c. CONCRETE SLAB OVER 50MM SUB–SLAB.....20MM
8. ALL DRAWINGS MUST BE READ IN CONJUNCTION WITH RELEVANT ARCHITECTURAL AND ENGINEERING DRAWINGS RELATED TO THE SAME SHEET AND ANY ITEM ON IT.
9. F.F.L +0.300 MENTIONED IS EQUIVALENT TO RL 922.65

LEGENDS


F/FDN.–FOUNDATION
CR–COLUMN NECK
C/COL.–COLUMN
FFL–FINISH FLOOR LEVEL
FGL–FINISH GROUND LEVEL
VER–VERTICAL
WWF–WELDED WIRE FABRIC
HCS–HOLLOW CORE SLAB
GB–GRADE BEAM
IJ–ISOLATION JOINT
CJ–CONTROL JOINT
BW's–BOTH WAYS
S.O.G–SLAB ON GRADE
TYP–TYPICAL
HOR.–HORIZONTAL
REINF.–REINFORCEMENT
LVL.–LEVEL
RL–REDUCED LEVEL
P.–PEDESTAL
℄ – CENTRE LINE OF COLUMN
T.O.S–TOP OF SCREED
DIA–DIAMETER

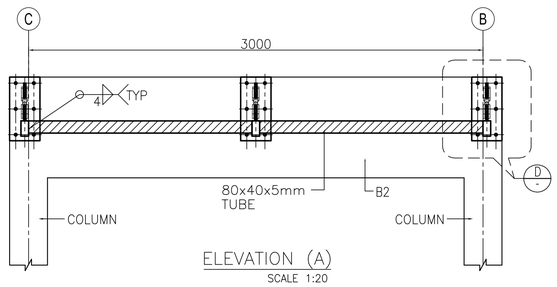


ELEVATION (A)
SCALE 1:20

SCHEDULE OF ROOF BEAMS

BEAM MARK	DIMENSIONS		STEEL REINFORCEMENT				STIRRUPS	REMARKS
			TOP		BOTTOM			
	WIDTH	DEPTH	STRAIGHT	ADD.	STRAIGHT	ADD.		
LB1	250	400	3Ø12	–	3Ø12	–	PROVIDE Ø10@150 AT THE DISTANCE OF L/3 FROM THE SUPPORT IN END SPAN & Ø10@200 IN THE MID SPAN	REFER DETAIL–X
B1	250	350	3Ø12	–	3Ø12	–	PROVIDE Ø10@100 AT THE DISTANCE OF L/3 FROM THE SUPPORT IN END SPAN & Ø10@125 IN THE MID SPAN	REFER DETAIL–R
B2	250	500	3Ø16	–	3Ø16	–	PROVIDE Ø10@140 BOTH IN END SPAN & MIDSPAN	REFER DETAIL–W

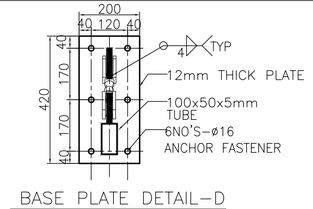

BASE PLATE DETAIL–D
SCALE 1:10

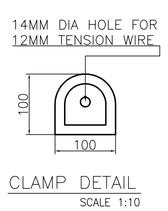

CLAMP DETAIL
SCALE 1:10

DOCUMENT NUMBER	REFERENCE DOCUMENTS	REV	DATE	REVISION DESCRIPTION	DRN	CHK	ENG	APP	EMP
MD-216-4000-EG-CV-DED-1084	LAYOUT AND DETAILS STRUCTURE								
MD-216-6000-EG-CV-STD-1002	HOLLOW CORE SLAB STANDARD	D01	26/05/2023	AS-BUILT	--	AVG	--	SJM	
MD-216-6000-EG-CV-STD-1001	REINFORCEMENT STANDARD	C02	13/07/2021	ISSUED FOR CONSTRUCTION & REVISED AS MARKED /C02	--	AVG	--	SJM	
MD-216-6000-EG-AR-GAD-1002	BUILDING PLANS	C01	28/07/2020	ISSUED FOR CONSTRUCTION	--	AVG	--	SJM	
MD-216-6000-EG-CV-GAD-1535	OVERALL LAYOUT PLAN	A01	29/06/2020	ISSUED FOR APPROVAL	--	AVG	--	SJM	

DESIGNER: GULF CONSULT ARCHITECTS AND ENGINEERS

DRAWING NUMBER						REVISION
WEIG.-CONTROL-ROOM-ST-002						0
DATE	25/06/2020	DATE	26/06/2020	DATE	27/06/2020	
DRAWN	MAH	CHECKED	MF	APPROVED	FK	

LARSEN & TOUBRO DRAWING NUMBER		REVISION
019045_910_C_D_24045_001		3
OUTOTEC DRAWING NUMBER	DOCUMENT ID	REVISION
900707__GAU01__AN03__CTB17__40020	OU100688265	3

LARSEN & TOUBRO
This drawing is the property of LARSEN & TOUBRO and must not be passed on to any person or body not authorized by us to receive it nor be copied or otherwise made use either in full or in part by such person or body without our prior permission in writing.

Outotec
The content of these documents are the sole property of Outotec Oyj. Any rights not expressly granted herein are reserved. Reproduction, transfer or distribution of part or all of the contents in any form without prior written permission of Outotec is prohibited.

MA'ADEN معادن
Saudi Arabian Mining Company شركة التعدين العربية السعودية
This document and the information contained herein is Ma'aden proprietary know-how. This document or any part thereof should not be reproduced, stored in a retrieval system or transmitted by any means, electronic or otherwise, or divulged without prior written permission of Ma'aden.

DRAWN	--	--
CHECKED	AVG	28/06/2020
ENGINEER	--	--
APPROVED	SJM	29/06/2020
EMPLOYER		
SCALE	1:50	A1

MANSOURAH - MASSARAH GOLD PROJECT
DETAIL DRAWING
PROCESS PLANT-WEIGHBRIDGE CONTROL ROOM
DETAILS OF GRADE SLAB & ROOF

DRAWING NUMBER	REV
MD - 216 - 4000 - EG - CV - DED - 1085	D01