

DRAWING NUMBER: MD-216-4000-EG-CV-DED-1088 | REV: D01

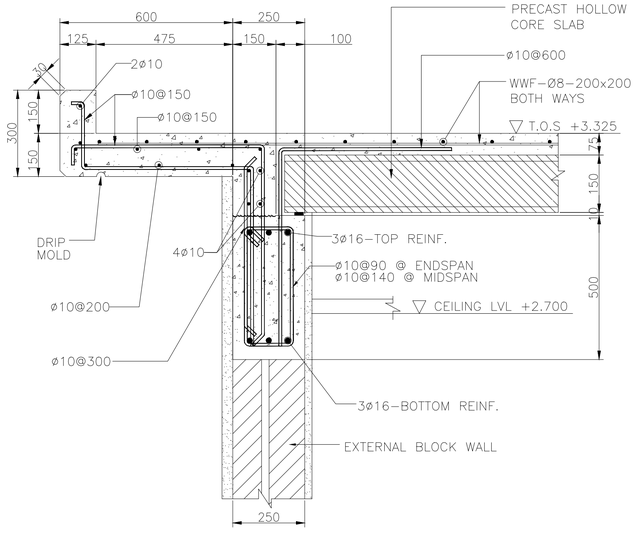


TYPICAL SECTION FOR LEDGER BEAM(LB1) — SCALE 1:10 — X / GAD-1087

SCHEDULE OF ROOF BEAMS


BEAM MARK	DIMENSIONS		STEEL REINFORCEMENT				STIRRUPS	REMARKS
			BOTTOM		TOP			
	WIDTH	DEPTH	STRAIGHT	ADD.	STRAIGHT	ADD.		
LB1	250	500	3ø16	–	3ø16	–	PROVIDE ø10@90@ ENDSPAN & ø10@140 THE MID SPAN	REFER DETAIL-X@GAD-1087
LB2	250	550	3ø25	–	3ø25+2ø12	–	PROVIDE ø10@150 BOTH @ MIDSPAN & THE END SPAN	REFER DETAIL-S@GAD-1087
LB3	250	500	3ø20	–	3ø20	–	PROVIDE ø10@90@ ENDSPAN & ø10@140 THE MID SPAN	REFER DETAIL-W@GAD-1087
B1	250	500	3ø16	–	3ø16	–	PROVIDE ø10@140 BOTH @ MIDSPAN & THE END SPAN	REFER DETAIL-Y@GAD-1087

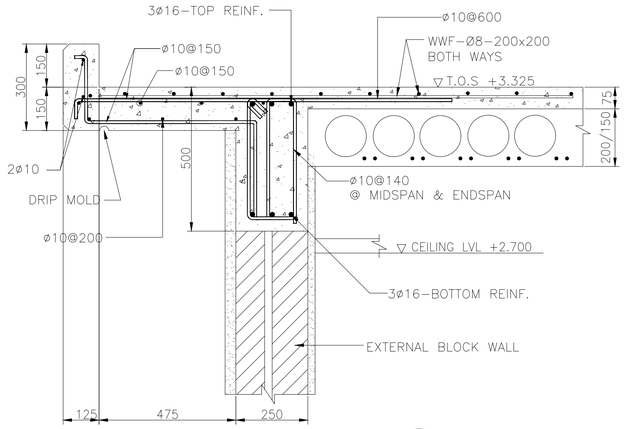


TYPICAL SECTION FOR DROP BEAM(B1) — SCALE 1:10 — Y / GAD-1087

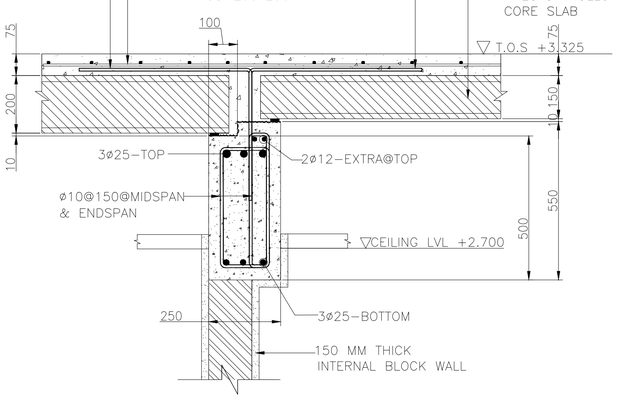

TYPICAL SECTION FOR LEDGER BEAM(LB2) — SCALE 1:10 — S / GAD-1087

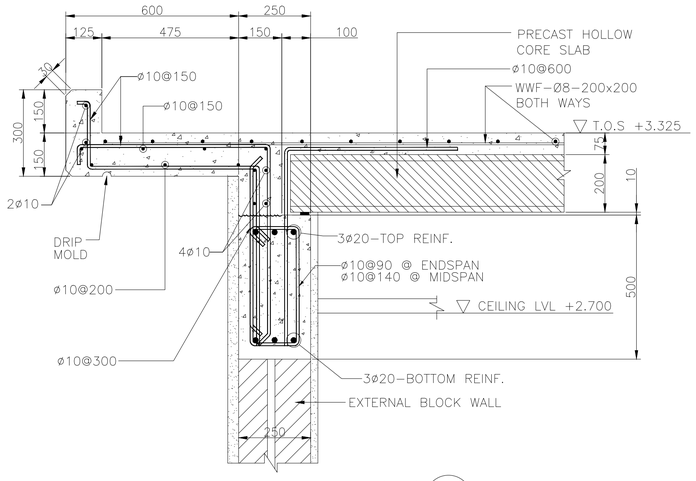


TYPICAL SECTION FOR LEDGER BEAM(LB3) — SCALE 1:10 — W / GAD-1087

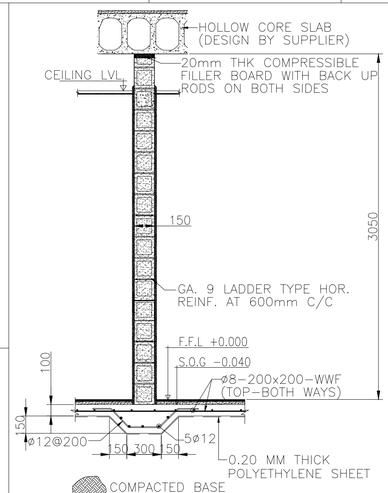


TYP. INTERNAL WALL SECTION — SCALE 1:10 — D / GAD-1087

NOTE: CONTROL JOINTS SHALL BE PROVIDED AT MAX SPACING OF 20 FT (6.10 M) AS PER ACI CODE

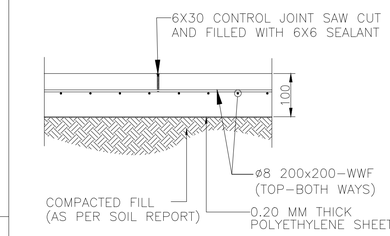

TYP CONTROL JOINT DETAIL — SCALE 1:10 — B / GAD-1087

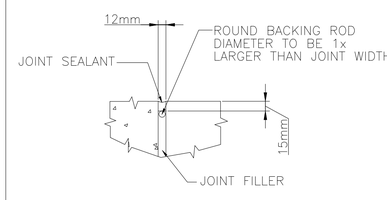

TYP JOINT SEAL DETAIL-C — SCALE 1:10

NOTES

1.) ALL DIMENSIONS ARE GIVEN IN MILLIMETRES AND ELEVATIONS ARE IN METRES UNLESS OTHERWISE NOTED.
2.) MINIMUM REINFORCED CONCRETE GRADE TO BE USED FOR SUPERSTRUCTURE & SUBSTRUCTURES IS C35(5000 PSI).
3.) MINIMUM LEAN CONCRETE GRADE TO BE USED FOR THE SUB-STRUCTURES IS C15(2175 PSI).
4.) ALL REINFORCING STEEL SHALL BE DEFORMED BILLET STEEL BARS CONFORMING TO ASTM-A615, WITH MINIMUM YIELD STRENGTH OF FY420 MPA .
5.) THE NET SOIL BEARING CAPACITY CONSIDERED IN FOUNDATION DESIGN IS 570 KPA(REFER DOC 216-3000-EG-CV-RPT-1008)
6.) WATER PROOFING INSULATION SHALL BE AS PER PROJECT SPECIFICATIONS & ITS MATERIAL TO BE APPROVED BY SITE ENGINEER.
7.) MINIMUM CONCRETE COVER AS PER SBC-304-2018(TABLE 20.6.1.3.1) MEASURED FROM REBAR SHALL BE
   a) CONCRETE CAST AGAINST & PERMANENTLY EXPOSED TO EARTH (INCLUDING FOUNDATIONS OVER SUB-SLAB) FORMED CONCRETE EXPOSED TO EARTH OR WEATHER.....50MM
   b.) CONCRETE NOT EXPOSED TO WEATHER NOR IN CONTACT WITH GROUND
   BEAMS, COLUMNS.....40MM
   SLABS, WALLS, JOISTS.....20MM
   c.) CONCRETE SLAB OVER 50MM SUB-SLAB.....20MM
8.) ALL DRAWINGS MUST BE READ IN CONJUNCTION WITH RELEVANT ARCHITECTURAL AND ENGINEERING DRAWINGS RELATED TO THE SAME SHEET AND ANY ITEM ON IT.
9.) F.F.L +0.00 MENTIONED IS EQUIVALENT TO RL 913.400

LEGENDS
F/FDN.-FOUNDATION
CR-COLUMN NECK
C/COL.-COLUMN
FFL-FINISH FLOOR LVL
FGL-FINISH GROUND LVL
TOS-TOP OF SCREED
WWF-WELDED WIRE FABRIC
HCS-HOLLOW CORE SLAB
GB-GRADE BEAM
IJ-ISOLATION JOINT
CJ-CONTROL JOINT
BW's-BOTH WAYS
S.O.G-SLAB ON GRADE
ARCH-ARCHITECTURAL
HOR.-HORIZONTAL
REINF.-REINFORCEMENT
LVL.-LEVEL
RL-REDUCED LEVEL
P.-PEDESTAL
TYP.-TYPICAL

DOCUMENT NUMBER	REFERENCE DOCUMENTS	REV	DATE	REVISION DESCRIPTION	DRN	CHK	ENG	APP	EMP
MD-216-4000-EG-AR-GAD-3040	BUILDING ELEVATIONS & SECTIONS	D01	24/05/2023	AS-BUILT	--	AVG	--	SJM	
MD-216-4000-EG-AR-GAD-3039	BUILDING PLANS	C01	06/07/2020	ISSUED FOR CONSTRUCTION	--	AVG	--	SJM	
MD-216-6000-EG-CV-GAD-1535	OVERALL LAYOUT PLAN	A01	10/06/2020	ISSUED FOR APPROVAL	--	AVG	--	SJM	

DESIGNER: مكتب الخليج للاستشارات الهندسية — الغبرة، المملكة العربية السعودية — GULF CONSULT ARCHITECTS AND ENGINEERS

DRAWING NUMBER	REVISION
ST-NON-ENGINEERING OFFICE-ST-004	0

DATE	02/06/2020	DATE	03/06/2020	DATE	04/06/2020
DRAWN	MAH	CHECKED	MF	APPROVED	FK

LARSEN & TOUBRO DRAWING NUMBER: 019045_910_C_D_24048_001 — REVISION: 02

OUTOTEC DRAWING NUMBER: 900707__GAU01__AN03__CTB17__40009 — DOCUMENT ID: OU100683340 — REVISION: 02

LARSEN & TOUBRO
This drawing is the property of LARSEN & TOUBRO and must not be passed on to any person or body not authorized by us to receive it nor be copied or otherwise made use either in full or in part by such person or body without our prior permission in writing.

Outotec
The content of these documents are the sole property of Outotec Oy. Any rights not expressly granted herein are reserved. Reproduction, transfer or distribution of part or all of the contents in any form without prior written permission of Outotec is prohibited.

MA'ADEN معادن
Saudi Arabian Mining Company شركة معادن العربية السعودية
This document and the information contained herein is Ma'aden proprietary know-how. This document or any part thereof should not be reproduced, stored in a retrieval system or transmitted by any means, electronic or otherwise, or divulged without prior written permission of Ma'aden.

DRAWN	--	--	MANSOURAH - MASSARAH GOLD PROJECT
CHECKED	AVG	09/06/2020	DETAIL DRAWING
ENGINEER	--	--	PROCESS PLANT-ENGINEERING OFFICE CUM CCR
APPROVED	SJM	10/06/2020	DETAIL OF ROOF & GRADE SLAB
EMPLOYER			
SCALE 1:50		A1	DRAWING NUMBER: MD-216-4000-EG-CV-DED-1088 — REV: D01