

DRAWING NUMBER: MD-216-4000-EG-CV-DED-1091 | REV: D01

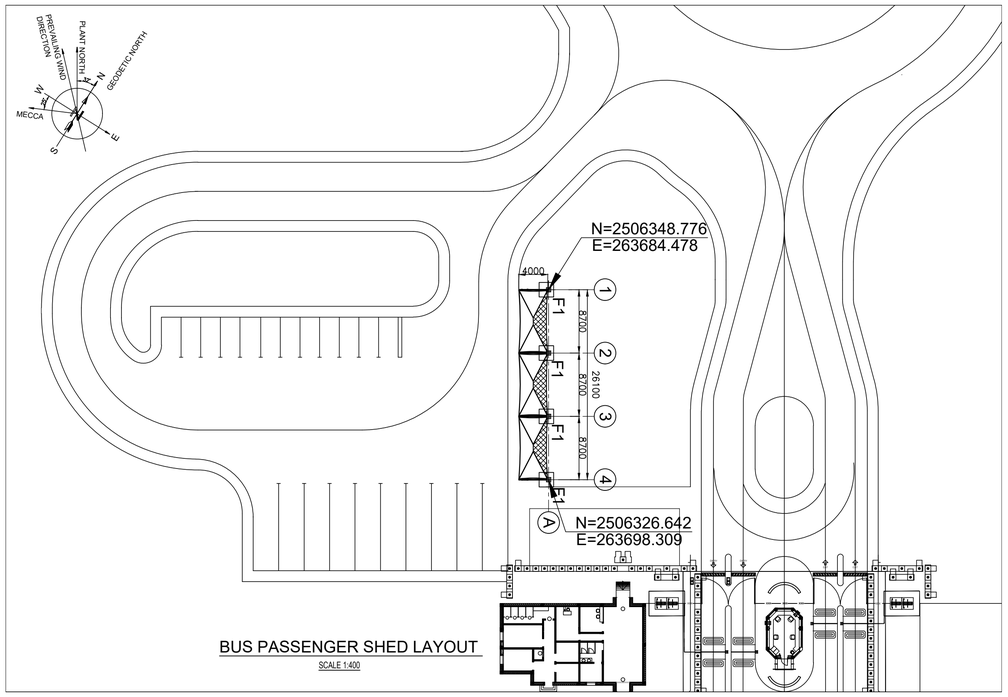


BUS PASSENGER SHED LAYOUT

SCALE 1:400

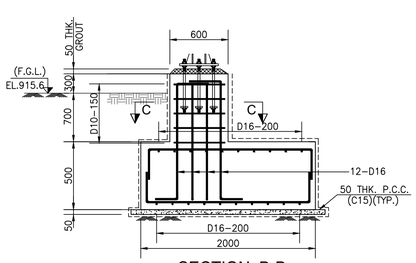


SECTION B-B

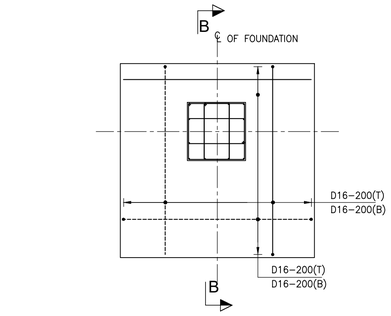


RCC DETAILS OF FOUNDATION PLAN MKD. F1

(4 NOS. REQUIRED)

SCALE 1:30

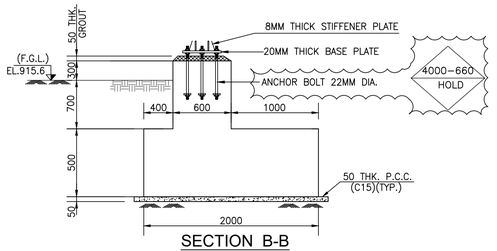


SECTION B-B

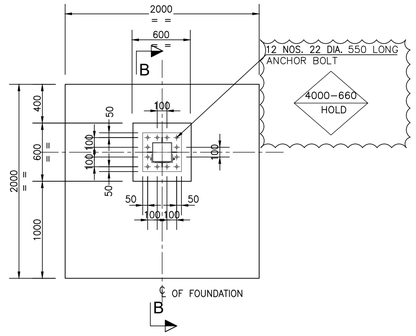


FOUNDATION PLAN MKD. F1

(4 NOS. REQUIRED)


SCALE 1:30

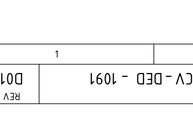

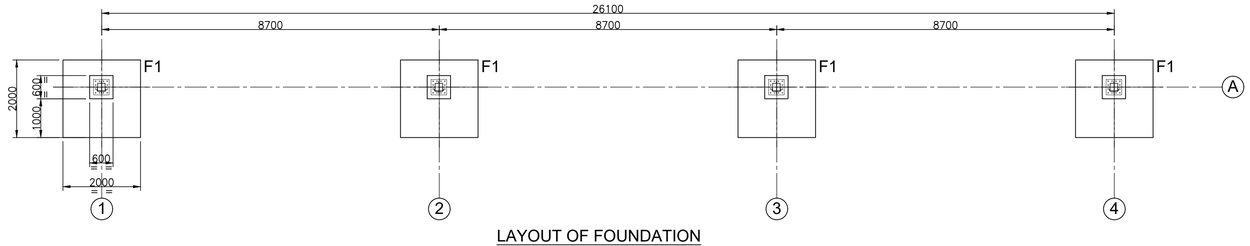

LAYOUT OF FOUNDATION


SCALE 1:75

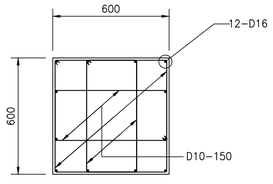

SECTION C-C

R.C.C DETAIL OF COLUMN

SCALE 1:15

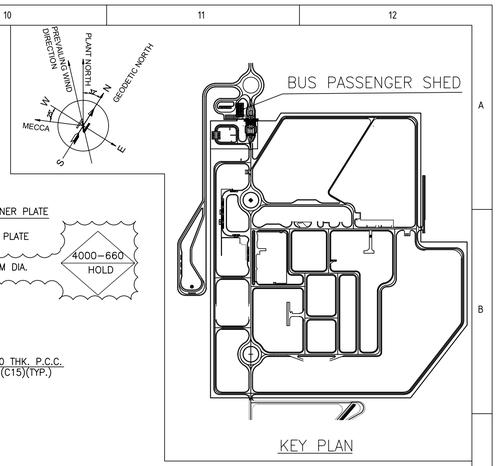

KEY PLAN

LEGENDS:

EL – ELEVATION
FGL – FINISHED GRADE LEVEL
FFL – FINISHED FLOOR LEVEL
FRL – FINISHED ROAD LEVEL
TYP. – TYPICAL
CMU – CONCRETE MASONRY UNIT
CH – CEILING HEIGHT
SSL – STRUCTURAL SLAB LEVEL
TOP – TOP OF PARAPET
DIA. – DIAMETER
RCC – REINFORCED CEMENT CONCRETE
PCC – PLAIN CEMENT CONCRETE
THK. – THICK
℄ – CENTRE LINE
MKD. – MARKED
BOTTOM REINFORCEMENT(B) ————
TOP REINFORCEMENT(T) ----------

NOTES:–

1. ALL DIMENSIONS ARE IN MILLIMETRES AND ALL LEVELS ARE GIVEN IN METRES UNLESS OTHERWISE NOTED.
2. GRADE OF CONCRETE SHALL BE C35 (35MPa) FOR FOUNDATION & COLUMN.
3. GRADE OF REINFORCEMENT SHALL BE DEFORMED BAR ASTM A615 – GRADE 60 (fy = 420 MPa).
4. NET SAFE BEARING CAPACITY OF SOIL AT BOTTOM OF FOUNDATION IS CONSIDERED AS 350KN/SQ.M.
5. CLEAR COVER TO MAIN REINFORCEMENT SHALL BE AS
   a) FOUNDATION = 50 mm (BOTTOM & SIDE) 50 mm. (TOP)
   b) COLUMN = 50mm
6. IF ANY PART OF FOUNDATION COMES ON BACKFILL ZONE OF ADJACENT FOUNDATION OR ANY LOOSE SOIL ARE ENCOUNTERED BELOW FOUNDATION LEVEL THE SAME SHALL BE REMOVED AND FILLED WITH PCC.
7. FOR STANDARD REINFORCEMENT DETAIL & GENERAL NOTES FOR CIVIL WORKS REFER DRAWING NO. MD-216-1000-EG-CV-DED-1005 &1001.
8. THIS DRAWING IS TO BE READ IN CONJUNCTION WITH DRAWING NO MD-216-4000-EG-ST-GAD-2069

DOCUMENT NUMBER	REFERENCE DOCUMENTS	REV	DATE	REVISION DESCRIPTION	DRN	CHK	ENG	APP	EMP
		D01	22/02/2023	AS-BUILT	MNS	SJM	AVG	AG	
		C01	05/09/2020	ISSUED FOR CONSTRUCTION	MNS	SJM	AVG	AG	
MD-216-1000-EG-ST-CRT-1001	CIVIL, STRUCTURAL & ARCHITECTURAL DESIGN CRITERIA	A01	13/08/2020	ISSUED FOR APPROVAL	MNS	SJM	AVG	AG	

LARSEN & TOUBRO

This drawing is the property of LARSEN & TOUBRO and must not be passed on to any person or body not authorized by us to receive it nor be copied or otherwise made use either in full or in part by such person or body without our prior permission in writing.

Outotec

The content of these documents are the sole property of Outotec Oyj. Any rights not expressly granted herein are reserved. Reproduction, transfer or distribution of part or all of the contents in any form without prior written permission of Outotec is prohibited.

MA'ADEN معادن
Saudi Arabian Mining Company شركة معادن العربية السعودية

This document and the information contained herein is Ma'aden proprietary know-how. This document or any part thereof should not be reproduced, stored in a retrieval system or transmitted by any means, electronic or otherwise, or divulged without prior written permission of Ma'aden.

LARSEN & TOUBRO DRAWING NUMBER: 019045_910_C_D_24051_001 | REVISION: 2

OUTOTEC DRAWING NUMBER: 900707 __GAU01 __AN03__CTB17 __40013 | DOCUMENT ID: OU100692631 | REVISION: 2

DRAWN	MNS	06/08/2020
CHECKED	SJM	07/08/2020
ENGINEER	AVG	06/08/2020
APPROVED	AG	13/08/2020
EMPLOYER		
SCALE	1:400,1:75,1:30	A1

MANSOURAH - MASSARAH GOLD PROJECT
DETAIL DRAWING
PROCESS AREA-BUS PASSENGER SHED
BUS PASSENGER SHED LAYOUT & DETAILS

DRAWING NUMBER: MD-216-4000-EG-CV-DED-1091 | REV: D01