


DRAWING NUMBER: MD-216-4000-EG-CV-GAD-1058 | REV: D01

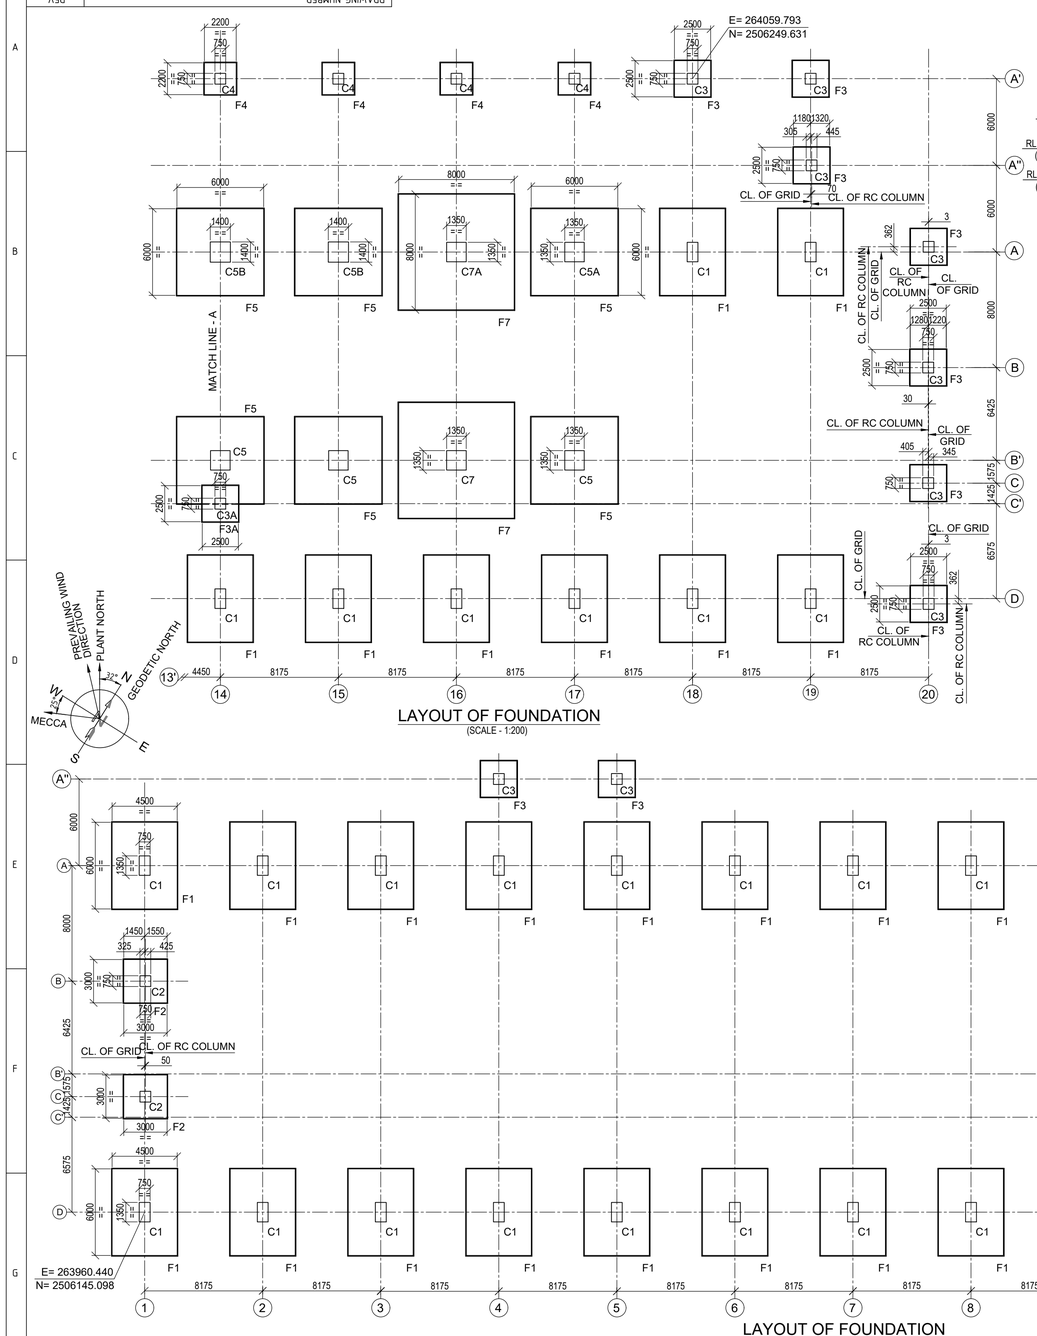


LAYOUT OF FOUNDATION
(SCALE - 1:200)

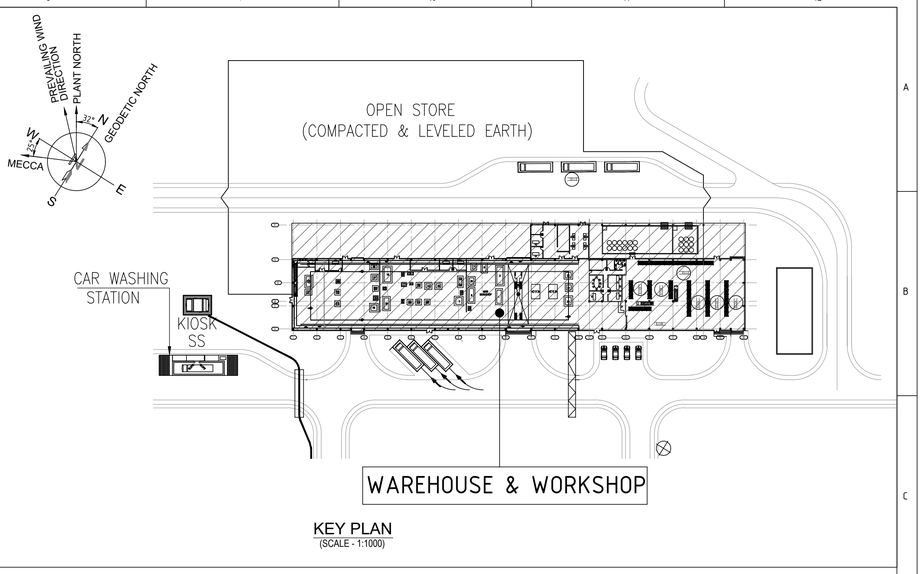


KEY PLAN
(SCALE - 1:1000)

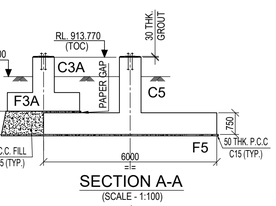

SECTION A-A
(SCALE - 1:100)

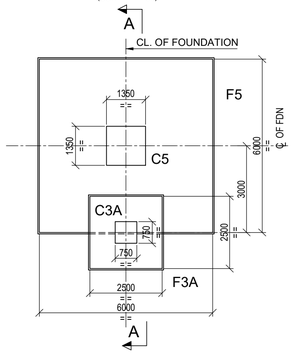

DETAIL - 1
(SCALE - 1:100)

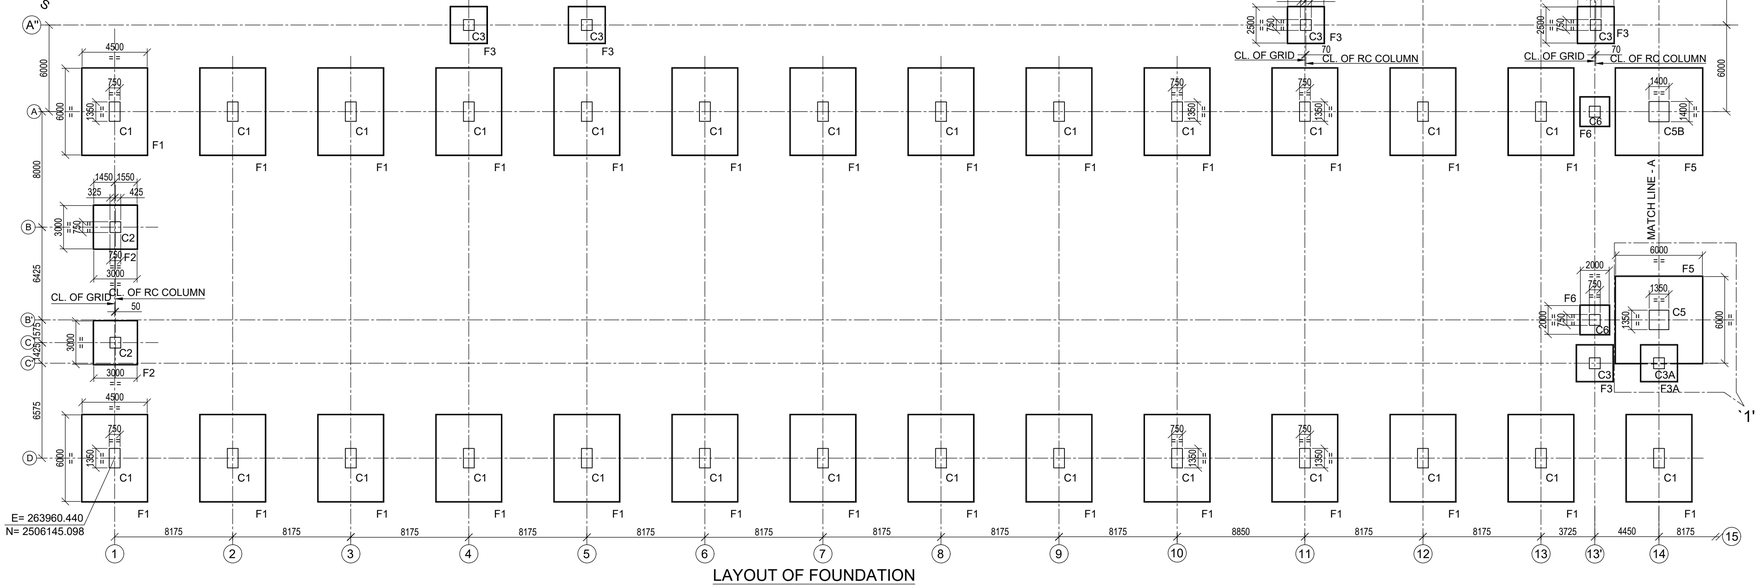

LAYOUT OF FOUNDATION
(SCALE - 1:200)

LEGENDS :

- TOC - TOP OF CONCRETE
- RL- REDUCED LEVEL
- TYP - TYPICAL
- PCC - PLAIN CEMENT CONCRETE
- MKD - MARKED
- C - COLUMN
- FDN - FOUNDATION
- BOF - BOTTOM OF FOUNDATION
- CL - CENTRE LINE
- RCC - REINFORCED CEMENT CONCRETE
- DRG. - DRAWING
- THK - THICK
- FGL - FINISHED GROUND LEVEL
- RC - REINFORCED CONCRETE
- BOF - BOTTOM OF FOUNDATION

NOTES :-

1. ALL DIMENSIONS ARE IN MILLIMETRES AND LEVELS AND CO-ORDINATES ARE IN METRES UNLESS OTHERWISE STATED.
2. GRADE OF CONCRETE SHALL BE 35MPa FOR RCC AND 15 MPa FOR BLINDING CONCRETE.
3. GRADE OF REINFORCEMENT SHALL BE DEFORMED BAR MPa (GRADE 60) - ASTM A615/A615M.
4. NET SAFE BEARING CAPACITY OF SOIL AT BOTTOM OF FOUNDATION IS CONSIDERED AS 400KN/SQ.M.
5. CLEAR COVER TO REINFOR CEMENT SHALL BE AS
   a). FOUNDATION = 50mm.
   b). COLUMN = 50mm.
6. FOR MINIMUM LAP LENGTH OF REINFORCEMENT REFER DRG. NO. MD-216-1000-EG-CV-DED-1001.
7. IF ANY PART OF FOUNDATION COMES ON BACKFILL ZONE OF ADJACENT FOUNDATION OR ANY LOOSE SOIL ARE ENCOUNTERED BELOW FOUNDATION LEVEL THE SAME SHALL BE REMOVED AND FILLED WITH PCC.
8. FOR DETAILS OF ANCHOR BOLTS REFER DRG. NO. MD-P20131-B01-A001 & MD-P20131-B01-A002.
9. FOR STRUCTURAL DETAILS REFER DRG. NO. MD-216-4000-EG-ST-GAD-2052 TO 2065.
10. FOR ANCHOR BOLT LOCATION FOR COLUMN MKD. C1,C2,C3,C3A,C4,C5,C5A,C5B,C6,C7,C7A, REFER DRG. NO. MD-216-4000-EG-CV-GAD-1059.
11. THIS DRAWING IS TO BE READ IN CONJUNCTION WITH DRAWING NO. MD-216-4000-EG-CV-DED-1060.
12. CIVIL DRAWINGS ARE PREPARED ON BASIS OF STRUCTURAL DRAWINGS OF REVISION VERSION AS REFERRED HERE.
13. FIXING DETAIL OF ADJACENT COLUMN POST FOR DOOR SUPPORTING SHALL BE FURNISHED IN SEPARATE DRAWING.

DOCUMENT NUMBER	REFERENCE DOCUMENTS	REV	DATE	REVISION DESCRIPTION	DRN	CHK	ENG	APP	EMP
		D01	22/02/2023	AS-BUILT	DSR	SJM	MMJ	AG	
MD-216-4000-EG-AR-GAD-3005	BUILDING ELEVATIONS & SECTIONS	C02	19/08/2020	ISSUED FOR CONSTRUCTION AND REVISED AS MKD. C02	DSR	SJM	MMJ	AG	
MD-216-4000-EG-AR-GAD-3004	ROOF & FALSE CEILING PLANS	C01	29/06/2020	ISSUED FOR CONSTRUCTION AND REVISED AS MKD. C01	DSR	SJM	MMJ	AG	
MD-216-4000-EG-AR-GAD-3003	BUILDING PLANS & SCHEDULES OF FINISHES	A01	30/05/2020	ISSUED FOR REFERENCE	DSR	SJM	MMJ	AG	

RESERVED FOR VENDOR LOGO AND DRAWING NUMBER

LARSEN & TOUBRO

This drawing is the property of LARSEN & TOUBRO and must not be passed on to any person or body not authorized by us to receive it nor be copied or otherwise made use either in full or in part by such person or body without our prior permission in writing.

Outotec

The content of these documents are the sole property of Outotec Oyj. Any rights not expressly granted herein are reserved. Reproduction, transfer or distribution of part or all of the contents in any form without prior written permission of Outotec is prohibited.

MA'ADEN معادن
Saudi Arabian Mining Company شركة معادن العربية السعودية

This document and the information contained herein is Ma'aden proprietary know-how. This document or any part thereof should not be reproduced, stored in a retrieval system or transmitted by any means, electronic or otherwise, or divulged without prior written permission of Ma'aden.

LARSEN & TOUBRO DRAWING NUMBER: 019045_501_C_G_24024_001 | REVISION: 3

OUTOTEC DRAWING NUMBER: 900707 __GAU01 __AN03__MTL01 __40063 | DOCUMENT ID: OU100687708 | REVISION: 3

DRAWN	DSR	28/05/2020
CHECKED	SJM	29/05/2020
ENGINEER	MMJ	28/05/2020
APPROVED	AG	30/05/2020
EMPLOYER		
SCALE	1:200	A1

MANSOURAH - MASSARAH GOLD PROJECT
GENERAL ARRANGEMENT
PROCESS PLANT- WAREHOUSE & WORKSHOP
LAYOUT & DETAIL

DRAWING NUMBER: MD-216-4000-EG-CV-GAD-1058 | REV: D01