



DRAWING NUMBER: MD-216-4000-EG-CV-GAD-1059 REV D01

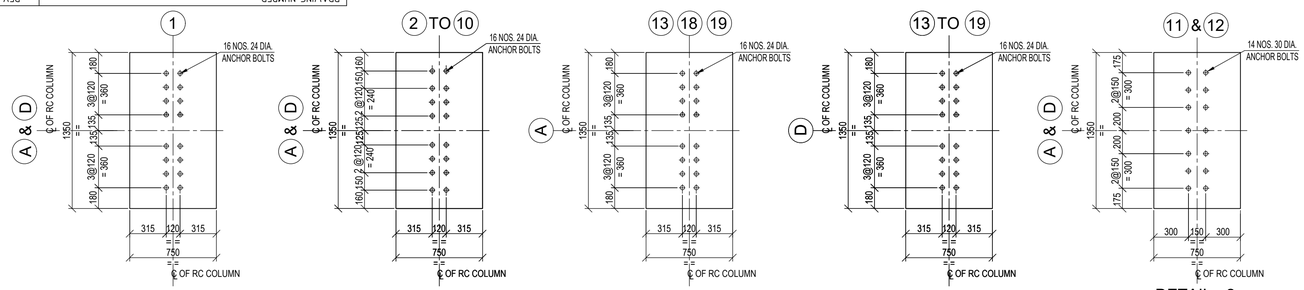


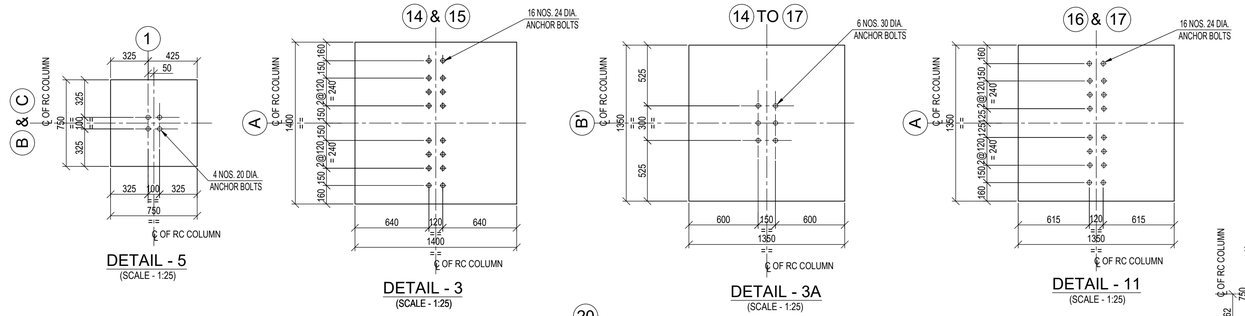


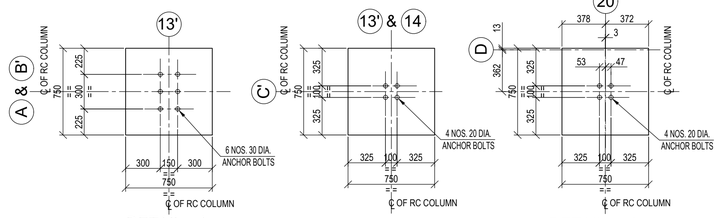

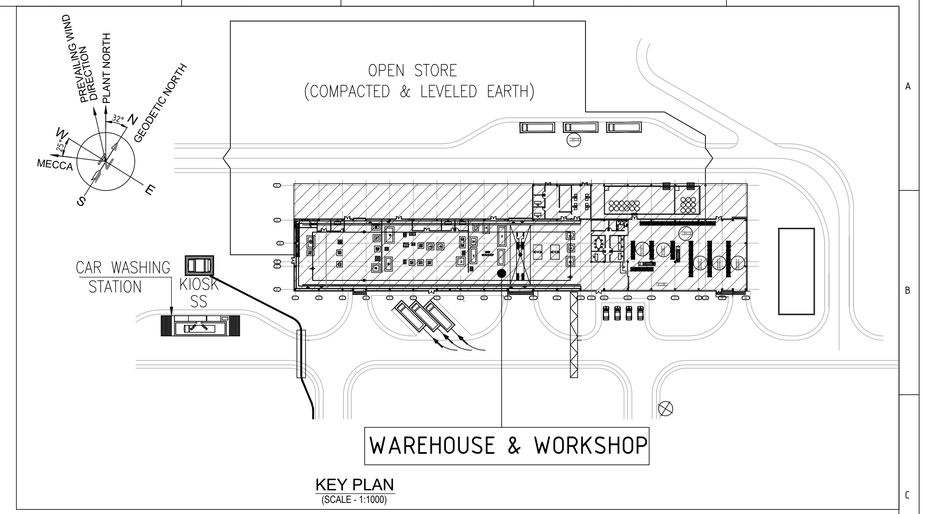

KEY PLAN
(SCALE - 1:1000)

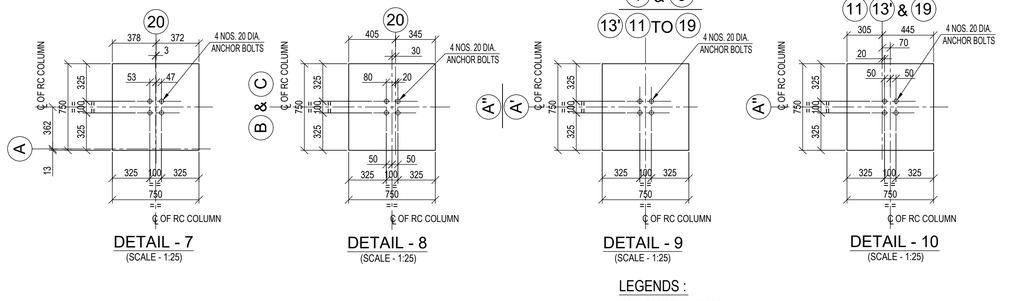

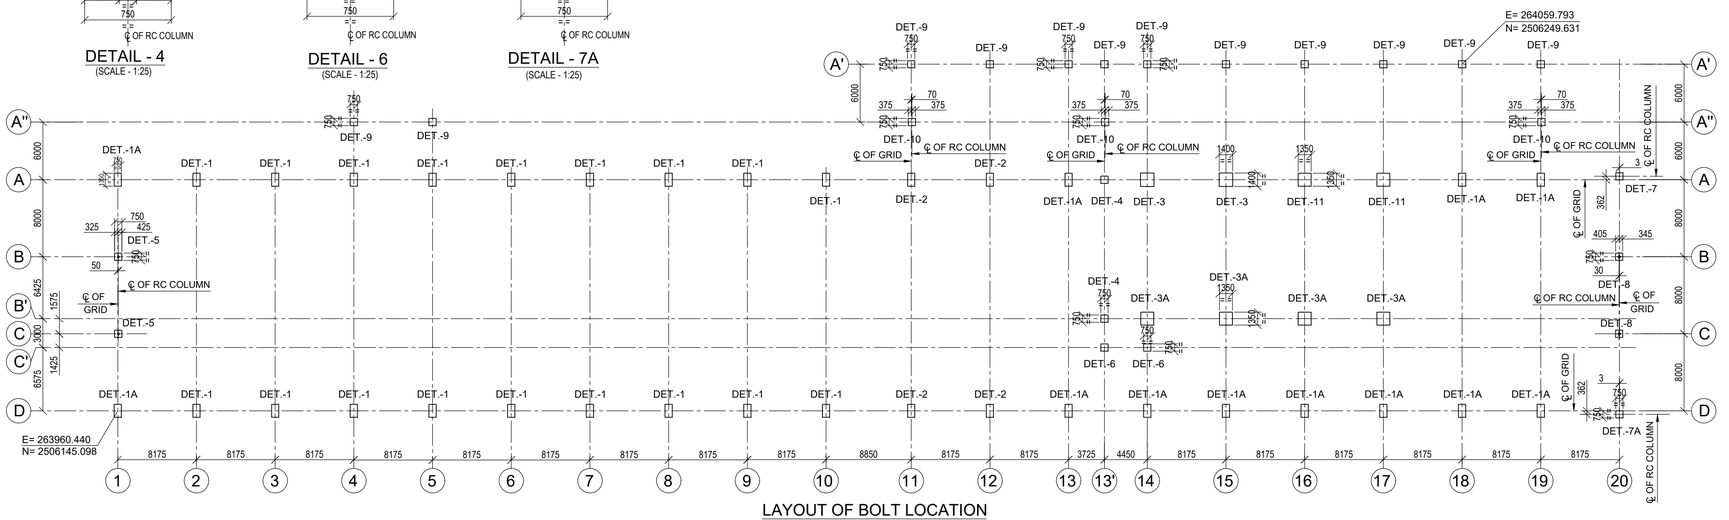

LAYOUT OF BOLT LOCATION
(SCALE - 1:300)

LEGENDS :

TOC - TOP OF CONCRETE
RL- REDUCED LEVEL
TYP - TYPICAL
PCC - PLAIN CEMENT CONCRETE
MKD - MARKED
C - COLUMN
F - FOUNDATION
BOF - BOTTOM OF FOUNDATION
℄ - CENTRE LINE
RCC - REINFORCED CEMENT CONCRETE
DRG. - DRAWING
THK - THICK
DRN. - DRAWN
OPP. - OPPOSITE
DET. - DETAIL
RC - REINFORCED CONCRETE
DIA. - DIAMETER

NOTES :-

1. ALL DIMENSIONS ARE IN MILLIMETRES AND LEVELS AND CO-ORDINATES ARE IN METRES UNLESS OTHERWISE STATED.
2. GRADE OF CONCRETE SHALL BE 35MPa FOR RCC AND 15 MPa FOR BLINDING CONCRETE.
3. GRADE OF REINFORCEMENT SHALL BE DEFORMED BAR MPa (GRADE 60) - ASTM A615/A615M.
4. FOR GRADE & DETAILS OF ANCHOR BOLTS REFER DRG. NO. MD-P20131-B01-A001 & MD-P20131-B01-A002. ALL THE ANCHOR BOLTS WILL BE SUPPLIED BY PEB VENDOR.
5. FOR STRUCTURAL DETAILS REFER DRG. NO. MD-216-4000-EG-ST-GAD-2052 TO 2065.
6. THIS DRAWING IS TO BE READ IN CONJUNCTION WITH DRG. NO. MD-216-4000-EG-CV-GAD-1058 & MD-216-4000-EG-CV-DED-1060.
7. FOR OTHER NOTES REFER DRG. NO. MD-216-4000-EG-CV-GAD-1058.
8. ALL ANCHOR BOLTS ARE CAST IN SITU.
9. FIXING DETAIL OF ADJACENT COLUMN POST FOR DOOR SUPPORTING SHALL BE FURNISHED IN SEPARATE DRAWING.

DOCUMENT NUMBER	REFERENCE DOCUMENTS	REV	DATE	REVISION DESCRIPTION	DRN	CHK	ENG	APP	EMP
MD-216-4000-EG-AR-GAD-3005	BUILDING ELEVATIONS & SECTIONS	D01	22/02/2023	AS-BUILT	DSR	SJM	MMJ	AG	
MD-216-4000-EG-AR-GAD-3004	ROOF & FALSE CEILING PLANS	C01	19/08/2020	ISSUED FOR CONSTRUCTION AND REVISED AS MKD. C01	DSR	SJM	MMJ	AG	
MD-216-4000-EG-AR-GAD-3003	BUILDING PLANS & SCHEDULES OF FINISHES	A01	02/07/2020	ISSUED FOR REFERENCE	DSR	SJM	MMJ	AG	

RESERVED FOR VENDOR LOGO AND DRAWING NUMBER

LARSEN & TOUBRO

This drawing is the property of LARSEN & TOUBRO and must not be passed on to any person or body not authorized by us to receive it nor be copied or otherwise made use either in full or in part by such person or body without our prior permission in writing.

Outotec

The content of these documents are the sole property of Outotec Oyj. Any rights not expressly granted herein are reserved. Reproduction, transfer or distribution of part or all of the contents in any form without prior written permission of Outotec is prohibited.

MA'ADEN معادن
Saudi Arabian Mining Company شركة معادن العربية السعودية

This document and the information contained herein is Ma'aden proprietary know-how. This document or any part thereof should not be reproduced, stored in a retrieval system or transmitted by any means, electronic or otherwise, or divulged without prior written permission of Ma'aden.

LARSEN & TOUBRO DRAWING NUMBER: 019045_501_C_G_24024__002 — REVISION: 2
OUTOTEC DRAWING NUMBER: 900707__GAU01__AN03__MTL01__40064 — DOCUMENT ID: OU100687709 — REVISION: 2

DRAWN	DSR	22/06/2020
CHECKED	SJM	30/06/2020
ENGINEER	MMJ	20/06/2020
APPROVED	AG	02/07/2020
EMPLOYER		
SCALE	1:300,25	A1

MANSOURAH - MASSARAH GOLD PROJECT
GENERAL ARRANGEMENT
PROCESS PLANT- WAREHOUSE & WORKSHOP
LAYOUT AND DETAIL OF ANCHOR BOLT

DRAWING NUMBER: MD-216-4000-EG-CV-GAD-1059 — REV: D01