


DRAWING NUMBER MD-216-4000-EG-CV-GAD-1060 REV D01

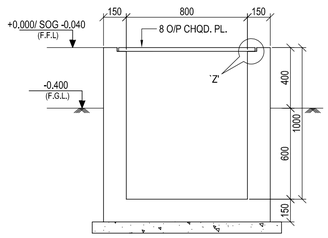


SECTION X-X
TYP. SECTION OF CABLE TRENCH
800(W)x1000(D)
(SCALE 1:20)

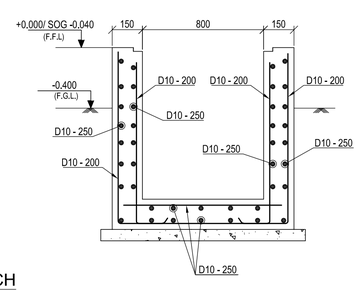


SECTION X-X
RC DETAILS OF CABLE TRENCH
800(W)x1000(D)
(SCALE 1:20)

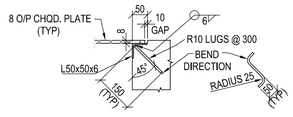


DETAIL - Z
(SCALE 1:10)

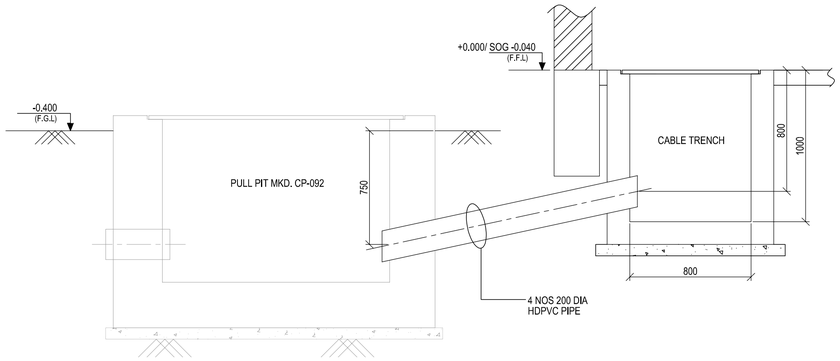


SECTION Y-Y
(SCALE 1:20)

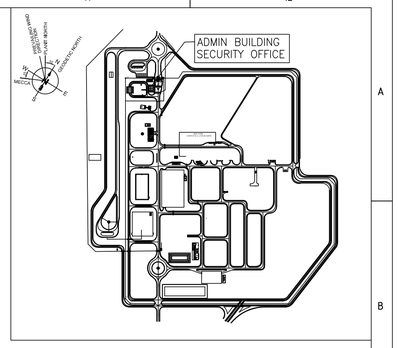


KEY PLAN

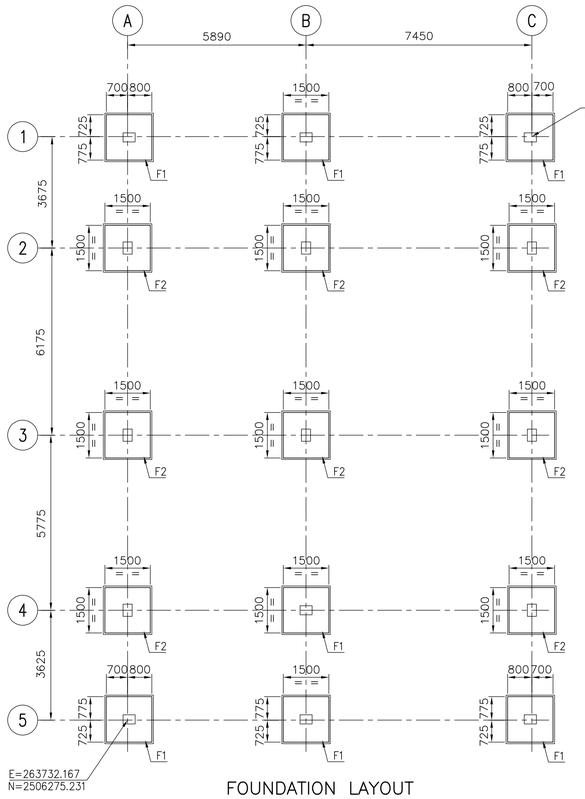

FOUNDATION LAYOUT
SCALE 1:100

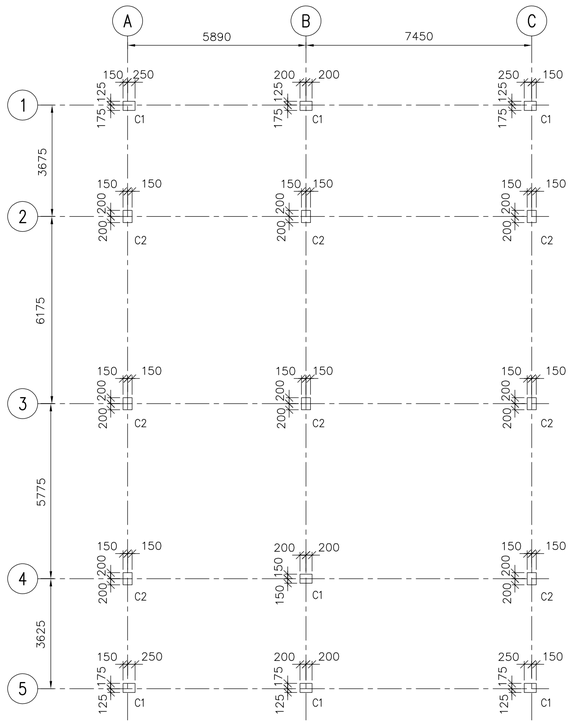

COLUMN LAYOUT
SCALE 1:100

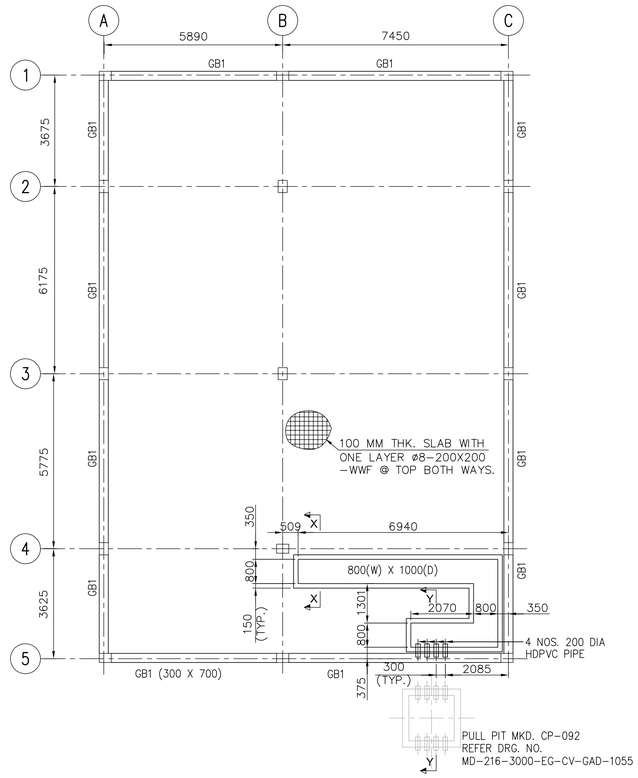

GRADE BEAM LAYOUT
SCALE 1:100

LEGENDS

F/FDN.–FOUNDATION
CR–COLUMN NECK
C/COL.–COLUMN
FFL–FINISH FLOOR LEVEL
FGL–FINISH GROUND LEVEL
TOS–TOP OF SCREED
WWF–WELDED WIRE FABRIC
HCS–HOLLOW CORE SLAB
GB–GRADE BEAM
IJ–ISOLATION JOINT
CJ–CONTROL JOINT
BW's–BOTH WAYS
S.O.G–SLAB ON GRADE
ARCH–ARCHITECTURAL
HOR.–HORIZONTAL
REINF.–REINFORCEMENT
LVL.–LEVEL
RL.–REDUCED LEVEL
P.–PEDESTAL
℄ –CENTRE LINE
BLDG.–BUILDING
DOC. –DOCUMENT
ø –DIAMETER
ADMIN–ADMINISTRATIVE
(W)– WIDTH
(D)– DEPTH
CHQD.– CHEQUERED
PL.– PLATE

NOTES

1. ALL DIMENSIONS ARE GIVEN IN MILLIMETRES AND ELEVATIONS ARE IN METRES UNLESS OTHERWISE NOTED.
2. MINIMUM REINFORCED CONCRETE GRADE TO BE USED FOR SUPERSTRUCTURE & SUBSTRUCTURES IS C35(5000 PSI).
3. MINIMUM LEAN CONCRETE GRADE TO BE USED FOR THE SUB-STRUCTURES IS C15(2175 PSI).
4. ALL REINFORCING STEEL SHALL BE DEFORMED BILLET STEEL BARS CONFORMING TO ASTM-A615, WITH MINIMUM YIELD STRENGTH OF FY420 MPA .
5. THE NET SOIL BEARING CAPACITY CONSIDERED IN FOUNDATION DESIGN IS 570 KPA (REFER DOCUMENT 216-3000-EG-CV-RPT-1008)
6. WATER PROOFING INSULATION SHALL BE AS PER PROJECT SPECIFICATIONS & ITS MATERIAL TO BE APPROVED BY SITE ENGINEER.
7. MINIMUM CONCRETE COVER AS PER SBC-304-2018(TABLE 20.6.1.3.1) MEASURED FROM REBAR SHALL BE
   a. CONCRETE CAST AGAINST & PERMANENTLY EXPOSED TO EARTH (INCLUDING FOUNDATIONS OVER SUB-SLAB) FORMED CONCRETE EXPOSED TO EARTH OR WEATHER.....50MM
   b. CONCRETE NOT EXPOSED TO WEATHER NOR IN CONTACT WITH GROUND
      BEAMS, COLUMNS.....40MM
      SLABS, WALLS, JOISTS.....20MM
   c. CONCRETE SLAB OVER 50MM SUB-SLAB.....20MM
8. ALL DRAWINGS MUST BE READ IN CONJUNCTION WITH RELEVANT ARCHITECTURAL AND ENGINEERING DRAWINGS RELATED TO THE SAME SHEET AND ANY ITEM ON IT.
9. F.F.L +0.00 MENTIONED IS EQUIVALENT TO RL 915.900

DOCUMENT NUMBER	REFERENCE DOCUMENTS			REVISION DESCRIPTION	DRN	CHK	ENG	APP	EMP
		D01	26/05/2023	AS-BUILT	TEC	BJB	TEC	SJM	
		C02	18/12/2021	ISSUED FOR CONSTRUCTION & REVISED AS MARKED C02	TEC	BJB	TEC	SJM	
		C01	09/01/2021	ISSUED FOR CONSTRUCTION & REVISED AS MARKED C01	TEC	BJB	TEC	SJM	
MD-216-3660-EG-CV-GAD-2002	LAYOUT & DETAIL OF FOUNDATION	A01	24/11/2020	ISSUED FOR REFERENCE	TEC	BJB	TEC	SJM	

RESERVED FOR VENDOR LOGO AND DRAWING NUMBER

LARSEN & TOUBRO

This drawing is the property of LARSEN & TOUBRO and must not be passed on to any person or body not authorized by us to receive it nor be copied or otherwise made use either in full or in part by such person or body without our prior permission in writing.

Outotec

The content of these documents are the sole property of Outotec Oyj. Any rights not expressly granted herein are reserved. Reproduction, transfer or distribution of part or all of the contents in any form without prior written permission of Outotec is prohibited.

MA'ADEN معادن
Saudi Arabian Mining Company شركة التعدين العربية السعودية

This document and the information contained herein is Ma'aden proprietary know-how. This document or any part thereof should not be reproduced, stored in a retrieval system or transmitted by any means, electronic or otherwise, or divulged without prior written permission of Ma'aden.

LARSEN & TOUBRO DRAWING NUMBER: 019045_501_C_G_24575_001 — REVISION: 3
OUTOTEC DRAWING NUMBER: 900707__GAU01__AN03__MTL01__40096 — DOCUMENT ID: OU100707195 — REVISION: 3

DRAWN	TEC	23/11/2020
CHECKED	AVG	24/11/2020
ENGINEER	TEC	23/11/2020
APPROVED	SJM	24/11/2020
EMPLOYER		
SCALE 1:40		A1

MANSOURAH - MASSARAH GOLD PROJECT
GENERAL ARRANGEMENT DRAWING
PROCESS AREA - ADMIN BUILDING
LAYOUT OF FDN. COL. GRADE SLAB & GRADE BEAM

DRAWING NUMBER: MD-216-4000-EG-CV-GAD-1060 — REV: D01