


DRAWING NUMBER: MD - 216 - 4000 - EG - CV - GAD - 1061
REV: D01

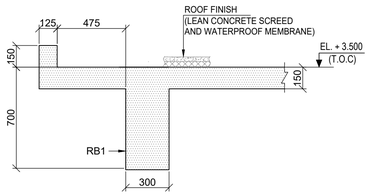


SECTION Z-Z
(SCALE 1:20)

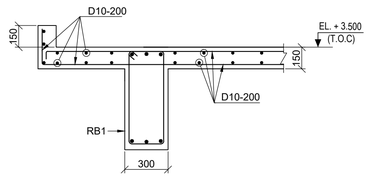


SECTION Z-Z
(SHOWING RC DETAIL)
(SCALE 1:20)

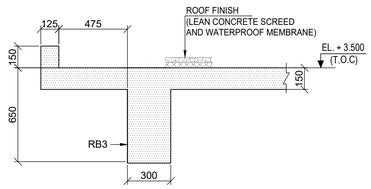


SECTION X-X
(SCALE 1:20)

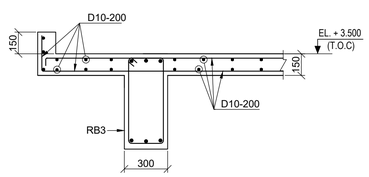


SECTION X-X
(SHOWING RC DETAIL)
(SCALE 1:20)

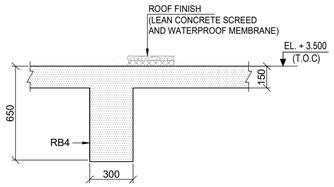


SECTION Y-Y
(SCALE 1:20)

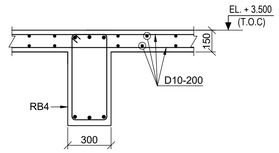


SECTION Y-Y
(SHOWING RC DETAIL)
(SCALE 1:20)

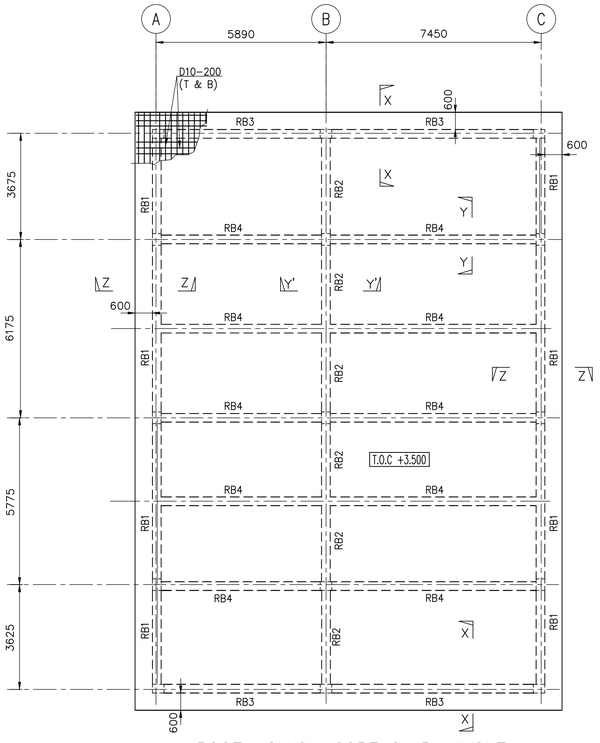

ROOF HOLLOW CORE SLAB LAYOUT
SCALE 1:100

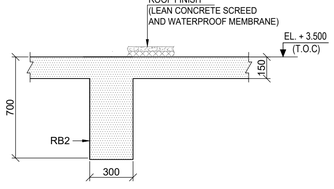


SECTION Y'-Y'
(SCALE 1:20)

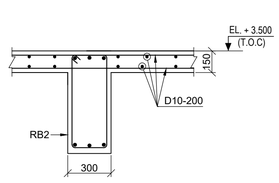

SECTION Y'-Y'
(SHOWING RC DETAIL)
(SCALE 1:20)

BEAM MARK	DIMENSIONS		LEVEL	STEEL REINFORCEMENT				STIRRUPS	REMARKS
				BOTTOM		TOP			
	WIDTH	DEPTH	TOP OF BEAM	STRAIGHT	ADD.	STRAIGHT	ADD.		
RB1	300	700	EL (+) 3.500	3–D20	–	3–D20	–	PROVIDE D10@150 BOTH @ MIDSPAN & THE END SPAN	
RB2	300	700	EL (+) 3.500	3–D25	–	3–D25	–	PROVIDE D10@150 BOTH @ MIDSPAN & THE END SPAN	
RB3	300	650	EL (+) 3.500	3–D20	–	3–D20	–	PROVIDE D10@150 BOTH @ MIDSPAN & THE END SPAN	
RB4	300	650	EL (+) 3.500	3–D25	–	3–D16	–	PROVIDE D10@150 BOTH @ MIDSPAN & THE END SPAN	

NOTE: CONTROL JOINTS SHALL BE PROVIDED AT MAX SPACING OF 20 FT (6.10 M) AS PER ACI CODE

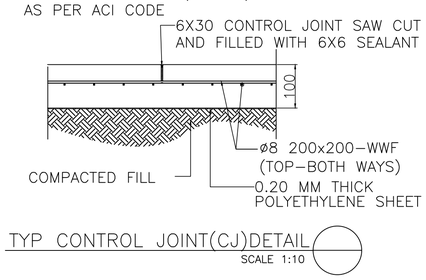

TYP CONTROL JOINT(CJ)DETAIL
SCALE 1:10

LEGENDS

F/FDN.–FOUNDATION
CR–COLUMN NECK
C/COL.–COLUMN
FFL–FINISH FLOOR LEVEL
FGL–FINISH GROUND LEVEL
TOS–TOP OF SCREED
WWF–WELDED WIRE FABRIC
HCS–HOLLOW CORE SLAB
GB–GRADE BEAM
IJ–ISOLATION JOINT
CJ–CONTROL JOINT
BW's–BOTH WAYS
S.O.G–SLAB ON GRADE
ARCH–ARCHITECTURAL
HOR.–HORIZONTAL
REINF.–REINFORCEMENT
LVL.–LEVEL
RL–REDUCED LEVEL
P.–PEDESTAL
℄ –CENTRE LINE
BLDG.–BUILDING
DOC. –DOCUMENT
ø –DIAMETER
ADMIN–ADMINISTRATIVE

NOTES

1. ALL DIMENSIONS ARE GIVEN IN MILLIMETRES AND ELEVATIONS ARE IN METRES UNLESS OTHERWISE NOTED.
2. GRADE OF CONCRETE SHALL BE 35 MPa FOR FOUNDATION & 15 MPa FOR BLINDING CONCRETE.
3. GRADE OF REINFORCEMENT SHALL BE DEFORMED BAR 420 MPa (GRADE 60) – ASTM A615/A615M.
4. ALL DRAWINGS MUST BE READ IN CONJUNCTION WITH RELEVANT ARCHITECTURAL AND ENGINEERING DRAWINGS RELATED TO THE SAME SHEET AND ANY ITEM ON IT.
5. F.F.L +0.00 MENTIONED IS EQUIVALENT TO RL 915.900
6. GENERAL NOTES FOR CIVIL WORKS & STANDARD REINFORCEMENT DETAIL REFER DRAWING NO. MD–216–1000–EG–CV–DED–1001 & 1005.

DOCUMENT NUMBER	REFERENCE DOCUMENTS			REVISION DESCRIPTION	DRN	CHK	ENG	APP	EMP
		D01	22/02/2023	AS-BUILT	SYA	SJM	AVG	AG	
		C02	20/11/2021	ISSUED FOR CONSTRUCTION & REVISED AS MARKED C02	SYA	SJM	AVG	AG	
		C01	06/01/2021	ISSUED FOR CONSTRUCTION	TEC	BJB	TEC	SJM	
MD-216-3660-EG-CV-GAD-2002	LAYOUT & DETAIL OF FOUNDATION	A01	24/11/2020	ISSUED FOR REFERENCE	TEC	BJB	TEC	SJM	

RESERVED FOR VENDOR LOGO AND DRAWING NUMBER

LARSEN & TOUBRO

This drawing is the property of LARSEN & TOUBRO and must not be passed on to any person or body not authorized by us to receive it nor be copied or otherwise made use either in full or in part by such person or body without our prior permission in writing.

Outotec

The content of these documents are the sole property of Outotec Oyj. Any rights not expressly granted herein are reserved. Reproduction, transfer or distribution of part or all of the contents in any form without prior written permission of Outotec is prohibited.

MA'ADEN معادن
Saudi Arabian Mining Company شركة معادن العربية السعودية

This document and the information contained herein is Ma'aden proprietary know-how. This document or any part thereof should not be reproduced, stored in a retrieval system or transmitted by any means, electronic or otherwise, or divulged without prior written permission of Ma'aden.

LARSEN & TOUBRO DRAWING NUMBER: 019045_501_C_G_24575_002 — REVISION: 3
OUTOTEC DRAWING NUMBER: 900707 __GAU01 __AN03__MTL01 __40097 — DOCUMENT ID: OU100707196 — REVISION: 3

DRAWN	TEC	23/11/2020
CHECKED	AVG	24/11/2020
ENGINEER	TEC	23/11/2020
APPROVED	SJM	24/11/2020
EMPLOYER		
SCALE 1:40		A1

MANSOURAH - MASSARAH GOLD PROJECT
GENERAL ARRANGEMENT DRAWING
PROCESS AREA - ADMIN BUILDING
LAYOUT & DETAIL OF ROOF SLAB

DRAWING NUMBER: MD - 216 - 4000 - EG - CV - GAD - 1061 — REV: D01