


DRAWING NUMBER: MD-216-4000-EG-CV-GAD-1068 | REV: D01

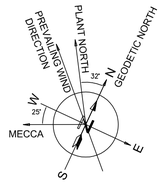


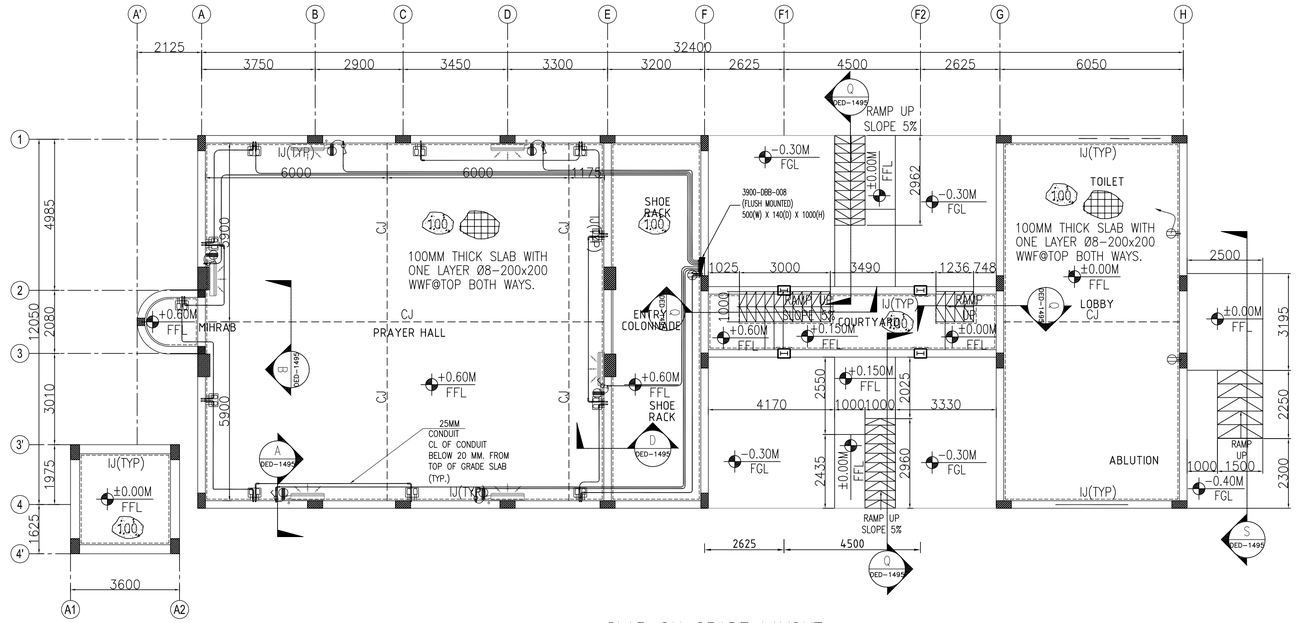


SLAB ON GRADE LAYOUT
SCALE 1:100

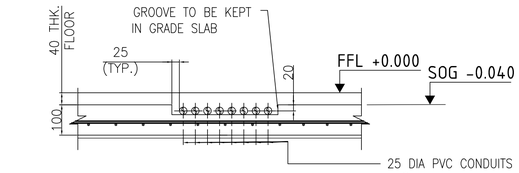

TYP. GROOVE DETAILS OF GRADE SLAB FOR CONDUITS
SCALE 1:10

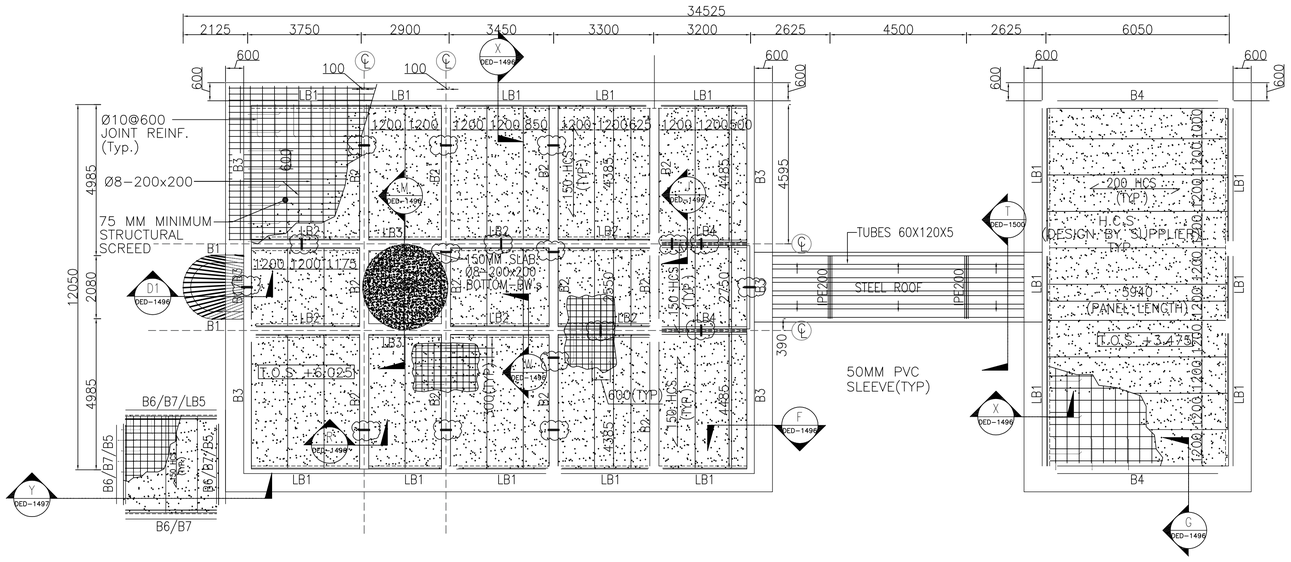

ROOF HOLLOW CORE SLAB LAYOUT
SCALE 1:100

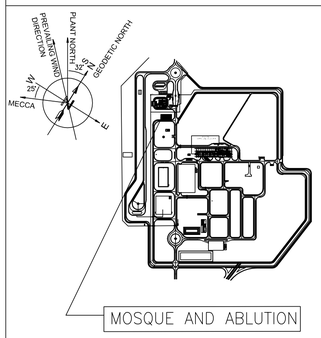

NOTES

1.) ALL DIMENSIONS ARE GIVEN IN MILLIMETRES AND ELEVATIONS ARE IN METRES UNLESS OTHERWISE NOTED.
2.) MINIMUM REINFORCED CONCRETE GRADE TO BE USED FOR SUPERSTRUCTURE & SUBSTRUCTURES IS M35(5000 PSI).
3.) MINIMUM LEAN CONCRETE GRADE TO BE USED FOR THE SUB-STRUCTURES IS M15(2175 PSI).
4.) ALL REINFORCING STEEL SHALL BE DEFORMED BILLET STEEL BARS CONFORMING TO ASTM-A615, WITH MINIMUM YIELD STRENGTH OF FY420 MPA .
5.) THE NET SOIL BEARING CAPACITY CONSIDERED IN FOUNDATION DESIGN IS 570 KPA(REFER DOC 216-3000-EG-CV-RPT-1008)
6.) WATER PROOFING INSULATION SHALL BE AS PER PROJECT SPECIFICATIONS & ITS MATERIAL TO BE APPROVED BY SITE ENGINEER.
7.) MINIMUM CONCRETE COVER AS PER SBC-304-2018(TABLE 20.6.1.3.1) MEASURED FROM REBAR SHALL BE
   a) CONCRETE CAST AGAINST & PERMANENTLY EXPOSED TO EARTH (INCLUDING FOUNDATIONS OVER SUB-SLAB) FORMED CONCRETE EXPOSED TO EARTH OR WEATHER.....50MM
   b.) CONCRETE NOT EXPOSED TO WEATHER NOR IN CONTACT WITH GROUND
   BEAMS, COLUMNS.....40MM
   SLABS, WALLS, JOISTS.....20MM
   c.) CONCRETE SLAB OVER 50MM SUB-SLAB.....20MM
8.) ALL DRAWINGS MUST BE READ IN CONJUNCTION WITH RELEVANT ARCHITECTURAL AND ENGINEERING DRAWINGS RELATED TO THE SAME SHEET AND ANY ITEM ON IT.
9.) F.F.L +0.00 MENTIONED IS EQUIVALENT TO RL 915.400 AS PER THE CIVIL DRAWING MD-216-1000-EG-ME-PPD-1002.

LEGENDS
F-FOUNDATION
CR-COLUMN NECK
C-COLUMN
FFL-FINISH FLOOR LVL
FGL-FINISH GROUND LVL
TOS-TOP OF SCREED
WWF-WELDED WIRE FABRIC
HCS-HOLLOW CORE SLAB
GB-GRADE BEAM
IJ-ISOLATION JOINT
CJ-CONTROL JOINT
BW's-BOTH WAYS
S.O.G-SLAB ON GRADE
ARCH-ARCHITECTURAL
HOR.-HORIZONTAL
REINF.-REINFORCEMENT
LVL.-LEVEL
RL.-REDUCED LEVEL
P.-PEDESTAL
℄-CENTRE LINE OF ROOF BEAMS

DOCUMENT NUMBER	REFERENCE DOCUMENTS	REV	DATE	REVISION DESCRIPTION	DRN	CHK	ENG	APP	EMP
MD-216-4000-EG-CV-DED-1071	DETAILS OF MINARETE & MIHRAB								
MD-216-4000-EG-CV-DED-1073	DETAILS OF WALKWAY SHED & ROOF DOME								
MD-216-4000-EG-CV-DED-1070	DETAILS OF ROOF BEAMS & GRADE SLAB								
MD-216-4000-EG-CV-DED-1069	DETAILS OF FDN, COL. & GRADE BEAM								
MD-216-4000-EG-CV-DED-1067	LAYOUT OF FDN, COL. & GRADE BEAM								
MD-216-4000-EG-AR-GAD-3018	BUILDING ELEVATIONS & SECTIONS								
MD-216-6000-EG-CV-STD-1002	HOLLOW CORE SLAB STANDARD	D01	26/05/2023	AS-BUILT	--	AVG	--	SJM	
MD-216-6000-EG-CV-STD-1001	REINFORCEMENT STANDARD	C02	11/08/2021	ISSUED FOR CONSTRUCTION & REVISED AS MARKED /C02	--	AVG	--	SJM	
MD-216-4000-EG-AR-GAD-3017	BUILDING PLANS	C01	13/06/2020	ISSUED FOR CONSTRUCTION	--	AVG	--	SJM	
MD-216-1000-EG-ME-PPD-1002	GENERAL PROCESS PLANT LAYOUT	A01	16/05/2020	ISSUED FOR APPROVAL	--	AVG	--	SJM	

DESIGNER: مكتب الخليج للاستشارات الهندسية — GULF CONSULT ARCHITECTS AND ENGINEERS

DRAWING NUMBER					REVISION
MOSQ-ABLU-ST-002					0
DATE	10/05/2020	DATE	12/05/2020	DATE	13/05/2020
DRAWN	MAH	CHECKED	MF	APPROVED	FK

LARSEN & TOUBRO DRAWING NUMBER: 019045_900_C_G_24029_002 — REVISION: 3
OUTOTEC DRAWING NUMBER: 900707__GAU01__AN03__MTL01__60021 — DOCUMENT ID: OU100665613 — REVISION: 3

DRAWN	--	--
CHECKED	AVG	15/05/2020
ENGINEER	--	--
APPROVED	SJM	16/05/2020
EMPLOYER		
SCALE	1:100	A1

MANSOURAH - MASSARAH GOLD PROJECT
GENERAL ARRANGEMENT DRAWING
PROCESS PLANT: MOSQUE AND ABLUTION
LAYOUT OF ROOF & GRADE SLAB

DRAWING NUMBER: MD-216-4000-EG-CV-GAD-1068 — REV: D01

LARSEN & TOUBRO
This drawing is the property of LARSEN & TOUBRO and must not be passed on to any person or body not authorized by us to receive it nor be copied or otherwise made use either in full or in part by such person or body without our prior permission in writing.

Outotec
The content of these documents are the sole property of Outotec Oyj. Any rights not expressly granted herein are reserved. Reproduction, transfer or distribution of part or all of the contents in any form without prior written permission of Outotec is prohibited.

MA'ADEN معادن
Saudi Arabian Mining Company شركة التعدين العربية السعودية
This document and the information contained herein is Ma'aden proprietary know-how. This document or any part thereof should not be reproduced, stored in a retrieval system or transmitted by any means, electronic or otherwise, or divulged without prior written permission of Ma'aden.