


DRAWING NUMBER: MD-216-4000-EG-CV-GAD-1071 | REV: D01

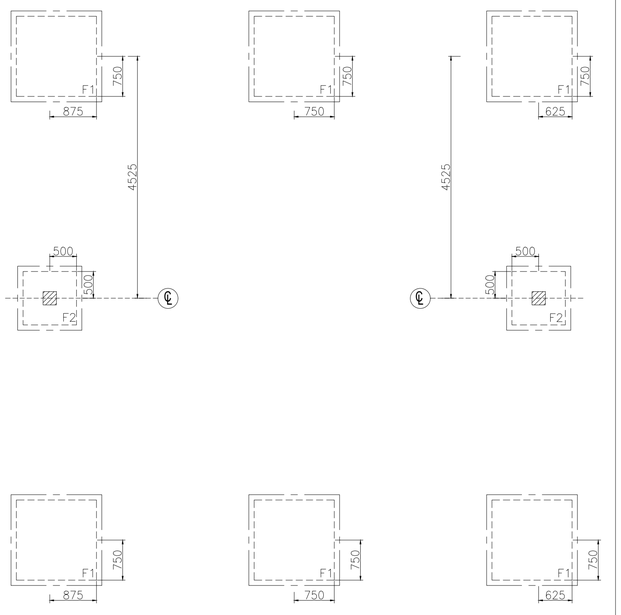

FOUNDATION LAYOUT
SCALE 1:50

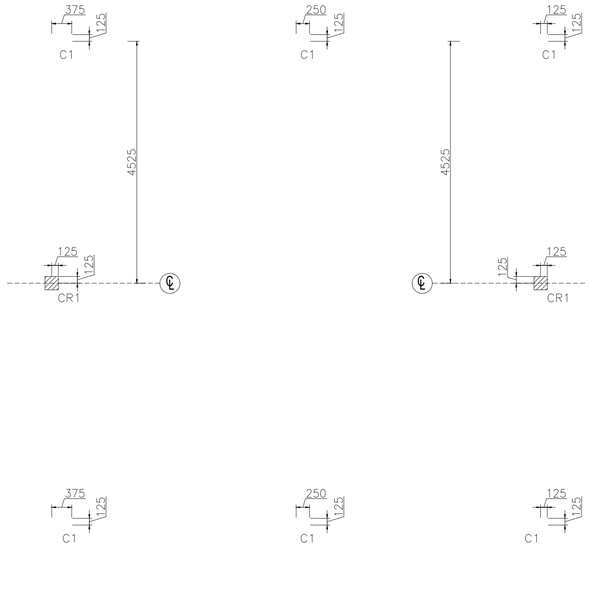


COLUMN LAYOUT
SCALE 1:50

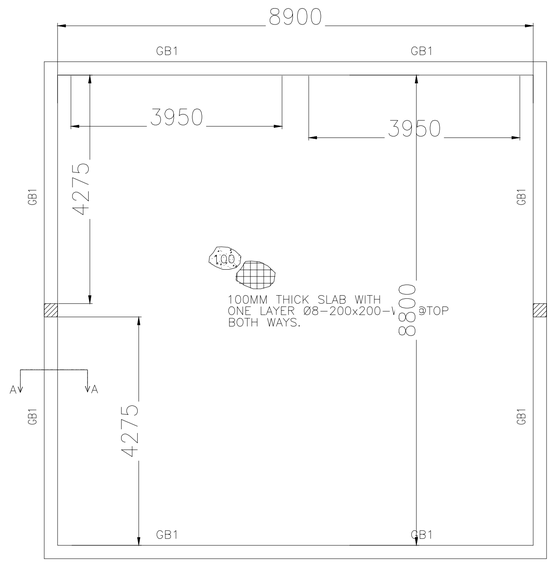


GRADE BEAM LAYOUT
SCALE 1:50

MASTER KEY PLAN

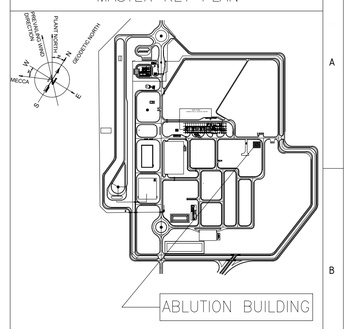

ABLUTION BUILDING ENLARGED KEYPLAN

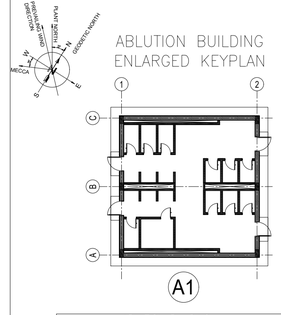


ABLUTION BUILDING			
BLDG NO.	CORNER NO.	EASTING	NORTHING
A1	A1	E 264224.555	N 2506246.372
	C2	E 264227.381	N 2506258.927

NOTES

1. ALL DIMENSIONS ARE GIVEN IN MILLIMETRES AND ELEVATIONS ARE IN METRES UNLESS OTHERWISE NOTED.
2. MINIMUM REINFORCED CONCRETE GRADE TO BE USED FOR SUPERSTRUCTURE & SUBSTRUCTURES IS M35(5000 PSI).
3. MINIMUM LEAN CONCRETE GRADE TO BE USED FOR THE SUB-STRUCTURES IS M15(2175 PSI).
4. ALL REINFORCING STEEL SHALL BE DEFORMED BILLET STEEL BARS CONFORMING TO ASTM-A615, WITH MINIMUM YIELD STRENGTHOF FY420 MPA .
5. THE NET SOIL BEARING CAPACITY CONSIDERED IN FOUNDATION DESIGN IS 570 KPA(REFER DOC NO-216-3000-EG-CV-CAL-1008-A02)
6. WATER PROOFING INSULATION SHALL BE AS PER PROJECT SPECIFICATIONS & ITS MATERIAL TO BE APPROVED BY SITE ENGINEER.
7. MINIMUM CONCRETE COVER AS PER SBC-304-2018(TABLE 20.6.1.3.1) MEASURED FROM REBAR SHALL BE
   a. CONCRETE CAST AGAINST & PERMANENTLY EXPOSED TO EARTH (INCLUDING FOUNDATIONS OVER SUB-SLAB) FORMED CONCRETE EXPOSED TO EARTH OR WEATHER.....50MM
   b. CONCRETE NOT EXPOSED TO WEATHER NOR IN CONTACT WITH GROUND
      BEAMS, COLUMNS.....40MM
      SLABS, WALLS, JOISTS.....20MM
   c. CONCRETE SLAB OVER 50MM SUB-SLAB.....20MM
8. ALL DRAWINGS MUST BE READ IN CONJUNCTION WITH RELEVANT ARCHITECTURAL AND ENGINEERING DRAWINGS RELATED TO THE SAME SHEET AND ANY ITEM ON IT.
9. F.F.L +0.000 MENTIONED IS EQUIVALENT TO RL 913.400

LEGENDS
F-FOUNDATION
CR-COLUMN NECK
C-COLUMN
FFL-FINISH FLOOR LVL
FGL-FINISH GRADE LVL
TOS-TOP OF SCREED
WWF-WELDED WIRE FABRIC
HCS-HOLLOW CORE SLAB
GB-GRADE BEAM
U-ISOLATION JOINT
CJ-CONTROL JOINT
GA-GALVANIZED
S.O.G-SLAB ON GRADE
ARCH-ARCHITECTURAL
HOR.-HORIZONTAL
REINF.-REINFORCEMENT
LVL.-LEVEL
RL.-REDUCED LEVEL

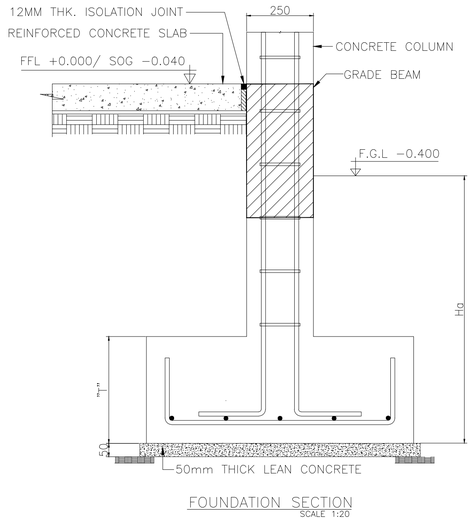


FOUNDATION SECTION
SCALE 1:20

SCHEDULE OF FOOTINGS

FOOTING MARK	PLAIN CONCRETE			REINFORCED CONCRETE			BOTTOM REINFORCEMENT		TOP REINFORCEMENT		Ha	REMARKS
	L	W	T	L	W	T	SHORT BARS	LONG BARS	SHORT BARS	LONG BARS		
F1	1700	1700	50	1500	1500	400	ø12@150	ø12@150	–	–	1200	
F2	1200	1200	50	1000	1000	400	ø12@150	ø12@150	–	–	1200	

SCHEDULE OF GRADE BEAMS

BEAM MARK	DIMENSIONS		STEEL REINFORCEMENT				STIRRUPS
			BOTTOM		TOP		
	WIDTH	DEPTH	STRAIGHT	ADD.	STRAIGHT	ADD.	
GB1	250	500	3ø16	–	3ø16	–	PROVIDE ø10@200 AT MID SPAN & ø10@150@END SPAN

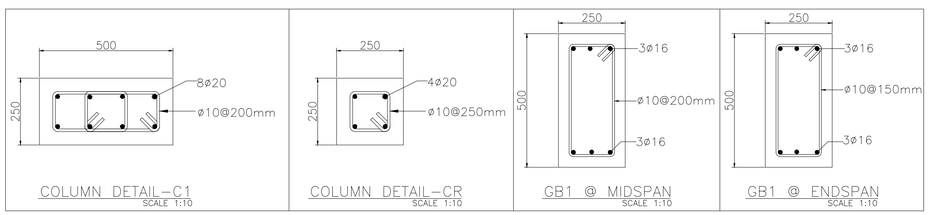


COLUMN DETAIL-C1
SCALE 1:10


COLUMN DETAIL-CR
SCALE 1:10

GB1 @ MIDSPAN
SCALE 1:10

GB1 @ ENDSPAN
SCALE 1:10

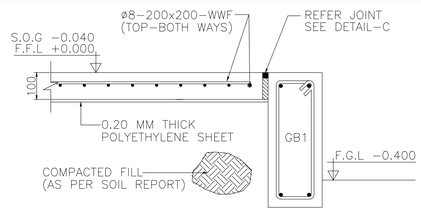

TYPICAL SECTION-A FOR GRADE SLAB
SCALE 1:10

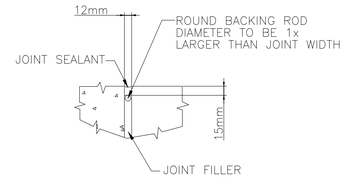

TYPICAL JOINT SEAL DETAIL-C
NTS

DOCUMENT NUMBER	REFERENCE DOCUMENTS	REV	DATE	REVISION DESCRIPTION	DRN	CHK	ENG	APP	EMP
MD-216-4000-EG-AR-GAD-3026	BUILDING SECTIONS, DOORS & FINISH SCHEDULES	D01	22/02/2023	AS-BUILT	--	AVG	--	SJM	
MD-216-6000-EG-CV-STD-1002	HOLLOW CORE SLAB STANDARD	C02	05/07/2020	ISSUED FOR CONSTRUCTION-REVISED AS MARKED	--	AVG	--	SJM	
MD-216-6000-EG-CV-STD-1001	REINFORCEMENT STANDARD	C01	15/06/2020	ISSUED FOR CONSTRUCTION	--	AVG	--	SJM	
MD-216-4000-EG-AR-GAD-3025	BUILDING PLANS & ELEVATIONS	A01	11/05/2020	ISSUED FOR APPROVAL	--	AVG	--	SJM	

DESIGNER: مكتب الخليج للاستشارات الهندسية المحدودة المملكة العربية السعودية — GULF CONSULT ARCHITECTS AND ENGINEERS

LARSEN & TOUBRO
This drawing is the property of LARSEN & TOUBRO and must not be passed on to any person or body not authorized by us to receive it nor be copied or otherwise made use either in full or in part by such person or body without our prior permission in writing.

Outotec
The content of these documents are the sole property of Outotec Oyj. Any rights not expressly granted herein are reserved. Reproduction, transfer or distribution of part or all of the contents in any form without prior written permission of Outotec is prohibited.

MA'ADEN معادن
Saudi Arabian Mining Company شركة معادن العربية السعودية
This document and the information contained herein is Ma'aden proprietary know-how. This document or any part thereof should not be reproduced, stored in a retrieval system or transmitted by any means, electronic or otherwise, or divulged without prior written permission of Ma'aden.

DRAWN	--	--	MANSOURAH - MASSARAH GOLD PROJECT
CHECKED	AVG	10/05/2020	GENERAL ARRANGEMENT
ENGINEER	--	--	PROCESS PLANT-ABLUTION BUILDING
APPROVED	SJM	11/05/2020	LAYOUT & DETAILS OF FDN, COL & GRADE BEAM
EMPLOYER			
SCALE	1:50	A1	DRAWING NUMBER: MD-216-4000-EG-CV-GAD-1071 REV: D01

DRAWING NUMBER	NON-ABL-ST-001	REVISION	0
DATE / DRAWN	07/05/2020 / MAH	DATE / CHECKED	08/05/2020 / MF
DATE / APPROVED	09/05/2020 / FK		
LARSEN & TOUBRO DRAWING NUMBER	O19045_900_C_G_24032_001	REVISION	3
OUTOTEC DRAWING NUMBER	900707__GAU01__AN03__MTL01__40060	DOCUMENT ID / REVISION	OU100684461 / 3