


DRAWING NUMBER: MD-216-4000-EG-CV-GAD-1074
REV: D01

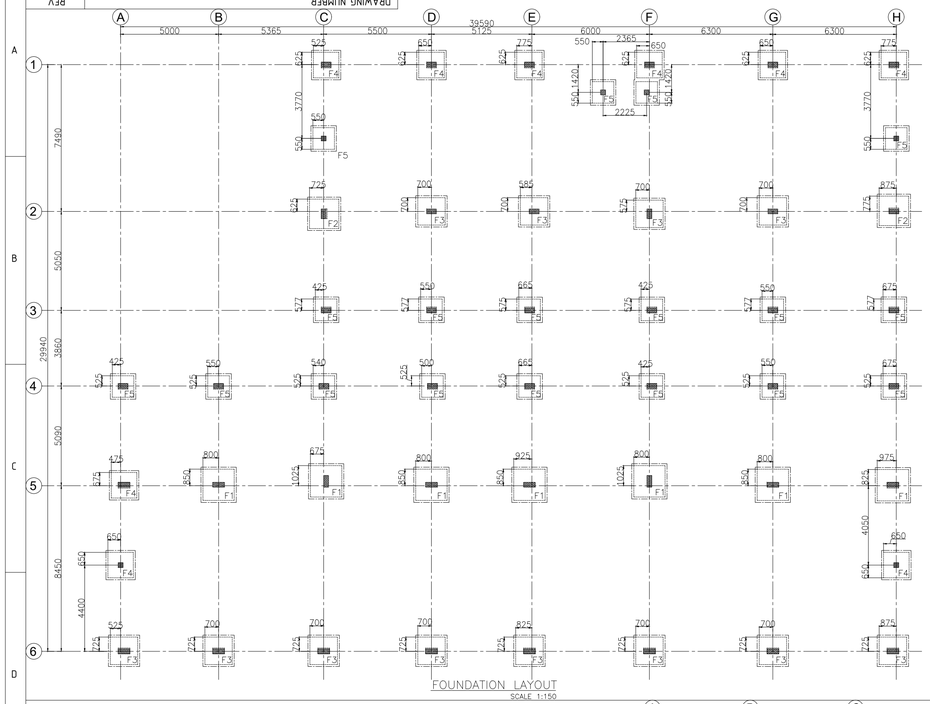


FOUNDATION LAYOUT
SCALE 1:150

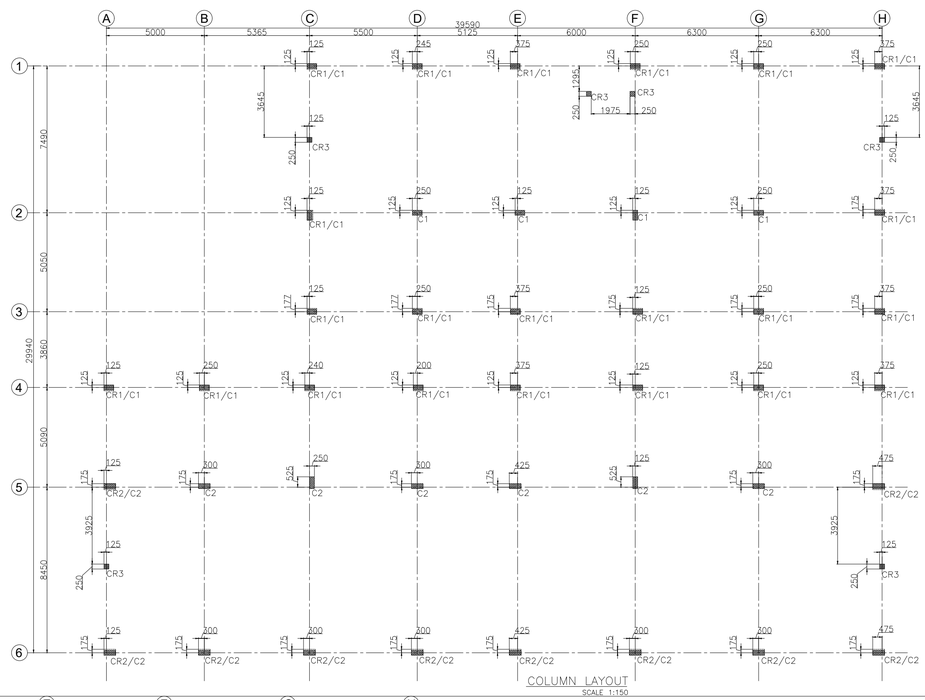



COLUMN LAYOUT
SCALE 1:150

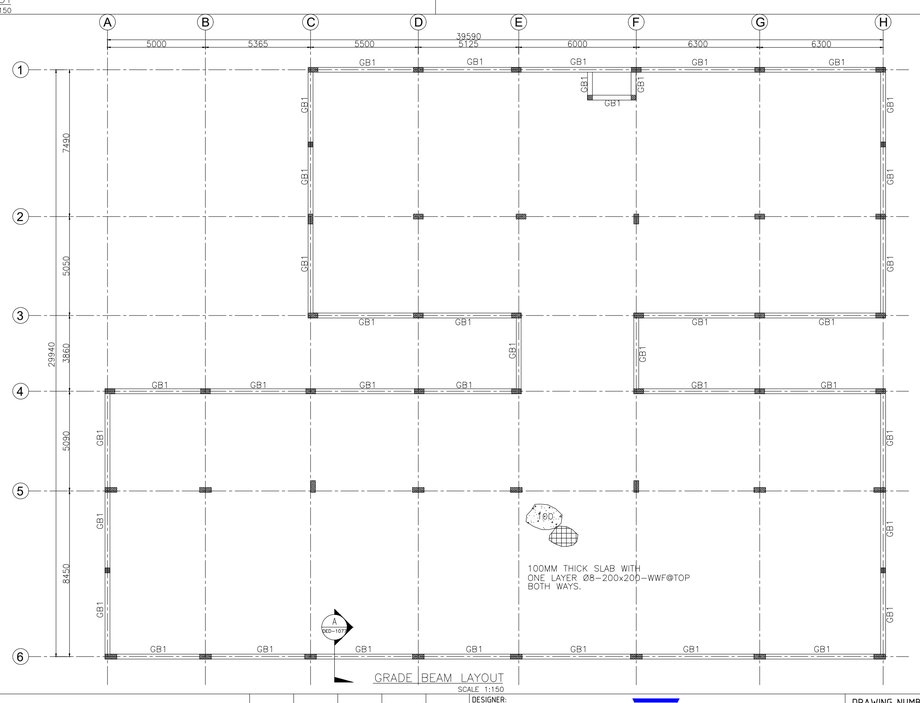


GRADE BEAM LAYOUT
SCALE 1:150

## MASTER KEY PLAN

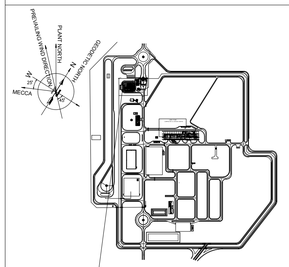


ADMINISTRATION BUILDING
ENLARGED KEYPLAN




| ADMINISTRATION BUILDING | | | |
|---|---|---|---|
| BLDG. NO. | CORNER NO. | EASTING | NORTHING |
| A1 | C1 | E 263686.267 | N 2506269.552 |
| | H1 | E 263711.052 | N 2506285.039 |
| | A6 | E 263693.343 | N 2506238.669 |
| | H6 | E 263726.917 | N 2506259.648 |

## NOTES

1.) ALL DIMENSIONS ARE GIVEN IN MILLIMETRES AND ELEVATIONS ARE IN METRES UNLESS OTHERWISE NOTED.
2.) MINIMUM REINFORCED CONCRETE GRADE TO BE USED FOR SUPERSTRUCTURE & SUBSTRUCTURES IS M35(5000 PSI).
3.) MINIMUM LEAN CONCRETE GRADE TO BE USED FOR THE SUB-STRUCTURES IS M15(2175 PSI).
4.) ALL REINFORCING STEEL SHALL BE DEFORMED BILLET STEEL BARS CONFORMING TO ASTM-A615, WITH MINIMUM YIELD STRENGTHOF FY420 MPA .
5.) THE NET SOIL BEARING CAPACITY CONSIDERED IN FOUNDATION DESIGN IS 570 KPA(REFER DOC '216-3000-EG-CV-CAL-1008-A02
6.) WATER PROOFING INSULATION SHALL BE AS PER PROJECT SPECIFICATIONS & ITS MATERIAL TO BE APPROVED BY ENGINEER@SITE.
7.) MINIMUM CONCRETE COVER AS PER SBC-304-2018(TABLE 20.6.1.3.1) MEASURED FROM REBAR SHALL BE
   a) CONCRETE CAST AGAINST & PERMANENTLY EXPOSED TO EARTH (INCLUDING FOUNDATIONS OVER SUB-SLAB) FORMED CONCRETE EXPOSED TO EARTH OR WEATHER.....50MM
   b.) CONCRETE NOT EXPOSED TO WEATHER NOR IN CONTACT WITH GROUND
   BEAMS, COLUMNS.....40MM
   SLABS, WALLS, JOISTS.....20MM
   c.) CONCRETE SLAB OVER 50MM SUB-SLAB.....20MM
8.) ALL DRAWINGS MUST BE READ IN CONJUNCTION WITH RELEVANT ARCHITECTURAL AND ENGINEERING DRAWINGS RELATED TO THE SAME SHEET AND ANY ITEM ON IT.
9.) F.F.L +0.00 MENTIONED IS EQUIVALENT TO RL 915.900 AS PER THE CIVIL DRAWING MD-216-1000-EG-ME-PPD-1002.

LEGENDS
F-FOUNDATION
CR-COLUMN NECK
C-COLUMN
FFL-FINISH FLOOR LVL
FGL-FINISH GRADE LVL
TOS-TOP OF SCREED
WWF-WELDED WIRE FABRIC
HCS-HOLLOW CORE SLAB
GB-GRADE BEAM
U-ISOLATION JOINT
CJ-CONTROL JOINT
GA-GALVANIZED
S.O.G-SLAB ON GRADE
ARCH-ARCHITECTURAL
HOR.-HORIZONTAL
REINF.-REINFORCEMENT
LVL.-LEVEL
RL.-REDUCED LEVEL

| REFERENCE DOCUMENTS | | REV | DATE | REVISION DESCRIPTION | DRN | CHK | ENG | APP | EMP |
|---|---|---|---|---|---|---|---|---|---|
| MD-216-6000-EG-CV-STD-1002 | HOLLOW CORE SLAB STANDARD | D01 | 22/02/2023 | AS-BUILT | -- | AVG | -- | SJM | |
| MD-216-6000-EG-CV-STD-1001 | REINFORCEMENT STANDARD | C01 | 10/04/2020 | ISSUED FOR CONSTRUCTION | -- | AVG | -- | SJM | |
| MD-216-4000-EG-AR-GAD-1075 | BUILDING PLANS | A01 | 26/02/2020 | ISSUED FOR APPROVAL | -- | AVG | -- | SJM | |

DESIGNER: مكتب الخليج للاستشارات الهندسية الغير، المملكة العربية السعودية — GULF CONSULT ARCHITECTS AND ENGINEERS

| DRAWING NUMBER | REVISION |
|---|---|
| NON-ADMIN-ST-001 | 0 |

| DATE | 22/02/2020 | DATE | 23/02/2020 | DATE | 24/02/2020 |
|---|---|---|---|---|---|
| DRAWN | MAH | CHECKED | MF | APPROVED | FK |

| LARSEN & TOUBRO DRAWING NUMBER | REVISION |
|---|---|
| 019045_900_C_G_24035_001 | 2 |

| OUTOTEC DRAWING NUMBER | DOCUMENT ID | REVISION |
|---|---|---|
| 900707__GAU01__AN03__MTL01__60056 | OU100665649 | 2 |

LARSEN & TOUBRO
This drawing is the property of LARSEN & TOUBRO and must not be passed on to any person or body not authorized by us to receive it nor be copied or otherwise made use either in full or in part by such person or body without our prior permission in writing.

Outotec
The content of these documents are the sole property of Outotec Oyj. Any rights not expressly granted herein are reserved. Reproduction, transfer or distribution of part or all of the contents in any form without prior written permission of Outotec is prohibited.

MA'ADEN معادن
Saudi Arabian Mining Company شركة التعدين العربية السعودية
This document and the information contained herein is Ma'aden proprietary know-how. This document or any part thereof should not be reproduced, stored in a retrieval system or transmitted by any means, electronic or otherwise, or divulged without prior written permission of Ma'aden.

| | | |
|---|---|---|
| DRAWN | -- | -- |
| CHECKED | AVG | 25/02/2020 |
| ENGINEER | -- | -- |
| APPROVED | SJM | 26/02/2020 |
| EMPLOYER | | |
| SCALE | 1:150 | A1 |

MANSOURAH - MASSARAH GOLD PROJECT
GENERAL ARRANGEMENT DRAWING
PROCESS AREA-ADMINISTRATION BUILDING
LAYOUT OF FDN, COL & GRADE BEAM

| DRAWING NUMBER | REV |
|---|---|
| MD-216-4000-EG-CV-GAD-1074 | D01 |