


DRAWING NUMBER: MD-216-4000-EG-CV-GAD-1078
REV: D01

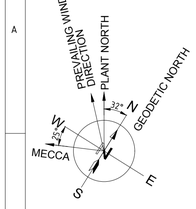


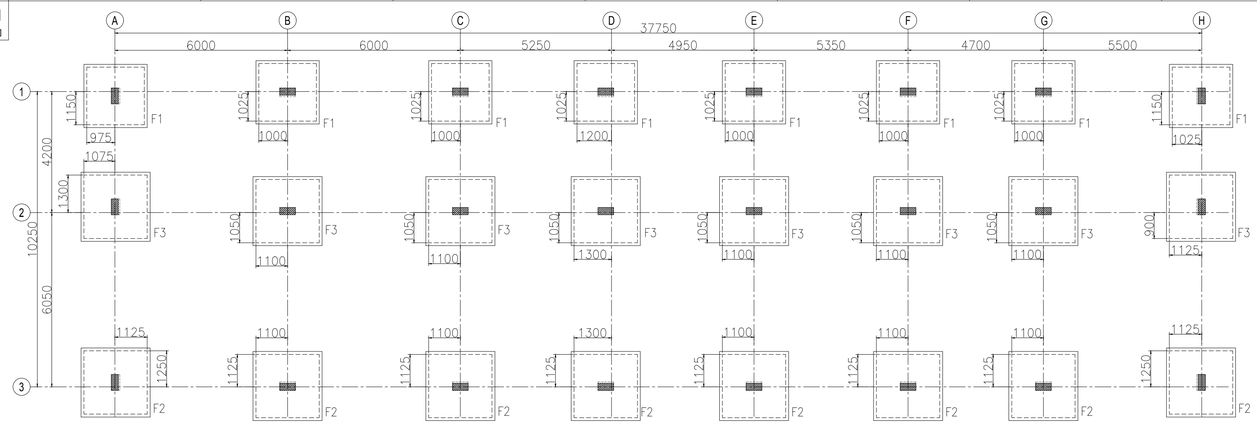

FOUNDATION LAYOUT
SCALE 1:100

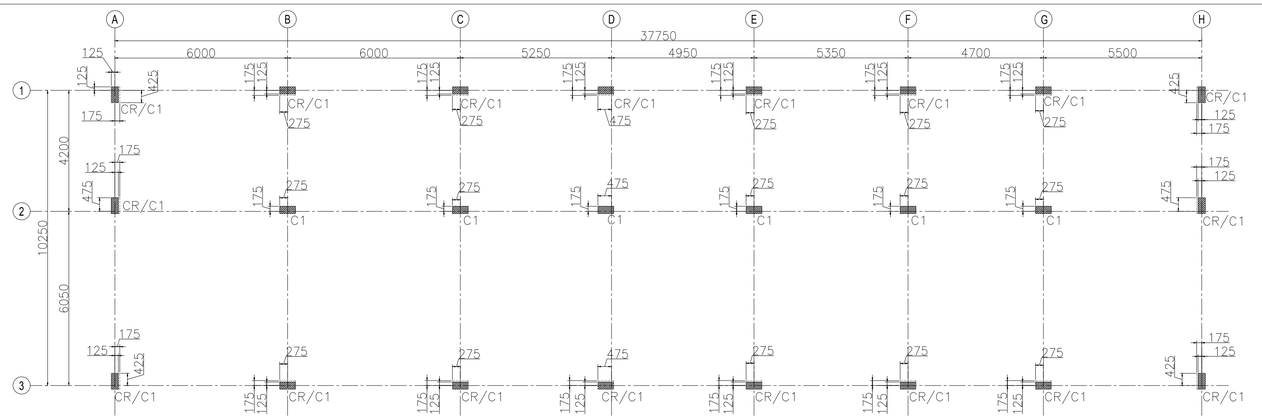


COLUMN LAYOUT
SCALE 1:100

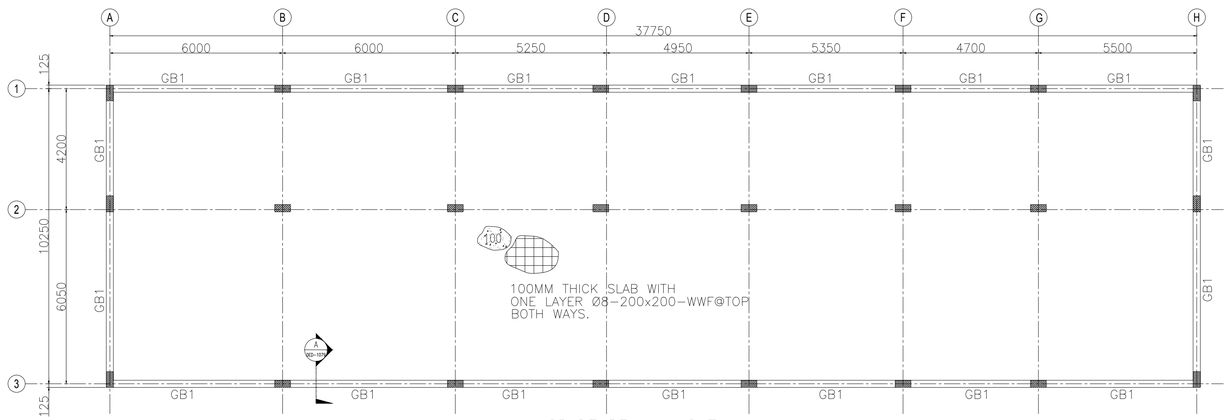


GRADE BEAM LAYOUT
SCALE 1:100

MASTER KEY PLAN

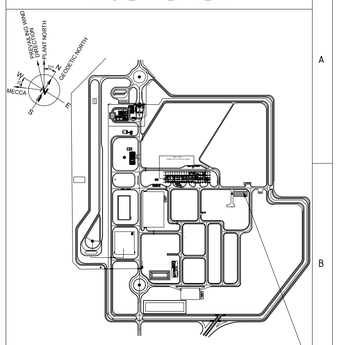

PROCESS PLANT-ENGINEERING OFFICE CUM CCR

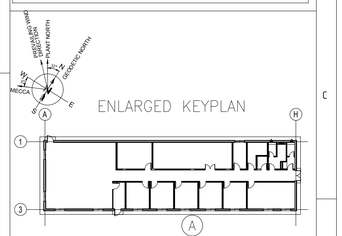

ENGINEERING OFFICE CUM CCR BUILDING			
BLDG. NO.	CORNER NO.	EASTING	NORTHING
A	A-1	E264187.923	N2506251.496
	H-3	E264225.369	N2506262.808

NOTES

1.) ALL DIMENSIONS ARE GIVEN IN MILLIMETRES AND ELEVATIONS ARE IN METRES UNLESS OTHERWISE NOTED.
2.) MINIMUM REINFORCED CONCRETE GRADE TO BE USED FOR SUPERSTRUCTURE & SUBSTRUCTURES IS C35(5000 PSI).
3.) MINIMUM LEAN CONCRETE GRADE TO BE USED FOR THE SUB-STRUCTURES IS C15(2175 PSI).
4.) ALL REINFORCING STEEL SHALL BE DEFORMED BILLET STEEL BARS CONFORMING TO ASTM-A615, WITH MINIMUM YIELD STRENGTH OF FY420 MPA .
5.) THE NET SOIL BEARING CAPACITY CONSIDERED IN FOUNDATION DESIGN IS 570 KPA(REFER DOC 216-3000-EG-CV-RPT-1008)
6.) WATER PROOFING INSULATION SHALL BE AS PER PROJECT SPECIFICATIONS & ITS MATERIAL TO BE APPROVED BY SITE ENGINEER.
7.) MINIMUM CONCRETE COVER AS PER SBC-304-2018(TABLE 20.6.1.3.1) MEASURED FROM REBAR SHALL BE
   a) CONCRETE CAST AGAINST & PERMANENTLY EXPOSED TO EARTH (INCLUDING FOUNDATIONS OVER SUB-SLAB) FORMED CONCRETE EXPOSED TO EARTH OR WEATHER.....50MM
   b.) CONCRETE NOT EXPOSED TO WEATHER NOR IN CONTACT WITH GROUND
      BEAMS, COLUMNS.....40MM
      SLABS, WALLS, JOISTS.....20MM
   c.) CONCRETE SLAB OVER 50MM SUB-SLAB.....20MM
8.) ALL DRAWINGS MUST BE READ IN CONJUNCTION WITH RELEVANT ARCHITECTURAL AND ENGINEERING DRAWINGS RELATED TO THE SAME SHEET AND ANY ITEM ON IT.
9.) F.F.L +0.00 MENTIONED IS EQUIVALENT TO RL 913.400

LEGENDS
F/FDN.-FOUNDATION
CR-COLUMN NECK
C/COL.-COLUMN
FFL-FINISH FLOOR LVL
FGL-FINISH GROUND LVL
TOS-TOP OF SCREED
WWF-WELDED WIRE FABRIC
HCS-HOLLOW CORE SLAB
GB-GRADE BEAM
IJ-ISOLATION JOINT
CJ-CONTROL JOINT
BW's-BOTH WAYS
S.O.G-SLAB ON GRADE
ARCH-ARCHITECTURAL
HOR.-HORIZONTAL
REINF.-REINFORCEMENT
LVL.-LEVEL
RL.-REDUCED LEVEL
P.-PEDESTAL
Q.-CENTRE LINE OF COLUMN

DOCUMENT NUMBER	REFERENCE DOCUMENTS	REV	DATE	REVISION DESCRIPTION	DRN	CHK	ENG	APP	EMP
MD-216-4000-EG-AR-GAD-3040	BUILDING ELEVATIONS & SECTIONS	D01	26/05/2023	AS-BUILT	--	AVG	--	SJM	
MD-216-4000-EG-AR-GAD-3039	BUILDING PLANS	C01	06/07/2020	ISSUED FOR CONSTRUCTION	--	AVG	--	SJM	
MD-216-6000-EG-CV-GAD-1535	OVERALL LAYOUT PLAN	A01	10/06/2020	ISSUED FOR APPROVAL	--	AVG	--	SJM	

DESIGNER: مكتب الخليج للاستشارات الهندسية
العبر، المملكة العربية السعودية
GULF CONSULT
ARCHITECTS AND ENGINEERS

DRAWING NUMBER					REVISION
ST-NON-ENGINEERING OFFICE-ST-001					0
DATE	02/06/2020	DATE	03/06/2020	DATE	04/06/2020
DRAWN	MAH	CHECKED	MF	APPROVED	FK

LARSEN & TOUBRO DRAWING NUMBER: 019045_900_C_G_24038_001 — REVISION: 2
OUTOTEC DRAWING NUMBER: 900707 _GAU01 _AN03_MTL01_ 40050 — DOCUMENT ID: OU100683337 — REVISION: 2

LARSEN & TOUBRO
This drawing is the property of LARSEN & TOUBRO and must not be passed on to any person or body not authorized by us to receive it nor be copied or otherwise made use either in full or in part by such person or body without our prior permission in writing.

Outotec
The content of these documents are the sole property of Outotec Oyj. Any rights not expressly granted herein are reserved. Reproduction, transfer or distribution of part or all of the contents in any form without prior written permission of Outotec is prohibited.

MA'ADEN معادن
Saudi Arabian Mining Company شركة معادن العربية السعودية
This document and the information contained herein is Ma'aden proprietary know-how. This document or any part thereof should not be reproduced, stored in a retrieval system or transmitted by any means, electronic or otherwise, or divulged without prior written permission of Ma'aden.

DRAWN	--	--	
CHECKED	AVG	09/06/2020	
ENGINEER	--	--	
APPROVED	SJM	10/06/2020	
EMPLOYER			
SCALE	1:100	A1	

MANSOURAH - MASSARAH GOLD PROJECT
GENERAL ARRANGEMENT DRAWING
PROCESS PLANT-ENGINEERING OFFICE CUM CCR
LAYOUT OF FDN. COL. & GRADE BEAM

DRAWING NUMBER: MD-216-4000-EG-CV-GAD-1078 — REV: D01