DRAWING NUMBER	REV
MD-216-49W1-EG-CV-DED-1018	D01

DETAIL OF PEDESTAL MKD. P25, P26, P27 & P28
(SCALE 1:25)

(49W1-PMP-047, 49W1-PMP-048, 49W1-PMP-037 & 49W1-PMP-038)

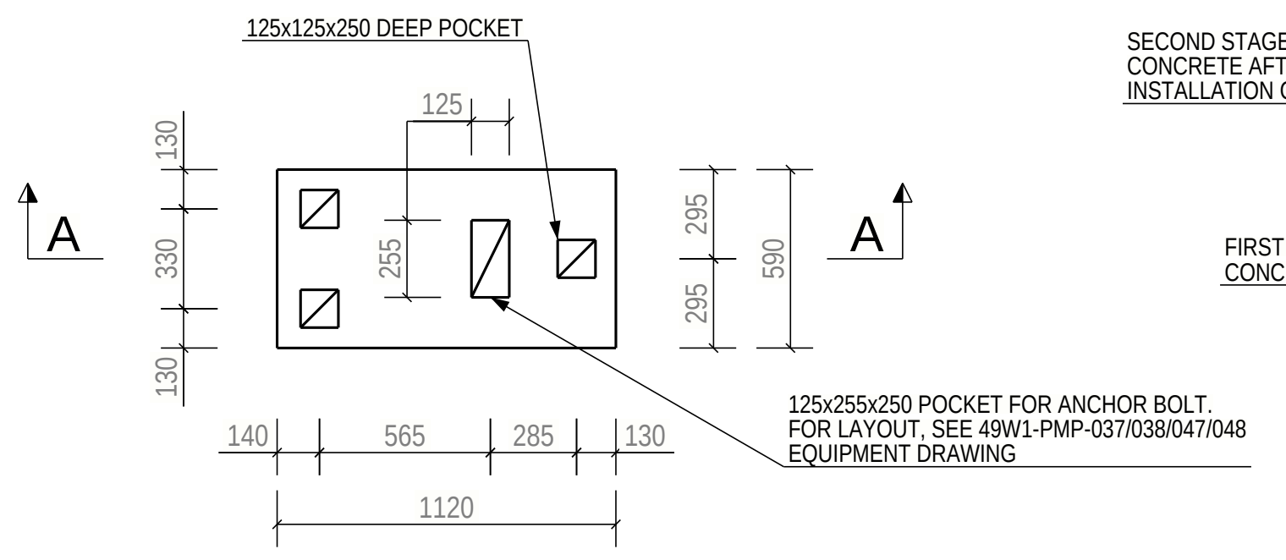
125x125x250 DEEP POCKET
A
A
125
1120
140
565
285
130
125x255x250 POCKET FOR ANCHOR BOLT.
FOR LAYOUT, SEE 49W1-PMP-037/038/047/048
EQUIPMENT DRAWING

SECTION : A - A
(SCALE 1:25)

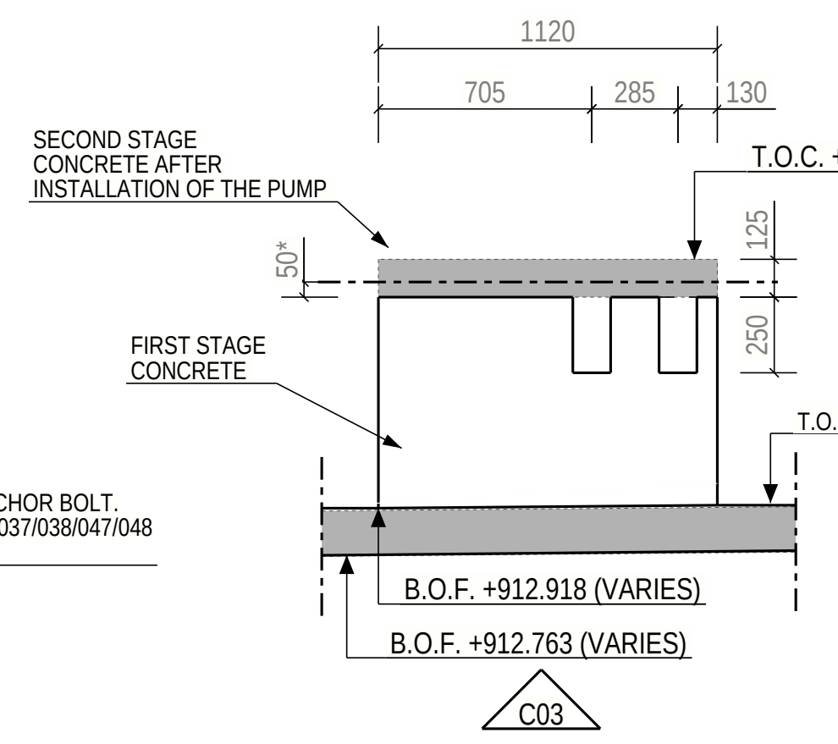

SECTION : A - A
(SCALE 1:25)

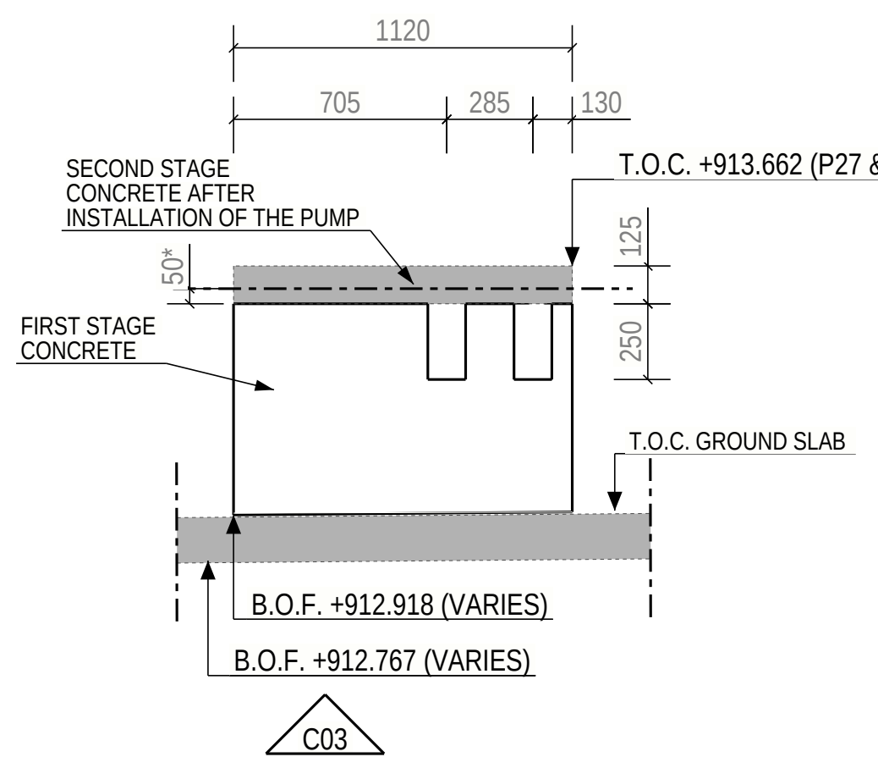

R.C.C. DETAIL OF PEDESTAL MKD. P25, P26, P27 & P28
(SCALE 1:25)

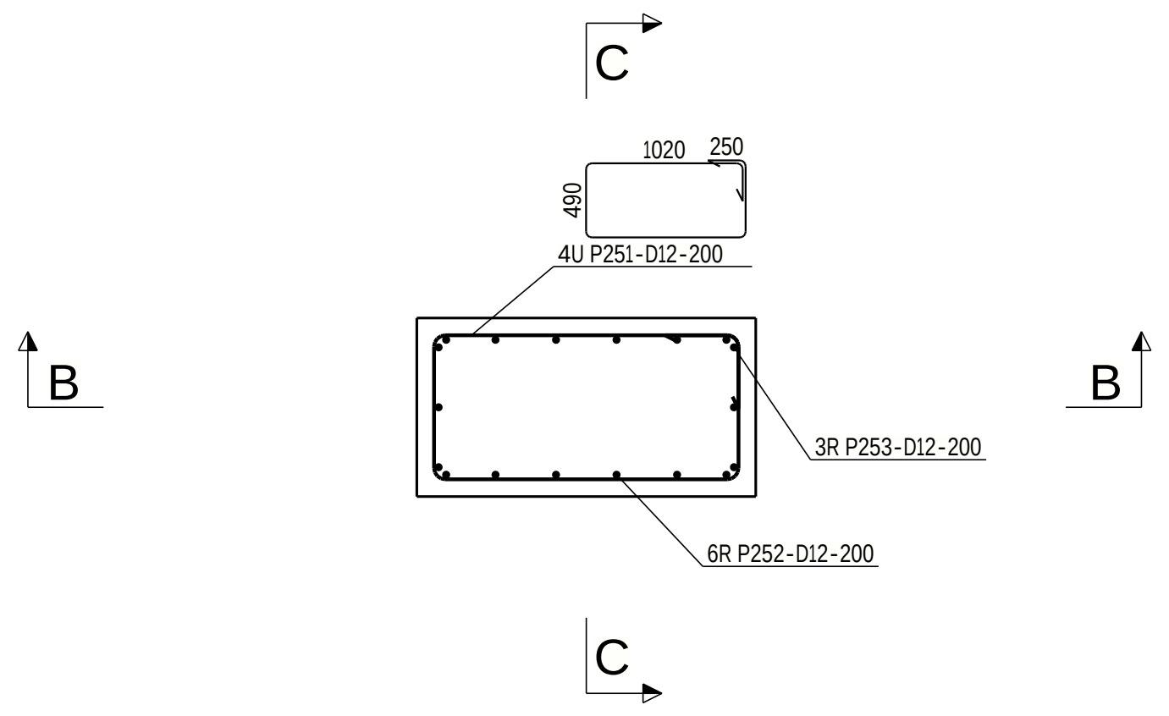

SECTION : B - B
(SCALE 1:25)

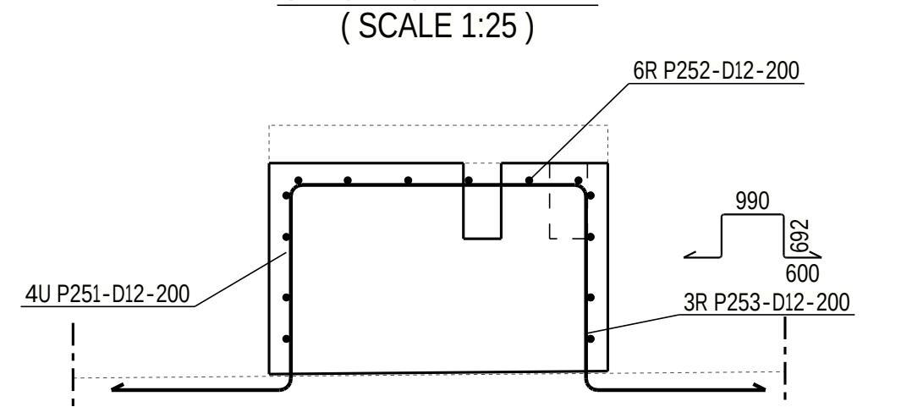

SECTION : C - C
(SCALE 1:25)

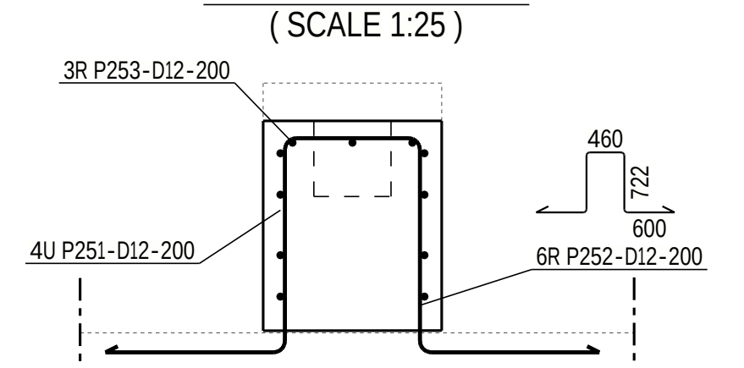

DETAIL OF PEDESTAL MKD. P29 & P30
(SCALE 1:25)

(49W1-PMP-035 &49W1-PMP-036)

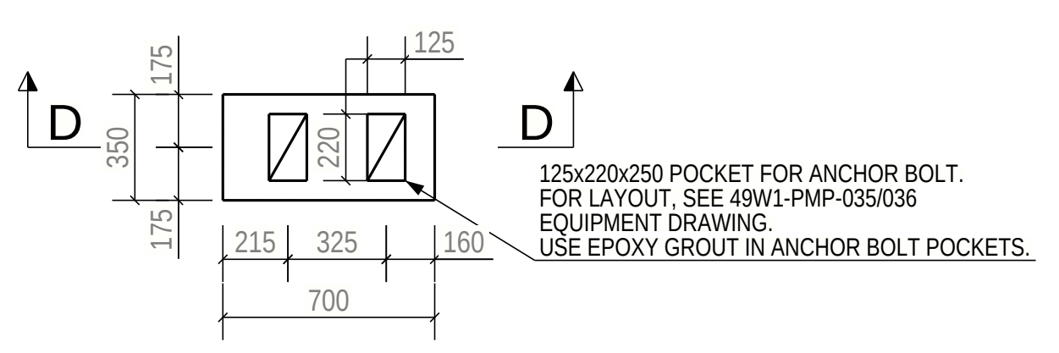
D
D
125
215
325
160
700
125x220x250 POCKET FOR ANCHOR BOLT.
FOR LAYOUT, SEE 49W1-PMP-035/036
EQUIPMENT DRAWING.
USE EPOXY GROUT IN ANCHOR BOLT POCKETS.

SECTION : D - D
(SCALE 1:25)

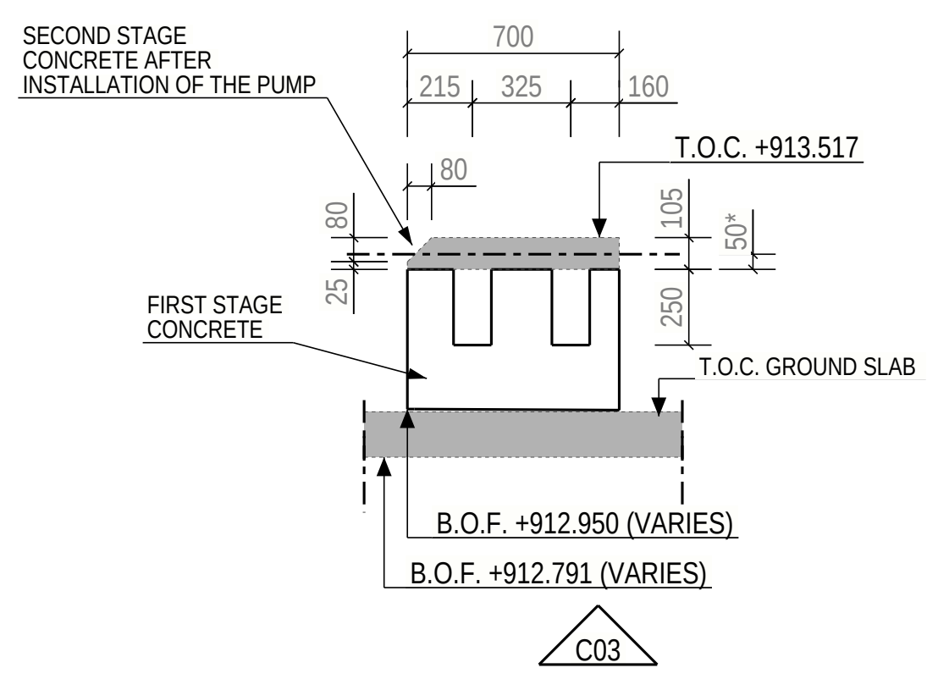

R.C.C. DETAIL OF PEDESTAL MKD. P29 & P30
(SCALE 1:25)

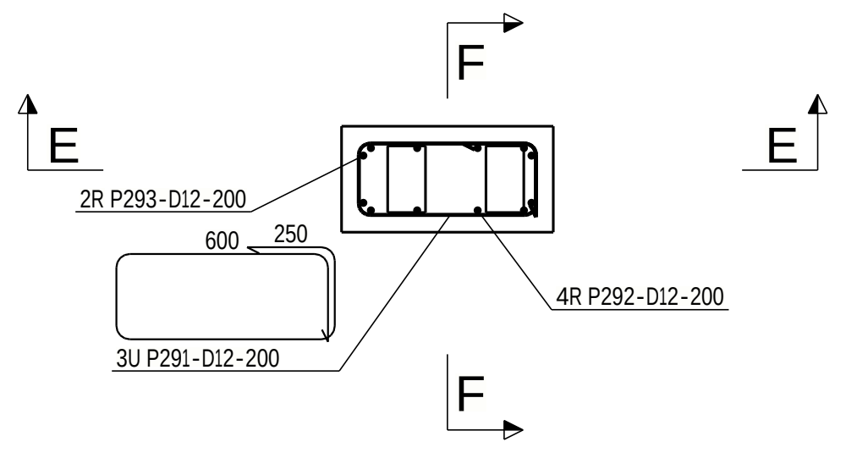

SECTION : E - E
(SCALE 1:25)

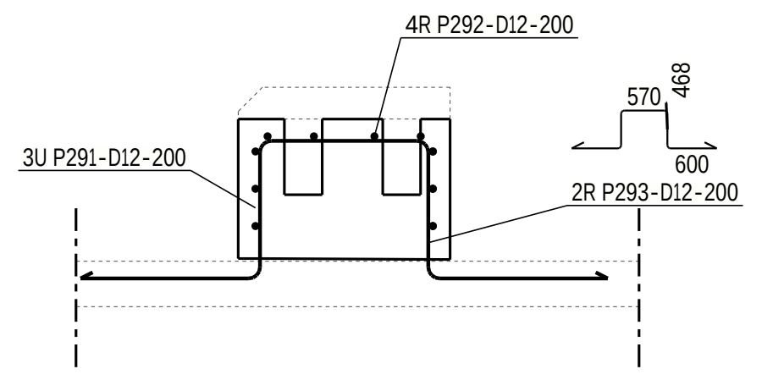

SECTION : F - F
(SCALE 1:25)

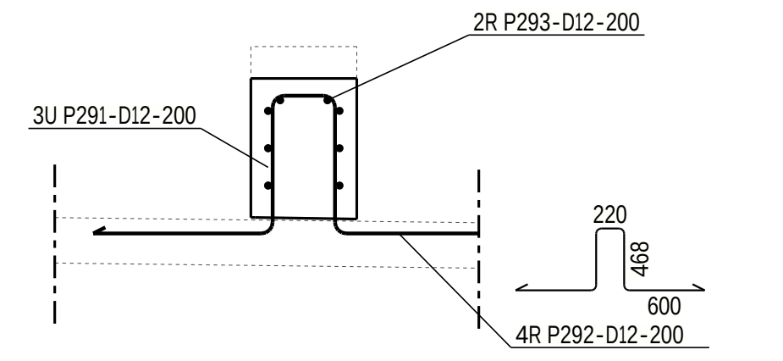

SECTION : H - H
(SCALE 1:25)

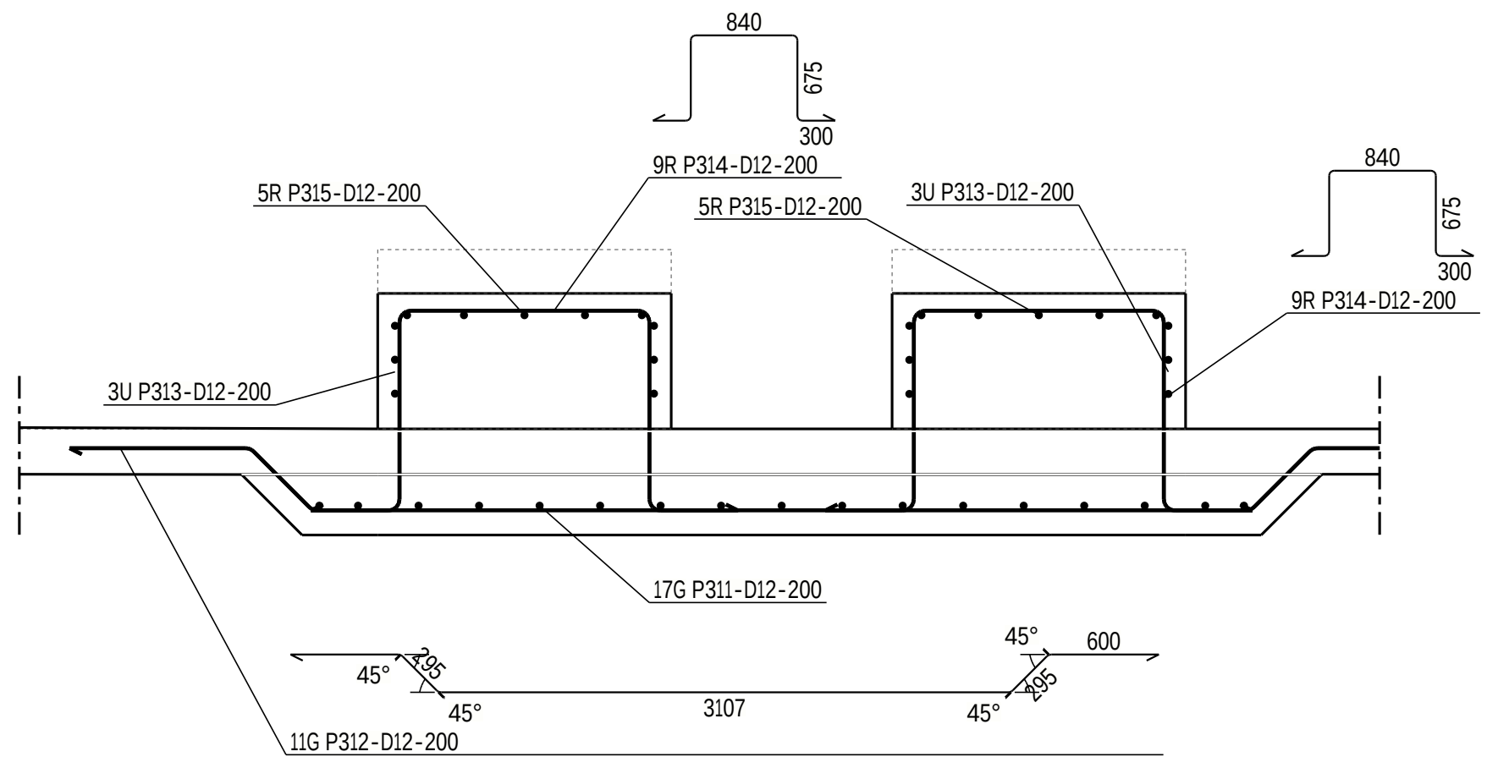

SECTION : I - I
(SCALE 1:25)

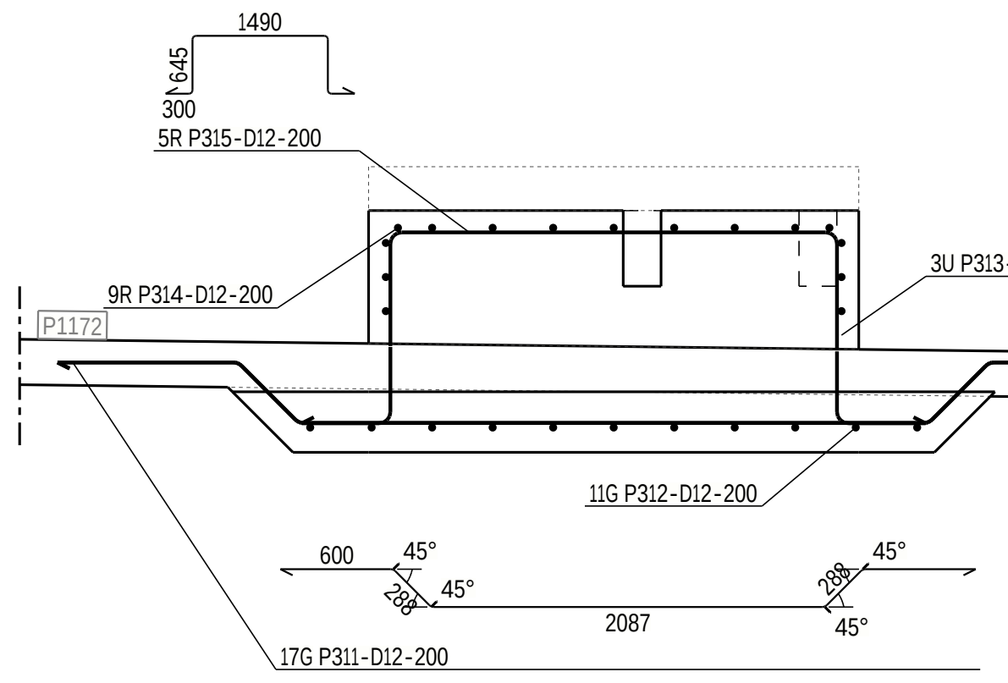

DETAIL OF PEDESTAL MKD. P31
(SCALE 1:25)

(49W1-PMP-033 & 49W1-PMP-034)

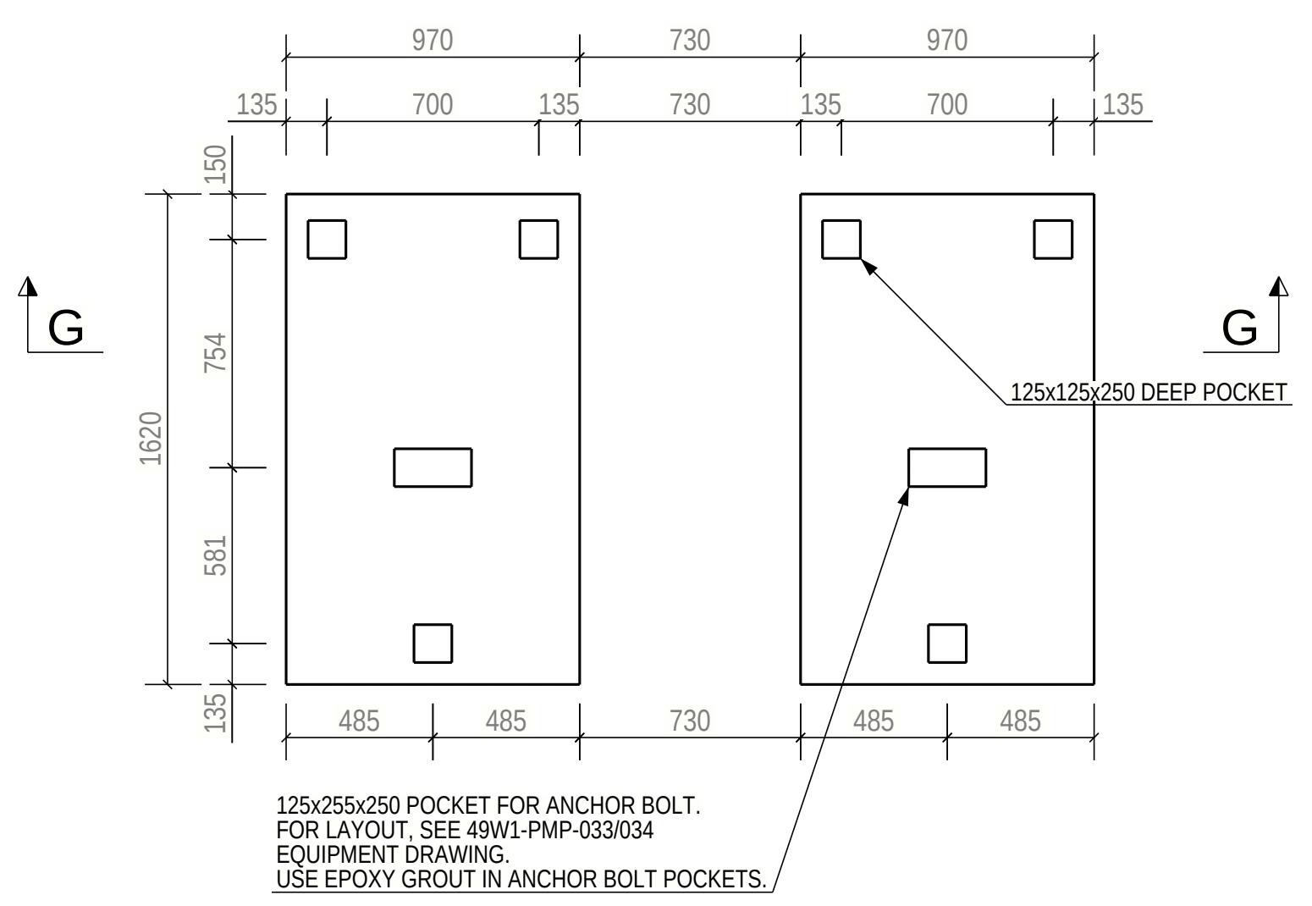
970
730
970
135
700
G
G
125x125x250 DEEP POCKET
1620
485
125x255x250 POCKET FOR ANCHOR BOLT.
FOR LAYOUT, SEE 49W1-PMP-033/034
EQUIPMENT DRAWING.
USE EPOXY GROUT IN ANCHOR BOLT POCKETS.

SECTION : G - G
(SCALE 1:25)

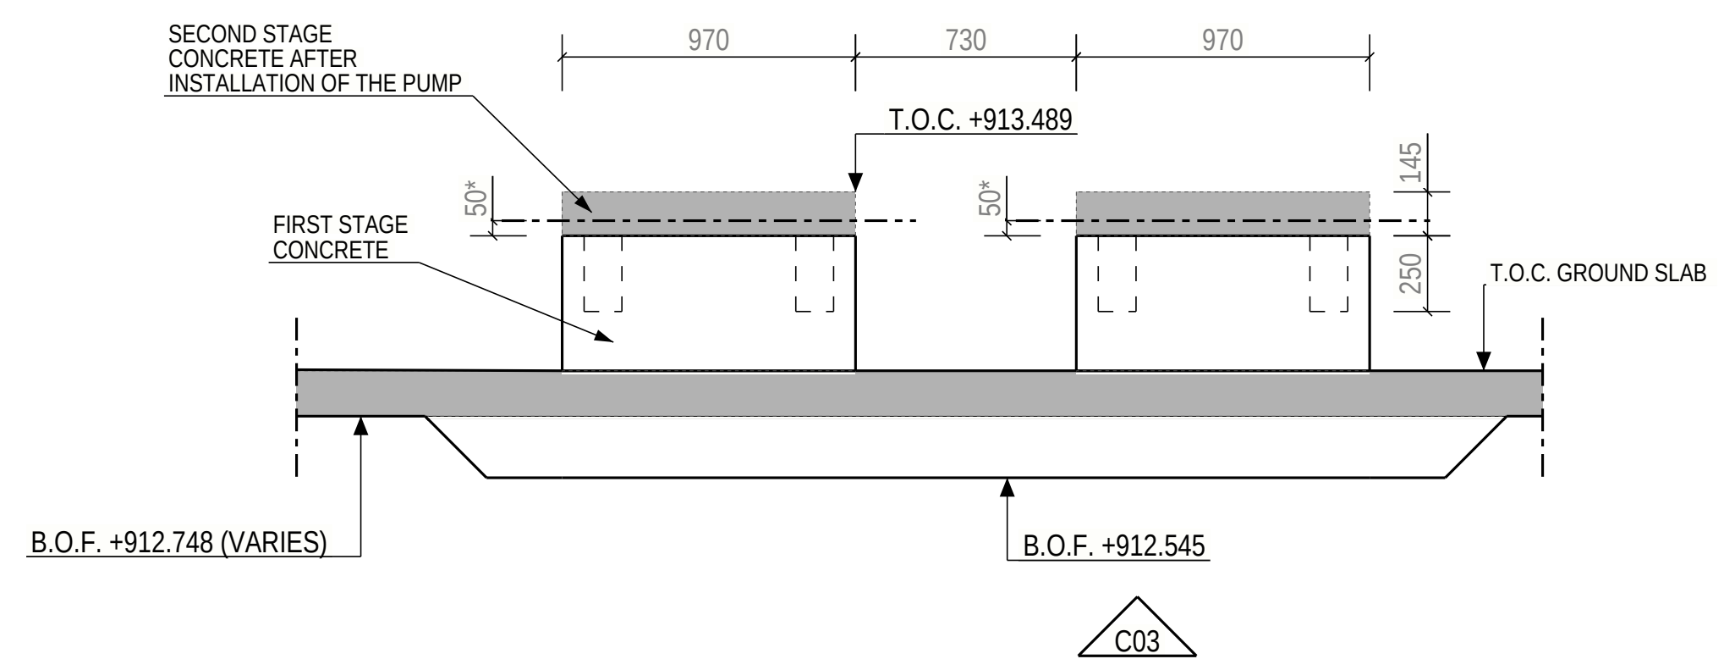

R.C.C. DETAIL OF PEDESTAL MKD. P31
(SCALE 1:25)

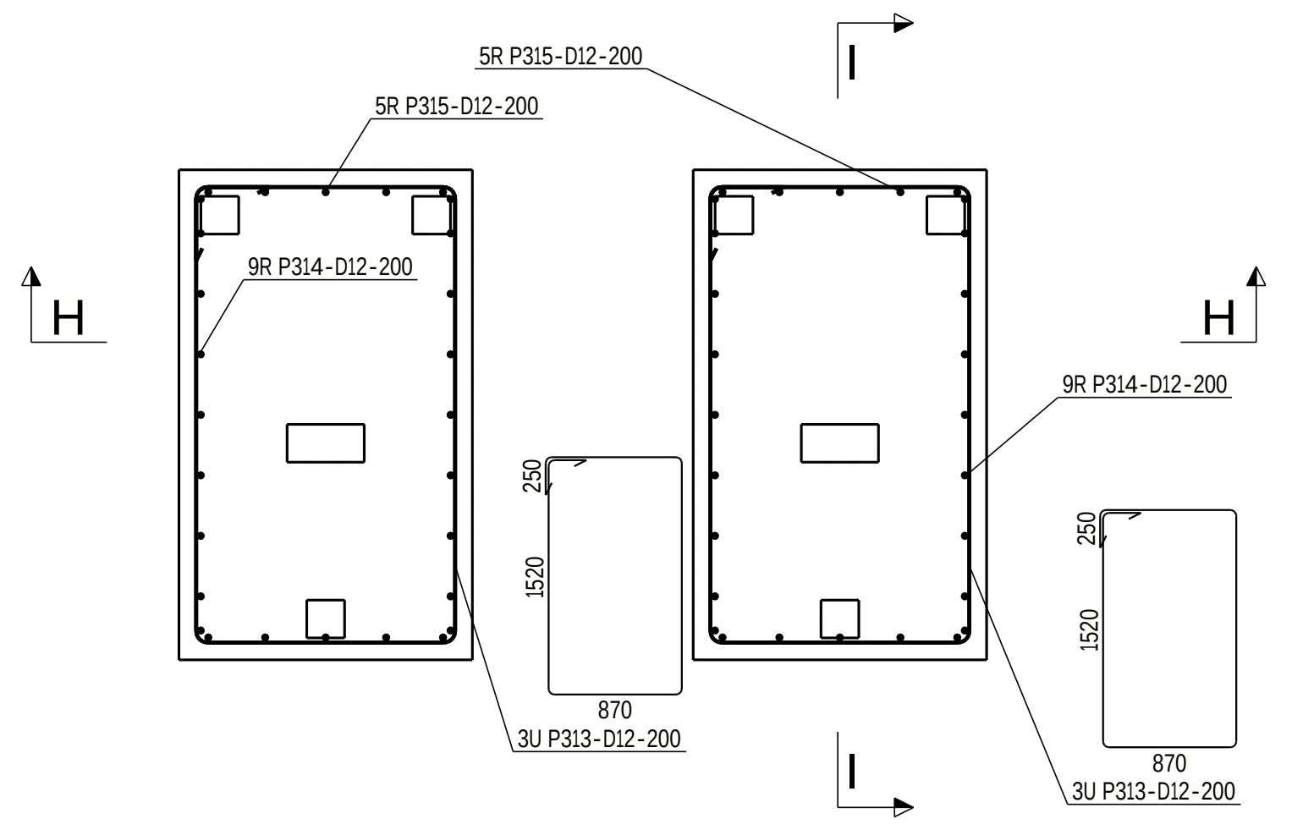

DETAIL OF PEDESTAL MKD. P49
(SCALE 1:25)

(49W1-PMP-026)

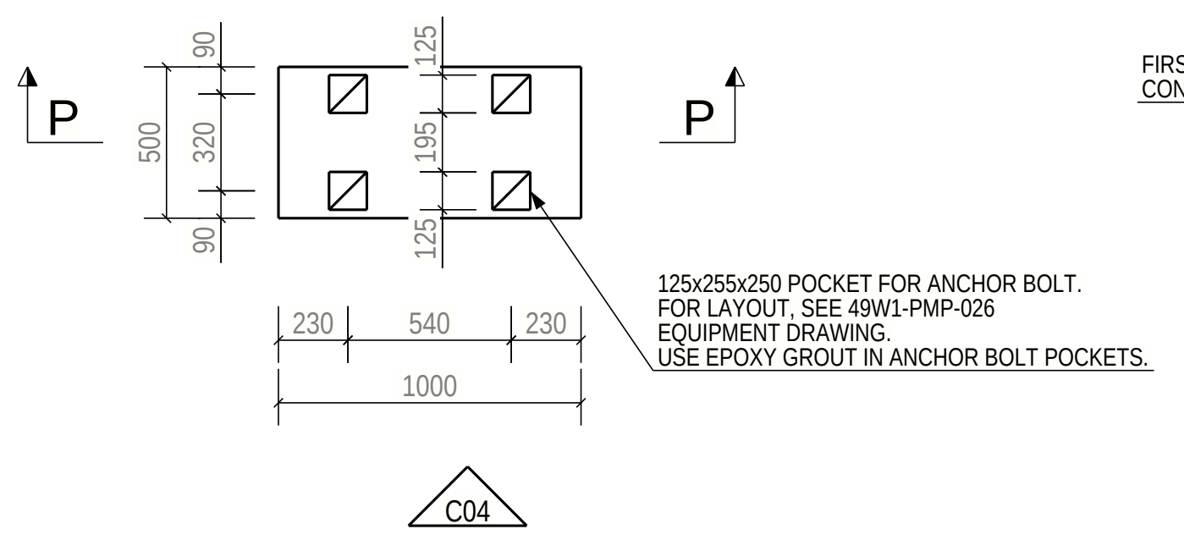
P
P
230
540
230
1000
125x255x250 POCKET FOR ANCHOR BOLT.
FOR LAYOUT, SEE 49W1-PMP-026
EQUIPMENT DRAWING.
USE EPOXY GROUT IN ANCHOR BOLT POCKETS.
C04

SECTION : P - P
(SCALE 1:25)

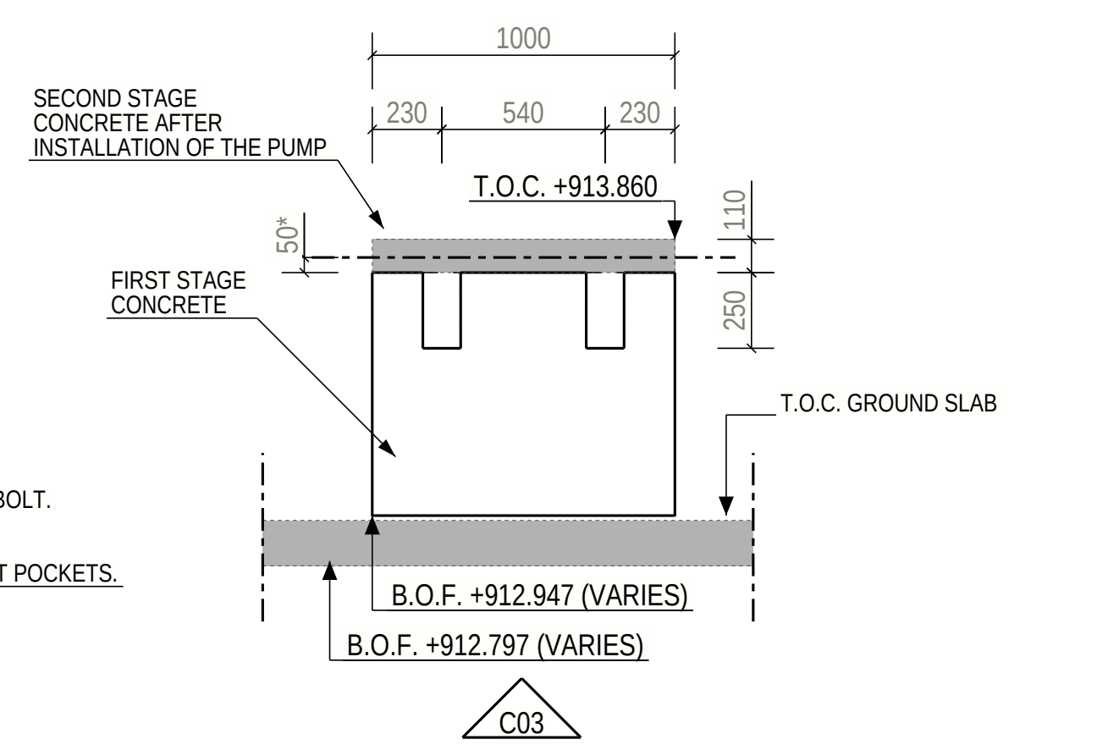

* NOMINAL DISTANCE BETWEEN FIRST STAGE CONCRETE AND BOTTOM OF PUMP 50mm

DETAIL OF PEDESTAL MKD. P33 & P34
(SCALE 1:25)

(49W1-PMP-043 & 49W1-PMP-044)

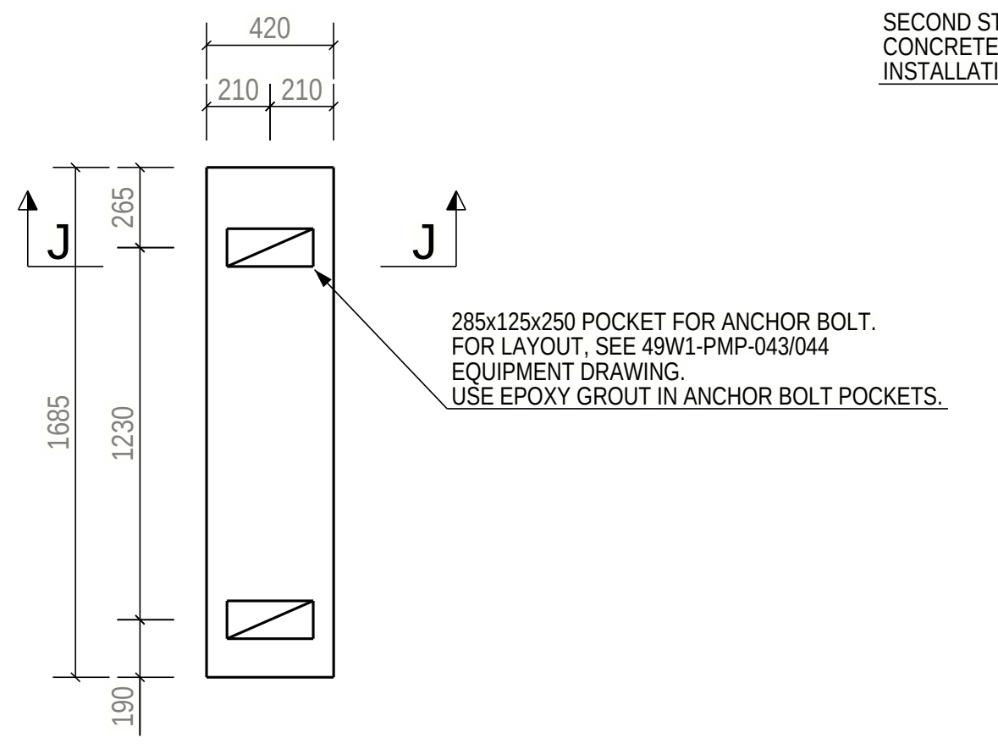
420
210
210
J
J
285x125x250 POCKET FOR ANCHOR BOLT.
FOR LAYOUT, SEE 49W1-PMP-043/044
EQUIPMENT DRAWING.
USE EPOXY GROUT IN ANCHOR BOLT POCKETS.
1685
1230

SECTION : J - J
(SCALE 1:25)

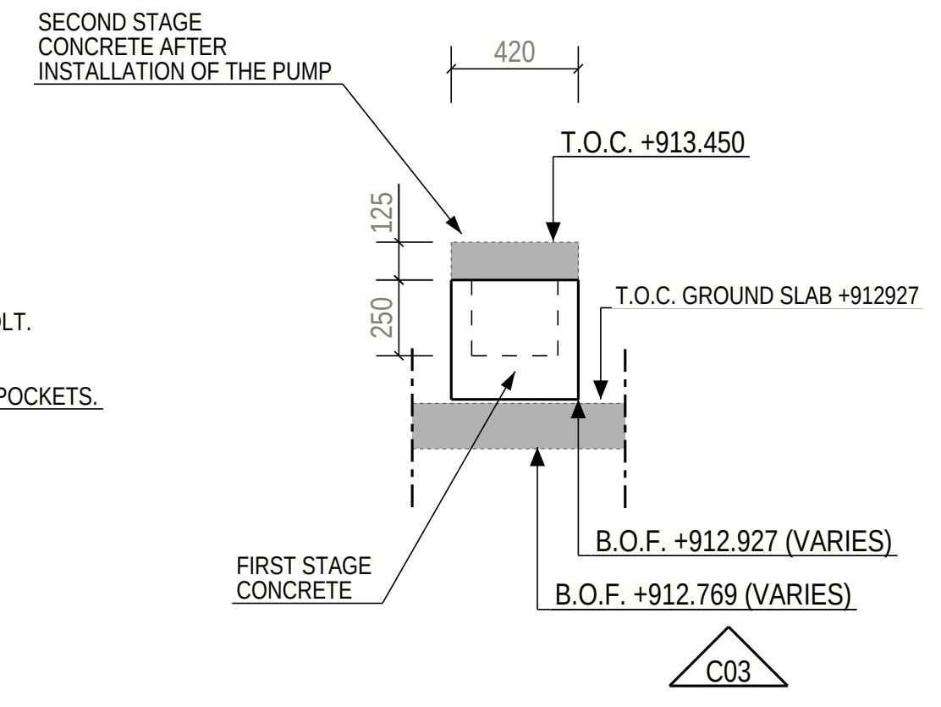

R.C.C. DETAIL OF PEDESTAL MKD. P33 & P34
(SCALE 1:25)

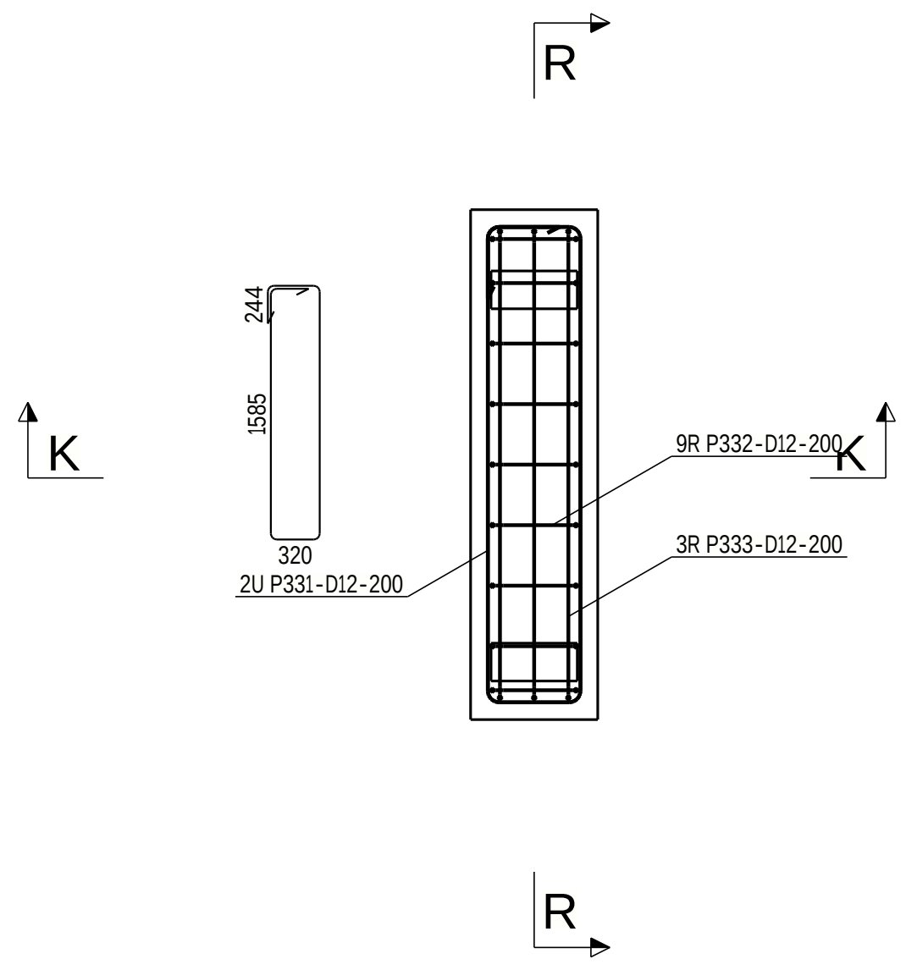

SECTION : K - K
(SCALE 1:25)

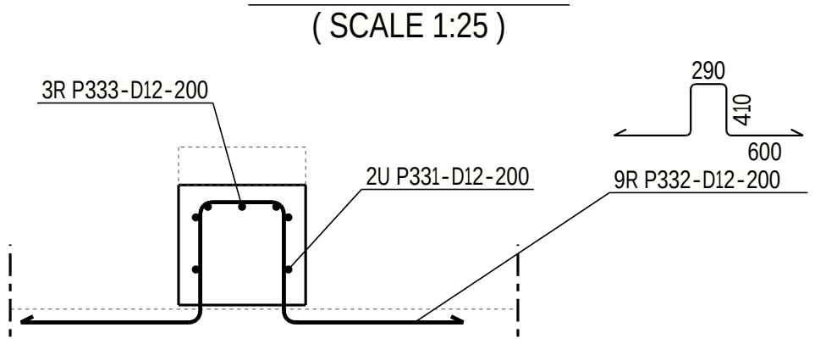

SECTION : R - R
(SCALE 1:25)

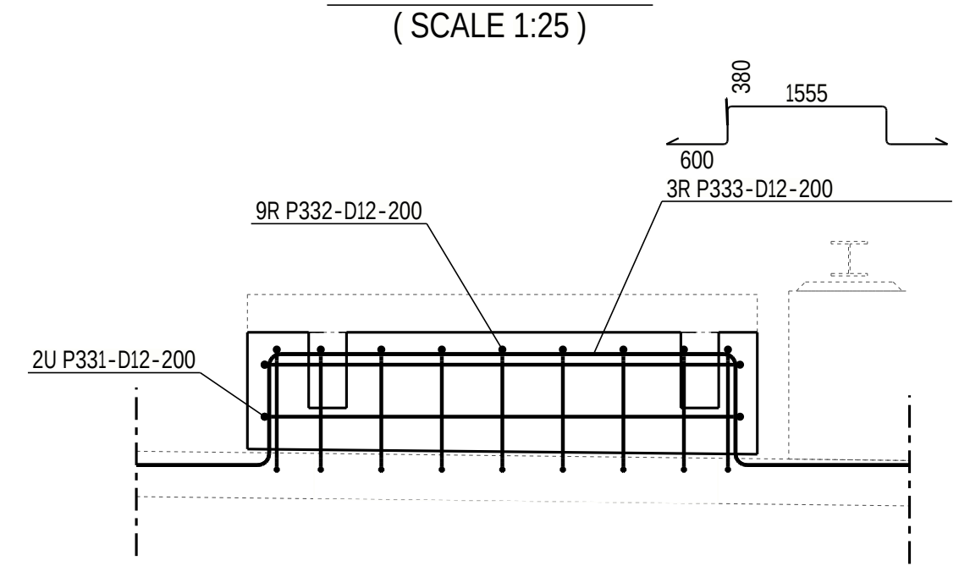

R.C.C. DETAIL OF PEDESTAL MKD. P49
(SCALE 1:25)

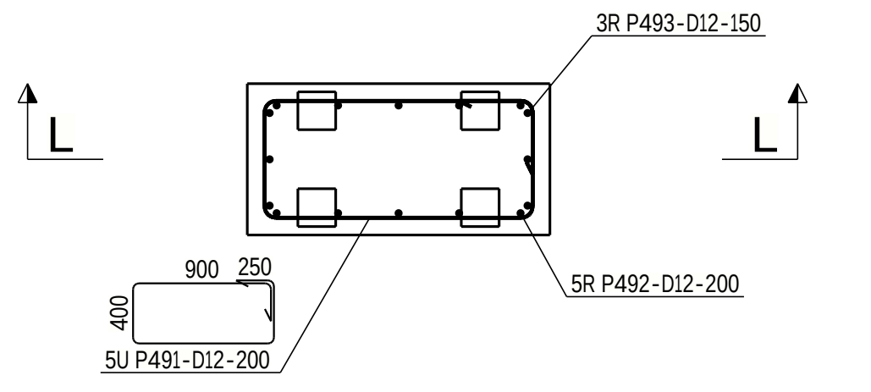

DETAIL OF PEDESTAL MKD. P32 & P35
(SCALE 1:25)

(49W1-PMP-003 & 49W1-PMP-004)

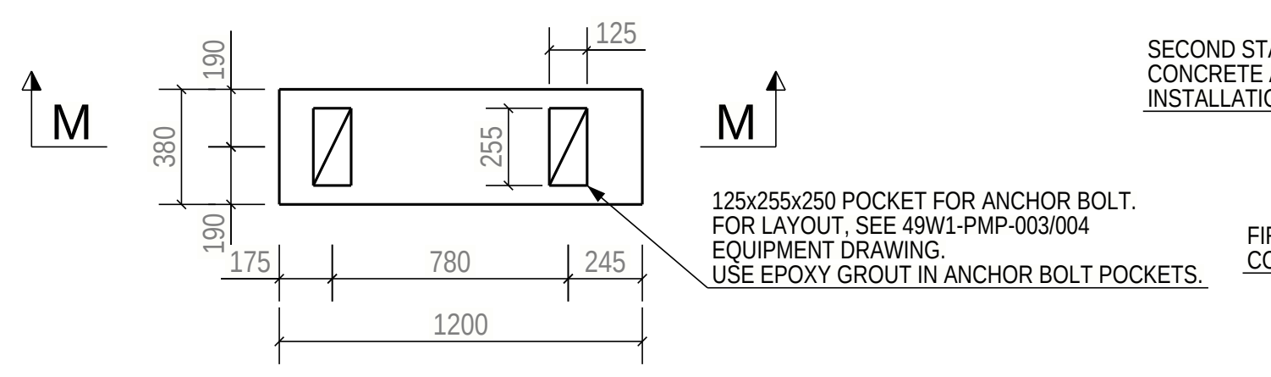
M
M
125
175
780
245
1200
125x255x250 POCKET FOR ANCHOR BOLT.
FOR LAYOUT, SEE 49W1-PMP-003/004
EQUIPMENT DRAWING.
USE EPOXY GROUT IN ANCHOR BOLT POCKETS.

SECTION : M - M
(SCALE 1:25)

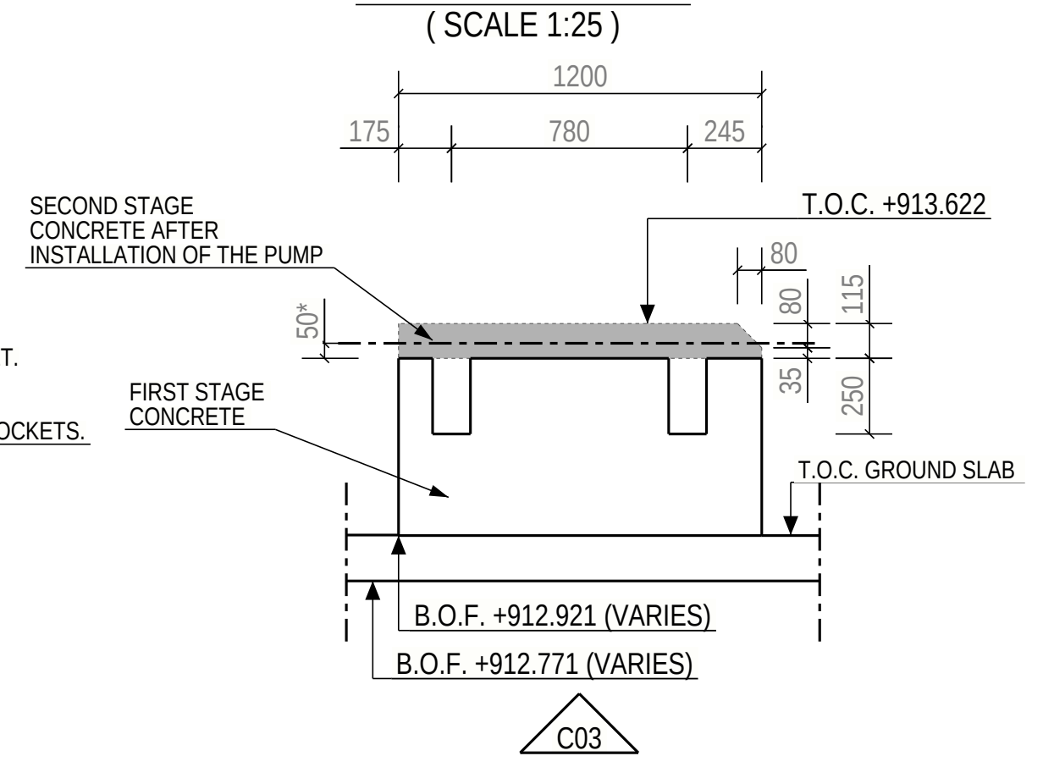

R.C.C. DETAIL OF PEDESTAL MKD. P32 & P35
(SCALE 1:25)

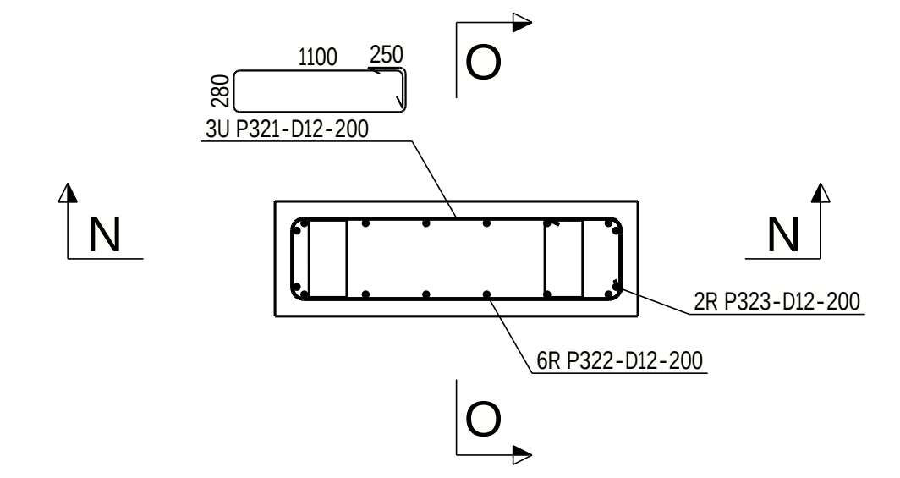

SECTION : N - N
(SCALE 1:25)

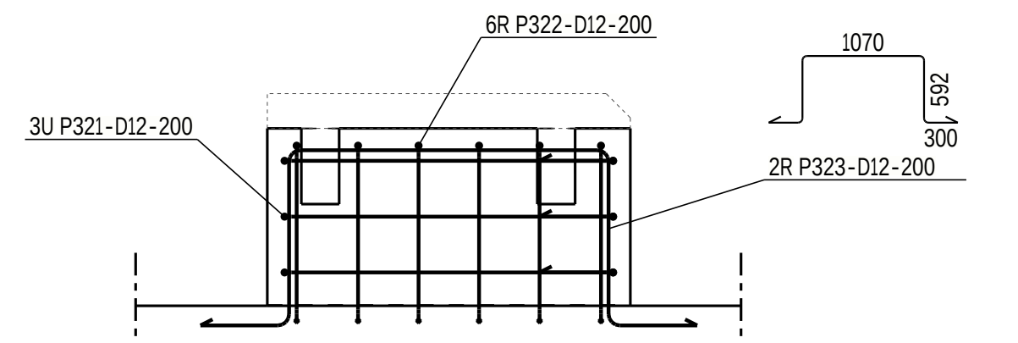

SECTION : O - O
(SCALE 1:25)

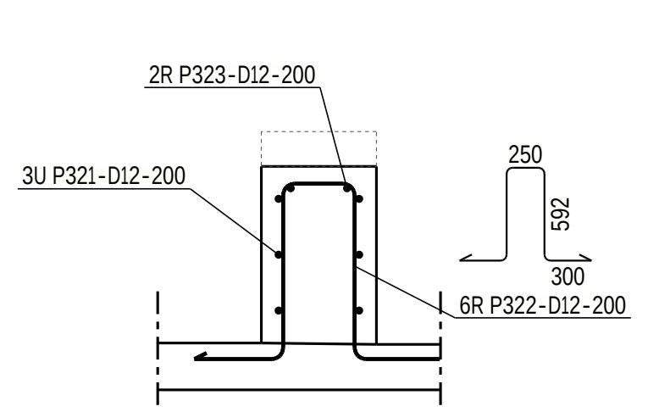

SECTION : L - L
(SCALE 1:25)

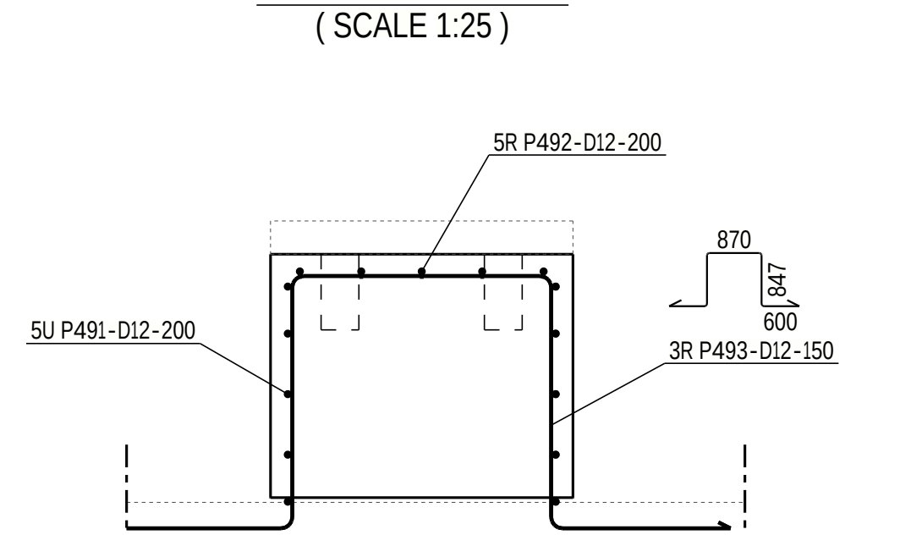

CONCRETE INFORMATION

Concretes used	C35
Concrete cover 1	50±10mm

REINFORCING BAR LIST — CAST UNIT CODE: P25 — PCS: 1

TYPE	POS	PCS	GRADE	D [mm]	L [mm]	dL [mm]	WEIGHT SUM [kg]	a	b	c	d	e	u	v	x	TD	COMMENT
U	P251	4	B500B	12	3370		12.0	250	1020	490	1020	490				60	
R	P252	6	B500B	12	2980		15.9	600	722	460	722	600				60	
R	P253	3	B500B	12	3450		9.2	600	692	990	692	600				60	

REINFORCING BAR TOTAL WEIGHT [kg] 37.1

REINFORCING BAR LIST — CAST UNIT CODE: P29 — PCS: 1

TYPE	POS	PCS	GRADE	D [mm]	L [mm]	dL [mm]	WEIGHT SUM [kg]	a	b	c	d	e	u	v	x	TD	COMMENT
U	P291	3	B500B	12	2050		5.5	250	600	250	600	250				60	
R	P292	4	B500B	12	2230		7.9	600	468	220	468	600				60	
R	P293	2	B500B	12	2580		4.6	600	468	570	468	600				60	

REINFORCING BAR TOTAL WEIGHT [kg] 18.0

REINFORCING BAR LIST — CAST UNIT CODE: P31 — PCS: 1

TYPE	POS	PCS	GRADE	D [mm]	L [mm]	dL [mm]	WEIGHT SUM [kg]	a	b	c	d	e	u	v	x	TD	COMMENT
G	P311	17	B500B	12	3830		57.9	600	288	2087	288	600	45	45	214	60	
G	P312	11	B500B	12	4860		47.6	600	295	3107	295	600	45	45	219	60	
U	P313	6	B500B	12	5130		27.3	250	1520	870	1520	870				60	
R	P314	18	B500B	12	2670		42.7	300	675	840	675	300				60	
R	P315	10	B500B	12	3260		29.0	300	645	1490	645	300				60	

REINFORCING BAR TOTAL WEIGHT [kg] 204.4

REINFORCING BAR LIST — CAST UNIT CODE: P32 — PCS: 1

TYPE	POS	PCS	GRADE	D [mm]	L [mm]	dL [mm]	WEIGHT SUM [kg]	a	b	c	d	e	u	v	x	TD	COMMENT
U	P321	3	B500B	12	3110		8.3	250	1100	280	1100	280				60	
R	P322	6	B500B	12	1910		10.2	300	592	250	592	300				60	
R	P323	2	B500B	12	2730		4.9	300	592	1070	592	300				60	

REINFORCING BAR TOTAL WEIGHT [kg] 23.4

REINFORCING BAR LIST — CAST UNIT CODE: P33 — PCS: 1

TYPE	POS	PCS	GRADE	D [mm]	L [mm]	dL [mm]	WEIGHT SUM [kg]	a	b	c	d	e	u	v	x	TD	COMMENT
U	P331	2	B500B	12	4140		7.4	244	1585	320	1585	320				60	
R	P332	9	B500B	12	2190		17.5	600	410	290	410	600				60	
R	P333	3	B500B	12	3390		9.1	600	380	1555	380	600				60	

REINFORCING BAR TOTAL WEIGHT [kg] 33.9

REINFORCING BAR LIST — CAST UNIT CODE: P49 — PCS: 1

TYPE	POS	PCS	GRADE	D [mm]	L [mm]	dL [mm]	WEIGHT SUM [kg]	a	b	c	d	e	u	v	x	TD	COMMENT
U	P491	5	B500B	12	2950		13.1	250	900	400	900	400				60	
R	P492	5	B500B	12	3190		14.2	600	872	370	872	600				60	
R	P493	3	B500B	12	3640		9.7	600	847	870	847	600				60	

REINFORCING BAR TOTAL WEIGHT [kg] 37.0

C02

REINFORCEMENT BENDING SHAPES:

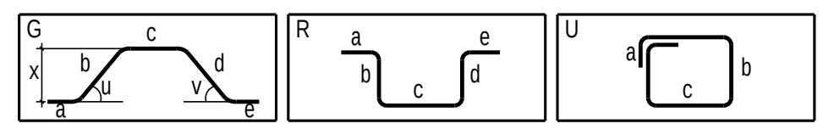

LEGEND:
R.L. - REDUCED LEVEL
T.O.C. - TOP OF CONCRETE
B.O.F. - BOTTOM OF FOUNDATION
F.G.L. - FINISHED GROUND LEVEL
P.C.C. - PLAIN CEMENT CONCRETE
TYP - TYPICAL
MKD - MARKED
CL - CENTER LINE
BOTTOM REINF. (B)
TOP REINF. (T)
SBC - SAFE BEARING CAPACITY
MIN. - MINIMUM
REF. - REFERED
GA - GENERAL ARRANGEMENT
DWG. - DRAWING
R.C.C. - REINFORCED CEMENT CONCRETE

NOTES:
1. ALL DIMENSIONS ARE IN MILLIMETRES AND LEVELS ARE IN METRES UNLESS OTHERWISE STATED
2. GRADE OF CONCRETE SHALL BE C35 (35MPa) UNLESS NOTED OTHERWISE & C15 (15MPa) FOR BLINDING CONCRETE.
3. GRADE OF REINFORCEMENT SHALL BE DEFORMED BAR ASTM A615-GRADE 60 (fy=420MPa)
4. CLEAR COVER TO MAIN REINFORCEMENT SHALL BE AS FOLLOWS:
a) FOUNDATION: 75 mm (BOTTOM & SIDE)
b) FOUNDATION: 50 mm (TOP)
c) COLUMN & PEDESTAL: 50 mm
5. MINIMUM LAP LENGTHS OF REINFORCEMENT SHALL BE 40XBAR DIAMETER
6. FOR STANDARD REINFORCEMENT DETAILS & GENERAL NOTES FOR CIVIL WORKS REFER TO DRAWING NUMBER MD-216-1000-EG-CV-DED-1005 & 1001
7. ANCHOR BOLTS AND EMBEDDED STEELWORK SHALL BE HOT DIP GALVANIZED
8. T.O.C. & TOP OF SCREED TOLERANCE SHALL BE WITHIN +/- 10MM OF DESIGN LEVEL
9. NET SAFE BEARING CAPACITY OF SOIL AT BOTTOM OF FOUNDATION IS CONSIDERED AS 375 KN/SQ.M.
10. REBARS CAN BE MOVED LOCALLY BY +/- 25mm TO AVOID INTERFERENCE WITH EMBEDDED PARTS

KEYPLAN

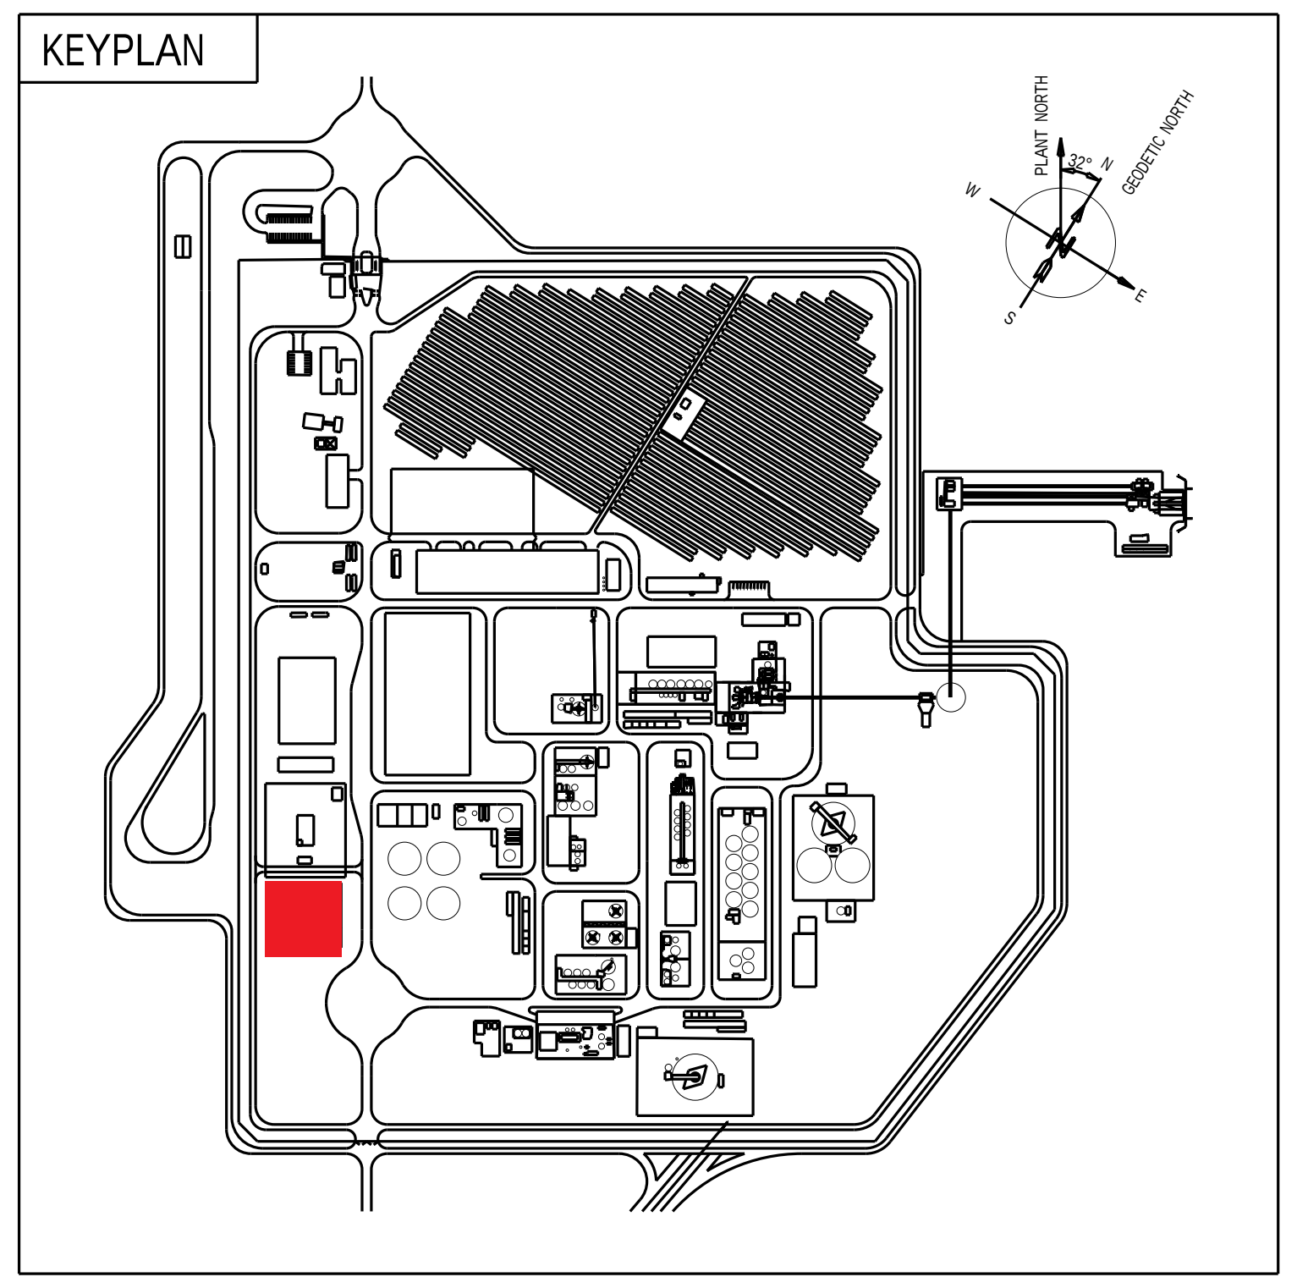

DOCUMENT NUMBER	REFERENCE DOCUMENTS	DOCUMENT NUMBER	REFERENCE DOCUMENTS
MD-216-49W1-EG-CV-DED-1017	EQUIPMENT FOUNDATION PUMPS 1		
MD-216-49W1-EG-CV-DED-1004	SAND FILTER BOTTOM SLAB REINFORCEMENT DRAWING	MD-216-49W1-EG-CV-CAL-1002	SAND FILTER AND DISTRIBUTION BOX CALCULATION REPORT
MD-216-49W1-EG-CV-GAD-1003	1-10/A-E GENERAL ARRANGEMENT DRAWING	MD-216-49W1-EG-CV-DED-1003	SAND FILTER AND DISTRIBUTION BOX DIMENSIONAL DRAWING
MD-216-49W1-EG-CV-GAD-1001	1-8/E-J GENERAL ARRANGEMENT DRAWING	MD-216-49W1-EG-CV-GAD-1002	7-12/D-J GENERAL ARRANGEMENT DRAWING

REV	DATE	REVISION DESCRIPTION	DRN	CHK	ENG	APP	EMP
D01	29.01.2024	AS-BUILT	JonRen	MauNot	LuiPiz	SouCha	
C04	22.02.2022	P49 HOLD REMOVED	JonRen	MauNot	LuiPiz	SouCha	
C03	19.01.2022	B.O.F ADDED	JonRen	MauNot	LuiPiz	SouCha	
C02	10.01.2022	COVER THICKNESS UPDATED, HOLD REMOVED	JonRen	MauNot	LuiPiz	SouCha	
C01	08.12.2021	ISSUED FOR CONSTRUCTION	AbdDus	MauNot	LuiPiz	SouCha	
A01	05.11.2021	ISSUED FOR APPROVAL	AbdDus	MauNot	LuiPiz	SouCha	

RESERVED FOR VENDOR LOGO AND DRAWING NUMBER

LARSEN & TOUBRO

This drawing is the property of LARSEN & TOUBRO and must not be passed on to any person or body not authorized by us to recieve it or be copied or otherwise made use either in full or in part by such person or body without our prior permission in writing.

Outotec

The content of these documents are the sole property of Outotec Oyj. Any rights not expressly granted herein are reserved. Reproduction, transfer or distribution of part or all of the contents in any form without prior written permission of Outotec is prohibited.

MA'ADEN معادن
Saudi Arabian Mining Company شركة التعدين العربية السعودية

This document and the information contained herein is Ma'aden proprietary know-how. This document or any part thereof should not be reproduced, stored in a retrieval system or transmitted by any means, electronic or otherwise, or divulged without prior written permission of Ma'aden.

LARSEN & TOUBRO DRAWING NUMBER	019045_080_C_D_24892_018	REVISION 5
OUTOTEC DRAWING NUMBER	900707_GAU01_AG11_CTB01_49018	DOCUMENT ID 0U100734783 — REVISION 5

DRAWN	AbdDus	05.11.2021
CHECKED	MauNot	05.11.2021
ENGINEER	NanWu	05.11.2021
APPROVED	LuiPiz	05.11.2021
EMPLOYER		
SCALE	1:25	A0

MANSOURAH - MASSARAH GOLD PROJECT
49W1 RAW WATER TREATMENT PLANT
EQUIPMENT FOUNDATION PUMPS 2
DETAIL AND REINFORCEMENT DRAWING

DRAWING NUMBER
MD-216-49W1-EG-CV-DED-1018
REV
D01