

DRAWING NUMBER: MD-216-49W1-EG-CV-DED-1019 | REV: D01


DETAIL OF FOUNDATION MKD. P42
(SCALE 1:30)

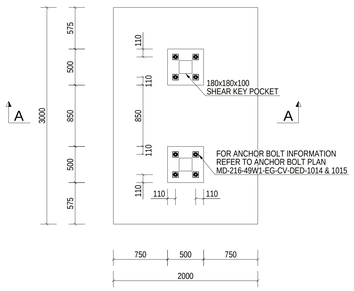


DETAIL OF FOUNDATION MKD. P39
(SCALE 1:30)

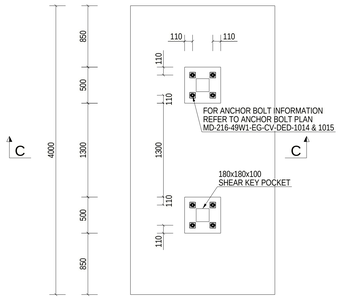


DETAIL OF FOUNDATION MKD. P40
(SCALE 1:30)

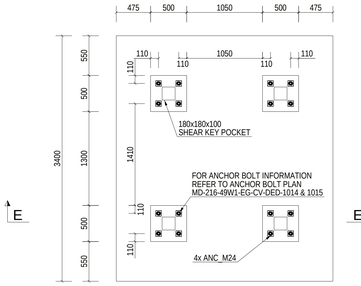


DETAIL OF FOUNDATION MKD. P45
(SCALE 1:30)

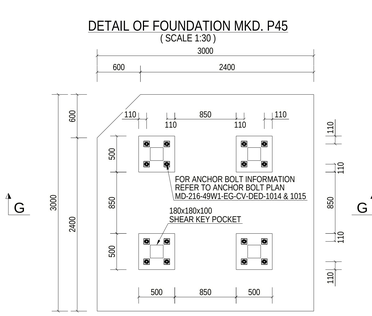


SECTION : A - A
(SCALE 1:30)

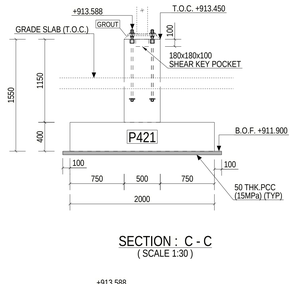


SECTION : C - C
(SCALE 1:30)

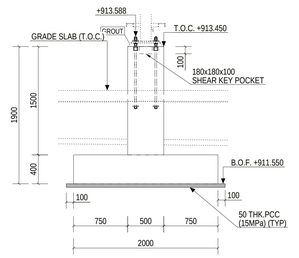


SECTION : E - E
(SCALE 1:30)

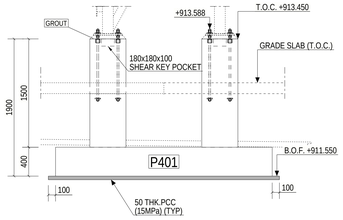


SECTION : G - G
(SCALE 1:30)

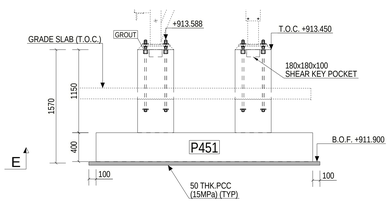


SECTION : 1 - 1
(SCALE 1:15)

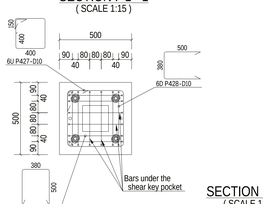


SECTION : 2 - 2
(SCALE 1:15)

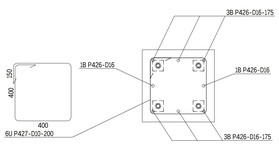


R.C.C. DETAIL OF FOUNDATION MKD. P42
(SCALE 1:30)

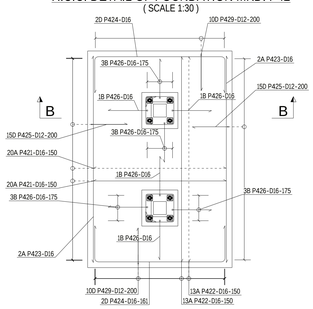


R.C.C. DETAIL OF FOUNDATION MKD. P39
(SCALE 1:30)

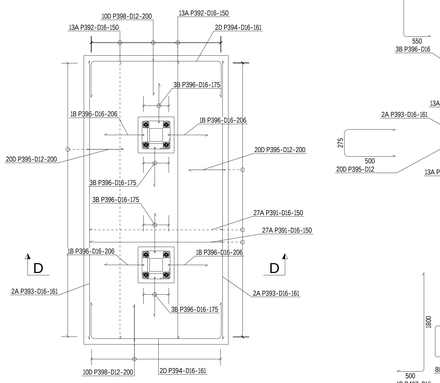


R.C.C. DETAIL OF FOUNDATION MKD. P40
(SCALE 1:30)

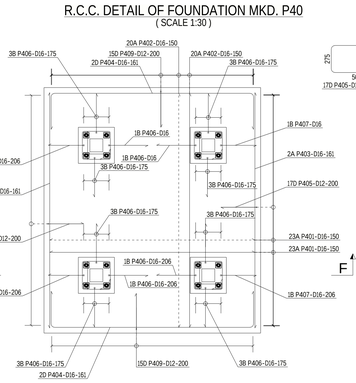


R.C.C. DETAIL OF FOUNDATION MKD. P45
(SCALE 1:30)

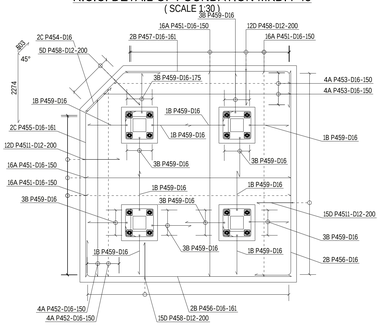


SECTION : B - B
(SCALE 1:30)

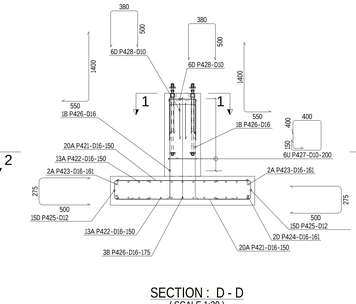


SECTION : D - D
(SCALE 1:30)

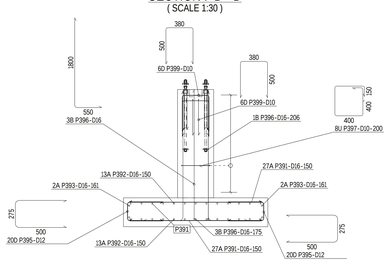


SECTION : F - F
(SCALE 1:30)

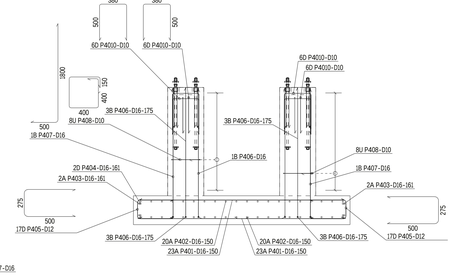


SECTION : H - H
(SCALE 1:30)

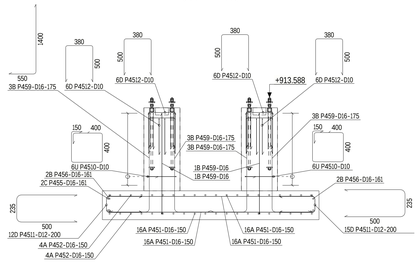


SECTION : I - I
(SCALE 1:30)

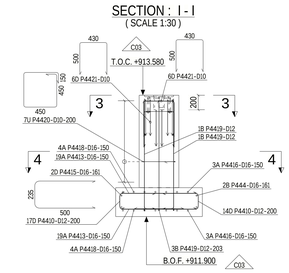


DETAIL OF FOUNDATION MKD. P44
(SCALE 1:30)

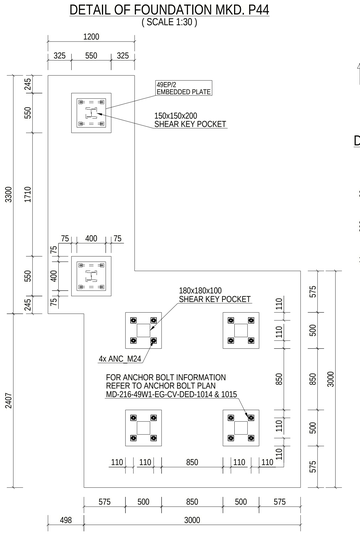


DETAIL OF EMBEDDED PLATE 49EP/2
(SCALE 1:10)

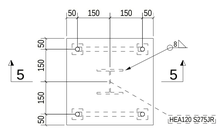


SECTION : 5 - 5
(SCALE 1:10)

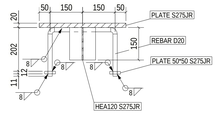


SECTION : 3 - 3
(SCALE 1:15)

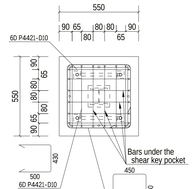


R.C.C. DETAIL OF FOUNDATION MKD. P44
(SCALE 1:30)

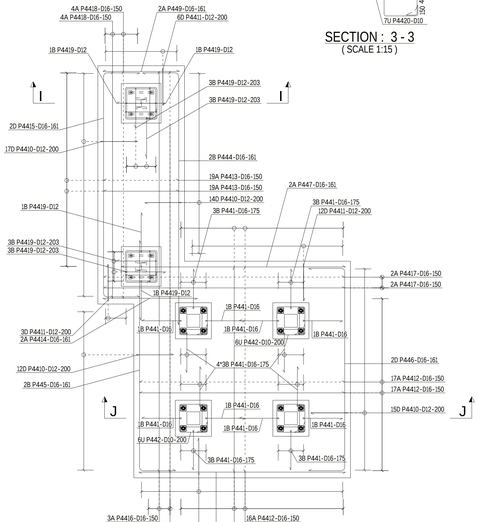

SECTION : J - J
(SCALE 1:30)

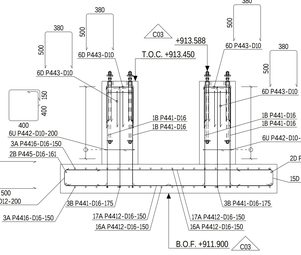

SECTION : 4 - 4
(SCALE 1:15)

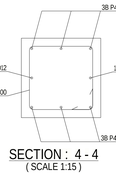

CONCRETE INFORMATION

Concretes used	C35
Concrete cover 1	50±10mm

REINFORCING BAR LIST

CAST UNIT CODE: P39 PCS: 1

REINFORCING BARS TYPE	POS	PCS	GRADE	D [mm]	L [mm]	dL [mm]	WEIGHT SUM [kg]	BENDING DIMENSIONS [mm] a	b	c	d	e	u	v	x	TD	COMMENT
A	P391	54	B500B	16	1840		157.0	1840									
A	P392	26	B500B	16	3840		157.7	3840									
A	P393	4	B500B	16	3860		24.4	3860									
D	P394	4	B500B	16	2760		17.4	509	1822	509						80	
D	P395	40	B500B	12	1210		43.2	500	275	500						60	
B	P396	16	B500B	16	2300		58.4	1800	550					90		80	
U	P397	16	B500B	10	1780		17.6	150	400	400	400	400				40	
D	P398	20	B500B	12	1170		20.9	500	235	500						60	
D	P399	24	B500B	10	1330		19.7	500	390	500						40	

REINFORCING BAR TOTAL WEIGHT [kg] 516.4

REINFORCING BAR LIST

CAST UNIT CODE: P40 PCS: 1

REINFORCING BARS TYPE	POS	PCS	GRADE	D [mm]	L [mm]	dL [mm]	WEIGHT SUM [kg]	BENDING DIMENSIONS [mm] a	b	c	d	e	u	v	x	TD	COMMENT
A	P401	46	B500B	16	2840		206.4	2840									
A	P402	40	B500B	16	3240		204.8	3240									
A	P403	4	B500B	16	3260		20.6	3260									
D	P404	4	B500B	16	3760		23.8	509	2822	509						80	
D	P405	34	B500B	12	1210		36.7	500	275	500						60	
D	P406	28	B500B	16	2300		102.2	1800	550					90		80	
B	P407	4	B500B	16	2250		14.3	1800	500					90		80	
U	P408	32	B500B	10	1780		35.2	150	400	400	400	400				40	
D	P409	30	B500B	12	1170		31.3	500	235	500						60	
D	P4010	48	B500B	10	1330		39.5	500	380	500						40	

REINFORCING BAR TOTAL WEIGHT [kg] 714.7

REINFORCING BAR LIST

CAST UNIT CODE: P42 PCS: 1

REINFORCING BARS TYPE	POS	PCS	GRADE	D [mm]	L [mm]	dL [mm]	WEIGHT SUM [kg]	BENDING DIMENSIONS [mm] a	b	c	d	e	u	v	x	TD	COMMENT
A	P421	40	B500B	16	1840		116.3	1840									
A	P422	26	B500B	16	2840		116.7	2840									
A	P423	4	B500B	16	2860		18.1	2860									
D	P424	4	B500B	16	2760		17.4	509	1822	509						80	
D	P425	30	B500B	12	1210		32.4	500	275	500						60	
B	P426	16	B500B	16	1900		48.3	1400	550					90		80	
U	P427	12	B500B	10	1780		13.2	150	400	400	400	400				40	
D	P428	24	B500B	10	1330		19.7	500	380	500						40	
D	P429	20	B500B	12	1170		20.9	500	235	500						60	

REINFORCING BAR TOTAL WEIGHT [kg] 403.0

REINFORCING BAR LIST

CAST UNIT CODE: P44 PCS: 1

REINFORCING BARS TYPE	POS	PCS	GRADE	D [mm]	L [mm]	dL [mm]	WEIGHT SUM [kg]	BENDING DIMENSIONS [mm] a	b	c	d	e	u	v	x	TD	COMMENT
B	P441	32	B500B	16	1900		96.5	1400	550					90		80	
U	P442	24	B500B	10	1780		26.4	150	400	400	400	400				40	
D	P443	48	B500B	10	1330		39.5	500	380	500						40	
B	P444	2	B500B	16	3960		12.5	3497	509					90		80	
B	P445	2	B500B	16	3660		11.6	3197	509					90		80	
D	P446	2	B500B	16	3760		11.9	509	2822	509						80	
A	P447	2	B500B	16	3100		9.8	3107									
A	P448	2	B500B	16	2860		9.0	2860									
A	P449	2	B500B	16	1060		3.3	1060									
D	P4410	58	B500B	12	1170		60.5	500	235	500						60	
D	P4411	36	B500B	12	1210		38.8	500	275	500						60	
A	P4412	66	B500B	16	2840		296.2	2840									
A	P4413	38	B500B	16	1040		62.4	1040									
A	P4414	2	B500B	16	1300		4.1	1307									
D	P4415	2	B500B	16	4060		12.8	509	3122	509						80	
A	P4416	6	B500B	16	5540		52.6	5547									
A	P4417	4	B500B	16	3330		21.1	3337									
A	P4418	8	B500B	16	3140		39.7	3140									
B	P4419	16	B500B	12	2050		29.1	1530	550					90		60	
U	P4420	14	B500B	10	1980		17.1	150	450	450	450	450				40	
D	P4421	24	B500B	10	1380		20.5	500	430	500						40	

REINFORCING BAR TOTAL WEIGHT [kg] 875.7

REINFORCING BAR LIST

CAST UNIT CODE: P45 PCS: 1

REINFORCING BARS TYPE	POS	PCS	GRADE	D [mm]	L [mm]	dL [mm]	WEIGHT SUM [kg]	BENDING DIMENSIONS [mm] a	b	c	d	e	u	v	x	TD	COMMENT
A	P451	64	B500B	16	2840		287.2	2840									
A	P452	8	B500B	16	2730		31.8	2739									
278 AT GROUP		4	PCS	...	2290	147	...	2297									
A	P453	8	B500B	16	2730		31.8	2739									
2 AT GROUP		4	PCS	...	2290	147	...	2297									
C	P454	2	B500B	16	1250		4.0	503	763					45		80	
C	P455	2	B500B	16	2760		8.7	503	2274					45		80	
B	P456	4	B500B	16	3310		20.9	509	2841					90		80	
B	P457	2	B500B	16	2750		8.7	509	2282					90		80	
D	P458	32	B500B	12	1210		34.5	500	275	500						60	
B	P459	32	B500B	16	1900		96.5	1400	550					90		80	
U	P4510	24	B500B	10	1780		26.4	150	400	400	400	400				40	
D	P4511	27	B500B	12	1170		28.2	500	235	500						60	
D	P4512	48	B500B	10	1330		39.5	500	380	500						40	

REINFORCING BAR TOTAL WEIGHT [kg] 618.3

REINFORCEMENT BENDING SHAPES:




NOTES:

1. ALL DIMENSIONS ARE IN MILLIMETRES AND LEVELS ARE IN METRES UNLESS OTHERWISE STATED
2. GRADE OF CONCRETE SHALL BE C35 (35MPa) UNLESS NOTED OTHERWISE & C15 (15MPa) FOR BUNDING CONCRETE.
3. GRADE OF REINFORCEMENT SHALL BE DEFORMED BAR ASTM A615-GRADE 60 (fy=420MPa)
4. CLEAR COVER TO MAIN REINFORCEMENT SHALL BE AS FOLLOWS:
   a) FOUNDATION: 75 mm (BOTTOM & SIDE)
   b) FOUNDATION: 50 mm (TOP)
   c) COLUMN & PEDESTAL: 50 mm
5. MINIMUM LAP LENGTHS OF REINFORCEMENT SHALL BE 40XBAR DIAMETER
6. FOR STANDARD REINFORCEMENT DETAILS & GENERAL NOTES FOR CIVIL WORKS REFER TO DRAWING NUMBER MD-216-1000-EG-CV-DED-1005 & 1001
7. ANCHOR BOLTS AND EMBEDDED STEELWORK SHALL BE HOT DIP GALVANIZED
8. T.O.C. & TOP OF SCREED TOLERANCE SHALL BE WITHIN +/- 10MM OF DESIGN LEVEL
9. NET SAFE BEARING CAPACITY OF SOIL AT BOTTOM OF FOUNDATION IS CONSIDERED AS 375 KN/SQ.M.
10. REBARS CAN BE MOVED LOCALLY BY +/- 25mm TO AVOID INTERFERENCE WITH EMBEDDED PARTS

LEGEND:

R.L. - REDUCED LEVEL
T.O.C. - TOP OF CONCRETE
B.O.F. - BOTTOM OF FOUNDATION
F.G.L. - FINISHED GROUND LEVEL
P.C.C. - PLAIN CEMENT CONCRETE
TYP - TYPICAL
MKD - MARKED
CL - CENTER LINE
BOTTOM REINF. (B)
TOP REINF. (T)
SBC - SAFE BEARING CAPACITY
MIN. - MINIMUM
REF. - REFERED
GA - GENERAL ARRANGEMENT
DWG. - DRAWING
R.C.C. - REINFORCED CEMENT CONCRETE

KEYPLAN

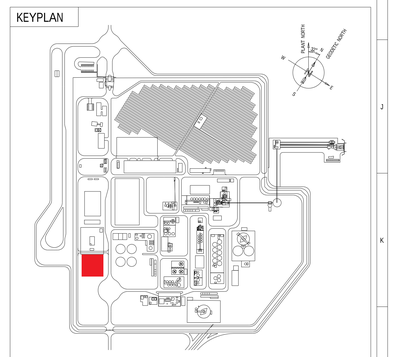

DOCUMENT NUMBER	REFERENCE DOCUMENTS
MD-216-49W1-EG-CV-DED-1016	PIPERACK FOUNDATION 1
MD-216-49W1-EG-CV-DED-1017	EQUIPMENT FOUNDATION PUMPS 1
MD-216-49W1-EG-CV-DED-1004	SAND FILTER BOTTOM SLAB REINFORCEMENT DRAWING
MD-216-49W1-EG-CV-GAD-1003	1-J2/A-1 GENERAL ARRANGEMENT DRAWING
MD-216-49W1-EG-CV-GAD-1001	1-B/E-J GENERAL ARRANGEMENT DRAWING

DOCUMENT NUMBER	REFERENCE DOCUMENTS
MD-216-49W1-EG-CV-DED-1018	EQUIPMENT FOUNDATION PUMPS 2
MD-216-49W1-EG-CV-CAL-1002	SAND FILTER AND DISTRIBUTION BOX CALCULATION REPORT
MD-216-49W1-EG-CV-DED-1003	SAND FILTER AND DISTRIBUTION BOX DIMENSIONAL DRAWING
MD-216-49W1-EG-CV-GAD-1002	7-J2/D-J GENERAL ARRANGEMENT DRAWING

REV	DATE	REVISION DESCRIPTION	DRN	CHK	ENG	APP	EMP
D01	29.01.2024	AS-BUILT	MaxCh	MauNot	LuiPiz	SiaCha	
C03	28.01.2022	LEVEL MARKS FOR P44 ARE ADDED	MaxCh	MauNot	NanWu	LuiPiz	
C02	23.12.2021	COVER THICKNESS CHANGED. P44 & P41 UPDATED	JonNeo	MauNot	NanWu	LuiPiz	
C01	08.12.2021	ISSUED FOR CONSTRUCTION, REVISED A PER COMMENTS	AbdDus	MauNot	LuiPiz	SiaCha	
A01	23.11.2021	ISSUED FOR DAPPROVAL	AbdDus	MauNot	AndDus	LuiPiz	

REV	DATE	REVISION DESCRIPTION	DRN	CHK	ENG	APP	EMP

RESERVED FOR VENDOR LOGO AND DRAWING NUMBER

LARSEN & TOUBRO

This drawing is the property of LARSEN & TOUBRO and must not be passed on to any person or body not authorized by us to receive it or be copied or otherwise made use either in full or in part by such person or body without our prior permission in writing.

Outotec

The content of these documents are the sole property of Outotec Oyj. Any rights not expressly granted herein are reserved. Reproduction, transfer or distribution of part or all of the contents in any form without prior written permission of Outotec is prohibited.

MA'ADEN معادن
Saudi Arabian Mining Company شركة معادن العربية السعودية

This document and the information contained herein is Ma'aden proprietary know-how. This document or any part thereof should not be reproduced, stored in a retrieval system or transmitted by any means, electronic or otherwise, or divulged without prior written permission of Ma'aden.

LARSEN & TOUBRO DRAWING NUMBER			REVISION
0190045_080_C_D_24892_019			3
OUTOTEC DRAWING NUMBER		DOCUMENT ID	REVISION
900707_GAU01_AG11_CTB01_49019		0UJ00736745	3
DRAWN	AbdDus	23.11.2021	
CHECKED	MauNot	23.11.2021	
ENGINEER	NanWu	23.11.2021	
APPROVED	LuiPiz	23.11.2021	
EMPLOYER			
SCALE	1:30	A0	

MANSOURAH - MASSARAH GOLD PROJECT
49W1 RAW WATER TREATMENT PLANT
PIPERACK FOUNDATION 2
DETAIL AND REINFORCEMENT DRAWING

DRAWING NUMBER: MD-216-49W1-EG-CV-DED-1019 | REV: C03

Tekla Structures