MD-216-49W1-EG-CV-DED-1022
DRAWING NUMBER
D01
REV

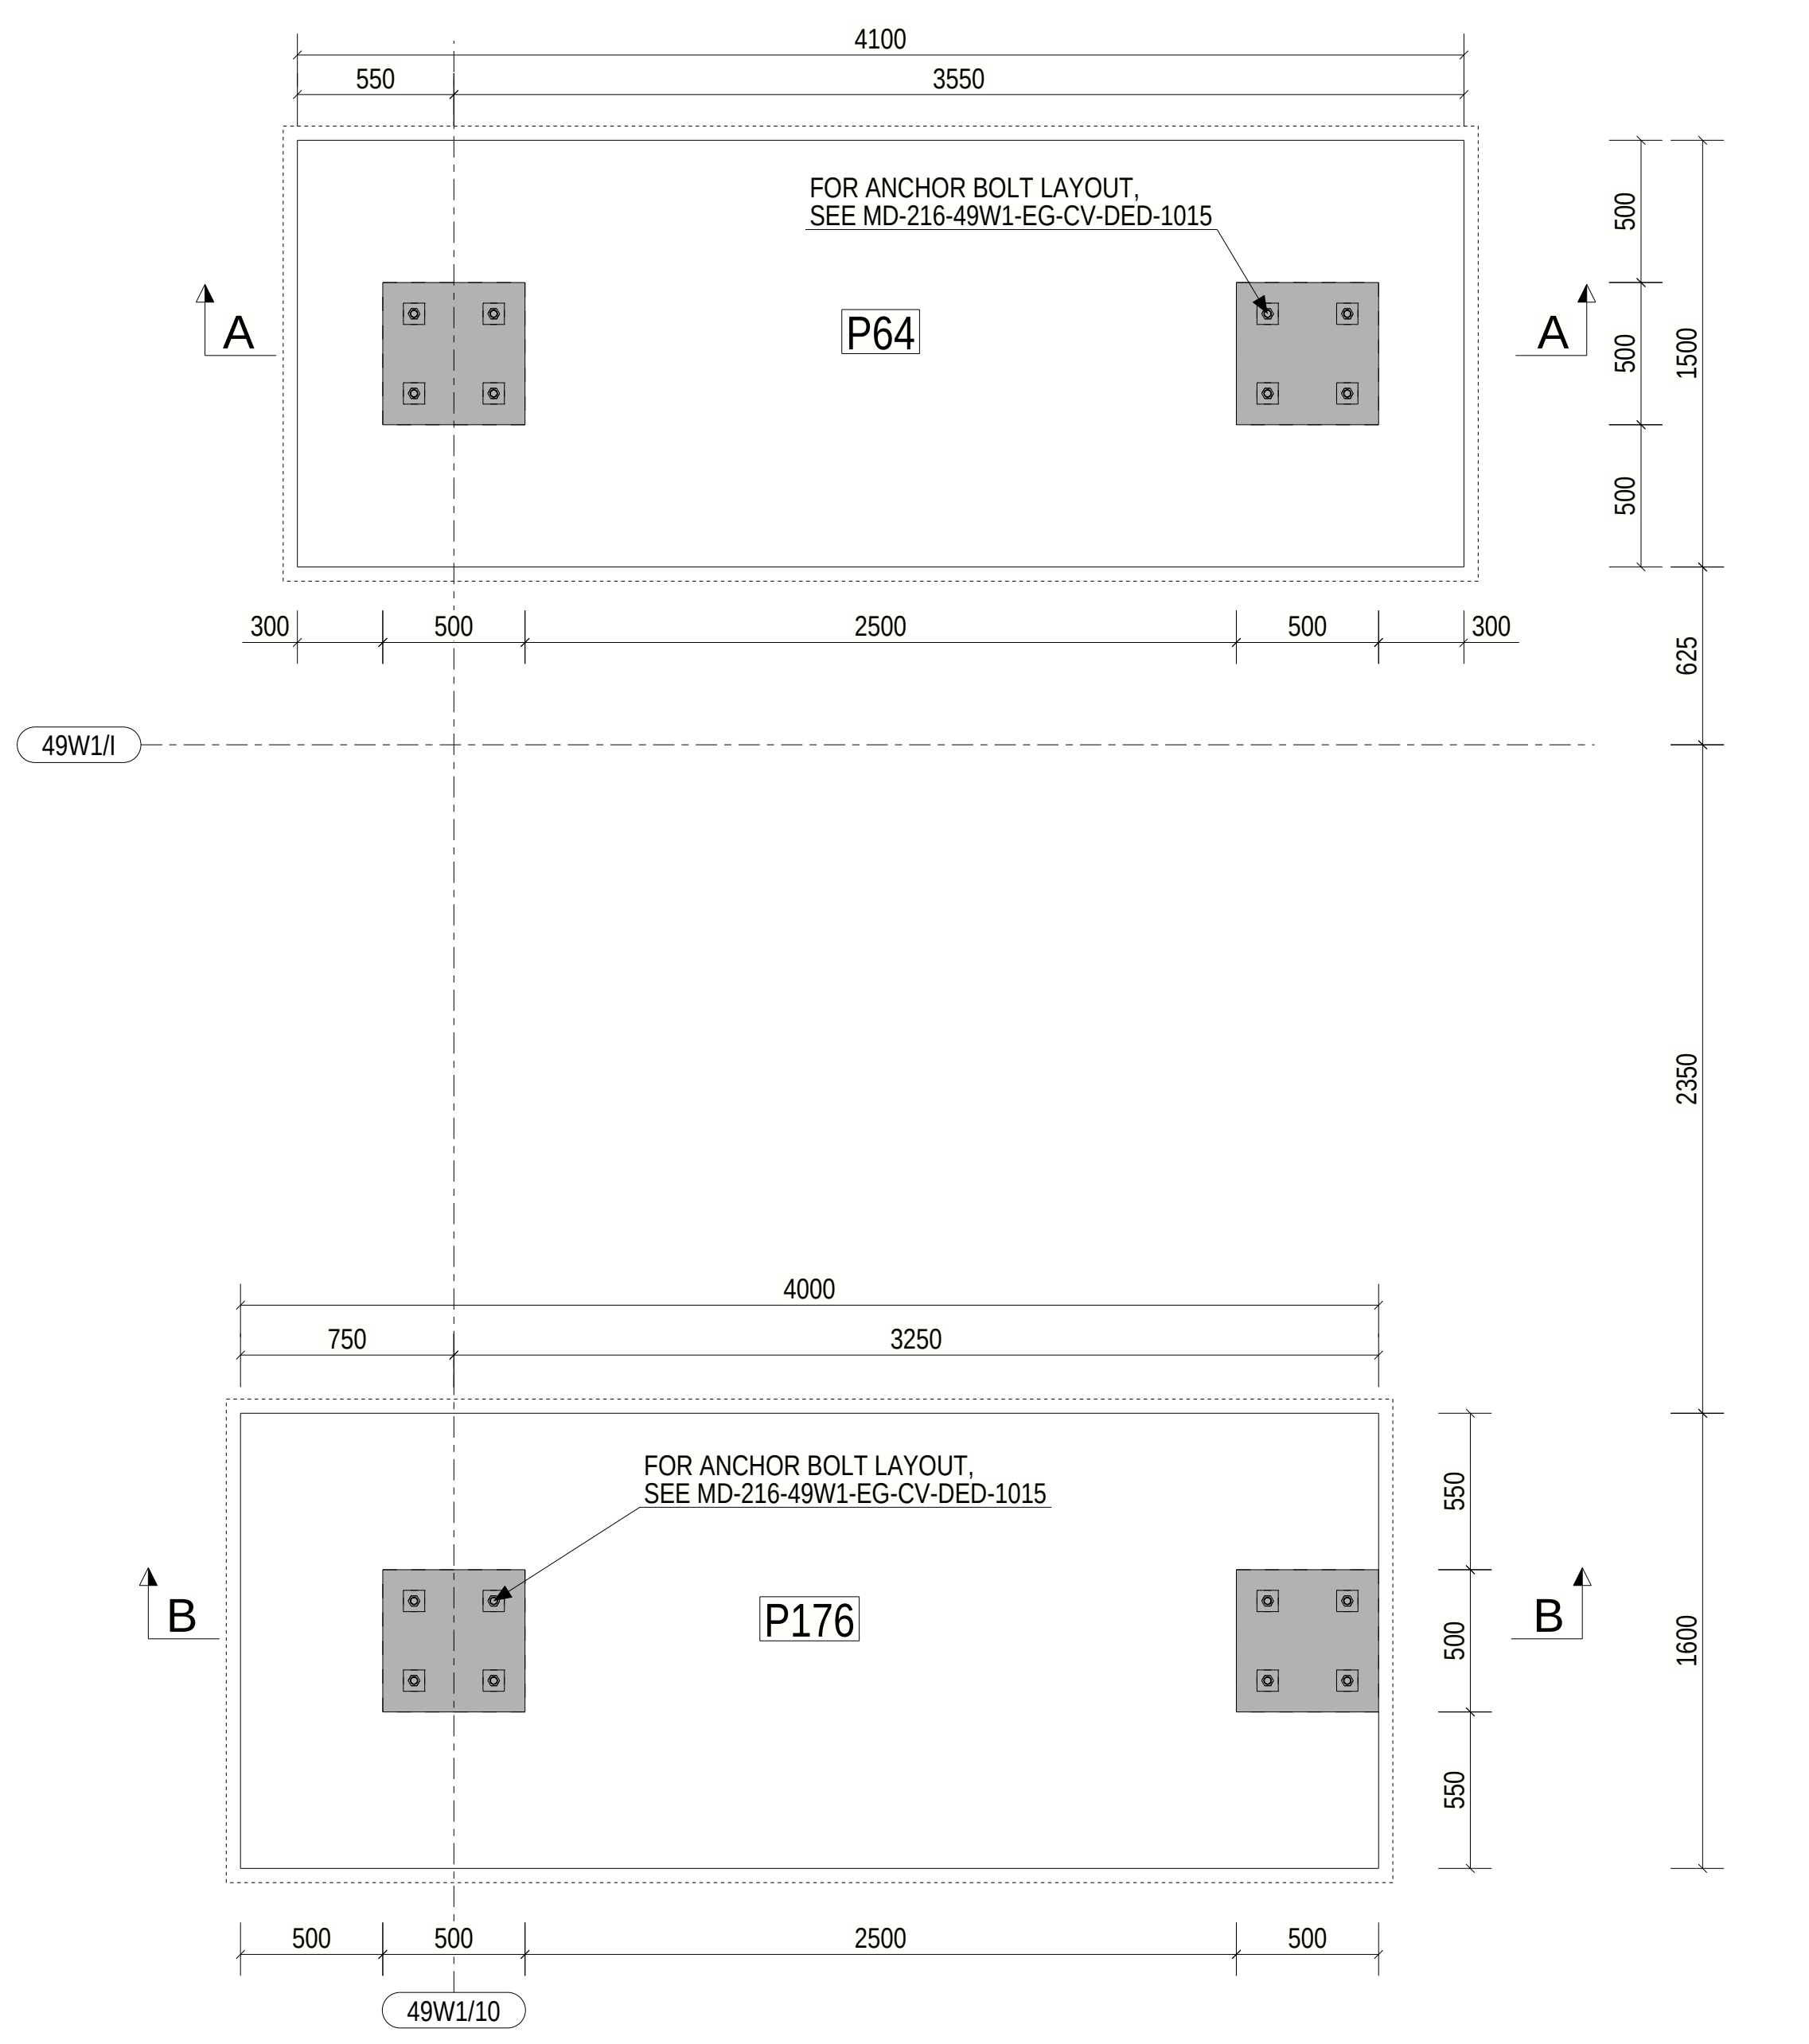

DETAIL OF FOUNDATIONS MKD. P64 AND P176
(SCALE 1:25)

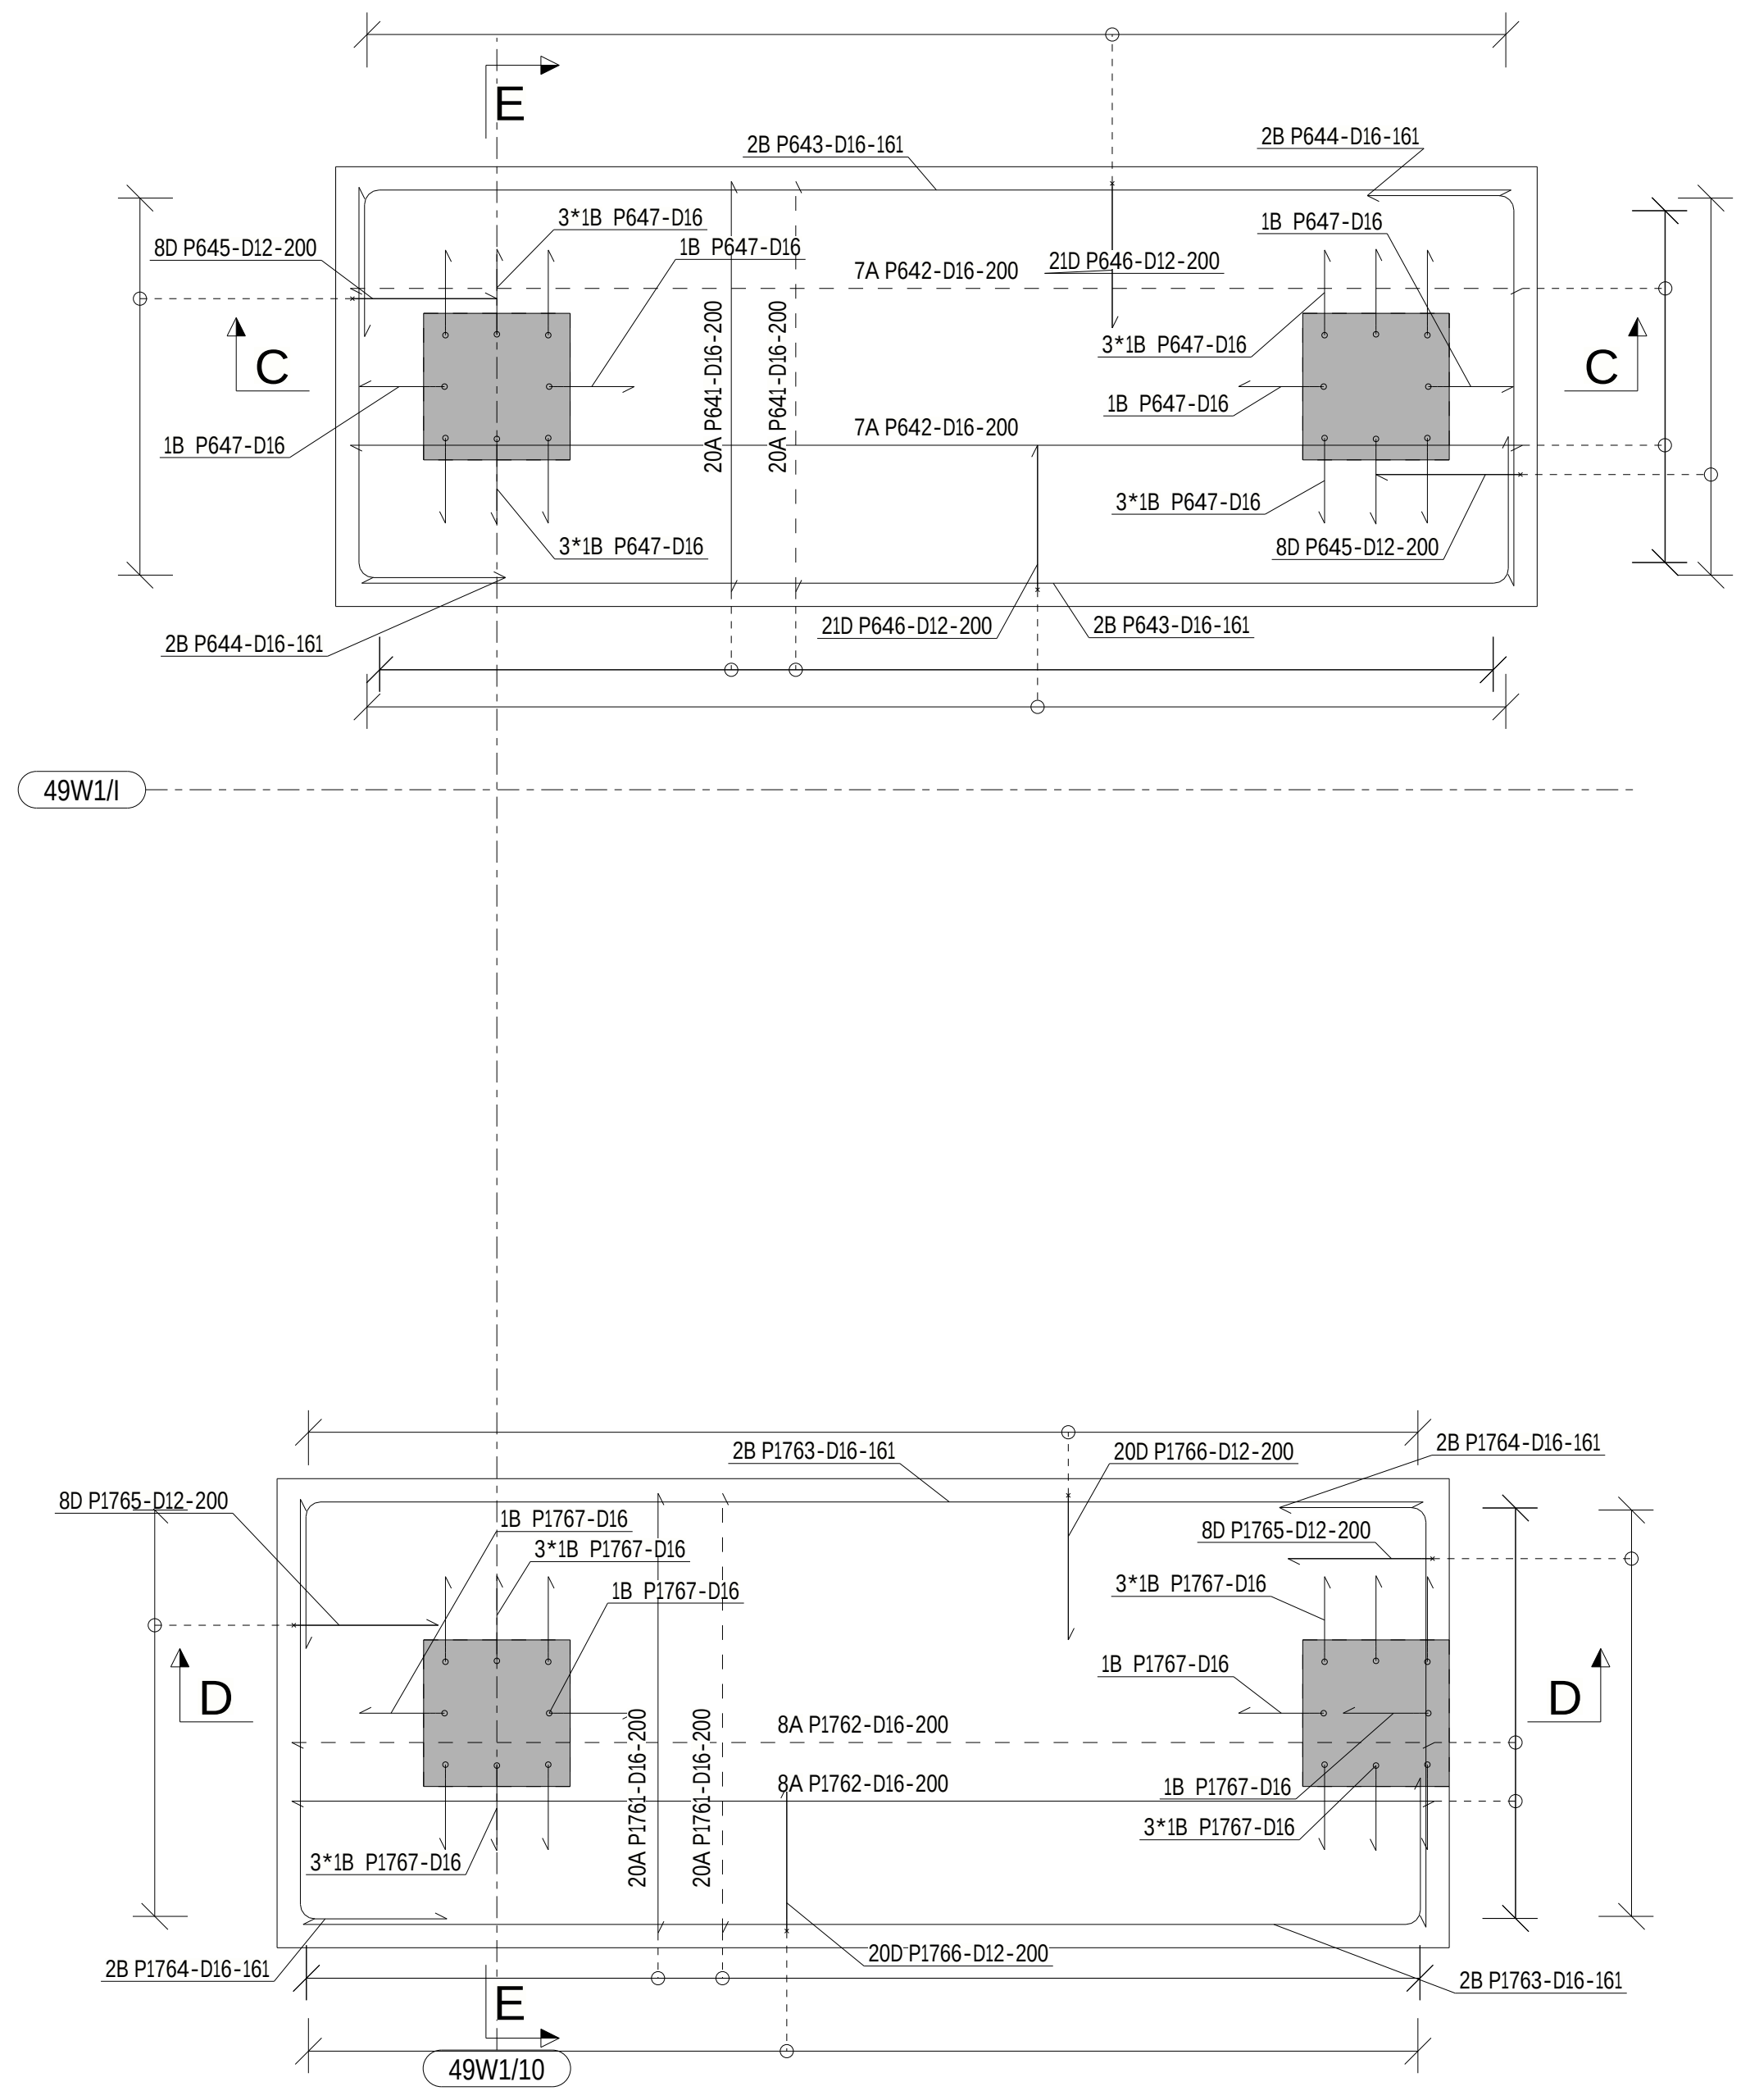

R.C.C. DETAIL OF FOUNDATIONS MKD. P64 AND P176
(SCALE 1:25)

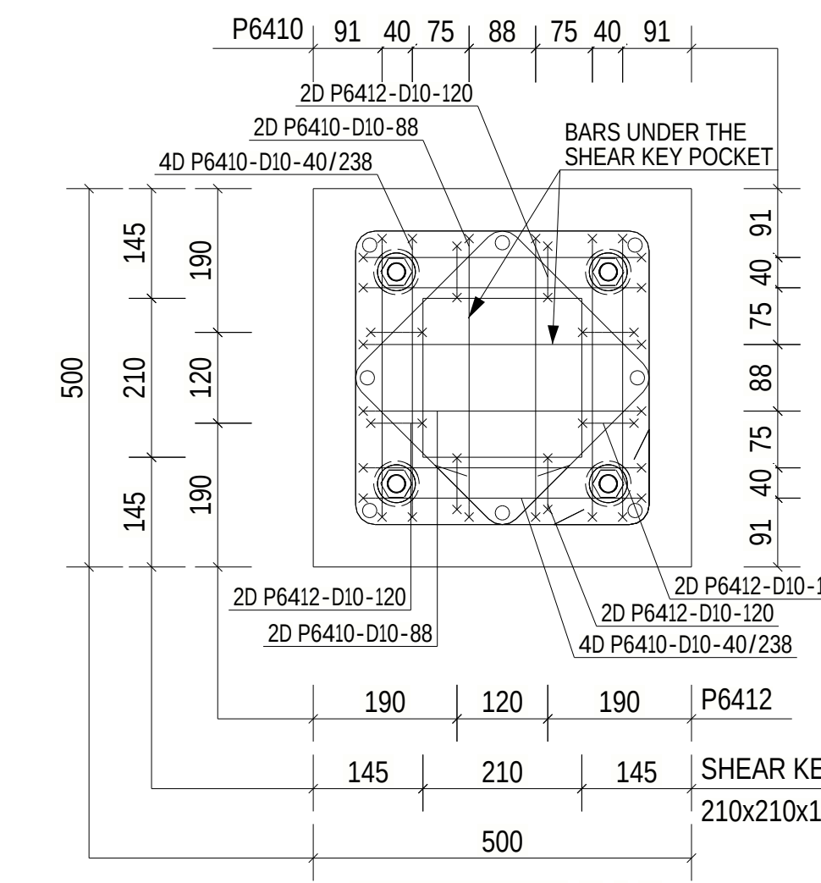

SECTION : 1 - 1
(SCALE 1:10)

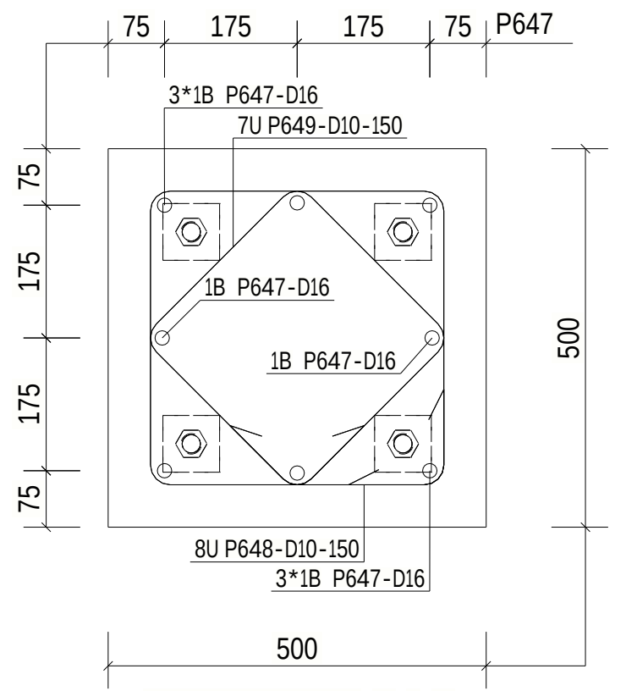

SECTION : 2 - 2
(SCALE 1:10)

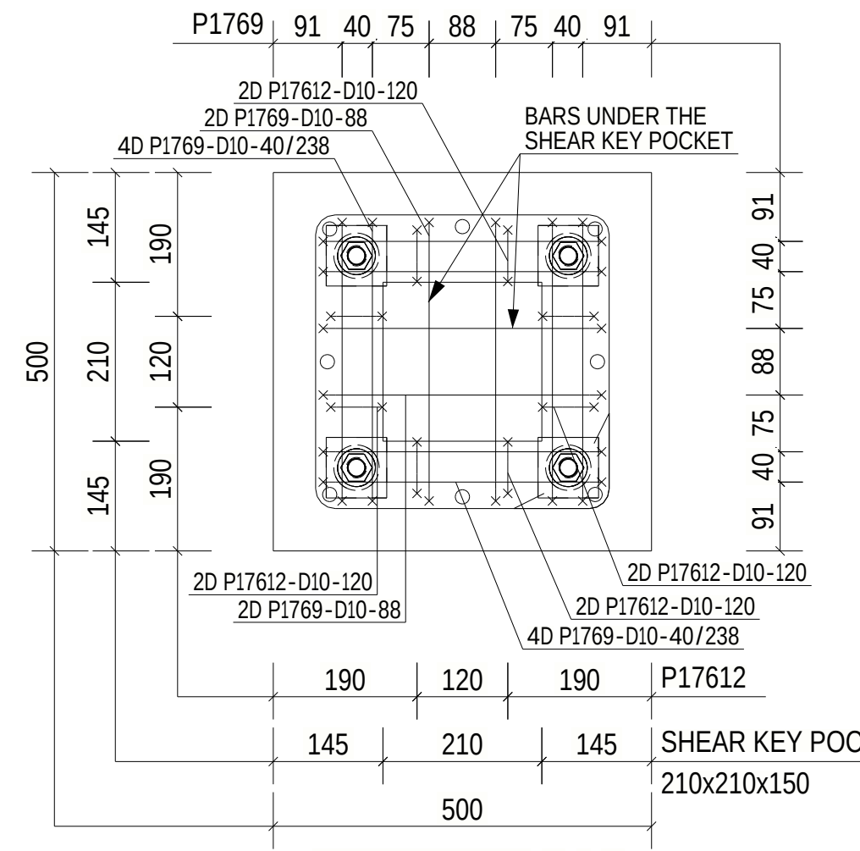

SECTION : 3 - 3
(SCALE 1:10)

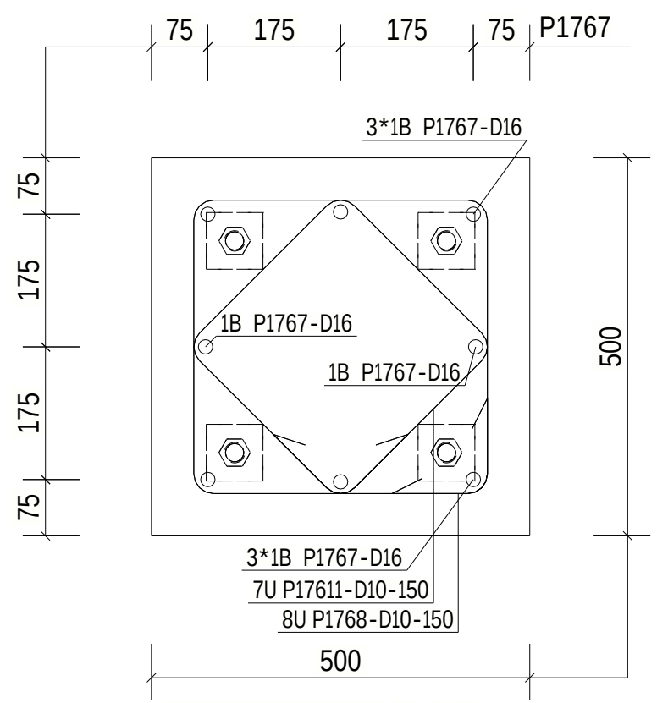

SECTION : 4 - 4
(SCALE 1:10)

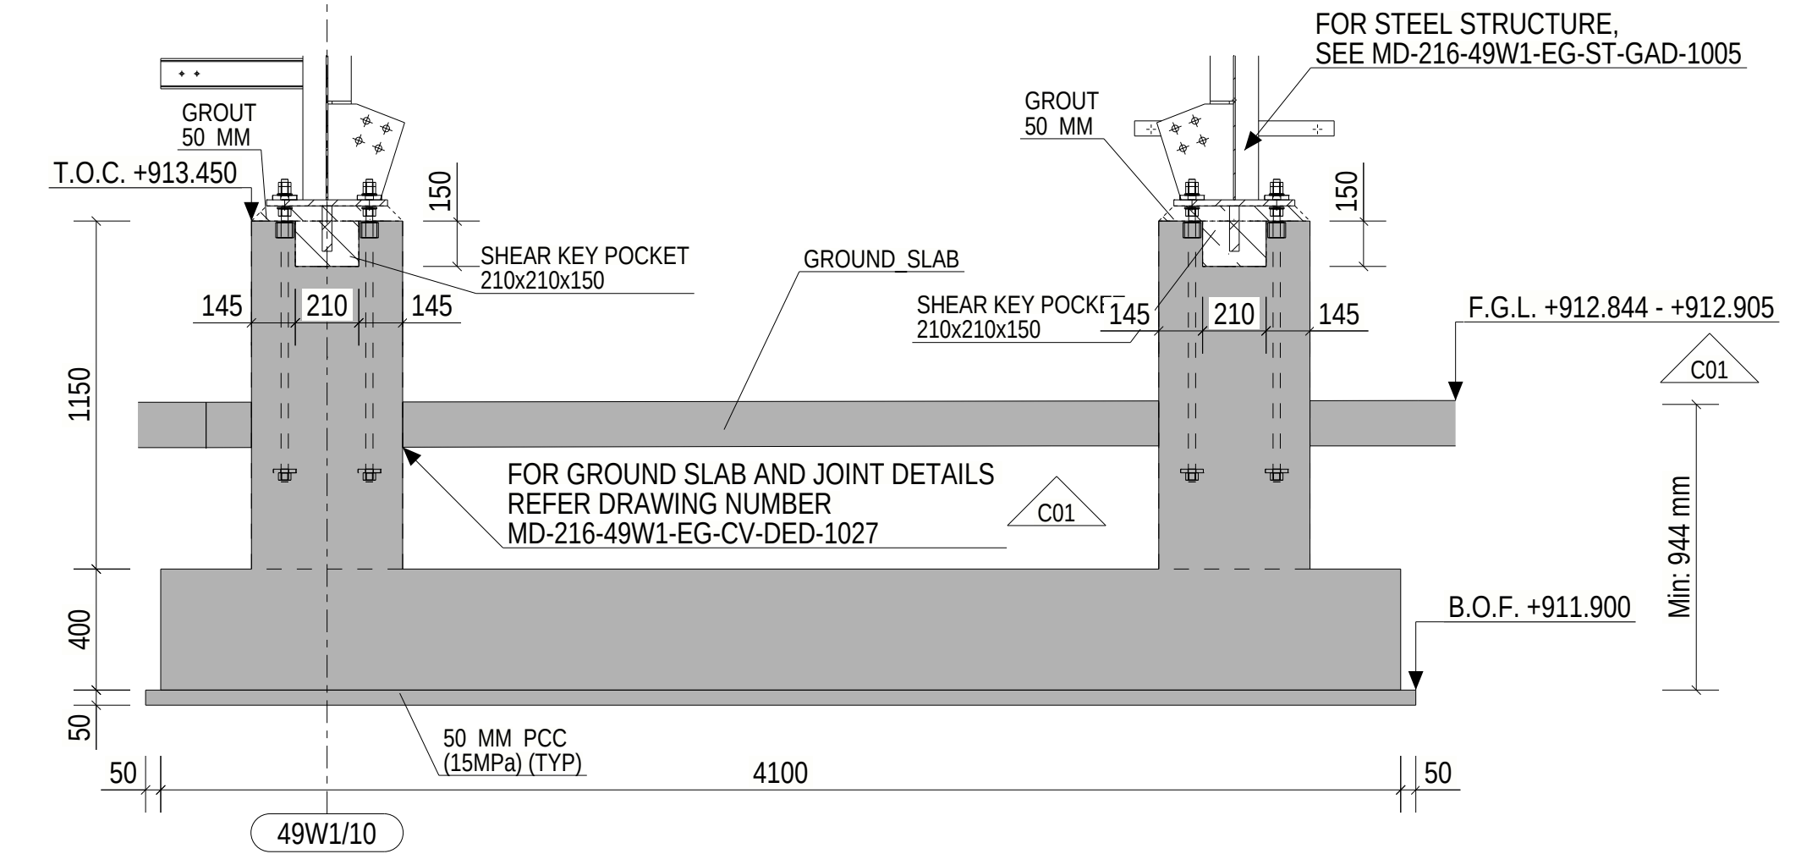

SECTION : A - A
(SCALE 1:25)

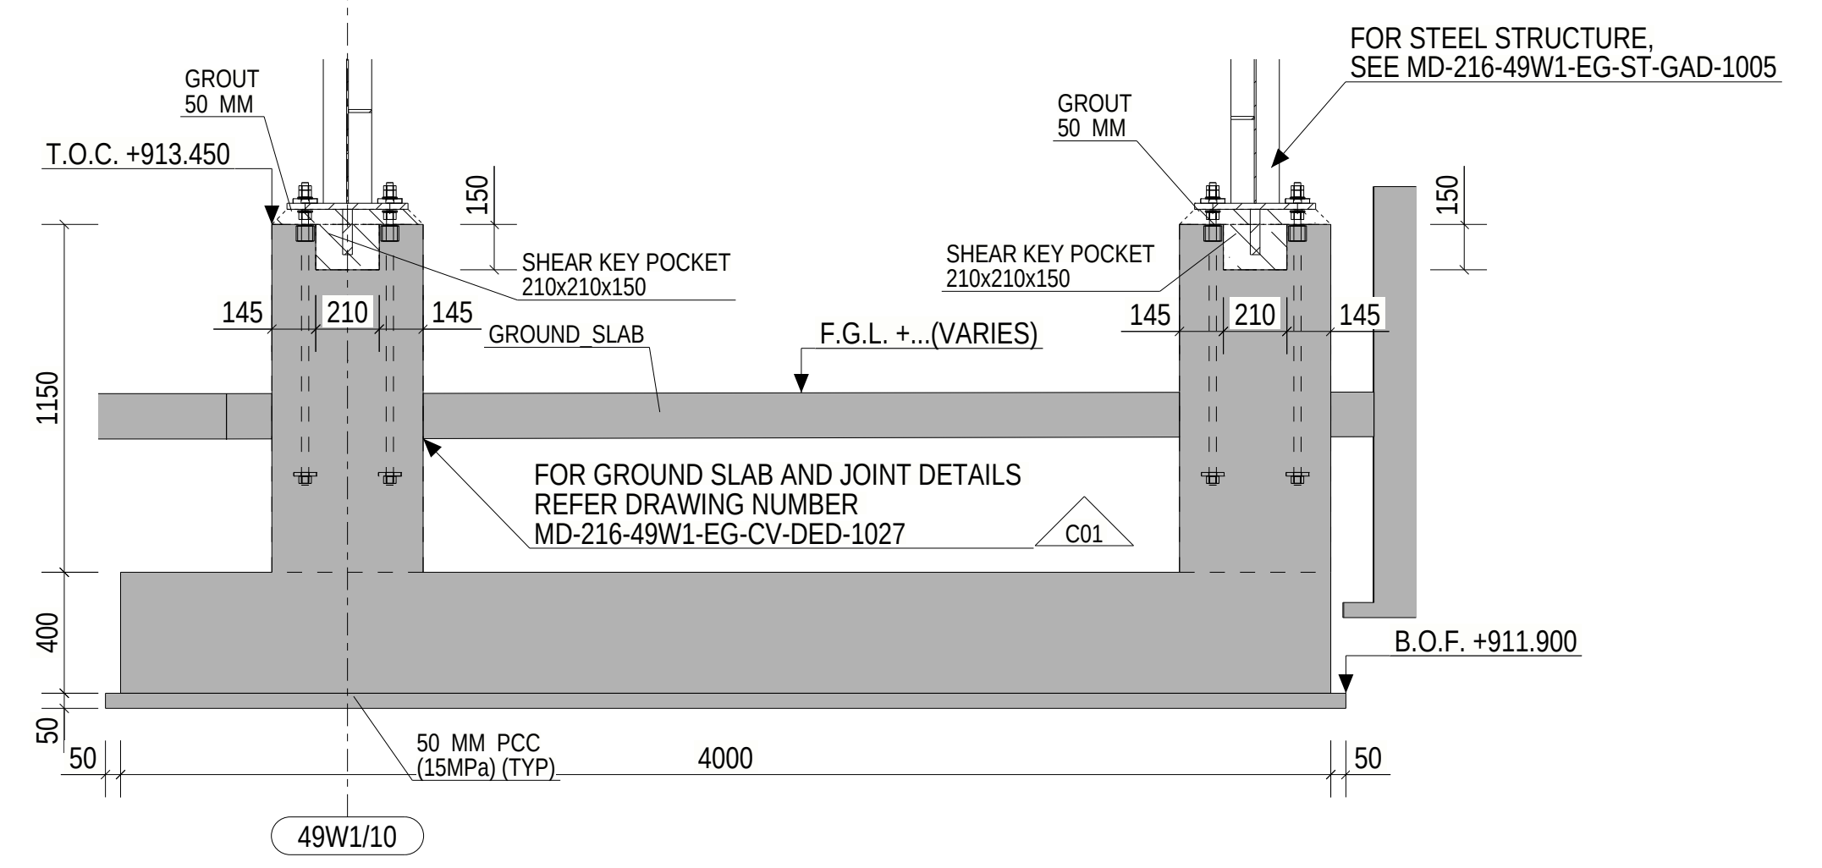

SECTION : B - B
(SCALE 1:25)

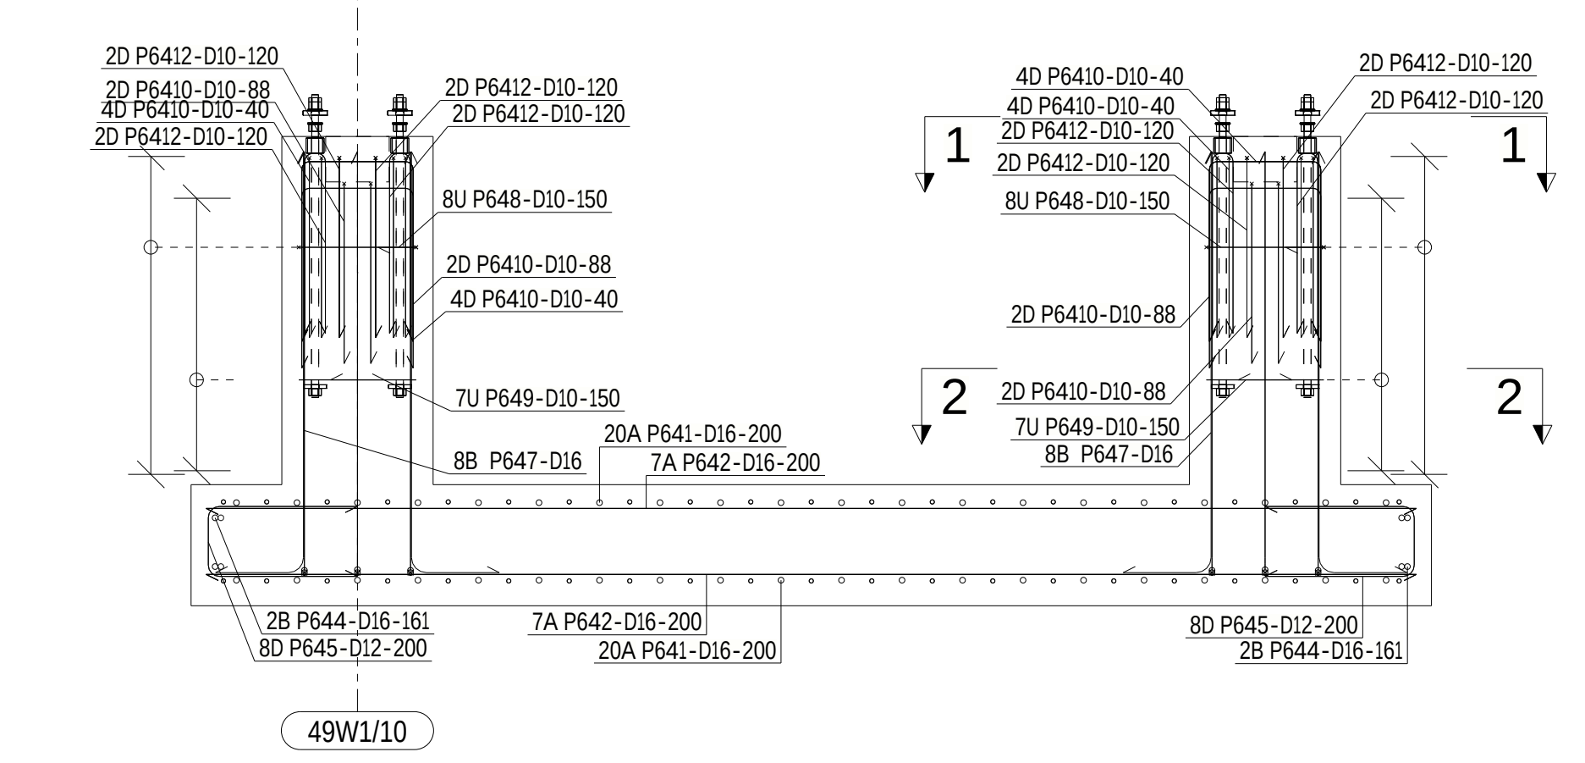

SECTION : C - C
(SCALE 1:25)

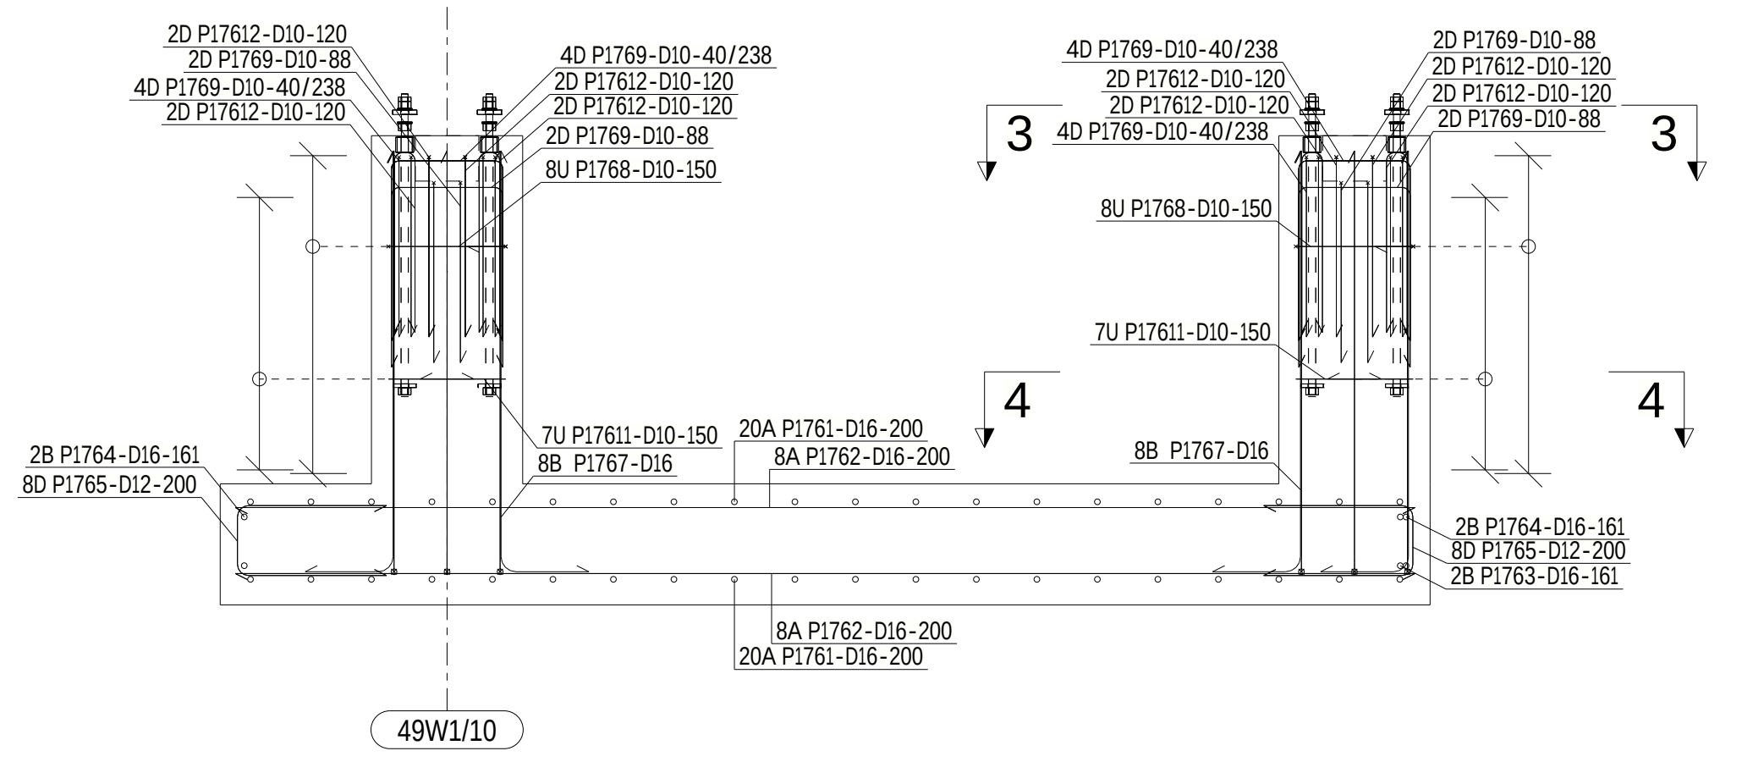

SECTION : D - D
(SCALE 1:25)

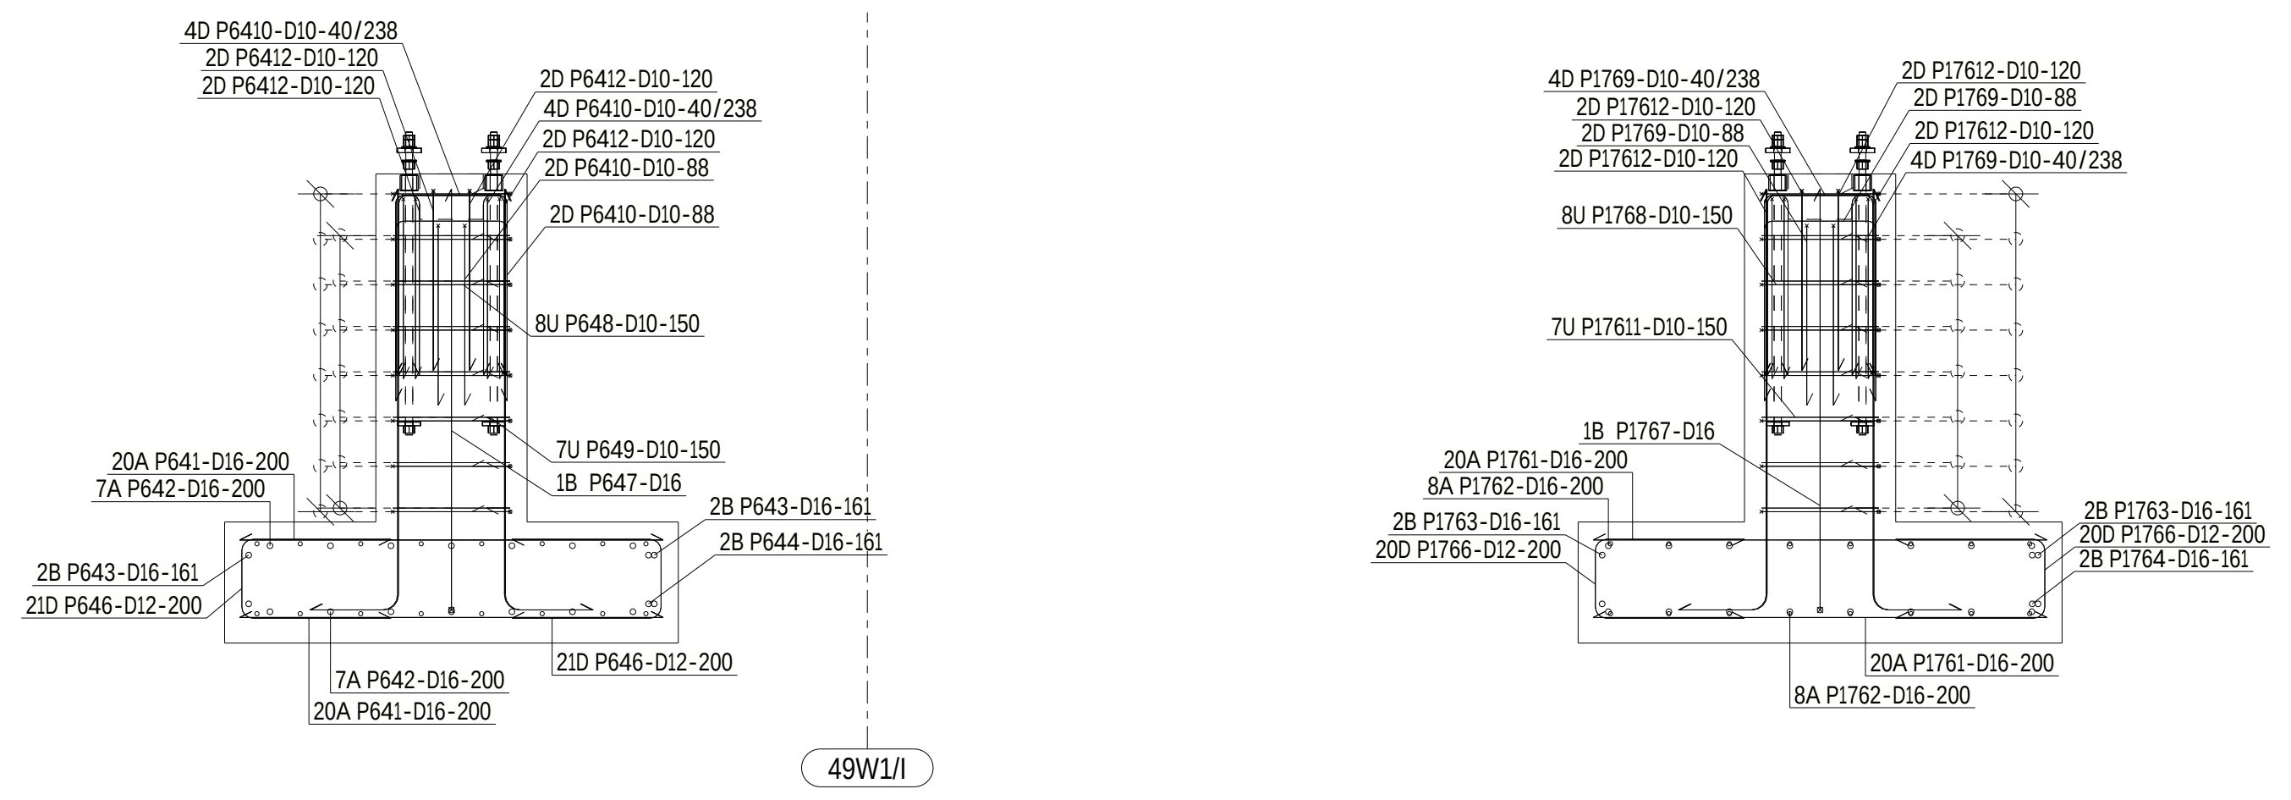

SECTION : E - E
(SCALE 1:25)

CONCRETE INFORMATION

Concretes used	C35	
Concrete cover 1	75±10mm	BOTTOM OF SLAB
Concrete cover 2	50±10mm	SIDES AND TOP OF SLAB, WALLS, BEAMS AND COLUMNS

REINFORCING BAR LIST

CAST UNIT CODE: P64 PCS: 1

REINFORCING BARS TYPE	POS	PCS	GRADE	D [mm]	L [mm]	dL [mm]	WEIGHT SUM [kg]	BENDING DIMENSIONS [mm] a	b	c	d	e	u	v	x	TD	COMMENT
A	P641	40	B500B	16	1400		88.5	1400									
A	P642	14	B500B	16	4000		88.5	4000									
B	P643	4	B500B	16	4390		27.8	3922	509				90			80	
B	P644	4	B500B	16	1810		11.4	1341	509				90			80	
D	P645	16	B500B	12	1180		16.8	500	245	500						60	
D	P646	42	B500B	12	1210		45.3	500	275	500						60	
B	P647	16	B500B	16	1650		41.9	1400	300				90			80	
U	P648	16	B500B	10	1740		17.3	132	400	400	400	400				40	
U	P649	14	B500B	10	1350		11.7	132	301	301	301	301				40	
D	P6410	24	B500B	10	1530		22.7	600	380	600						40	
D	P6412	16	B500B	10	1230		12.2	600	80	600						40	

REINFORCING BAR TOTAL WEIGHT [kg] 384.1

REINFORCING BAR LIST

CAST UNIT CODE: P116 PCS: 1

REINFORCING BARS TYPE	POS	PCS	GRADE	D [mm]	L [mm]	dL [mm]	WEIGHT SUM [kg]	BENDING DIMENSIONS [mm] a	b	c	d	e	u	v	x	TD	COMMENT
Q	0(?)	116	B500B	16	1760		321.2	569	170	519	388		22		219	80	
4	AT GROUP	77	PCS	...	1670	2	...	571	166	424	386		27		218		

REINFORCING BAR TOTAL WEIGHT [kg] 321.2

REINFORCING BAR LIST

CAST UNIT CODE: P176 PCS: 1

REINFORCING BARS TYPE	POS	PCS	GRADE	D [mm]	L [mm]	dL [mm]	WEIGHT SUM [kg]	BENDING DIMENSIONS [mm] a	b	c	d	e	u	v	x	TD	COMMENT
A	P1761	40	B500B	16	1500		94.8	1500									
A	P1762	16	B500B	16	3900		98.6	3900									
B	P1763	4	B500B	16	4290		27.1	3822	509				90			80	
B	P1764	4	B500B	16	1910		12.1	1441	509				90			80	
D	P1765	16	B500B	12	1180		16.8	500	245	500						60	
D	P1766	40	B500B	12	1210		43.2	500	275	500						60	
B	P1767	16	B500B	16	1650		41.9	1400	300				90			80	
U	P1768	16	B500B	10	1740		17.3	132	400	400	400	400				40	
D	P1769	24	B500B	10	1530		22.7	600	380	600						40	
U	P17611	14	B500B	10	1350		11.7	132	301	301	301	301				40	
D	P17612	16	B500B	10	1230		12.2	600	80	600						40	

REINFORCING BAR TOTAL WEIGHT [kg] 398.4

REINFORCEMENT BENDING SHAPES:

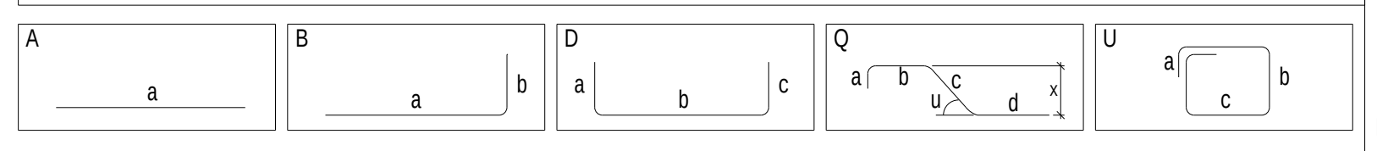

LEGEND:

R.L. - REDUCED LEVEL
T.O.C. - TOP OF CONCRETE
B.O.F. - BOTTOM OF FOUNDATION
F.G.L. - FINISHED GROUND LEVEL
P.C.C. - PLAIN CEMENT CONCRETE
TYP - TYPICAL
MKD - MARKED
CL - CENTER LINE
BOTTOM REINF. (B)
TOP REINF. (T)
SBC - SAFE BEARING CAPACITY
MIN. - MINIMUM
REF. - REFERED
GA - GENERAL ARRANGEMENT
DWG. - DRAWING
R.C.C. - REINFORCED CEMENT CONCRETE

NOTES:

1. ALL DIMENSIONS ARE IN MILLIMETRES AND LEVELS ARE IN METRES UNLESS OTHERWISE STATED

2. GRADE OF CONCRETE SHALL BE C35 (35MPa) UNLESS NOTED OTHERWISE & C15 (15MPa) FOR BLINDING CONCRETE.

3. GRADE OF REINFORCEMENT SHALL BE DEFORMED BAR ASTM A615-GRADE 60 (fy=420MPa)

4. CLEAR COVER TO MAIN REINFORCEMENT SHALL BE AS FOLLOWS:
a) FOUNDATION: 75 mm (BOTTOM & SIDE)
b) FOUNDATION: 50 mm (TOP)
c) COLUMN & PEDESTAL: 50 mm

5. MINIMUM LAP LENGTHS OF REINFORCEMENT SHALL BE 40XBAR DIAMETER

6. FOR STANDARD REINFORCEMENT DETAILS & GENERAL NOTES FOR CIVIL WORKS REFER TO DRAWING NUMBER MD-216-1000-EG-CV-DED-1005 & 1001

7. ANCHOR BOLTS AND EMBEDDED STEELWORK SHALL BE HOT DIP GALVANIZED

8. T.O.C. & TOP OF SCREED TOLERANCE SHALL BE WITHIN +/- 10MM OF DESIGN LEVEL

9. NET SAFE BEARING CAPACITY OF SOIL AT BOTTOM OF FOUNDATION IS CONSIDERED AS 375 KN/SQ.M.

10. REBARS CAN BE MOVED LOCALLY BY +/- 25mm TO AVOID INTERFERENCE WITH EMBEDDED PARTS

KEYPLAN

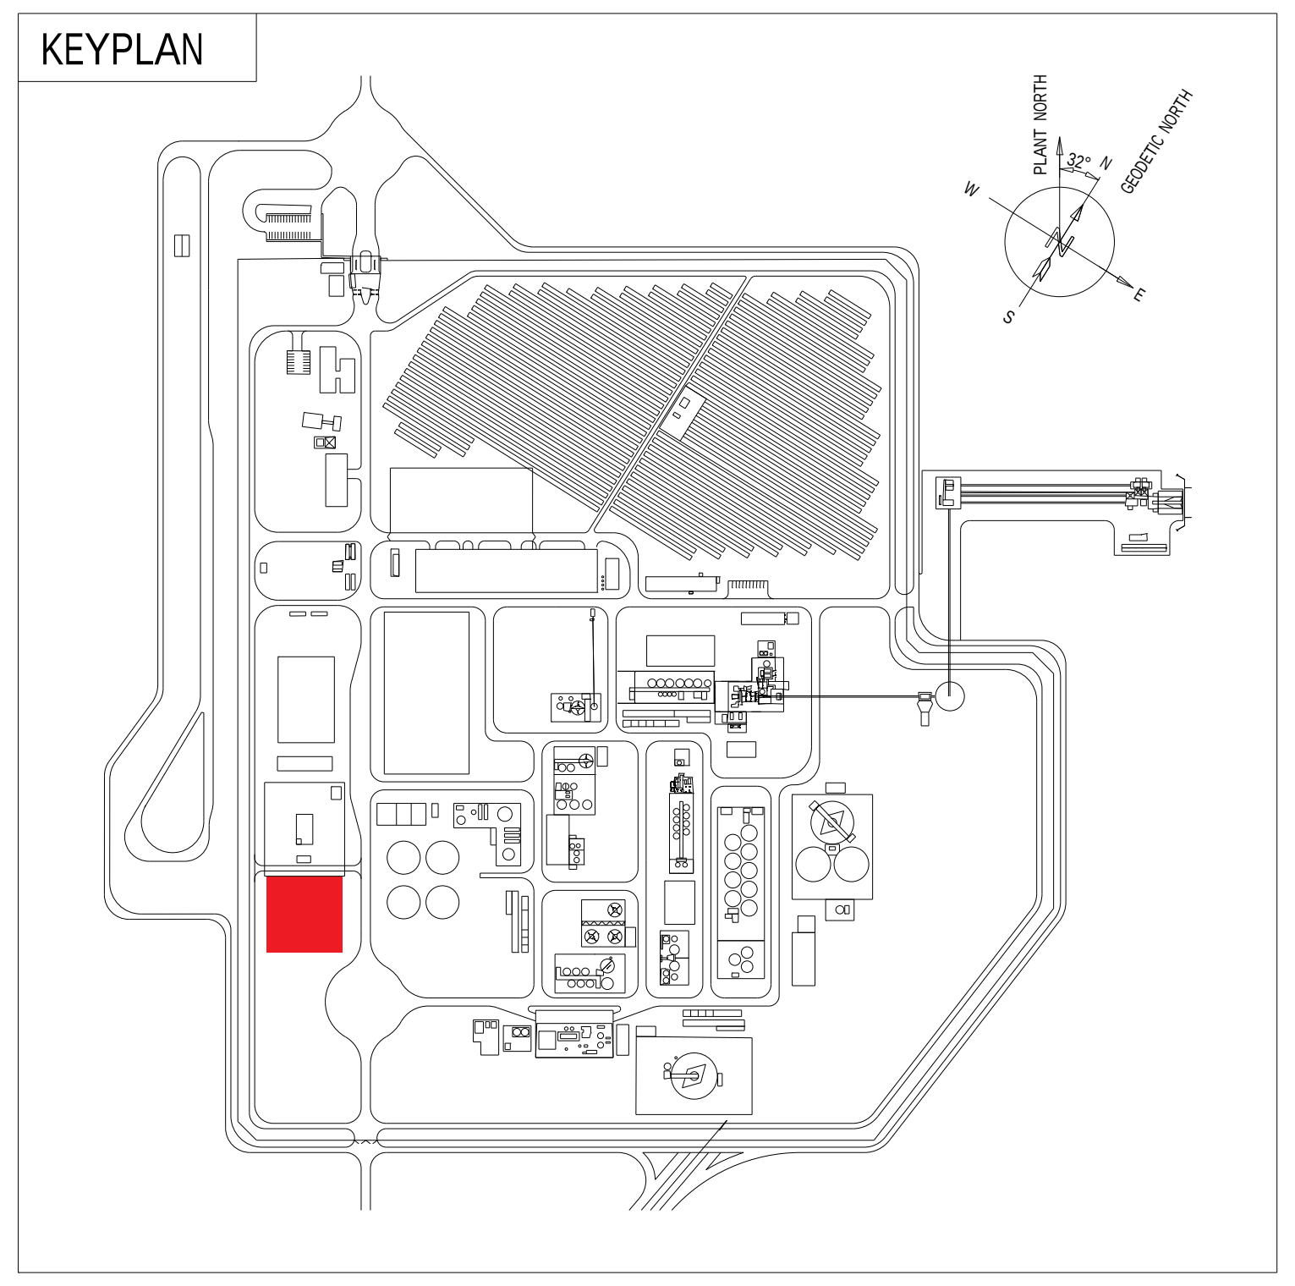

DOCUMENT NUMBER	REFERENCE DOCUMENTS	DOCUMENT NUMBER	REFERENCE DOCUMENTS
MD-216-49W1-EG-ST-GAD-1005	STEEL STR. OF BACKWASH TANK STAIRCASE & PUMP PL.	MD-216-49W1-EG-CV-DED-1027	SLAB SECTOR GL G-J/5-10
MD-216-49W1-EG-CV-GAD-1002	GENERAL ARRENGEMENT, 7-12/E-J	MD-216-49W1-EG-CV-DED-1015	ANCHOR BOLT PLAN 2

REV	DATE	REVISION DESCRIPTION	DRN	CHK	ENG	APP	EMP
D01	29.01.2024	AS-BUILT	MaxChi	MauNot	LuiPiz		
C01	25.01.2022	ISSUED FOR CONSTRUCTION	MaxChi	MauNot	LuiPiz	SouCha	
A01	04.01.2022	ISSUED FOR APPROVAL	KalKar	MauNot	NanWu	LuiPiz	

RESERVED FOR VENDOR LOGO AND DRAWING NUMBER

LARSEN & TOUBRO DRAWING NUMBER
019045_080_C_D_24892_022
REVISION
2

OUTOTEC DRAWING NUMBER
900707_GAU01_AG11_CTB01_49022
DOCUMENT ID
OU100736748
REVISION
2

This drawing is the property of LARSEN & TOUBRO and must not be passed on to any person or body not authorized by us to recieve it or be copied or otherwise made use either in full or in part by such person or body without our prior permission in writing.

The content of these documents are the sole property of Outotec Oyj. Any rights not expressly granted herein are reserved. Reproduction, transfer or distribution of part or all of the contents in any form without prior written permission of Outotec is prohibited.

This document and the information contained herein is Ma'aden proprietary know-how. This document or any part thereof should not be reproduced, stored in a retrieval system or transmitted by any means, electronic or otherwise, or divulged without prior written permission of Ma'aden.

DRAWN	KalKar	04.01.2022
CHECKED	MauNot	04.01.2022
ENGINEER	KalKar	04.01.2022
APPROVED	LuiPiz	04.01.2022
EMPLOYER		
SCALE	1:25	A0

MANSOURAH - MASSARAH GOLD PROJECT
49W1 RAW WATER TREATMENT PLANT
GL 10-11/H-J STAIRCASE FOUNDATIONS
DETAIL- AND REINFORCEMENT DRAWING

DRAWING NUMBER
MD-216-49W1-EG-CV-DED-1022
REV
D01

Tekla Structures