MD-216-49W1-EG-CV-DED-1023
DRAWING NUMBER
D01
REV

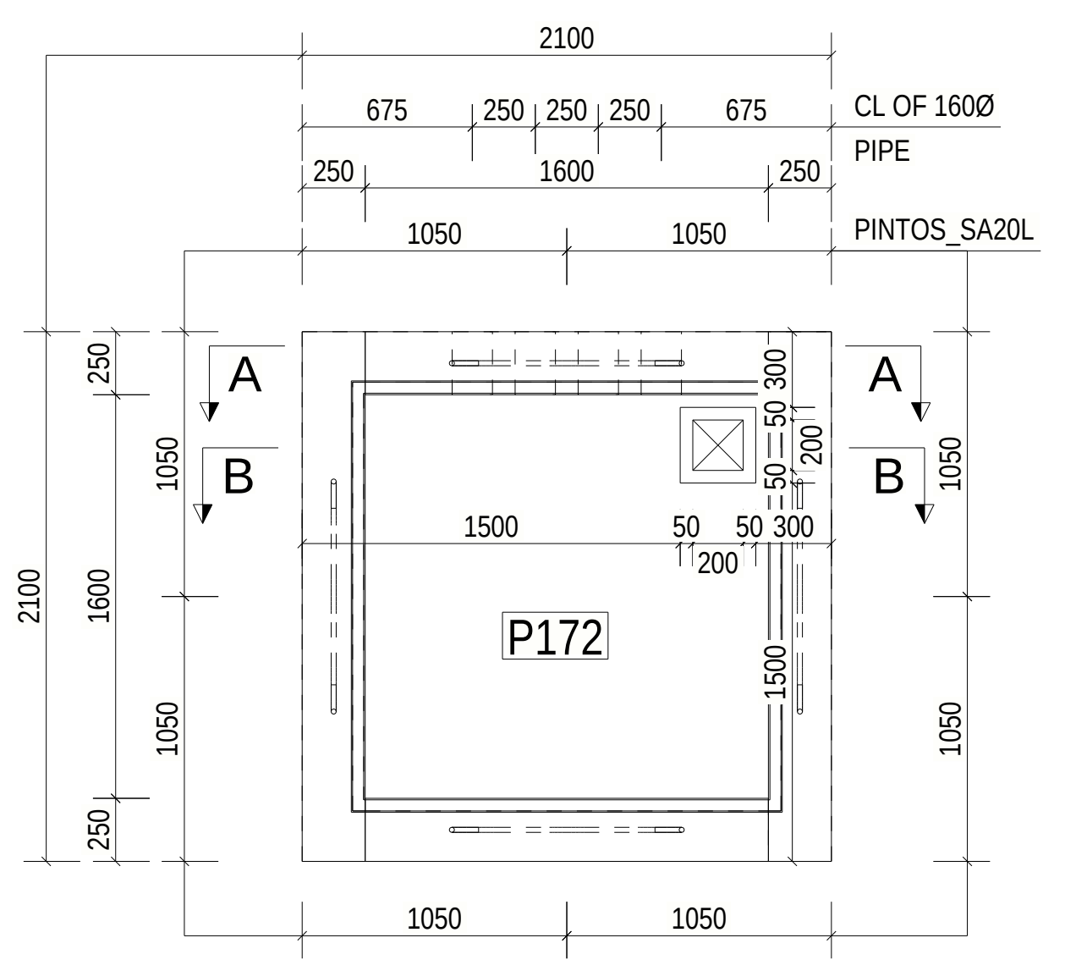

PULLPIT MKD. P172
(SCALE 1:30)

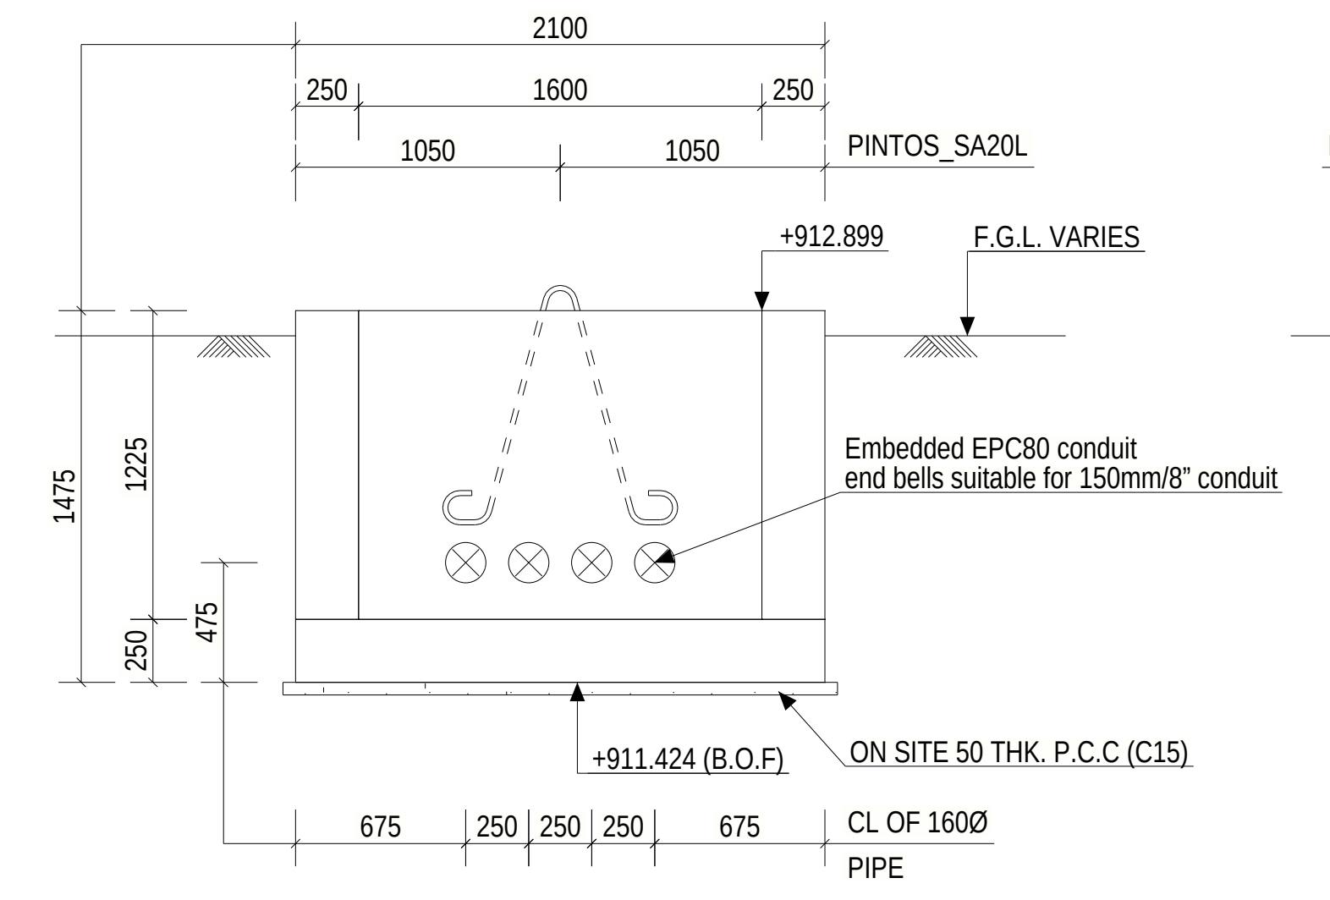

SECTION : A - A
(SCALE 1:30)

THE SAME FOR SECTION C-C OF PULLPIT MKD. P168 AND SECTIONS F-F, G-G OF PULLPIT MKD. P170

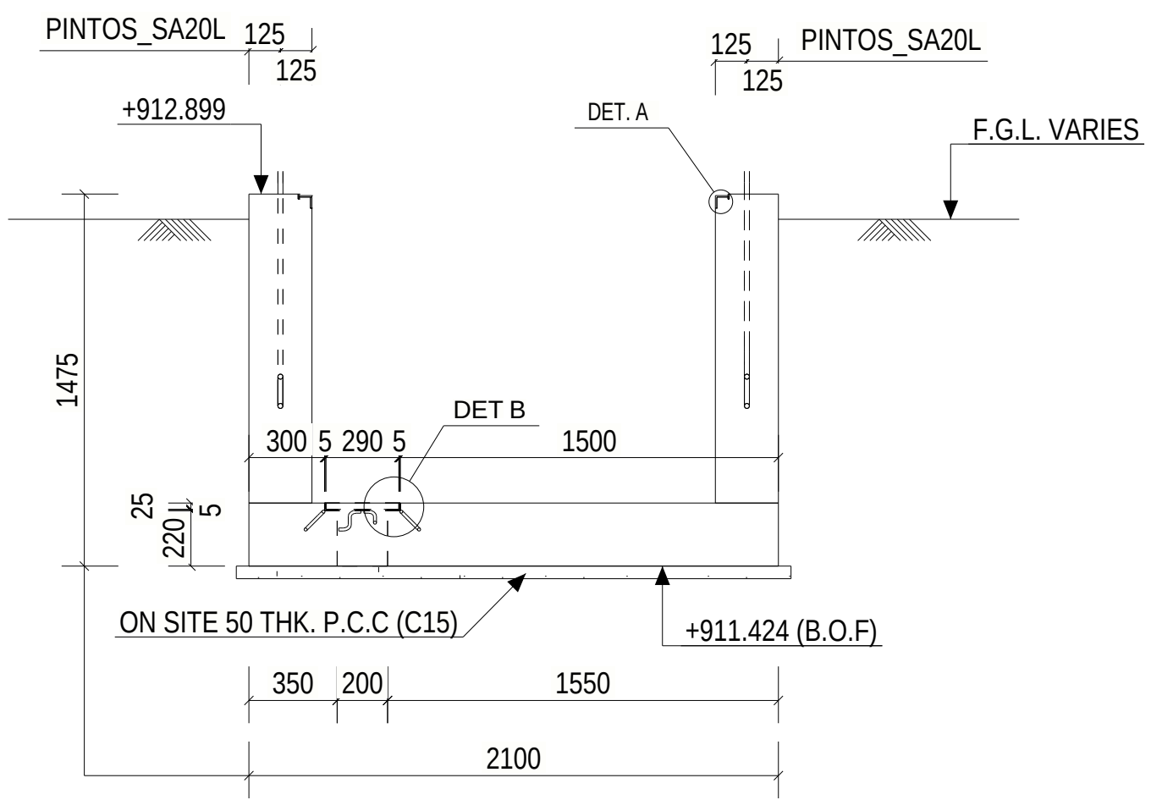

SECTION : B - B
(SCALE 1:30)

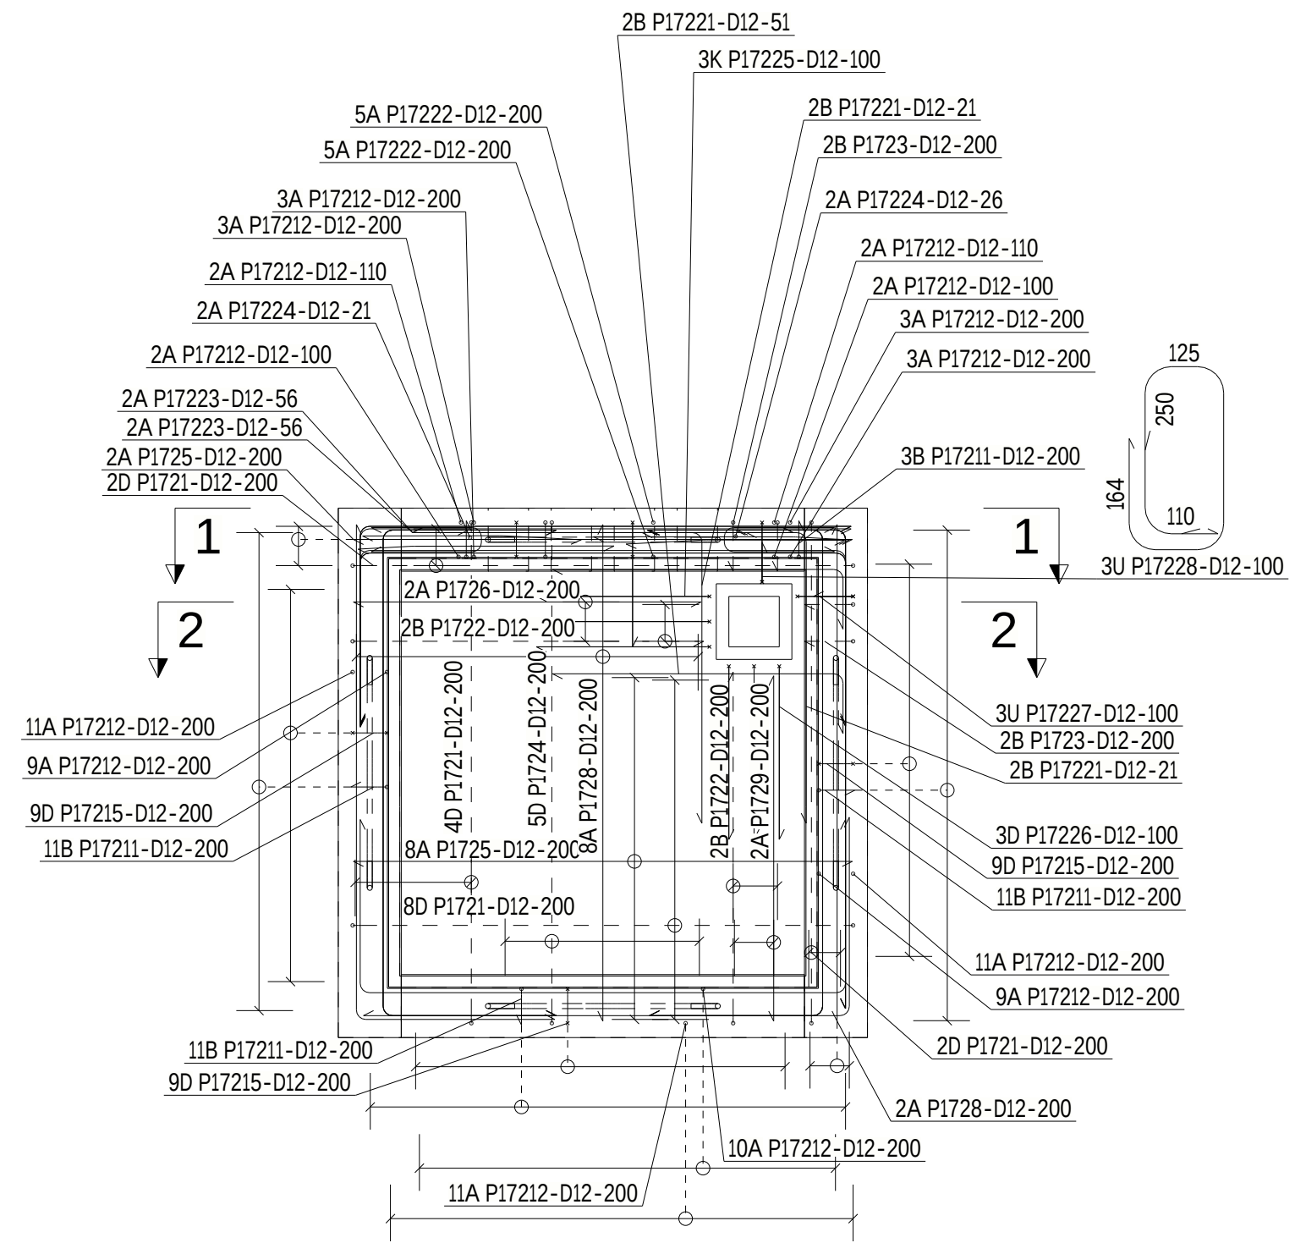

R.C.C. PLAN FOR PULLPIT MKD. P172
(SCALE 1:30)

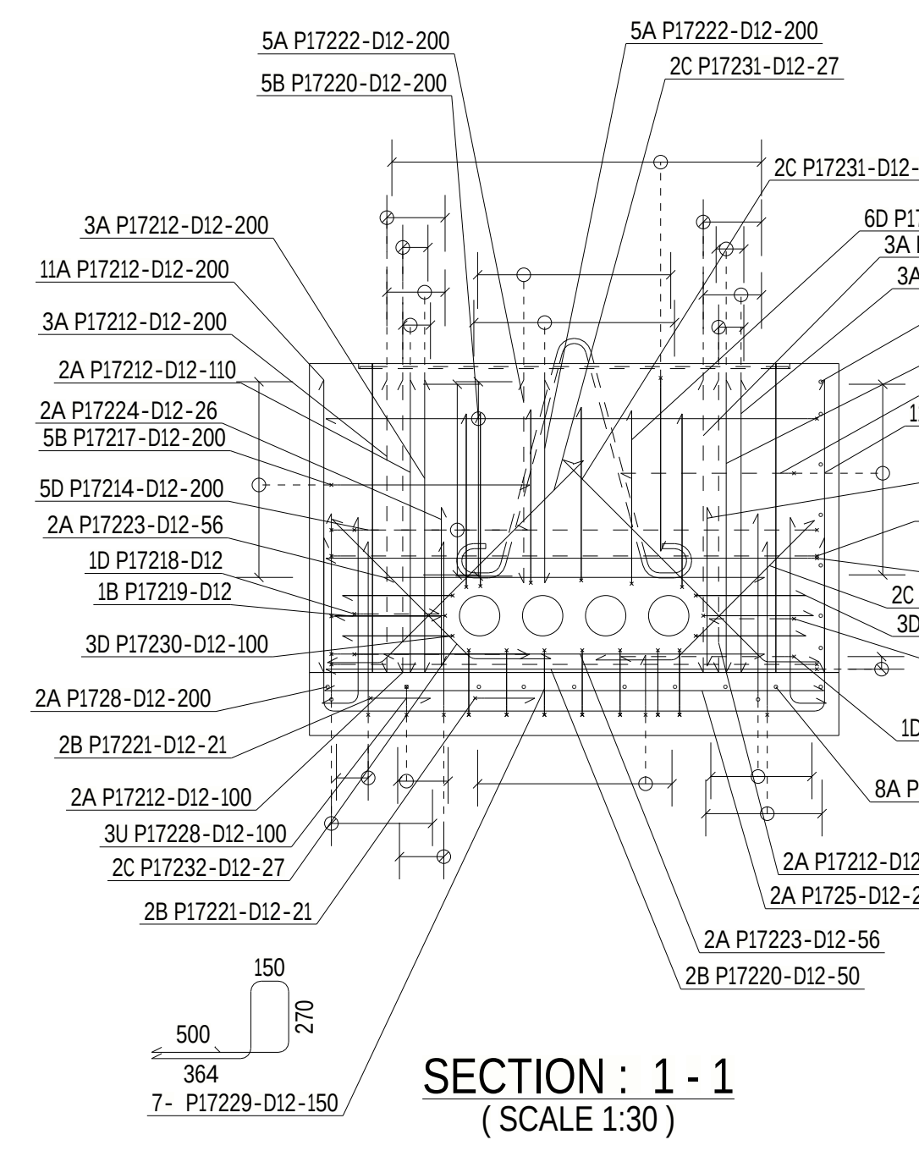

SECTION : 1 - 1
(SCALE 1:30)

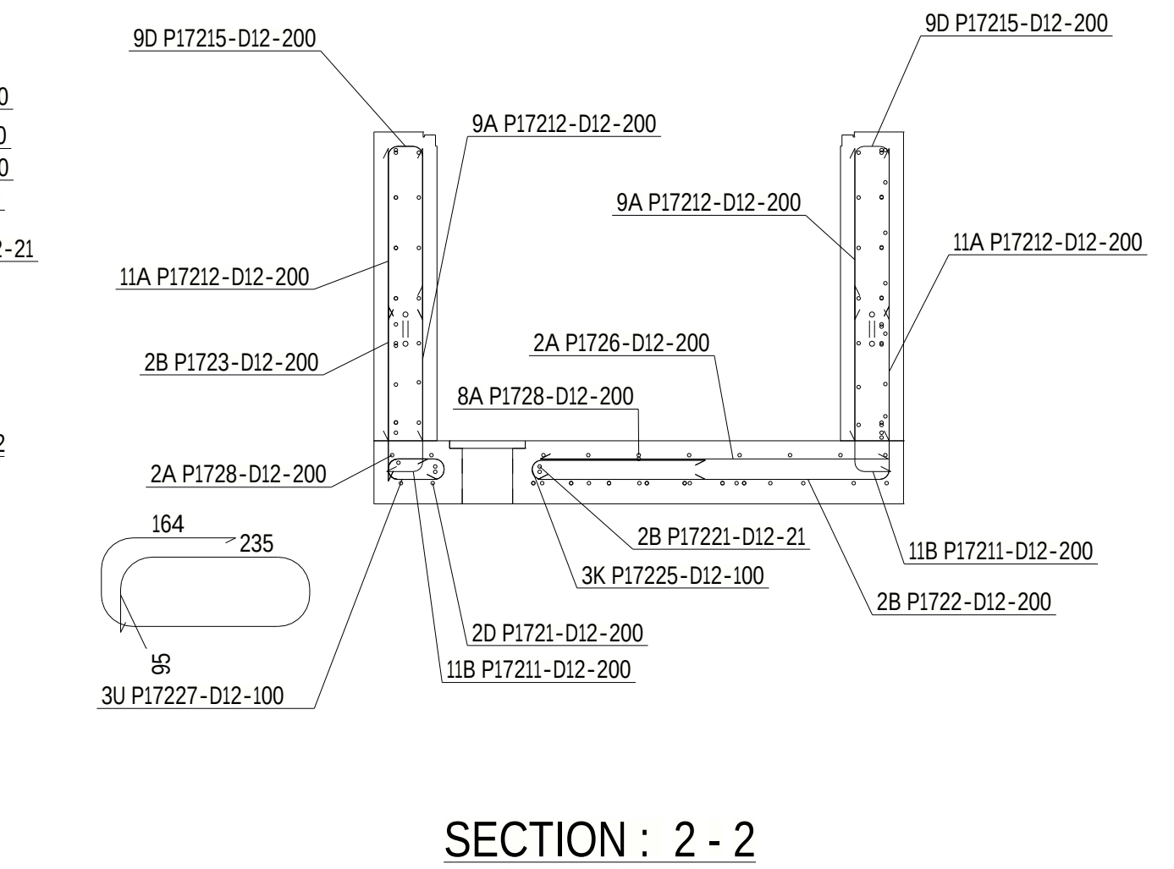

SECTION : 2 - 2
(SCALE 1:30)

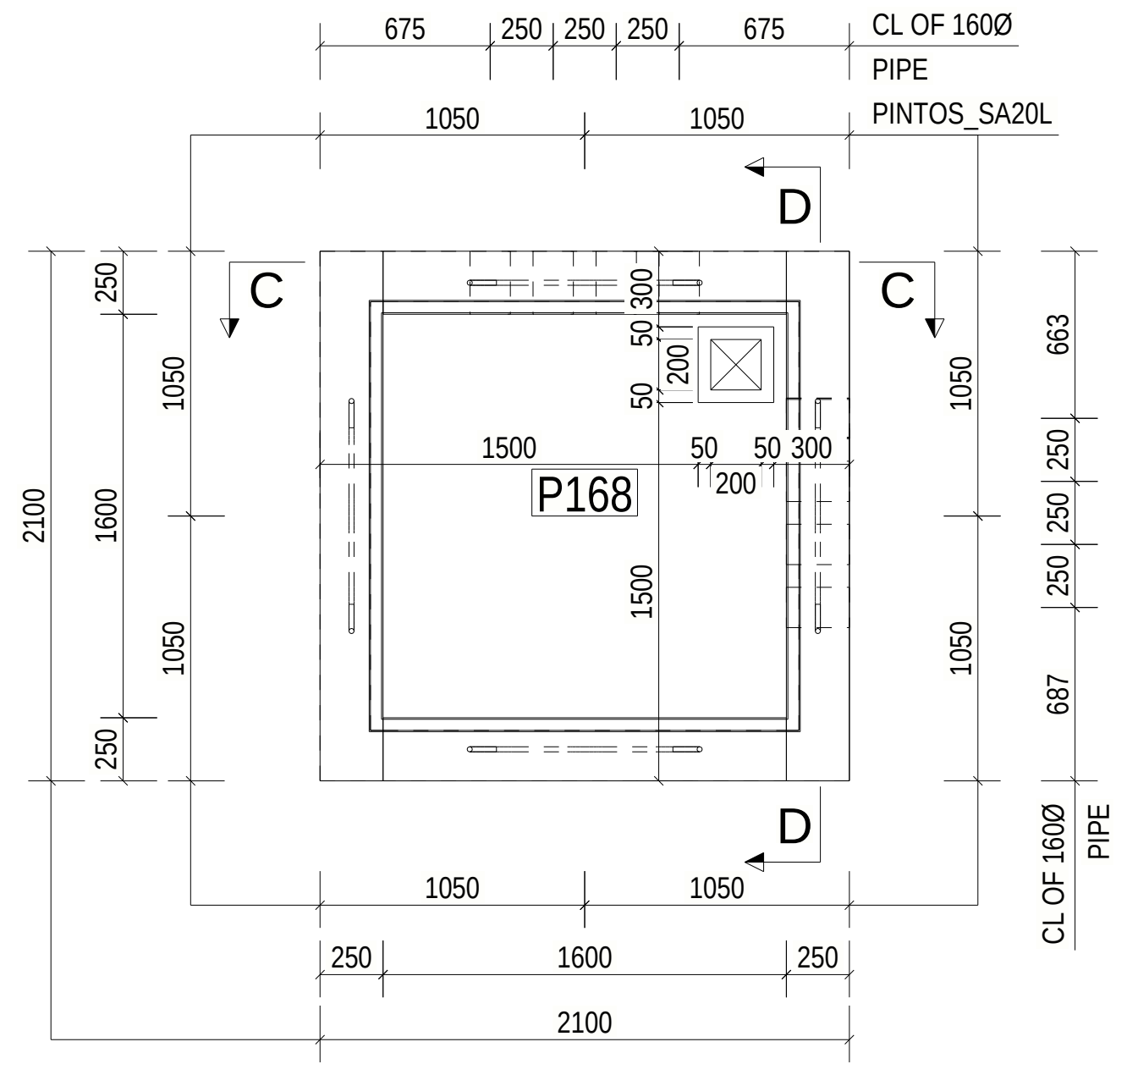

PULLPIT MKD. P168
(SCALE 1:30)

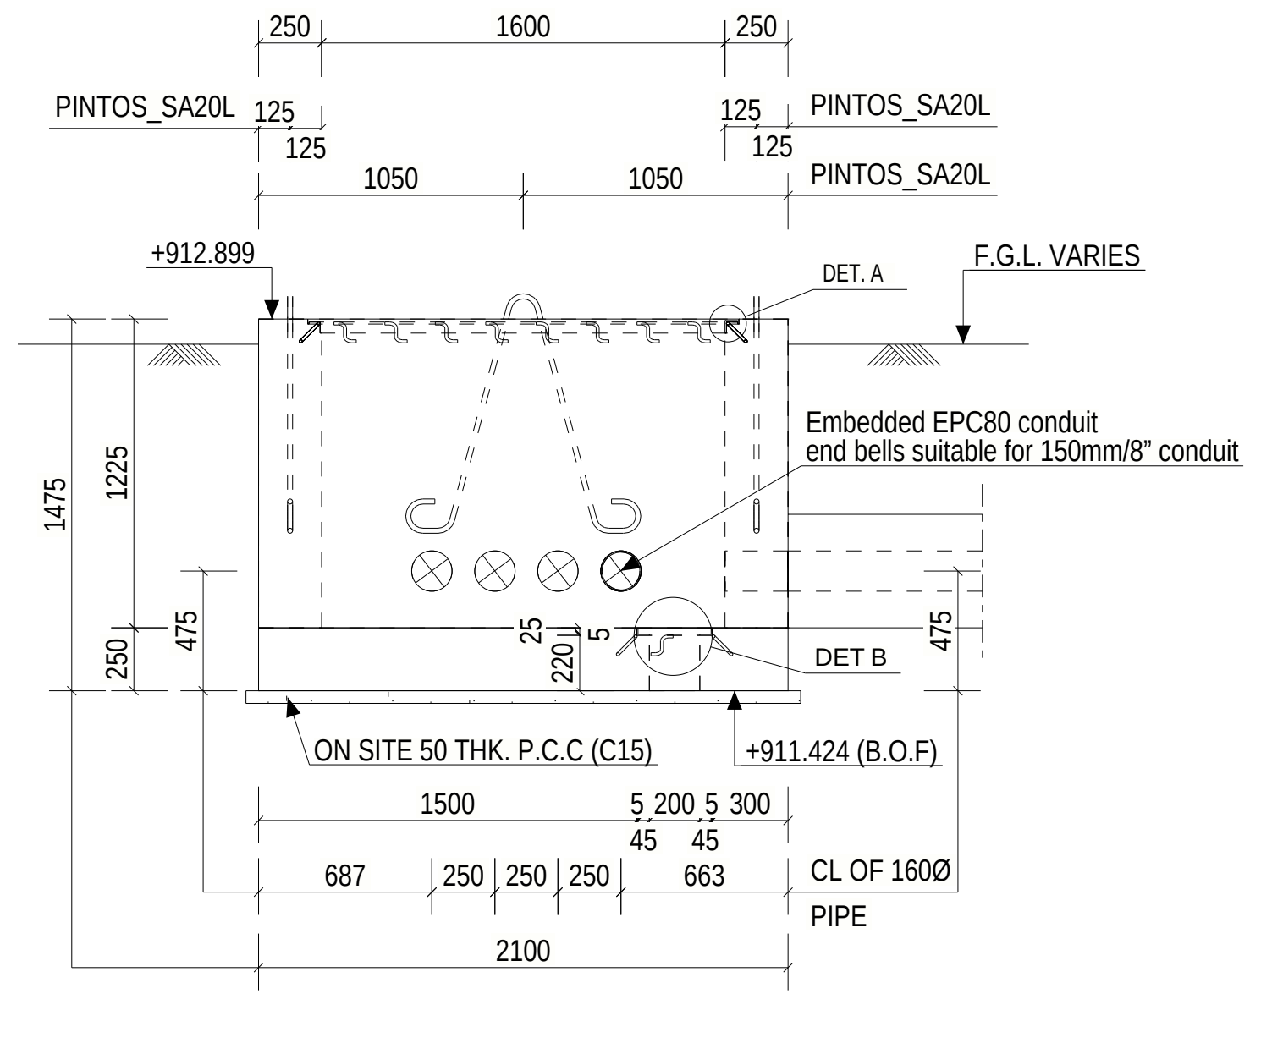

SECTION : D - D
(SCALE 1:30)

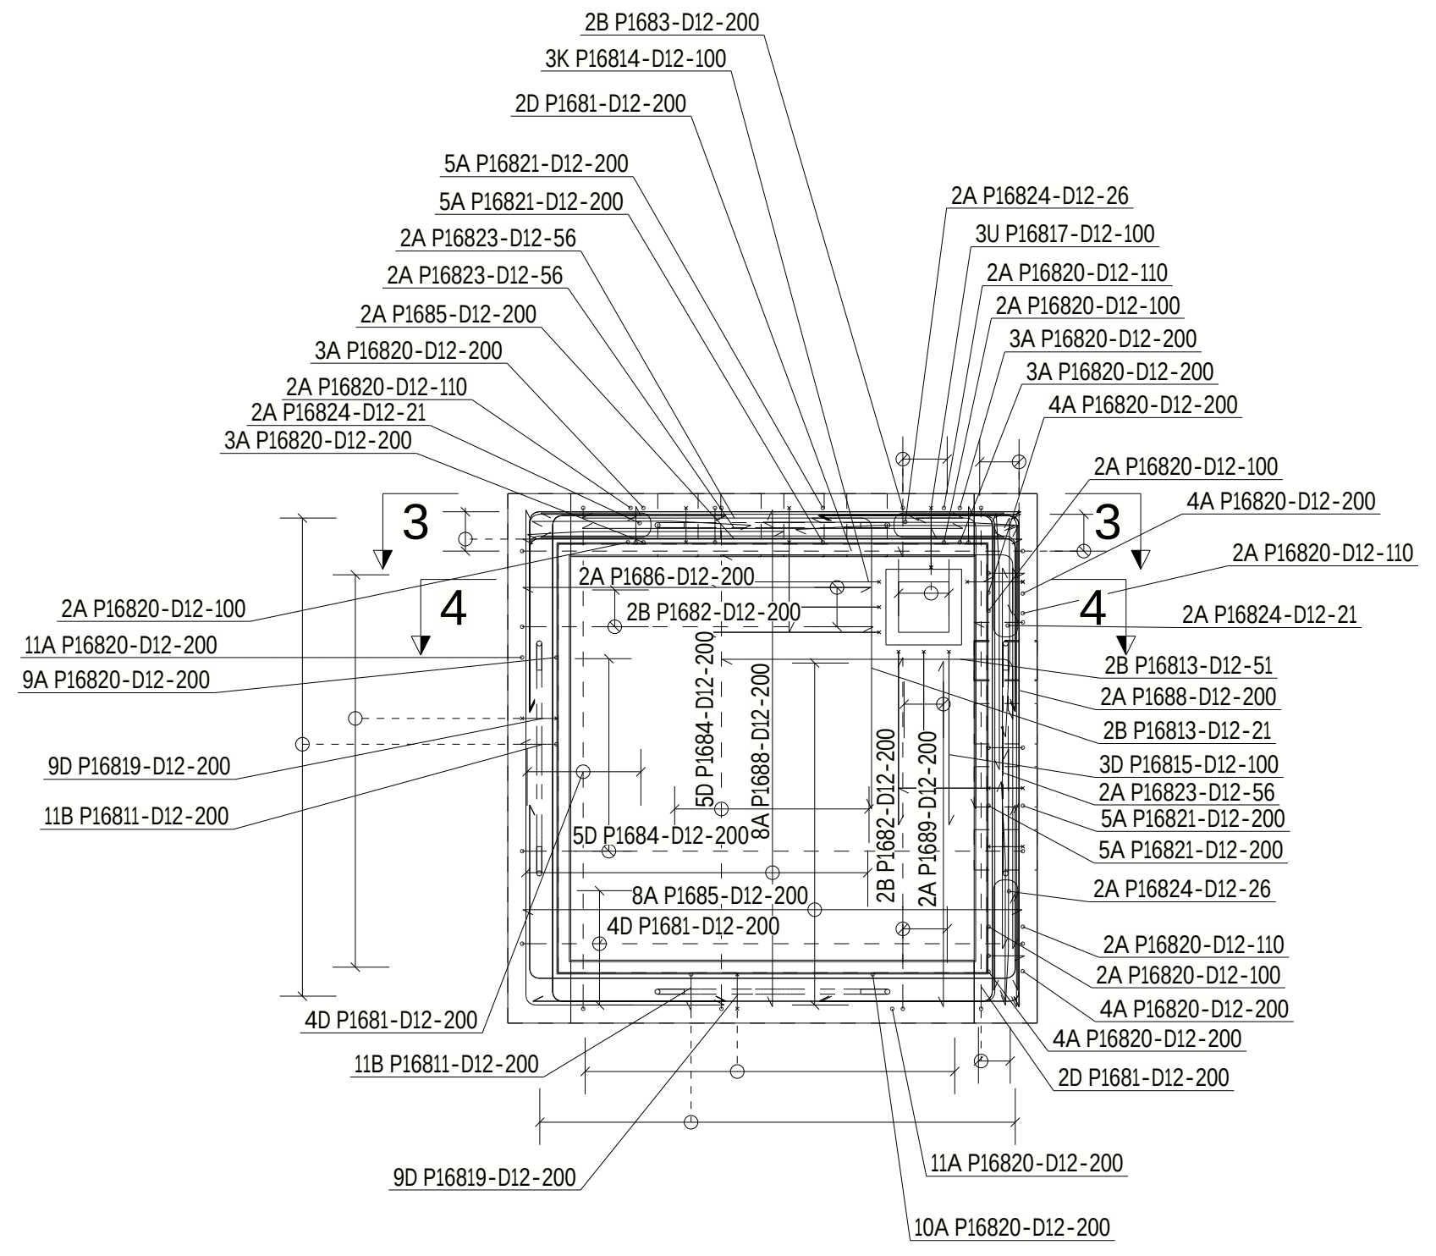

R.C.C. PLAN FOR PULLPIT MKD. P168
(SCALE 1:30)

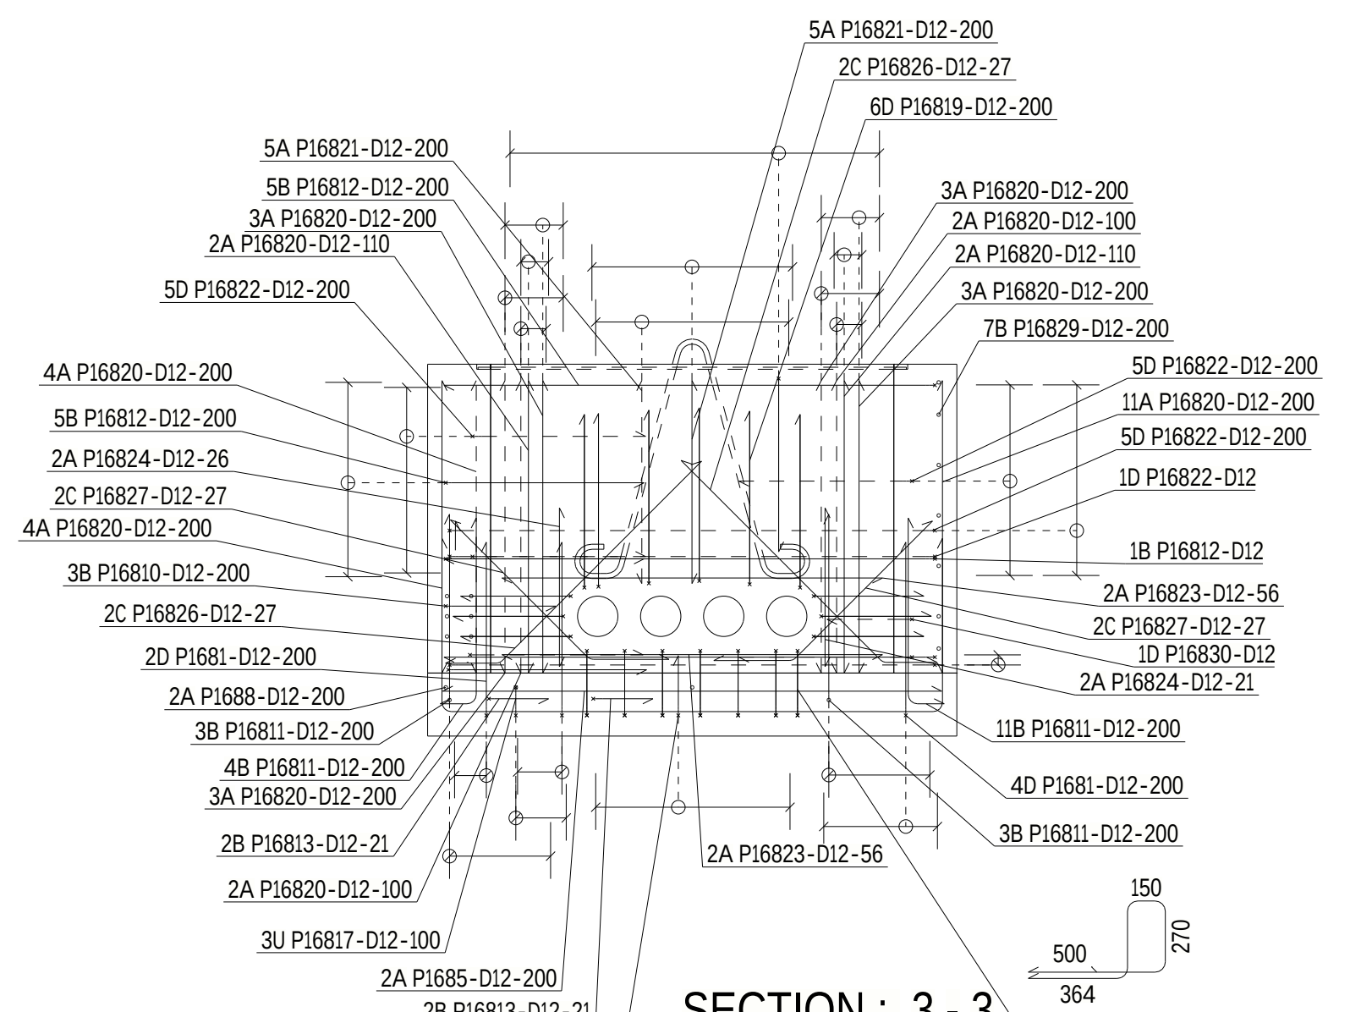

SECTION : 3 - 3
(SCALE 1:30)

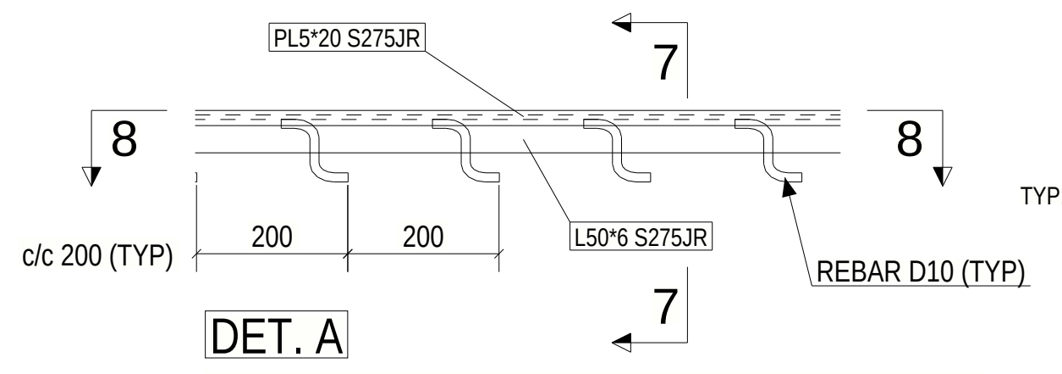

DET. A
DETAIL OF EMBEDDED PROFILE L50X6
(SCALE 1:10)

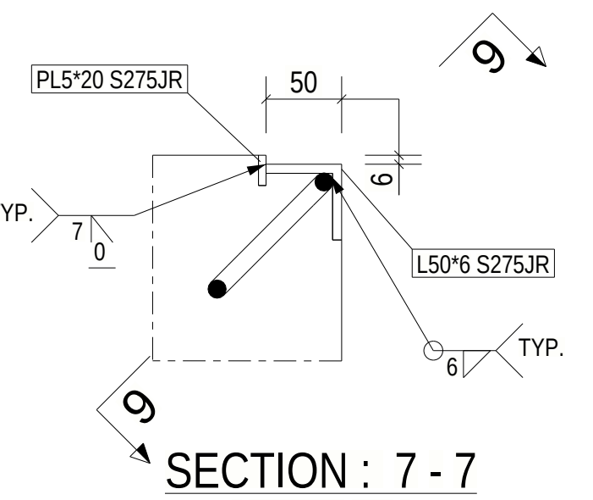

SECTION : 7 - 7
(SCALE 1:5)

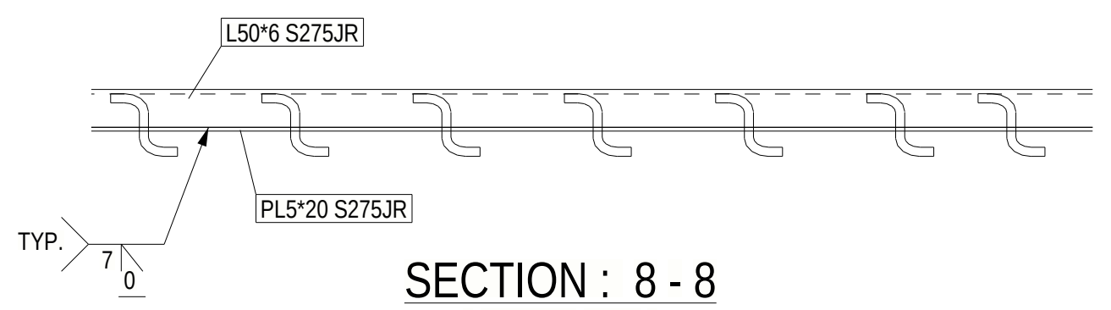

SECTION : 8 - 8
(SCALE 1:10)

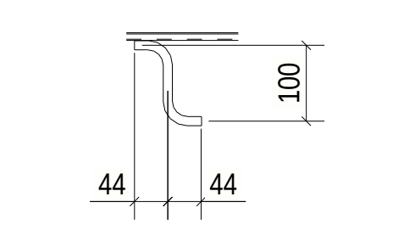

SECTION : 9 - 9
(SCALE 1:10)

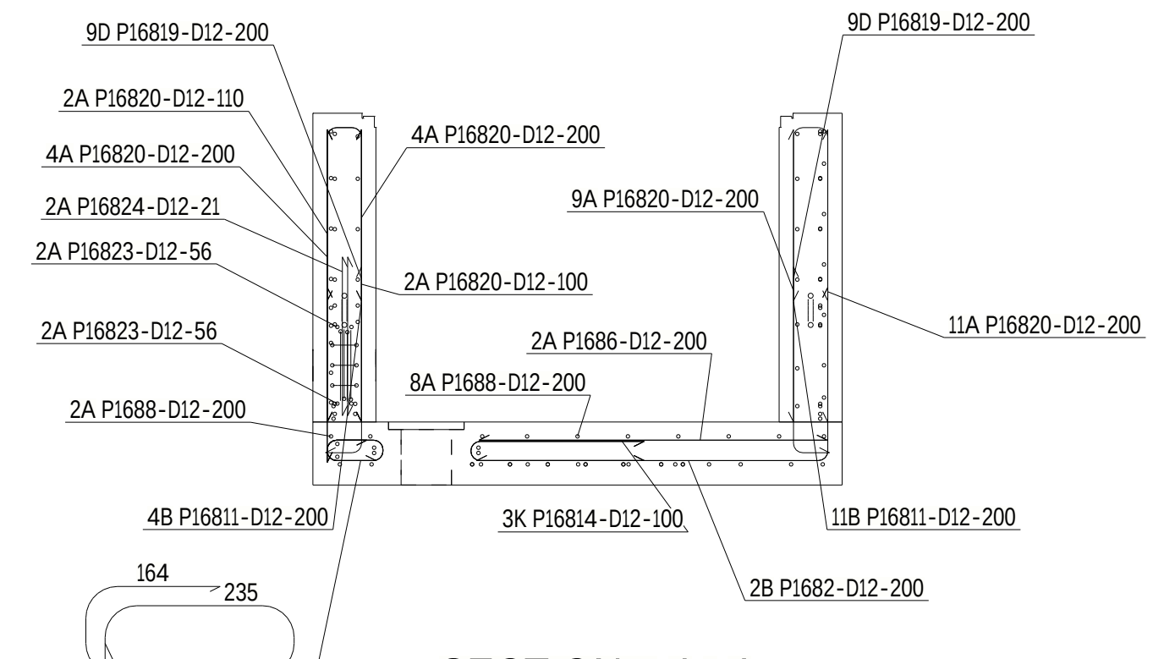

SECTION : 4 - 4
(SCALE 1:30)

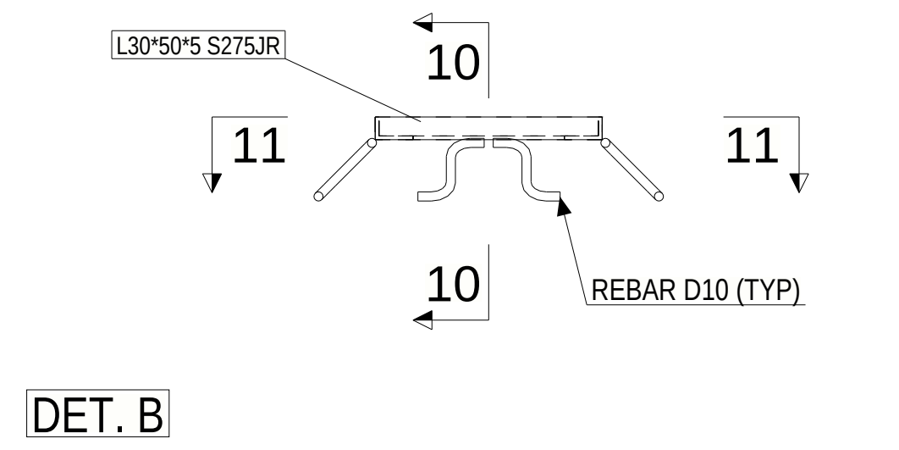

DET. B
DETAIL OF EMBEDDED PROFILE L30X50X5
(SCALE 1:10)

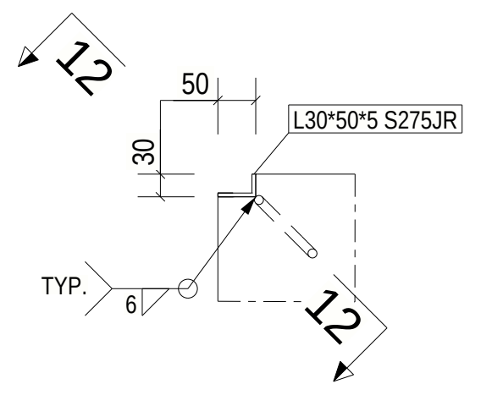

SECTION : 10 - 10
(SCALE 1:10)

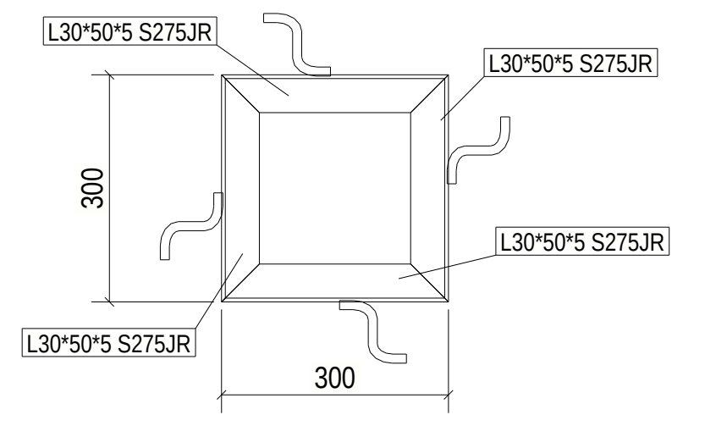

SECTION : 11 - 11
(SCALE 1:10)

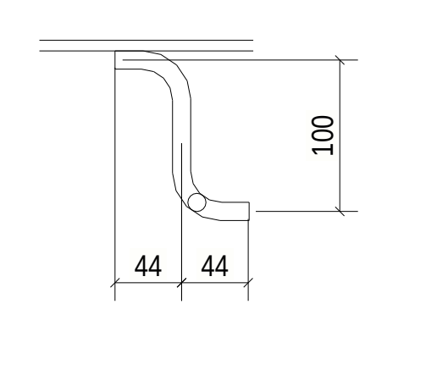

SECTION : 12 - 12
(SCALE 1:5)

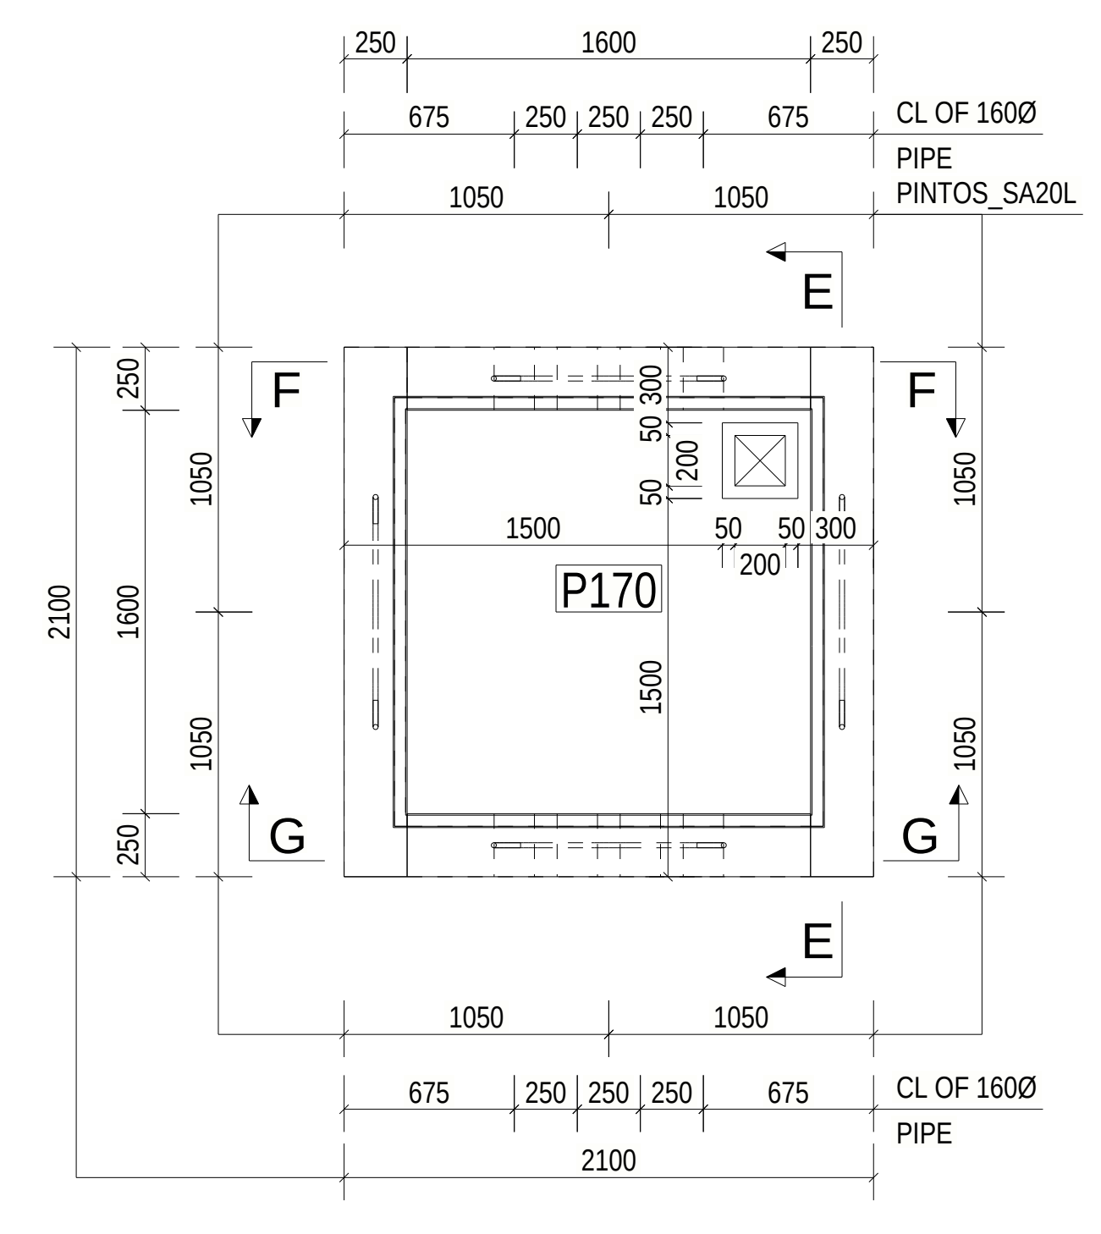

PULLPIT MKD. P170
(SCALE 1:30)

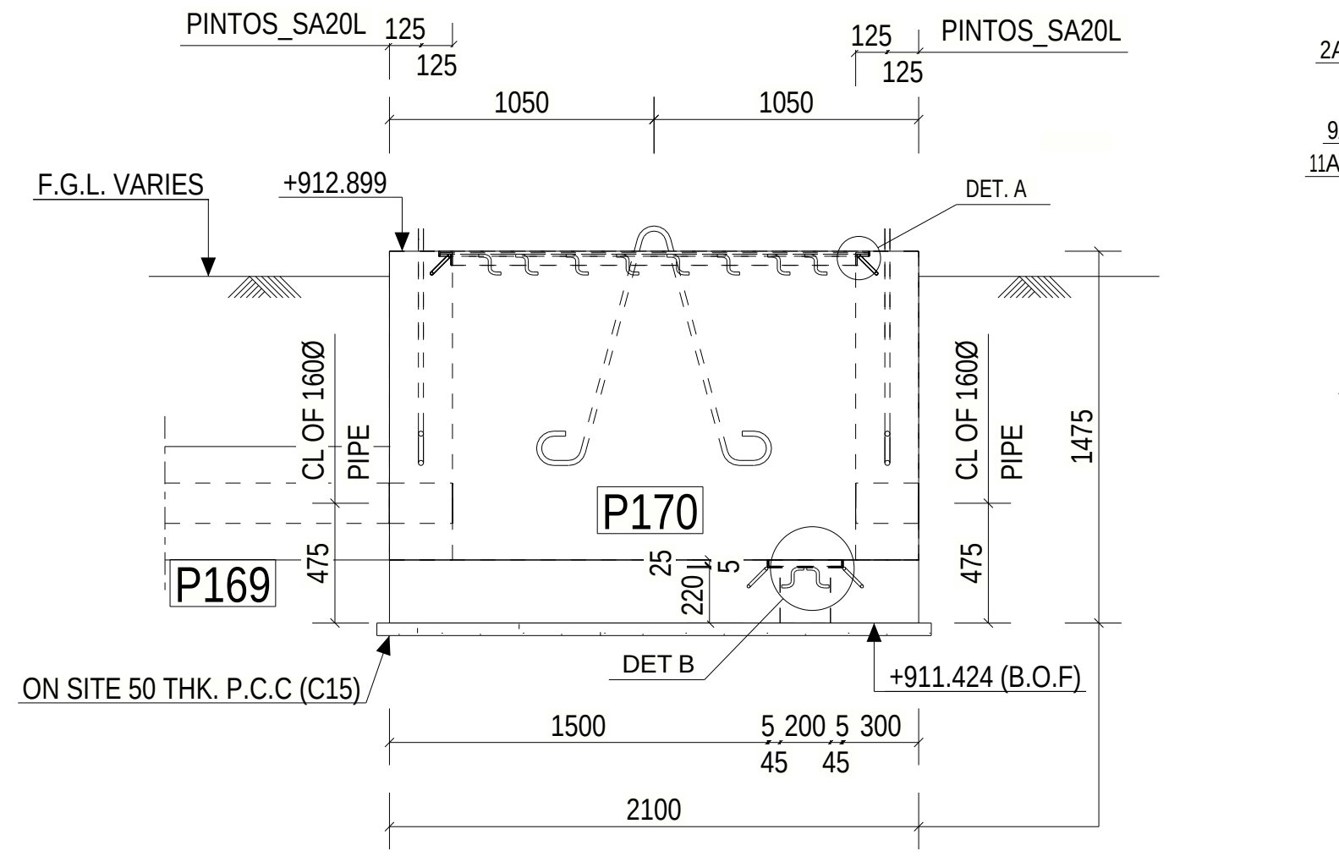

SECTION : E - E
(SCALE 1:30)

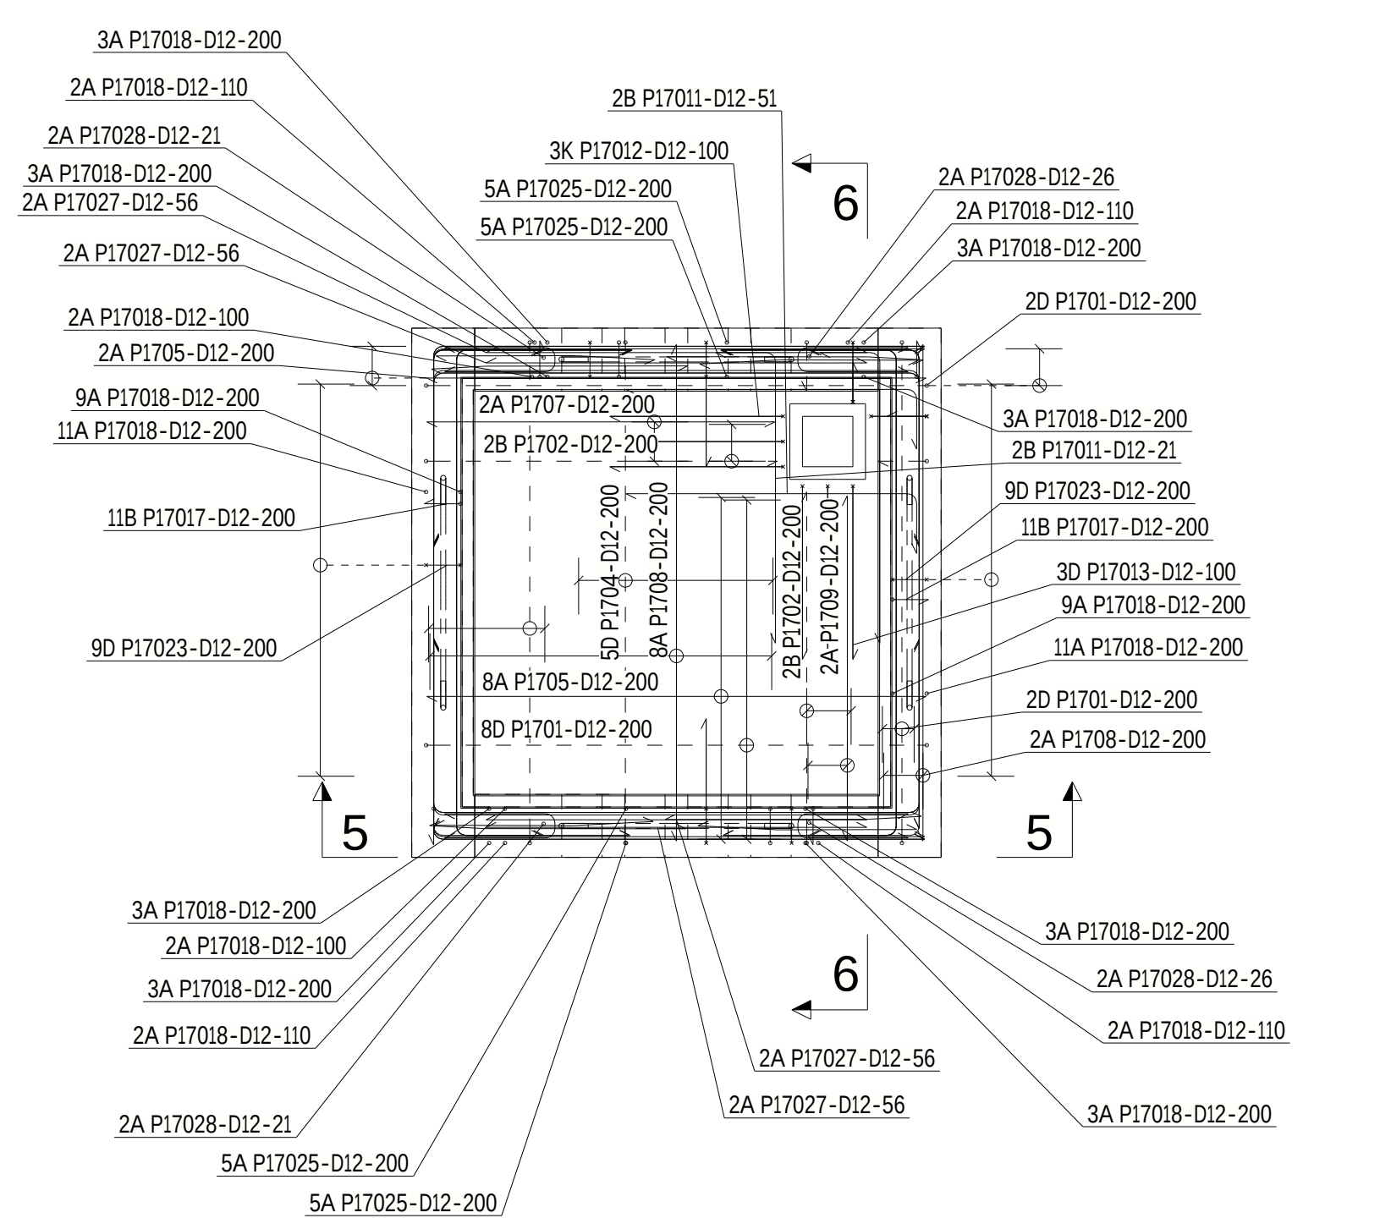

R.C.C. PLAN FOR PULLPIT MKD. P170
(SCALE 1:30)

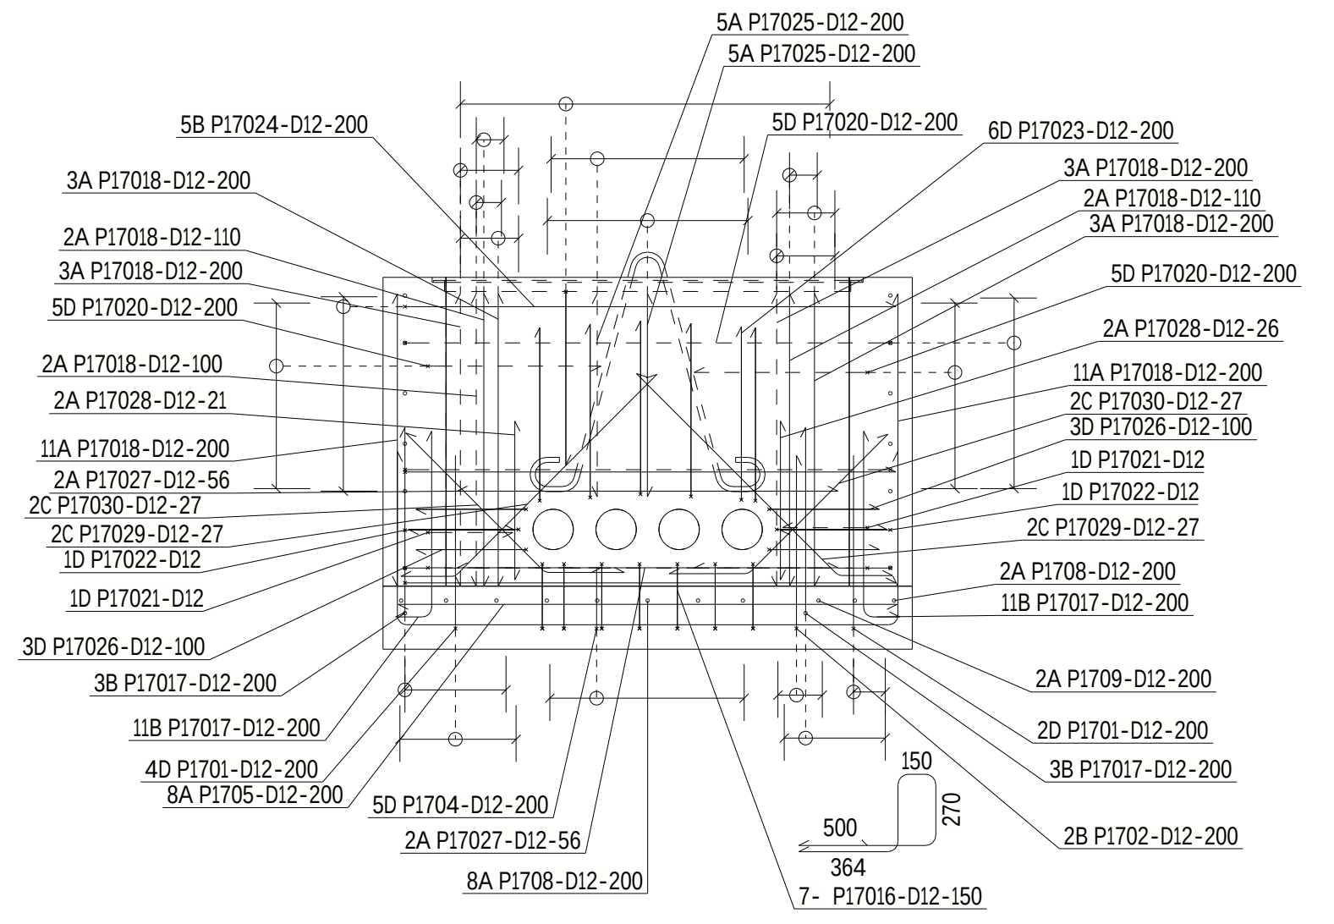

SECTION : 5 - 5
(SCALE 1:30)

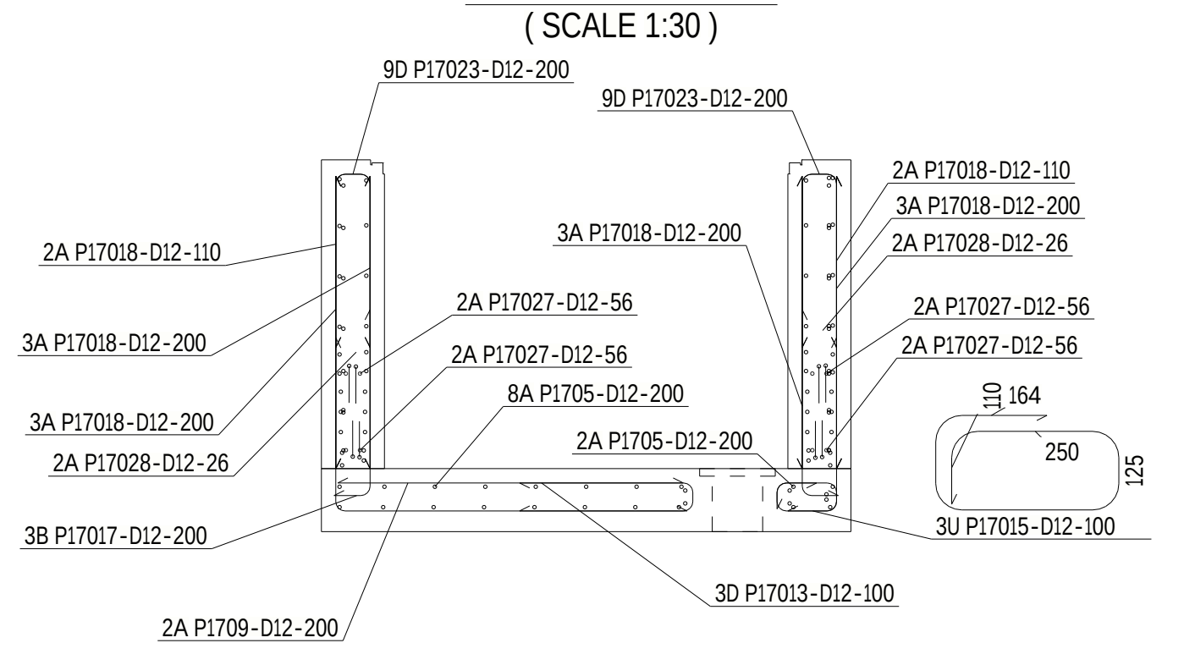

SECTION : 6 - 6
(SCALE 1:30)

FOR LOCATION OF PIT, SEE GENERAL ARRANGEMENT
DRAWING MD-216-49W1-EG-CV-GAD-1005

CONCRETE INFORMATION

Concretes used	C45	
Concrete cover 1	75±10mm	BOTTOM OF SLAB
Concrete cover 2	50±10mm	SIDES AND TOP OF SLAB, WALLS

REINFORCING BAR LIST
CAST UNIT CODE: P168 PCS: 5

REINFORCING BARS				D	L	dL	WEIGHT	BENDING DIMENSIONS [mm]									COMMENT
TYPE	POS	PCS	GRADE	[mm]	[mm]	[mm]	SUM [kg]	a	b	c	d	e	u	v	x	TD	
D	P1681	12	B500B	12	3320		35.5	694	2000	694						60	
B	P1682	4	B500B	12	2060		7.3	694	1400				90			60	
B	P1683	4	B500B	12	860		3.1	200	694				90			60	
D	P1684	10	B500B	12	2870		25.6	694	2000	244						60	
A	P1685	10	B500B	12	1980		17.6	1980									
A	P1686	2	B500B	12	1380		2.5	1380									
B	P1687	2	B500B	12	2340		4.2	444	1935				90			60	
A	P1688	10	B500B	12	1970		17.5	1969									
A	P1689	2	B500B	12	1370		2.4	1369									
B	P16810	3	B500B	12	850		2.3	437	444				90			60	
B	P16811	36	B500B	12	860		27.6	744	150				90			60	
B	P16812	16	B500B	12	2710		38.6	1955	794				90			60	
B	P16813	8	B500B	12	1370		9.8	1160	244				90			60	
K	P16814	3	B500B	12	1410		3.8	694	694							60	
D	P16815	3	B500B	12	1450		3.9	694	125	694						60	
U	P16816	3	B500B	12	760		2.0	164	95	235	95	235				60	
U	P16817	3	B500B	12	870		2.3	164	125	250	125	250				60	
**	P16818	7	B500B	12	1430		8.9										
D	P16819	48	B500B	12	1470		63.0	694	150	694						60	
A	P16820	85	B500B	12	1160		87.6	1160									
A	P16821	20	B500B	12	800		14.3	805									
D	P16822	27	B500B	12	3260		78.4	694	1940	694						60	
A	P16823	8	B500B	12	1510		10.7	1510									
A	P16824	8	B500B	12	630		4.5	630									
D	P16825	12	B500B	12	930		10.0	444	110	444						60	
C	P16826	8	B500B	12	1340		9.6	218	1135				45			60	
C	P16827	8	B500B	12	1090		7.8	784	318				45			60	
B	P16828	5	B500B	12	2690		12.0	794	1935				90			60	
B	P16829	7	B500B	12	2730		17.0	1970	794				90			60	
D	P16830	3	B500B	12	2910		7.8	694	1940	344						60	
**	P16831	7	B500B	12	1400		8.7										

REINFORCING BAR TOTAL WEIGHT [kg] 546.0

REINFORCING BAR LIST
CAST UNIT CODE: P170 PCS: 5

REINFORCING BARS				D	L	dL	WEIGHT	BENDING DIMENSIONS [mm]									COMMENT
TYPE	POS	PCS	GRADE	[mm]	[mm]	[mm]	SUM [kg]	a	b	c	d	e	u	v	x	TD	
D	P1701	16	B500B	12	3320		47.3	694	2000	694						60	
B	P1702	4	B500B	12	2060		7.3	694	1400				90			60	
B	P1703	4	B500B	12	860		3.1	200	694				90			60	
D	P1704	5	B500B	12	2420		10.8	244	2000	244						60	
A	P1705	10	B500B	12	1980		17.6	1980									
A	P1707	2	B500B	12	1380		2.5	1380									
A	P1708	10	B500B	12	1970		17.5	1969									
A	P1709	2	B500B	12	1370		2.4	1369									
B	P17011	8	B500B	12	1370		9.8	1160	244				90			60	
K	P17012	3	B500B	12	1410		3.8	694	694							60	
D	P17013	3	B500B	12	1450		3.9	694	125	694						60	
U	P17014	3	B500B	12	760		2.0	164	95	235	95	235				60	
U	P17015	3	B500B	12	870		2.3	164	125	250	125	250				60	
**	P17016	14	B500B	12	1430		17.8										
B	P17017	34	B500B	12	860		26.1	744	150				90			60	
A	P17018	76	B500B	12	1160		78.3	1160									
B	P17019	12	B500B	12	2660		28.4	1905	794				90			60	
D	P17020	28	B500B	12	3260		81.3	694	1940	694						60	
D	P17021	2	B500B	12	2560		4.6	344	1940	344						60	
D	P17022	2	B500B	12	2760		4.9	444	1940	444						60	
D	P17023	48	B500B	12	1470		63.0	694	150	694						60	
B	P17024	16	B500B	12	2710		38.6	1955	794				90			60	
A	P17025	20	B500B	12	800		14.3	805									
D	P17026	12	B500B	12	930		10.0	444	110	444						60	
A	P17027	8	B500B	12	1510		10.7	1510									
A	P17028	8	B500B	12	630		4.5	630									
C	P17029	8	B500B	12	1340		9.6	218	1135				45			60	
C	P17030	8	B500B	12	1090		7.8	784	318				45			60	

REINFORCING BAR TOTAL WEIGHT [kg] 530.1

REINFORCING BAR LIST
CAST UNIT CODE: P172 PCS: 5

REINFORCING BARS				D	L	dL	WEIGHT	BENDING DIMENSIONS [mm]									COMMENT
TYPE	POS	PCS	GRADE	[mm]	[mm]	[mm]	SUM [kg]	a	b	c	d	e	u	v	x	TD	
D	P1721	16	B500B	12	3320		47.3	694	2000	694						60	
B	P1722	4	B500B	12	2060		7.3	694	1400				90			60	
B	P1723	4	B500B	12	860		3.1	200	694				90			60	
D	P1724	5	B500B	12	2870		12.8	694	2000	244						60	
A	P1725	10	B500B	12	1980		17.6	1980									
A	P1726	2	B500B	12	1380		2.5	1380									
A	P1728	10	B500B	12	1970		17.5	1969									
A	P1729	2	B500B	12	1370		2.4	1369									
B	P17211	39	B500B	12	860		29.9	744	150				90			60	
A	P17212	81	B500B	12	1160		83.4	1160									
B	P17213	7	B500B	12	2690		16.8	794	1935				90			60	
D	P17214	27	B500B	12	3260		78.4	694	1940	694						60	
D	P17215	42	B500B	12	1470		55.1	694	150	694						60	
B	P17216	7	B500B	12	2730		17.0	1970	794				90			60	
B	P17217	6	B500B	12	2660		14.2	1905	794				90			60	
D	P17218	2	B500B	12	2910		5.2	694	1940	344						60	
B	P17219	1	B500B	12	2310		2.1	1905	444				90			60	
B	P17220	8	B500B	12	2710		19.3	1955	794				90			60	
B	P17221	8	B500B	12	1370		9.8	1160	244				90			60	
A	P17222	10	B500B	12	800		7.1	805									
A	P17223	4	B500B	12	1510		5.4	1510									
A	P17224	4	B500B	12	630		2.2	630									
K	P17225	3	B500B	12	1410		3.8	694	694							60	
D	P17226	3	B500B	12	1450		3.9	694	125	694						60	
U	P17227	3	B500B	12	760		2.0	164	95	235	95	235				60	
U	P17228	3	B500B	12	870		2.3	164	125	250	125	250				60	
**	P17229	7	B500B	12	1430		8.9										
D	P17230	6	B500B	12	930		5.0	444	110	444						60	
C	P17231	4	B500B	12	1340		4.8	218	1135				45			60	
C	P17232	4	B500B	12	1090		3.9	784	318				45			60	

REINFORCING BAR TOTAL WEIGHT [kg] 490.9

REINFORCEMENT BENDING SHAPES:

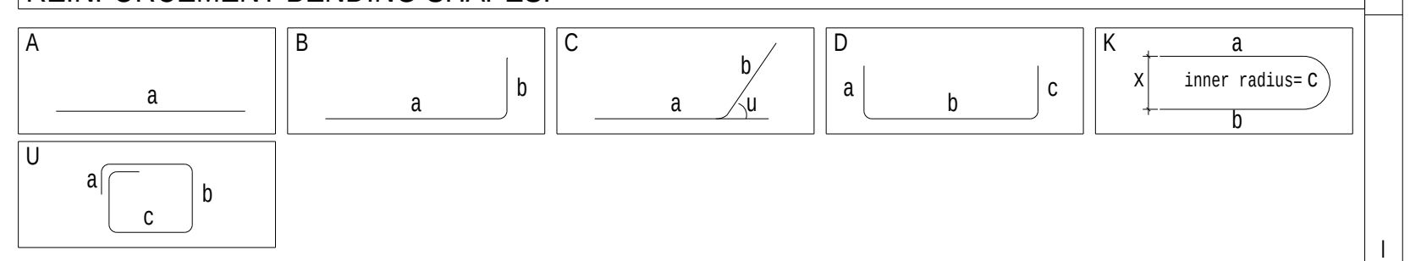

LEGEND:
R.L. - REDUCED LEVEL
T.O.C. - TOP OF CONCRETE
B.O.F. - BOTTOM OF FOUNDATION
F.G.L. - FINISHED GROUND LEVEL
P.C.C. - PLAIN CEMENT CONCRETE
TYP - TYPICAL
MKD - MARKED
CL - CENTER LINE
BOTTOM REINF. (B)
TOP REINF. (T)
SBC - SAFE BEARING CAPACITY
MIN. - MINIMUM
REF. - REFERED
GA - GENERAL ARRANGEMENT
DWG. - DRAWING
R.C.C. - REINFORCED CEMENT CONCRETE

NOTES:

1. ALL DIMENSIONS ARE IN MILLIMETRES AND LEVELS ARE IN METRES UNLESS OTHERWISE STATED
2. GRADE OF CONCRETE SHALL BE C35 (35MPa) UNLESS NOTED OTHERWISE & C15 (15MPa) FOR BLINDING CONCRETE.
3. GRADE OF REINFORCEMENT SHALL BE DEFORMED BAR ASTM A615-GRADE 60 (fy=420MPa)
4. CLEAR COVER TO MAIN REINFORCEMENT SHALL BE AS FOLLOWS:
a) FOUNDATION: 75 mm (BOTTOM & SIDE)
b) FOUNDATION: 50 mm (TOP)
c) COLUMN & PEDESTAL: 50 mm
5. MINIMUM LAP LENGTHS OF REINFORCEMENT SHALL BE 40XBAR DIAMETER
6. FOR STANDARD REINFORCEMENT DETAILS & GENERAL NOTES FOR CIVIL WORKS REFER TO DRAWING NUMBER MD-216-1000-EG-CV-DED-1005 & 1001
7. ANCHOR BOLTS AND EMBEDDED STEELWORK SHALL BE HOT DIP GALVANIZED
8. T.O.C. & TOP OF SCREED TOLERANCE SHALL BE WITHIN +/- 10MM OF DESIGN LEVEL
9. NET SAFE BEARING CAPACITY OF SOIL AT BOTTOM OF FOUNDATION IS CONSIDERED AS 375 KN/SQ.M.
10. REBARS CAN BE MOVED LOCALLY BY +/- 25mm TO AVOID INTERFERENCE WITH EMBEDDED PARTS
C01 11. STEEL GRADE OF EMBEDDED SECTIONS AND PLATES S275JR

MANUFACTURED PRECAST ELEMENTS

ELEMENT:	PCS:
PULLPIT MKD. P168	1
PULLPIT MKD. P170	1
PULLPIT MKD. P172	2
TOTAL:	4

KEYPLAN

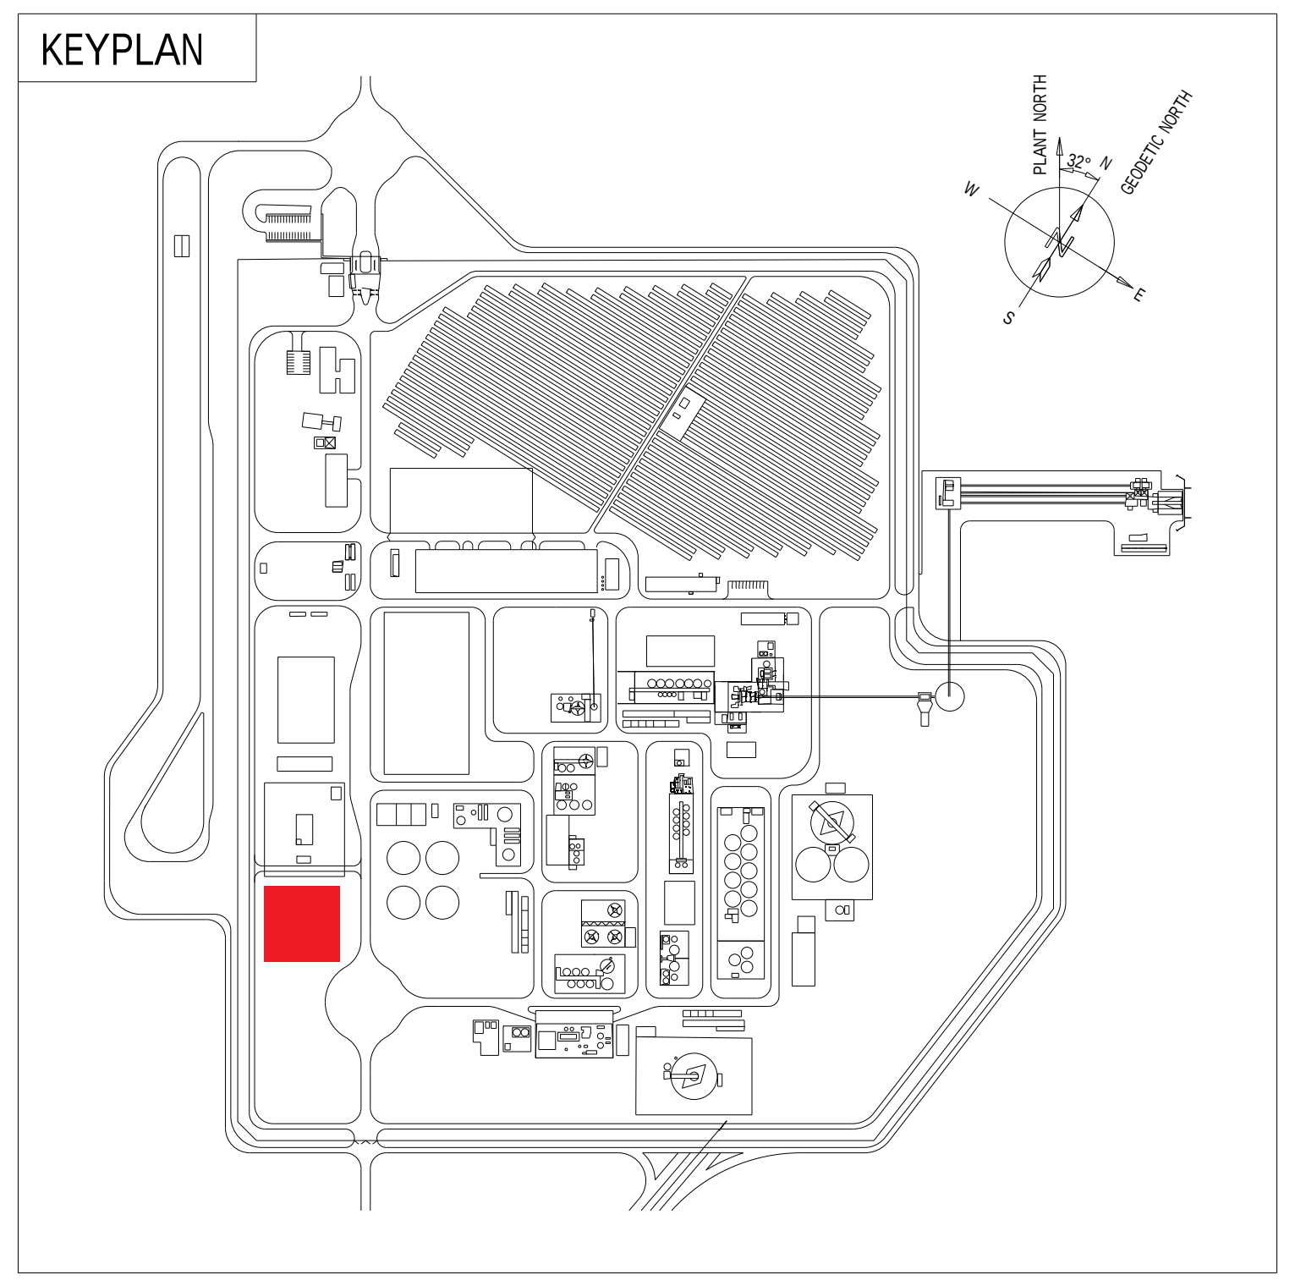

DOCUMENT NUMBER	REFERENCE DOCUMENTS	DOCUMENT NUMBER	REFERENCE DOCUMENTS
MD-216-1000-EG-ST-CRT-1001	DESIGN CRITERIA	MD-216-49W1-EG-CV-CAL-1006	DAF BASIN, COAGULANT BASIN, PIT, SLUDGE BASIN, VESSEL FOUNDATION
MD-216-49W1-EG-CV-GAD-1005	GENERAL ARRANGEMENT DRAWING	MD-216-49W1-EG-CV-DED-1008	REINFORCEMENT DRAWING OF VALVE PITS

REV	DATE	REVISION DESCRIPTION	DRN	CHK	ENG	APP	EMP
D01	29.01.2024	AS-BUILT	NikJan	MauNot	LuiPiz	SouCha	
C01	14.02.2022	ISSUED FOR CONSTRUCTION	NikJan	MauNot	LuiPiz	SouCha	
A01	14.01.2022	ISSUED FOR APPROVAL	EvgPon	MauNot	NanWu	LuiPiz	

RESERVED FOR VENDOR LOGO AND DRAWING NUMBER

LARSEN & TOUBRO

This drawing is the property of LARSEN & TOUBRO and must not be passed on to any person or body not authorized by us to recieve it or be copied or otherwise made use either in full or in part by such person or body without our prior permission in writing.

Outotec

The content of these documents are the sole property of Outotec Oyj. Any rights not expressly granted herein are reserved. Reproduction, transfer or distribution of part or all of the contents in any form without prior written permission of Outotec is prohibited.

MA'ADEN معادن
Saudi Arabian Mining Company شركة التعدين العربية السعودية

This document and the information contained herein is Ma'aden proprietary know-how. This document or any part thereof should not be reproduced, stored in a retrieval system or transmitted by any means, electronic or otherwise, or divulged without prior written permission of Ma'aden.

LARSEN & TOUBRO DRAWING NUMBER
019045_080_C_D_24892_023
REVISION 2

OUTOTEC DRAWING NUMBER
900707_GAU01_AG11_CTB01_49023
DOCUMENT ID
OU100736749
REVISION 2

DRAWN	EvgPon	14.01.2022
CHECKED	MauNot	14.01.2022
ENGINEER	NanWu	14.01.2022
APPROVED	LuiPiz	14.01.2022
EMPLOYER		
SCALE	1:30	A0

MANSOURAH - MASSARAH GOLD PROJECT
RAW WATER TREATMENT PLANT
PRECAST ELECTRICAL CABLE PITS
DETAIL- AND REINFORCEMENT DRAWING

DRAWING NUMBER
MD-216-49W1-EG-CV-DED-1023
REV
D01

Tekla Structures