MD-216-49W1-EG-CV-DED-1024
DRAWING NUMBER
REV
D01

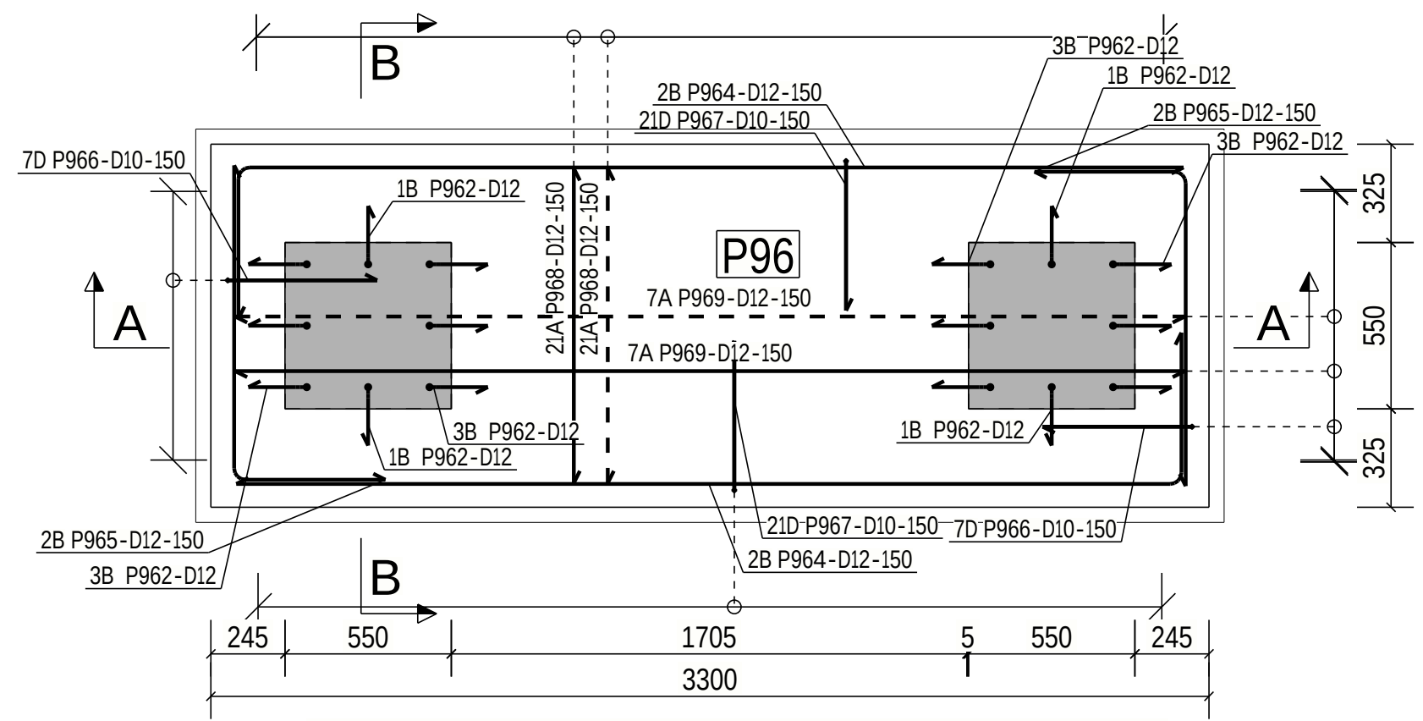

R.C.C. DETAIL OF FOUNDATIONS MKD. P96
(SCALE 1:25)

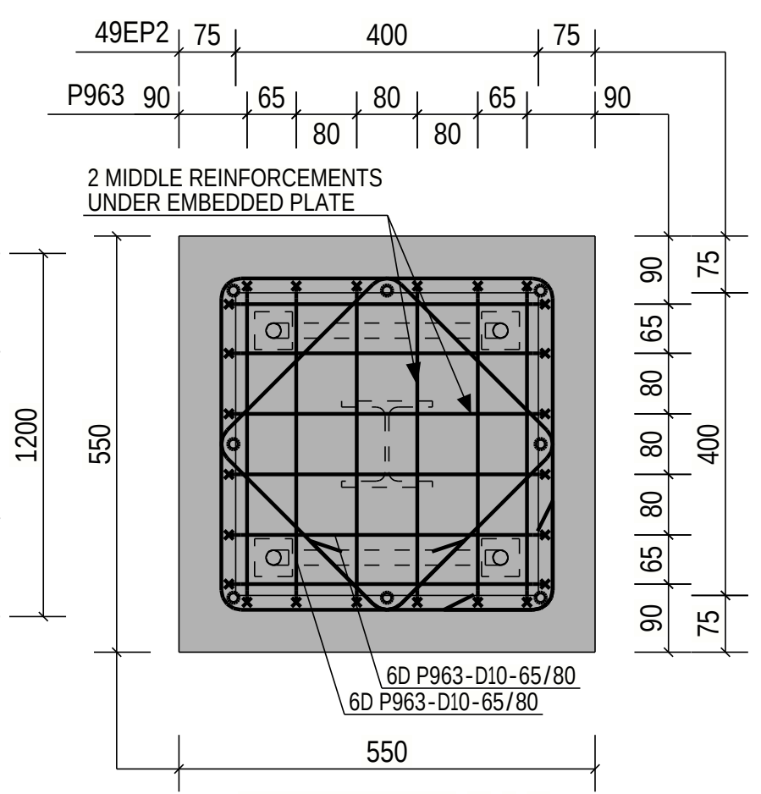

SECTION : 1 - 1
(SCALE 1:10)

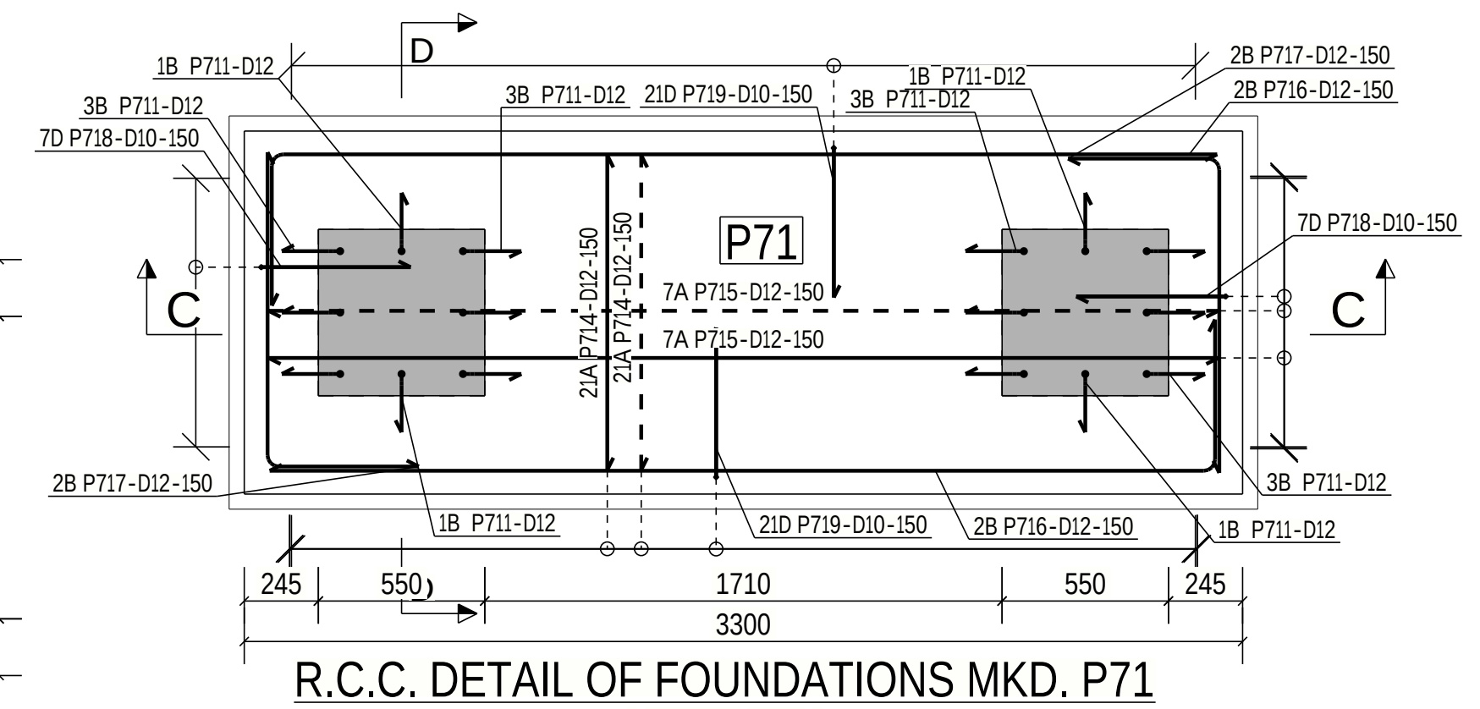

R.C.C. DETAIL OF FOUNDATIONS MKD. P71
(SCALE 1:25)

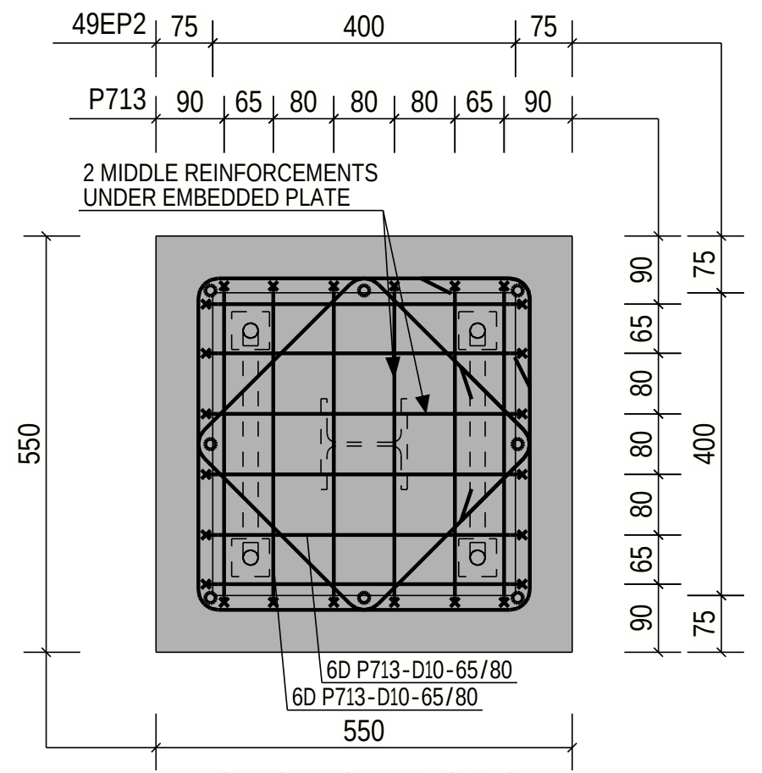

SECTION : 3 - 3
(SCALE 1:10)

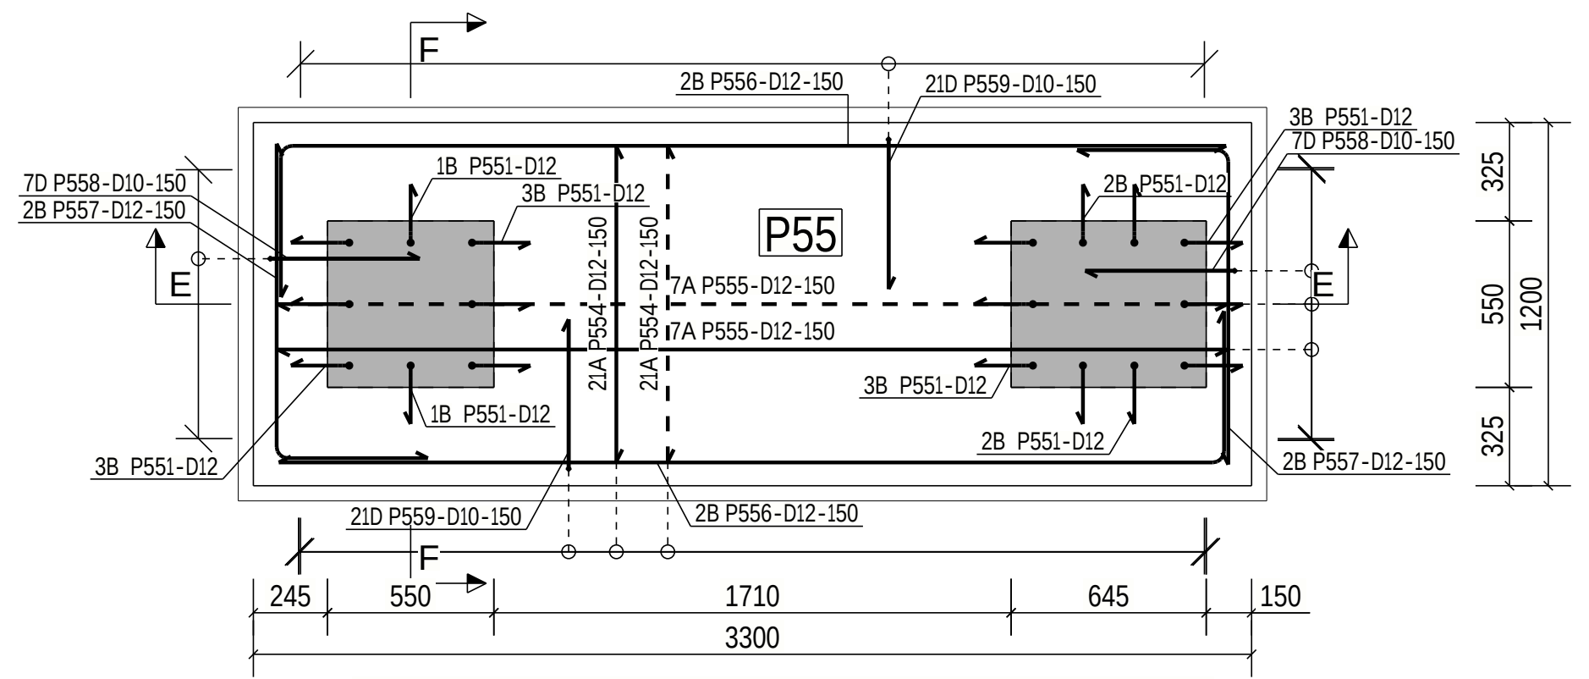

R.C.C. DETAIL OF FOUNDATIONS MKD. P55
(SCALE 1:25)

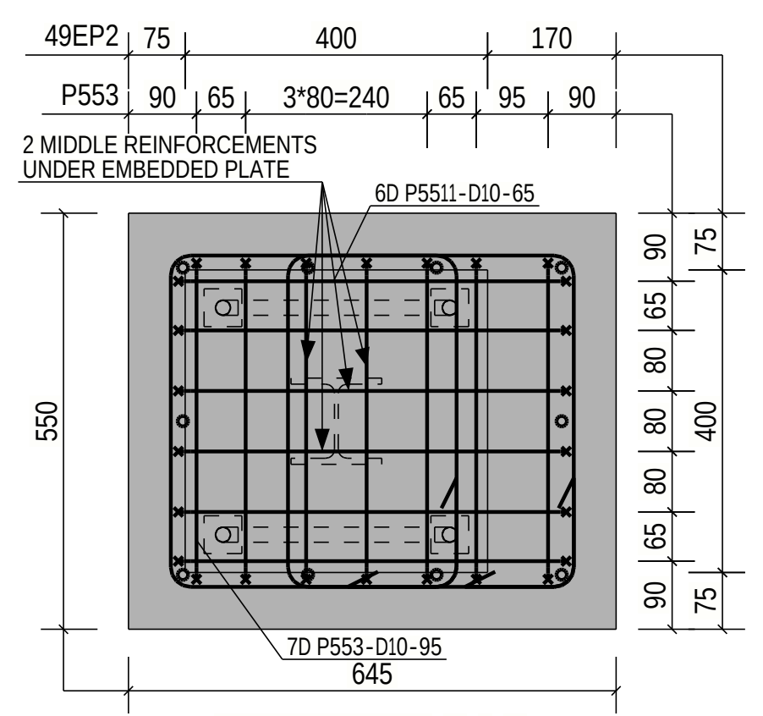

SECTION : 7 - 7
(SCALE 1:10)

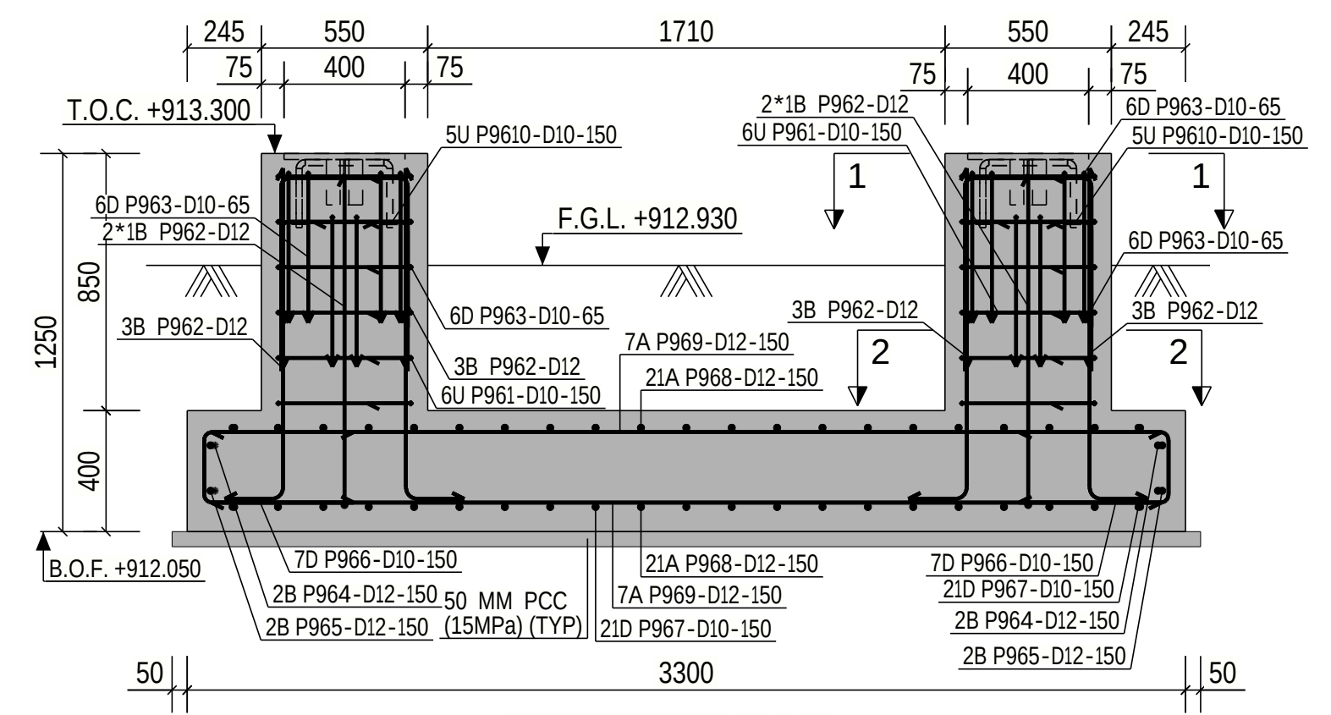

SECTION : A - A
(SCALE 1:25)

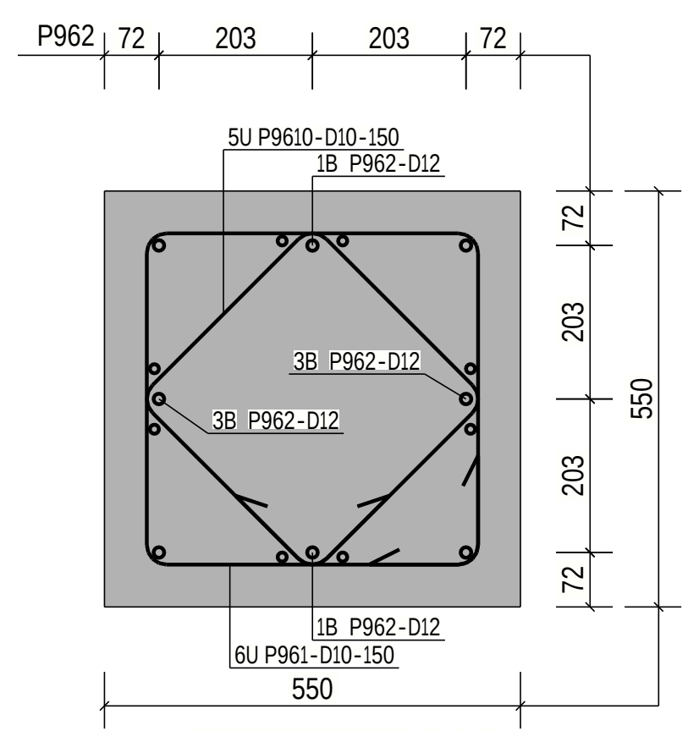

SECTION : 2 - 2
(SCALE 1:10)

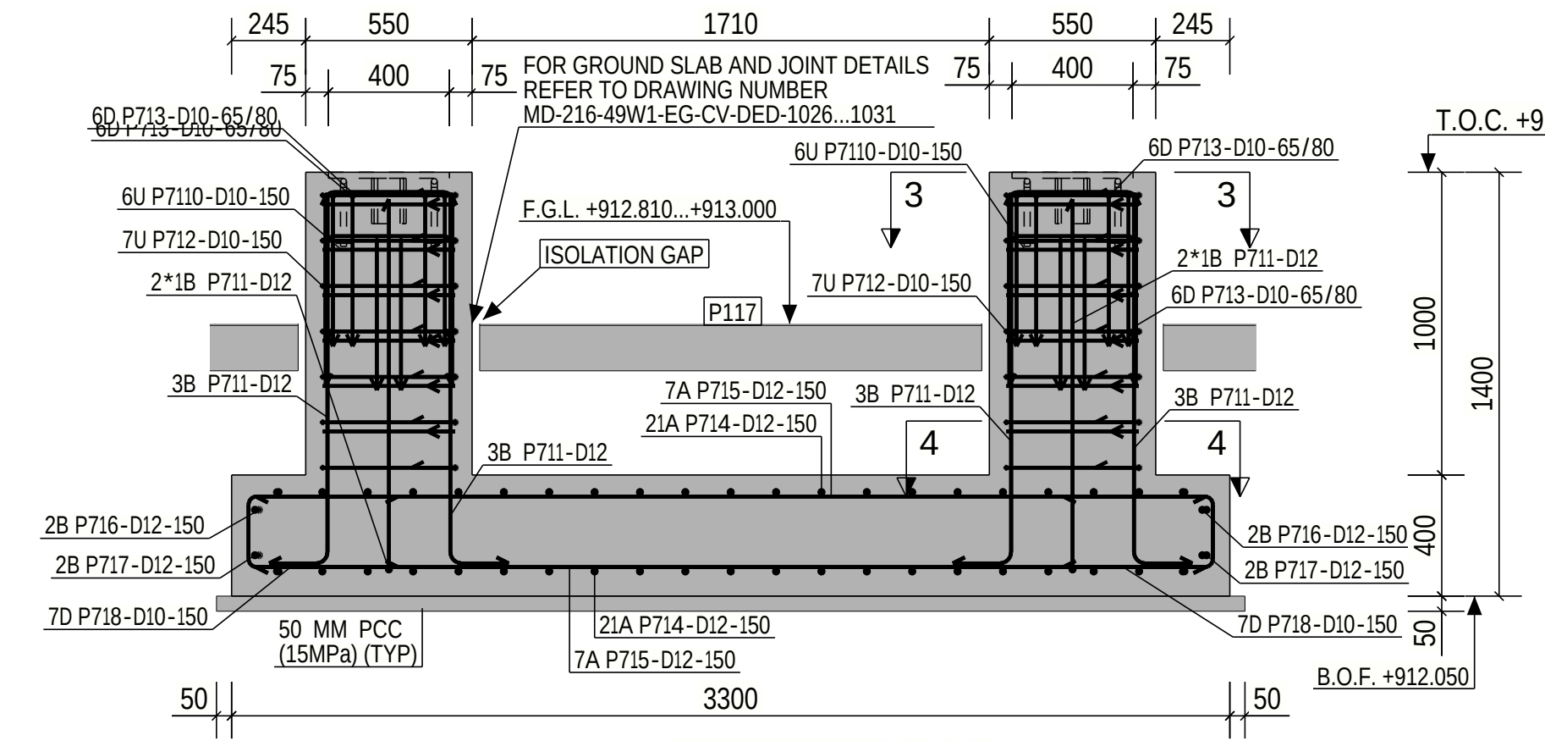

SECTION : C - C
(SCALE 1:25)

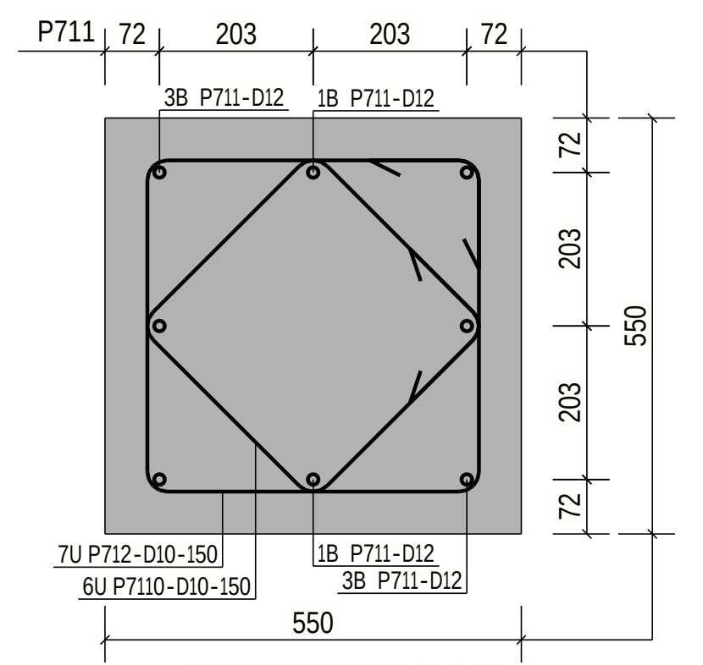

SECTION : 4 - 4
(SCALE 1:10)

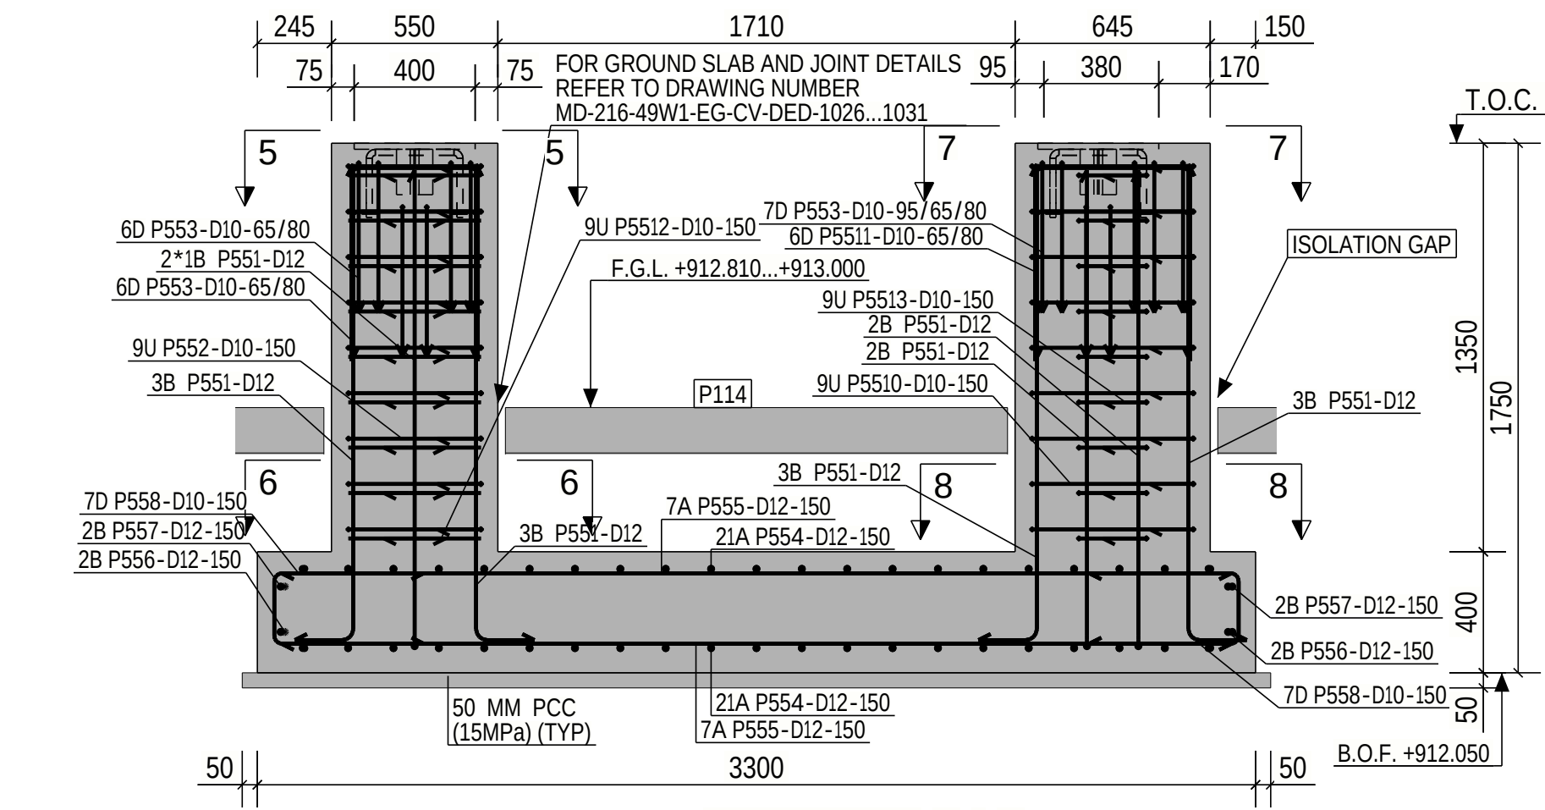

SECTION : E - E
(SCALE 1:25)

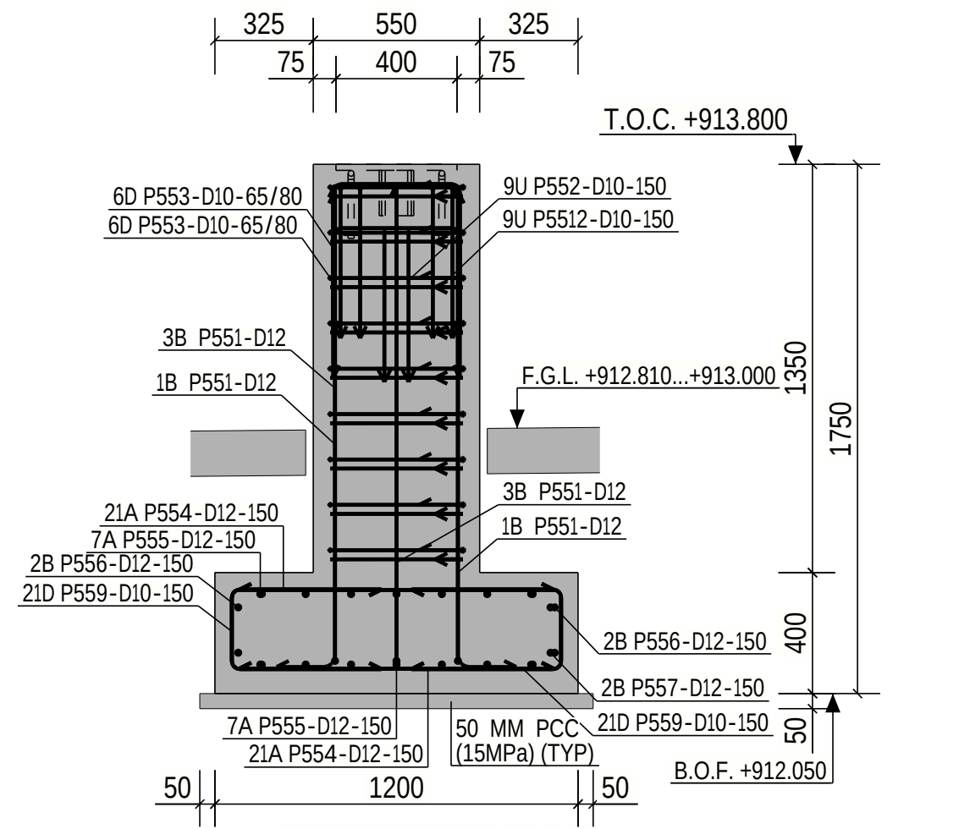

SECTION : F - F
(SCALE 1:25)

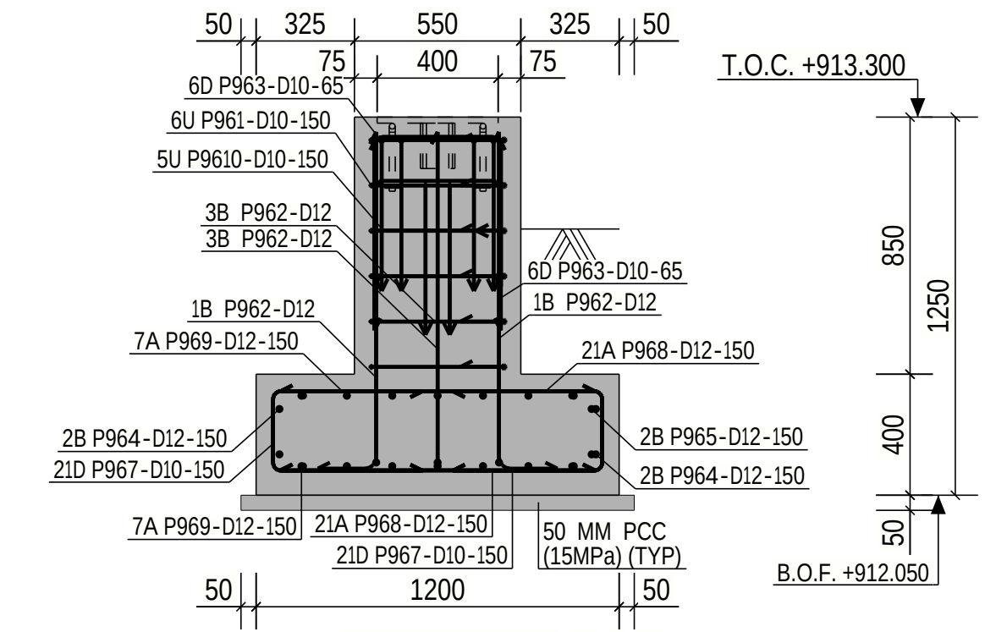

SECTION : B - B
(SCALE 1:25)

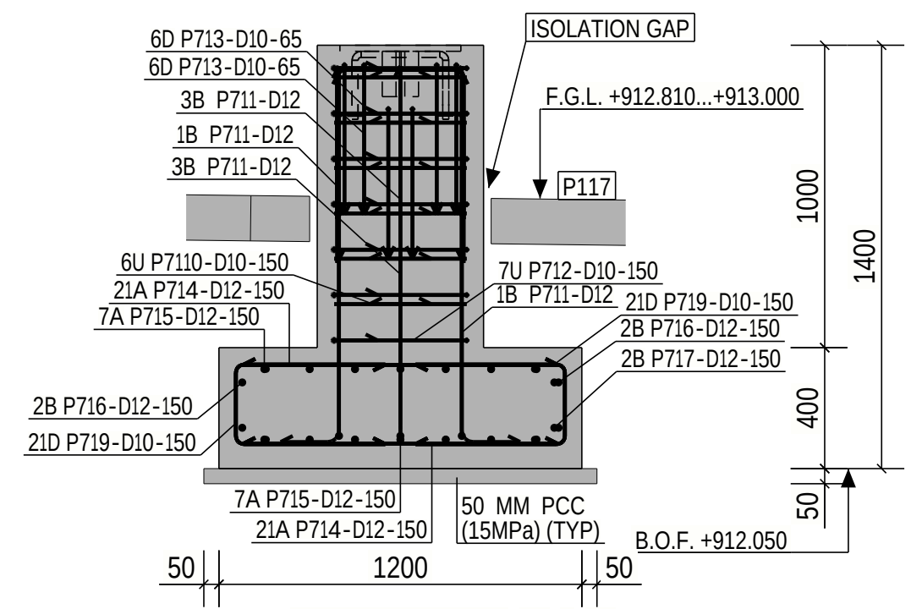

SECTION : D - D
(SCALE 1:25)

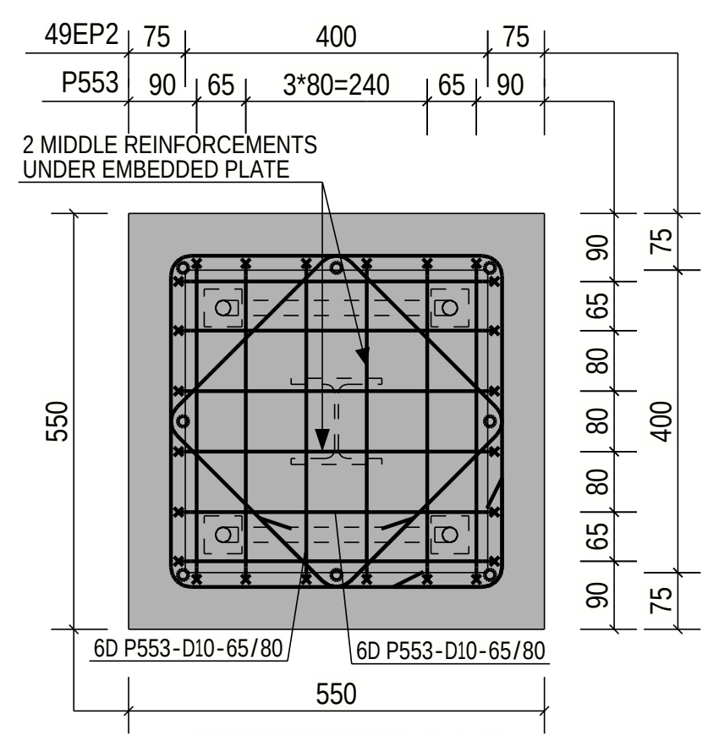

SECTION : 5 - 5
(SCALE 1:10)

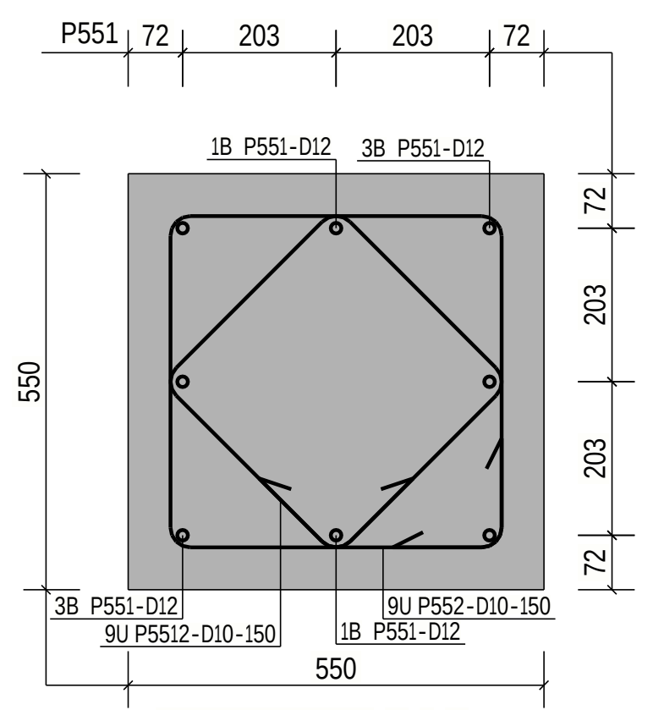

SECTION : 6 - 6
(SCALE 1:10)

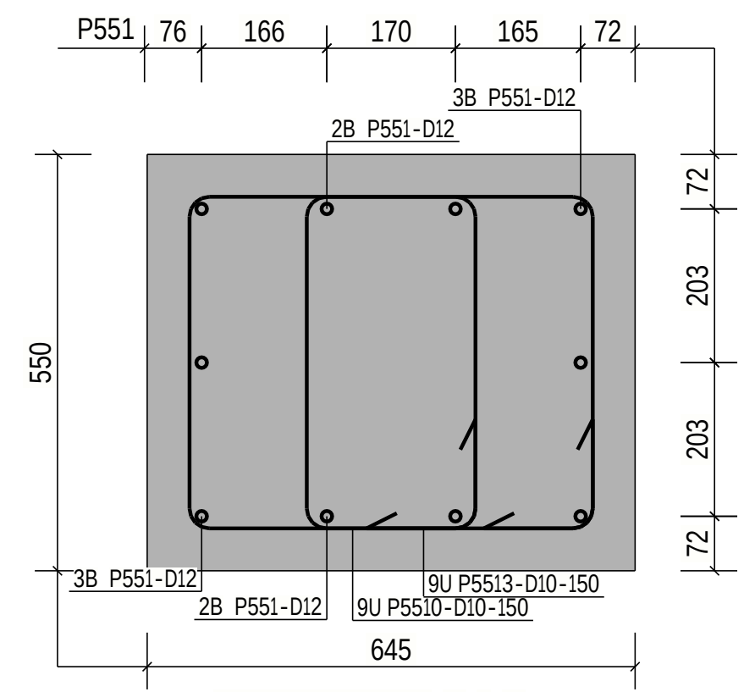

SECTION : 8 - 8
(SCALE 1:10)

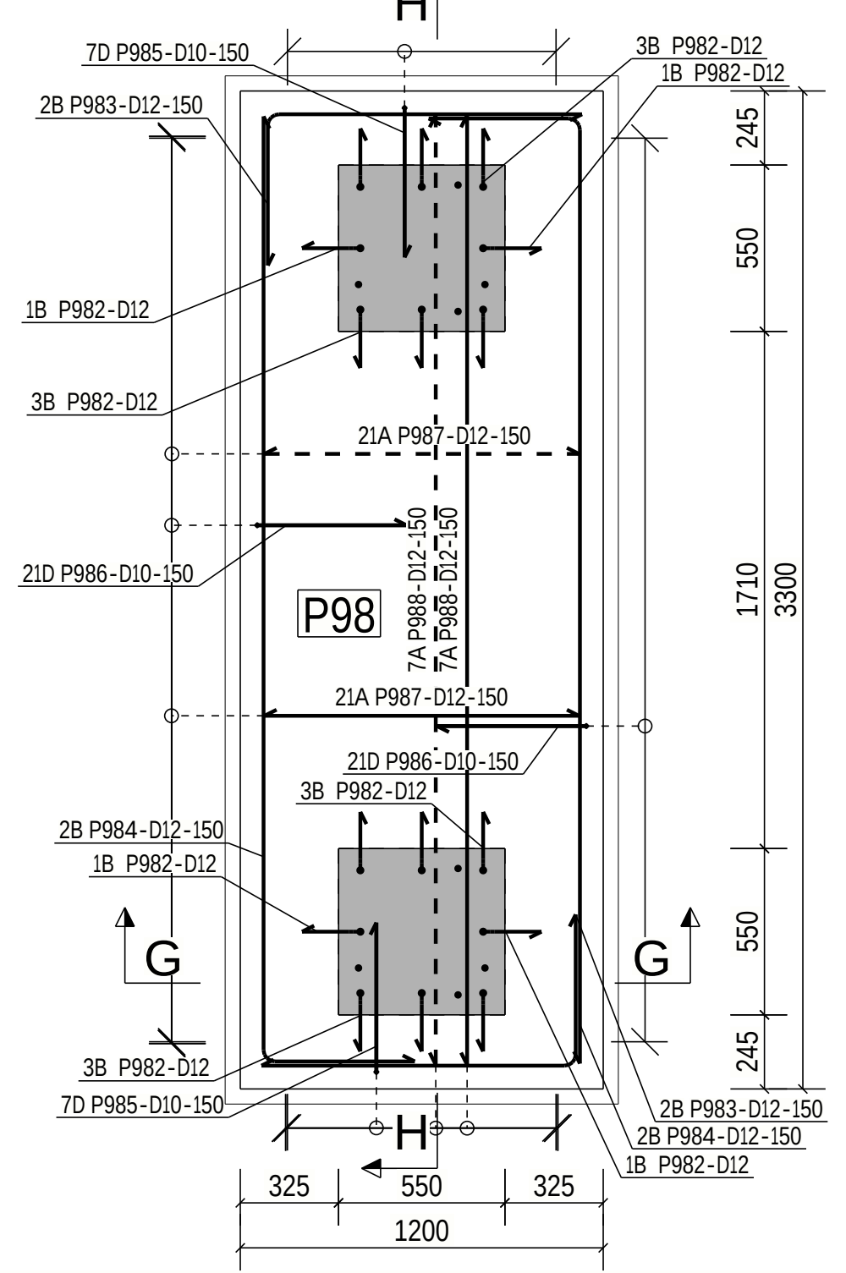

R.C.C. DETAIL OF FOUNDATIONS MKD. P98
(SCALE 1:25)

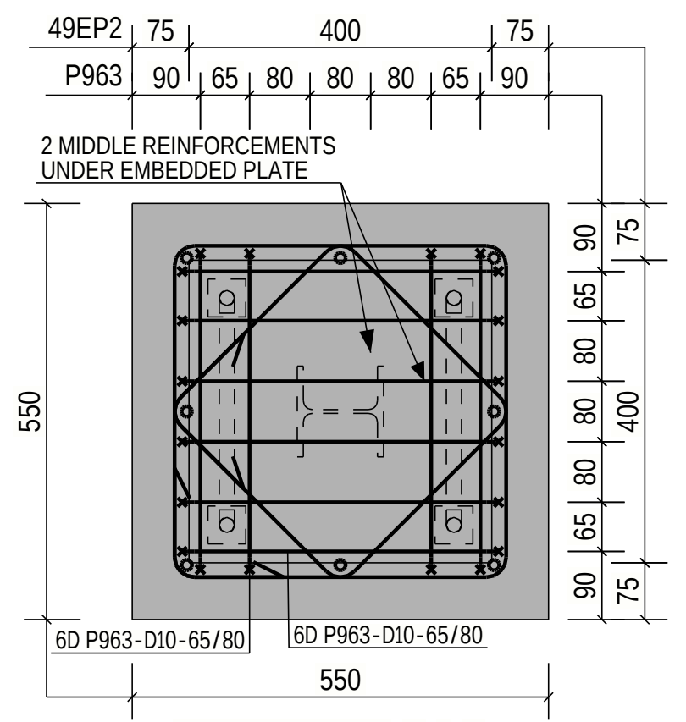

SECTION : 9 - 9
(SCALE 1:10)

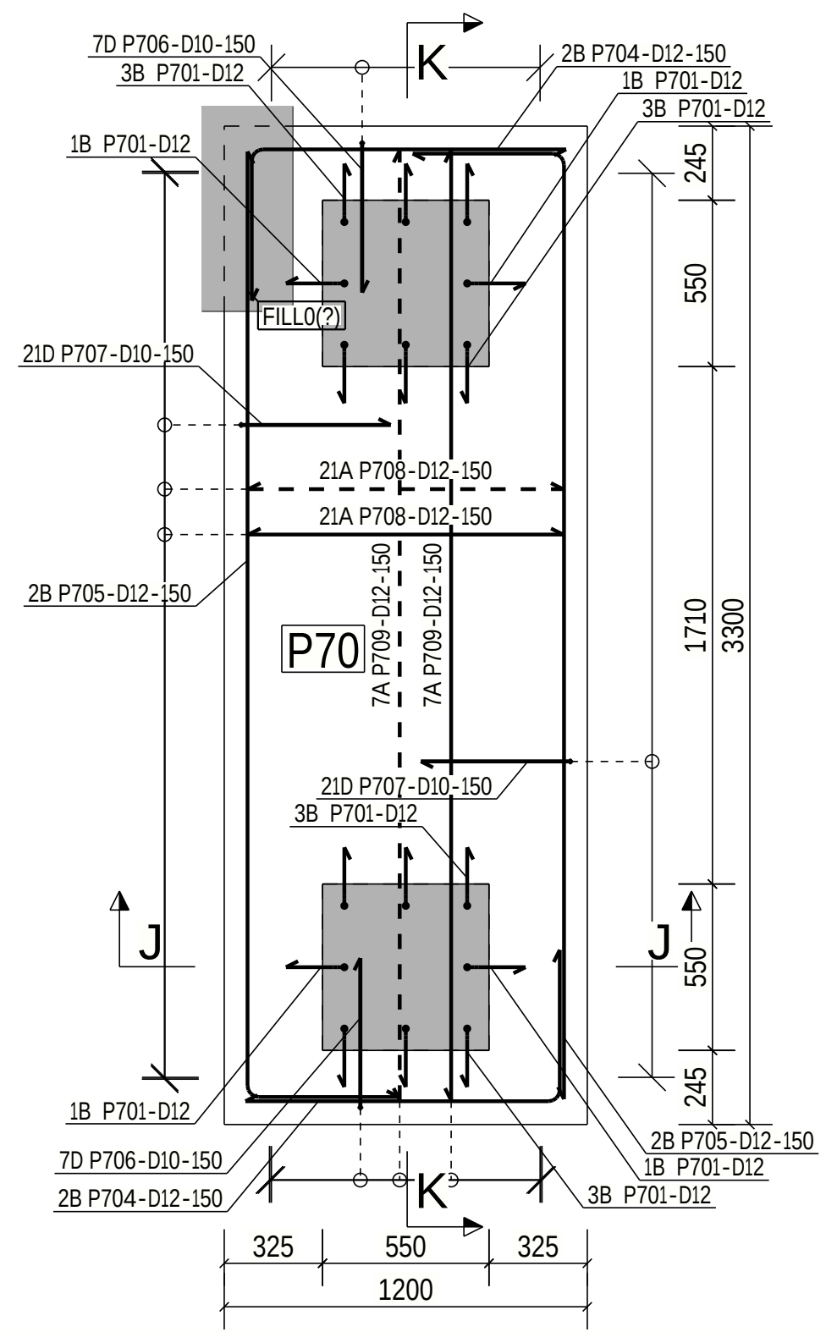

R.C.C. DETAIL OF FOUNDATIONS MKD. P70
(SCALE 1:25)

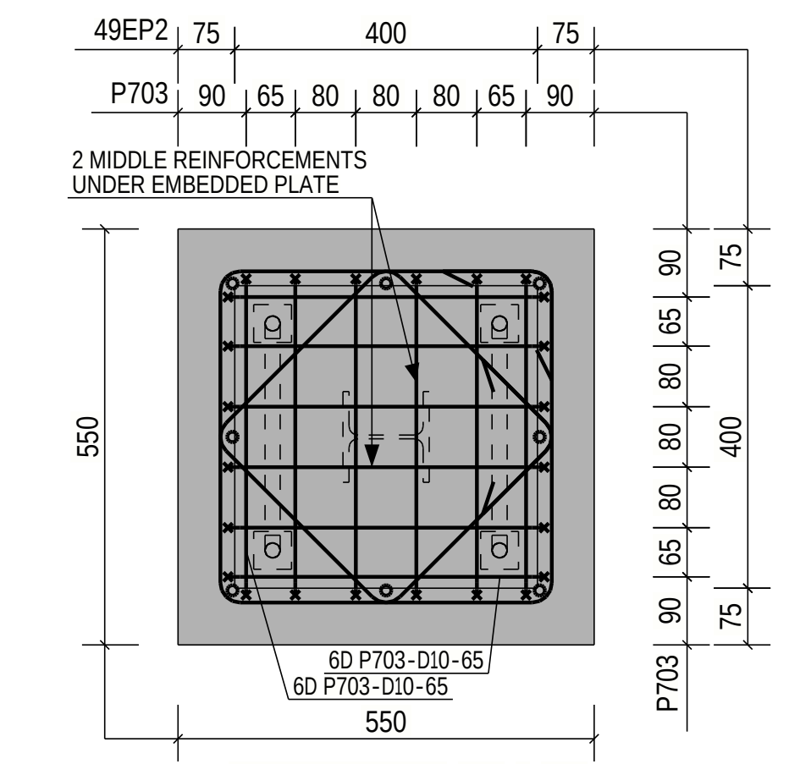

SECTION : 11 - 11
(SCALE 1:10)

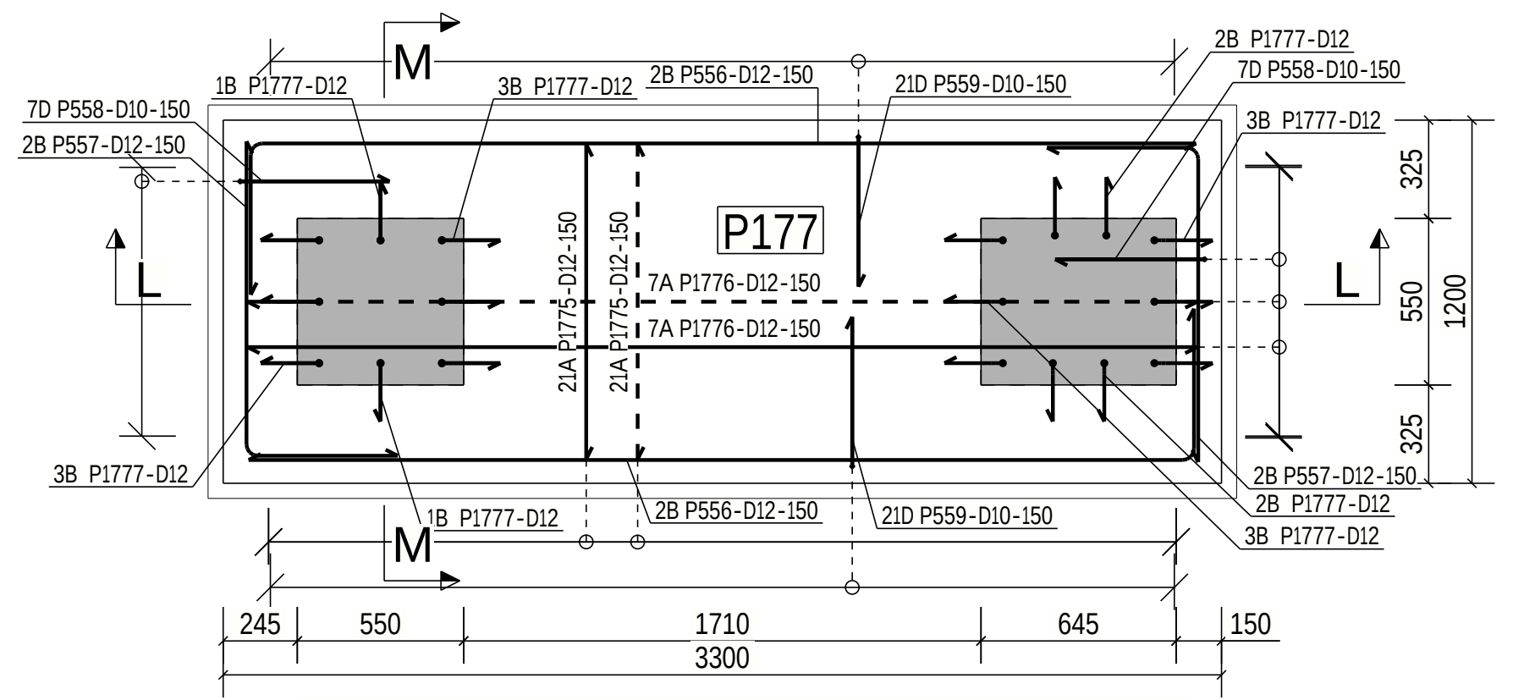

R.C.C. DETAIL OF FOUNDATIONS MKD. P177
(SCALE 1:25)

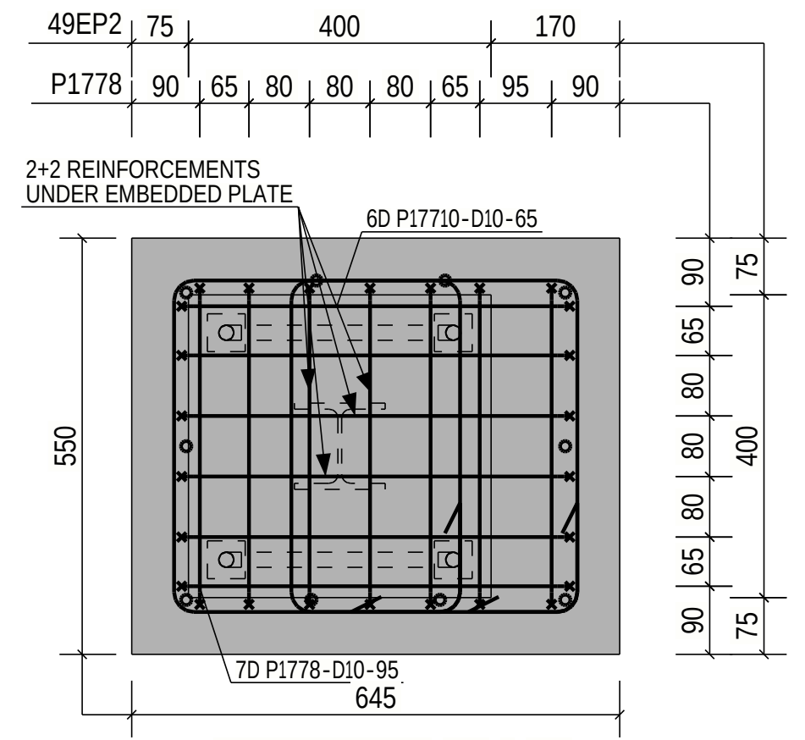

SECTION : 15 - 15
(SCALE 1:10)

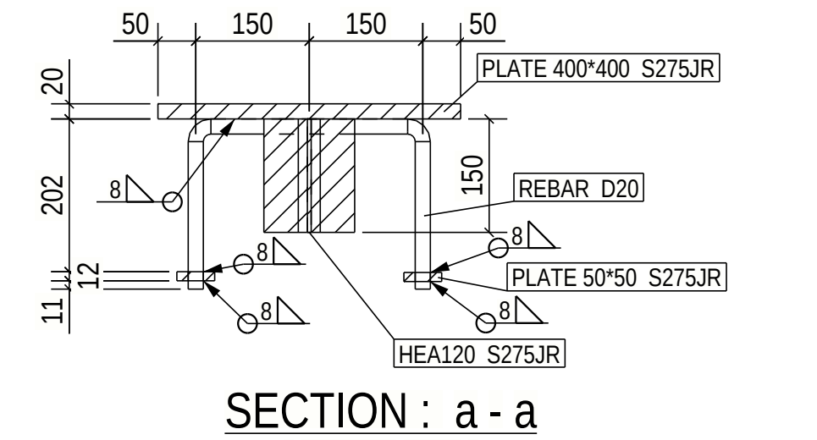

SECTION : a - a
(SCALE 1:10)

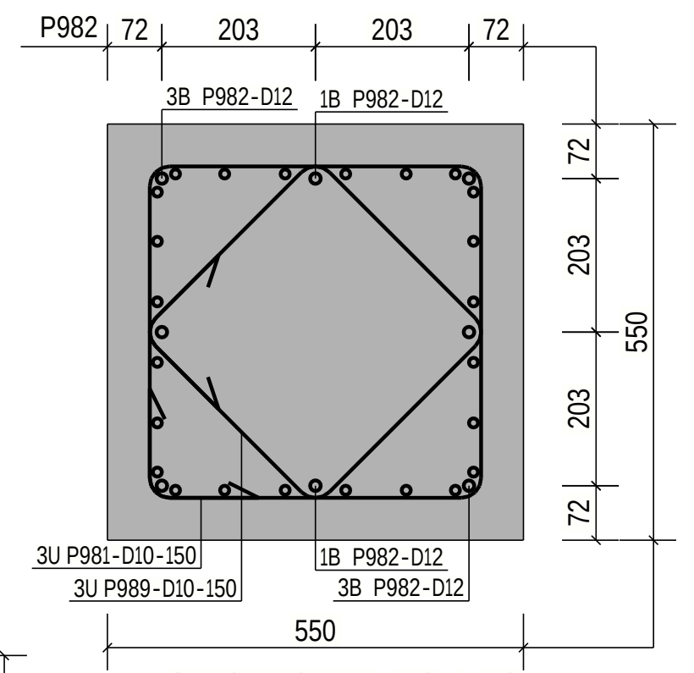

SECTION : 10 - 10
(SCALE 1:10)

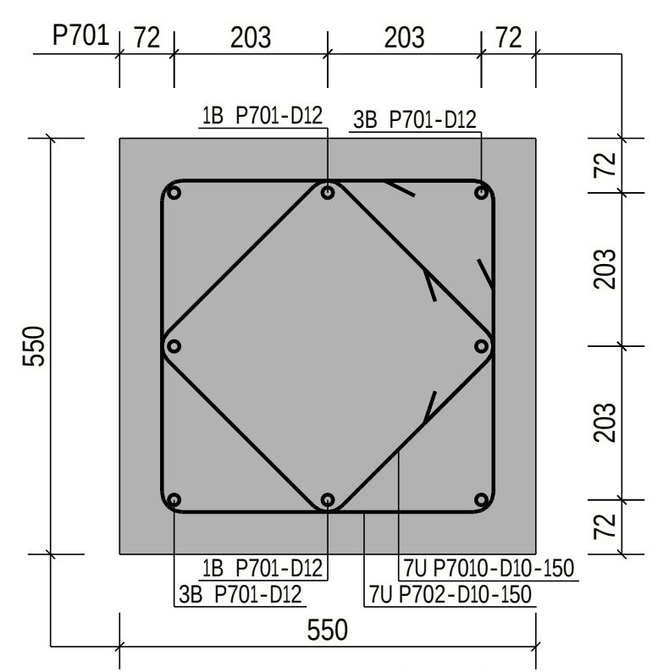

SECTION : 12 - 12
(SCALE 1:10)

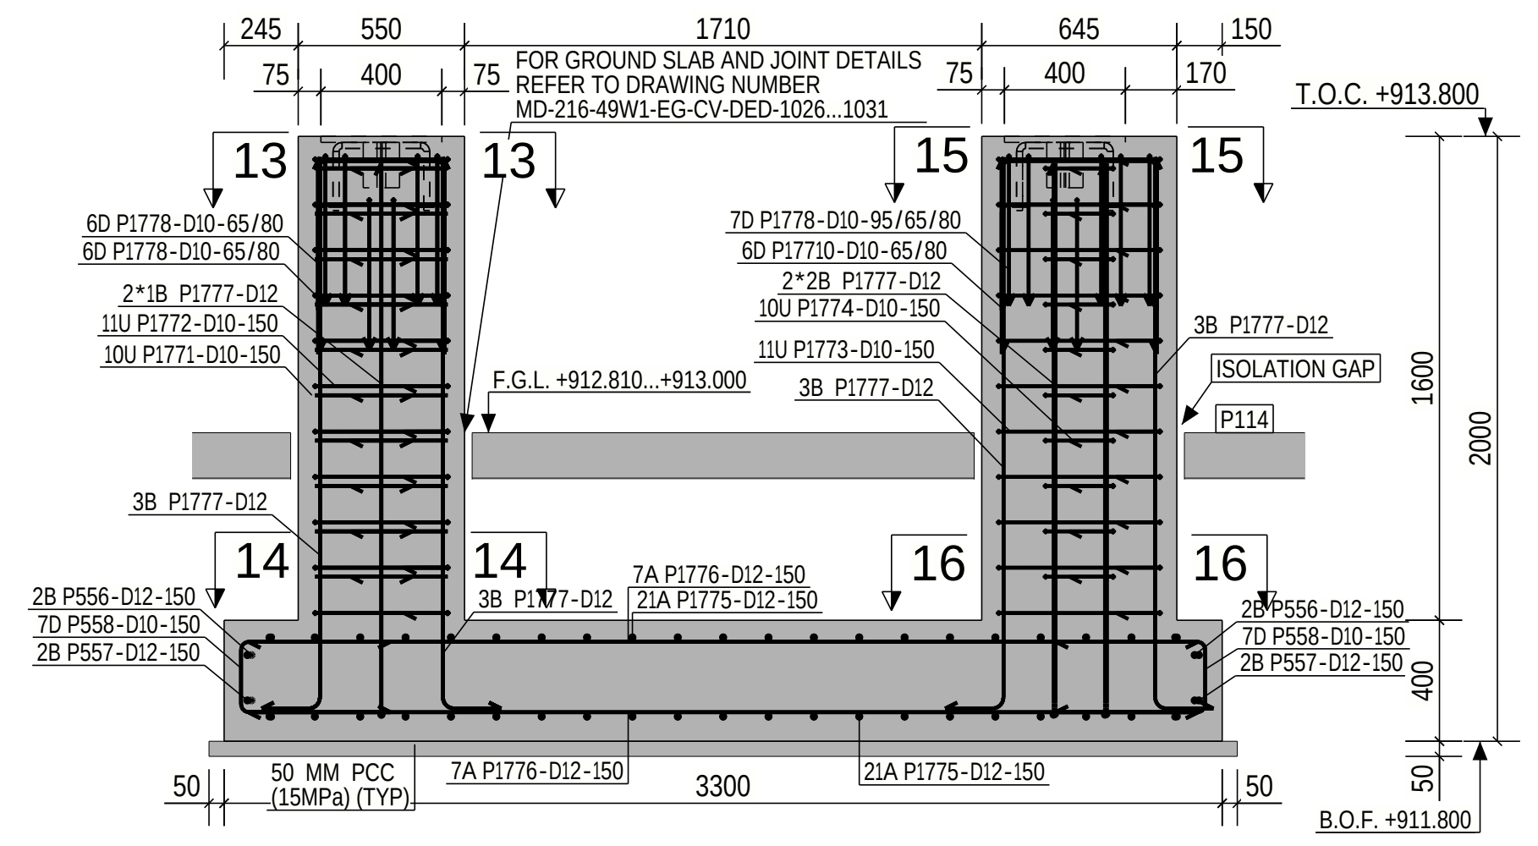

SECTION : L - L
(SCALE 1:25)

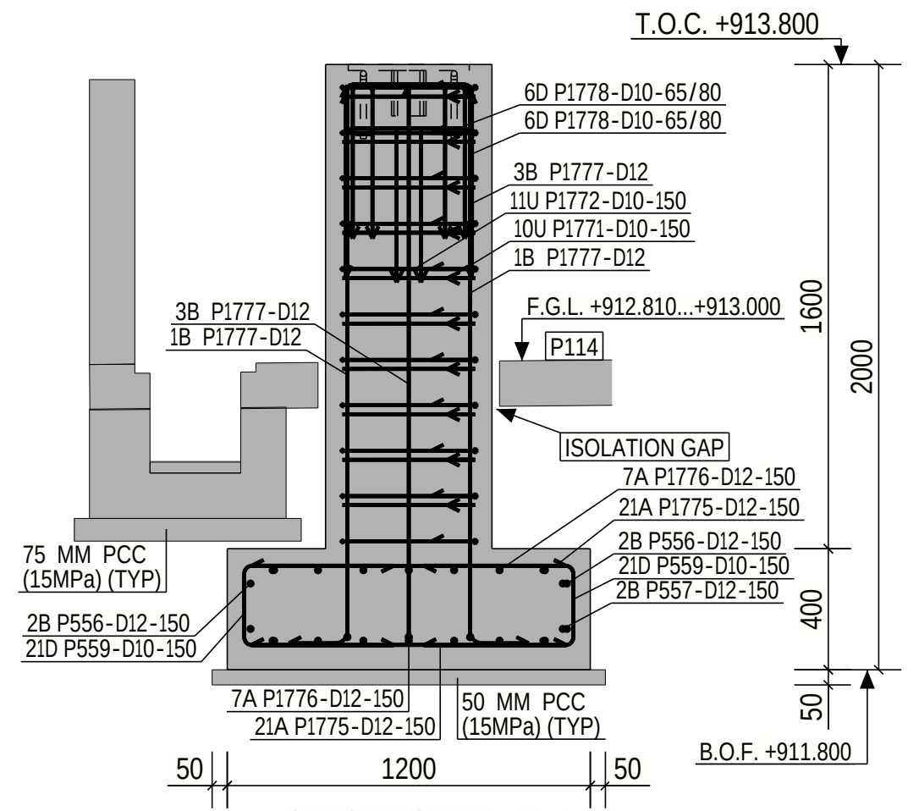

SECTION : M - M
(SCALE 1:25)

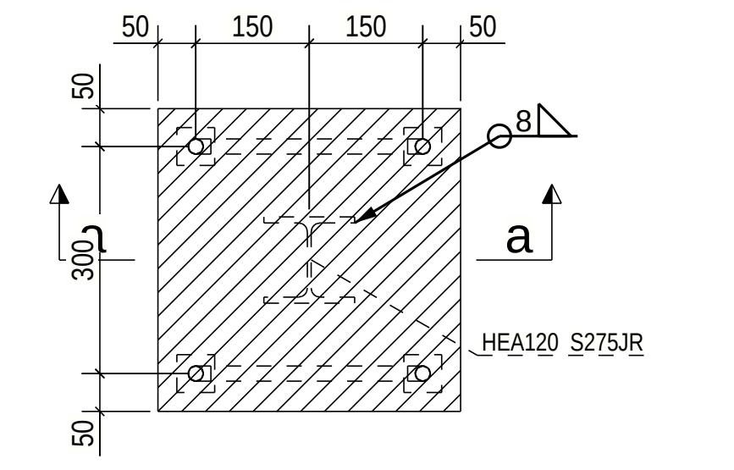

DETAIL OF EMBEDDED PLATE 49EP/2
(SCALE 1:10)

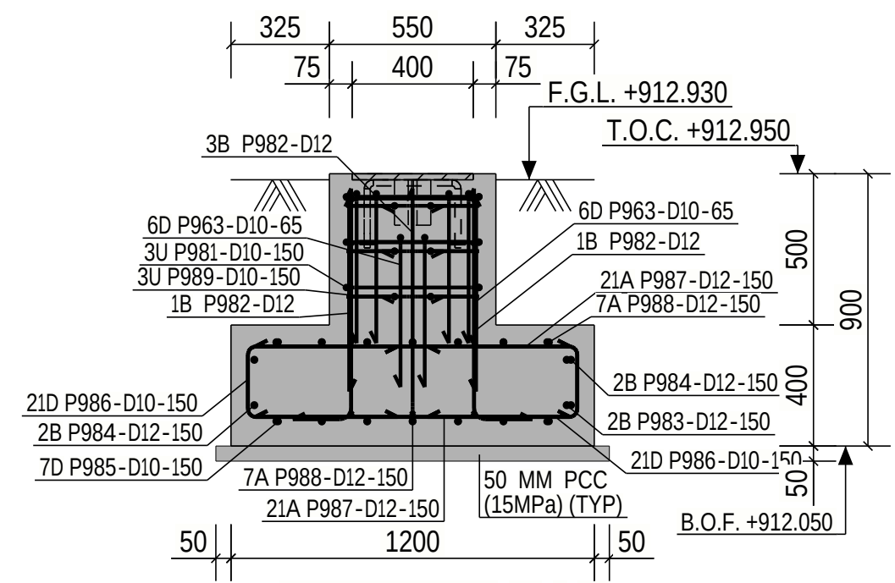

SECTION : G - G
(SCALE 1:25)

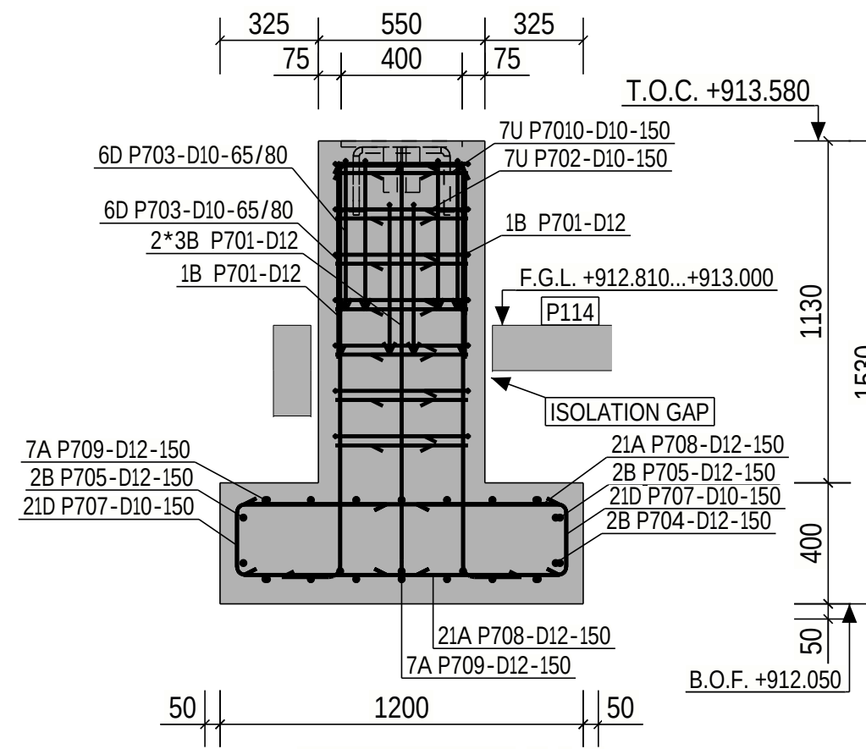

SECTION : J - J
(SCALE 1:25)

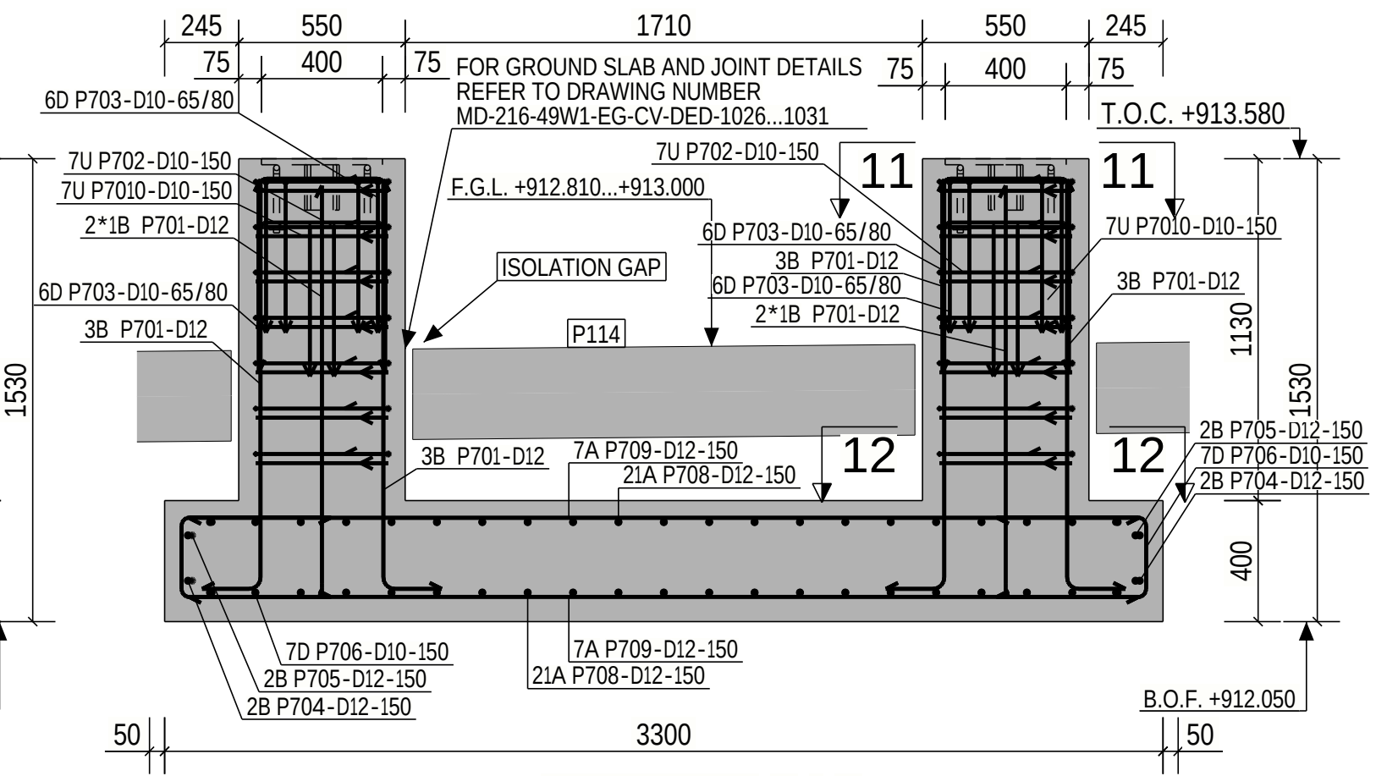

SECTION : K - K
(SCALE 1:25)

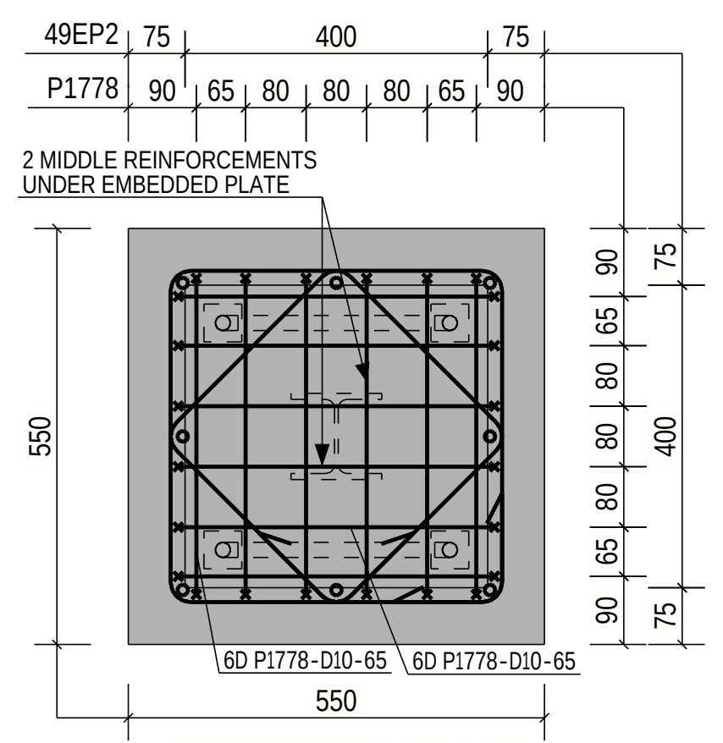

SECTION : 13 - 13
(SCALE 1:10)

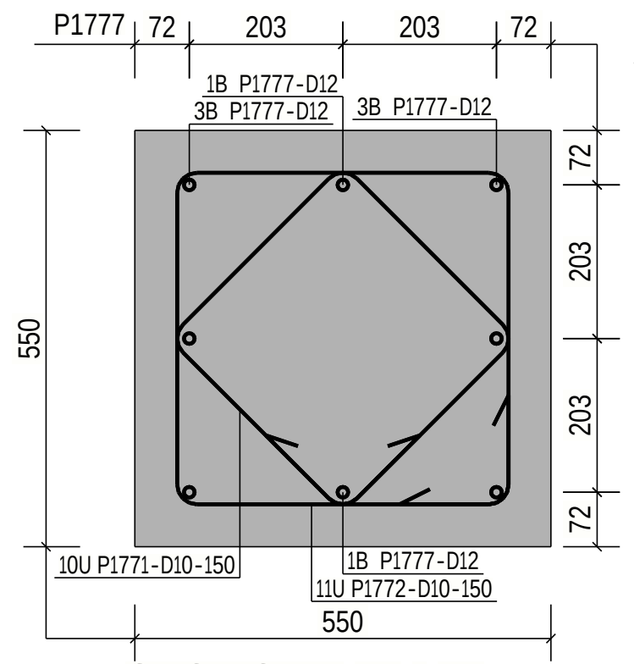

SECTION : 14 - 14
(SCALE 1:10)

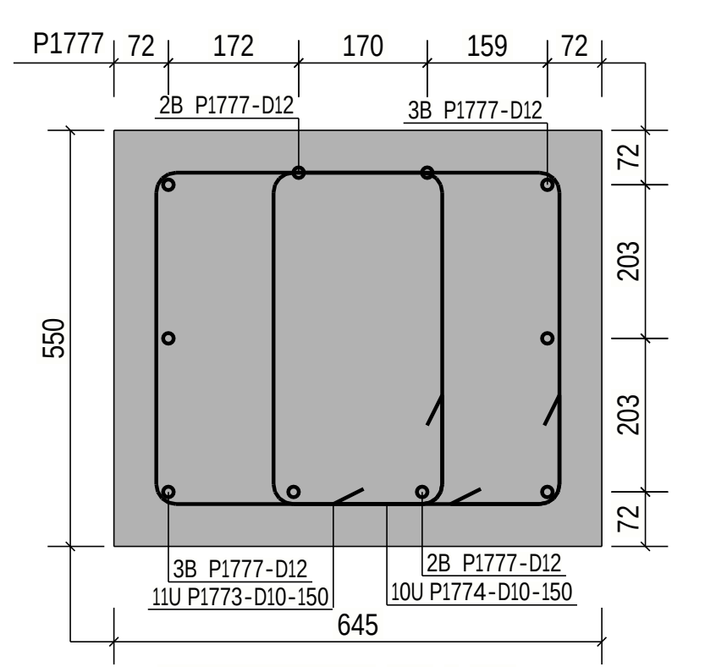

SECTION : 16 - 16
(SCALE 1:10)

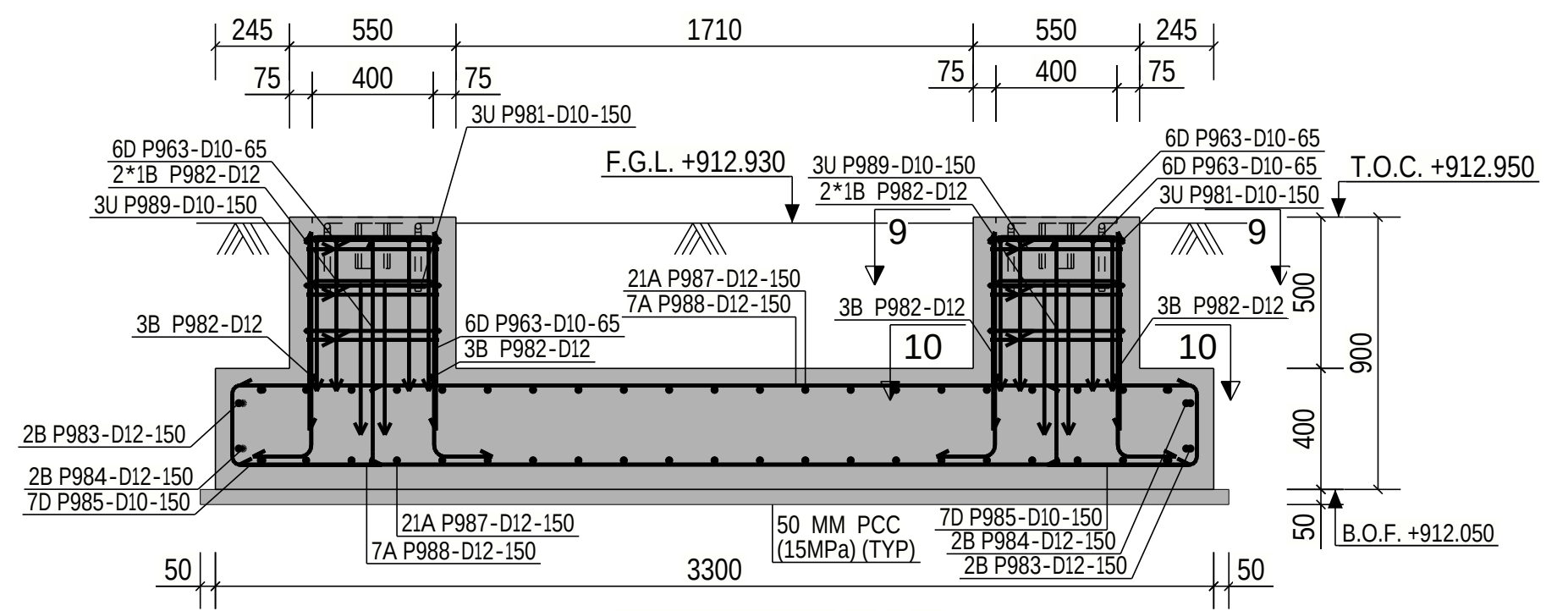

SECTION : H - H
(SCALE 1:25)

LEGEND:

R.L. - REDUCED LEVEL
T.O.C. - TOP OF CONCRETE
B.O.F. - BOTTOM OF FOUNDATION
F.G.L. - FINISHED GROUND LEVEL
P.C.C. - PLAIN CEMENT CONCRETE
TYP - TYPICAL
MKD - MARKED
CL - CENTER LINE
BOTTOM REINF. (B)
TOP REINF. (T)
SBC - SAFE BEARING CAPACITY
MIN. - MINIMUM
REF. - REFERED
GA - GENERAL ARRANGEMENT
DWG. - DRAWING
R.C.C. - REINFORCED CEMENT CONCRETE

NOTES:

1. ALL DIMENSIONS ARE IN MILLIMETRES AND LEVELS ARE IN METRES UNLESS OTHERWISE STATED
2. GRADE OF CONCRETE SHALL BE C35 (35MPa) UNLESS NOTED OTHERWISE & C15 (15MPa) FOR BLINDING CONCRETE.
3. GRADE OF REINFORCEMENT SHALL BE DEFORMED BAR ASTM A615-GRADE 60 (fy=420MPa)
4. CLEAR COVER TO MAIN REINFORCEMENT SHALL BE AS FOLLOWS:
a) FOUNDATION: 75 mm (BOTTOM & SIDE)
b) FOUNDATION: 50 mm (TOP)
c) COLUMN & PEDESTAL: 50 mm
5. MINIMUM LAP LENGTHS OF REINFORCEMENT SHALL BE 40XBAR DIAMETER
6. FOR STANDARD REINFORCEMENT DETAILS & GENERAL NOTES FOR CIVIL WORKS REFER TO DRAWING NUMBER MD-216-1000-EG-CV-DED-1005 & 1001
7. ANCHOR BOLTS AND EMBEDDED STEELWORK SHALL BE HOT DIP GALVANIZED
8. T.O.C. & TOP OF SCREED TOLERANCE SHALL BE WITHIN +/- 10MM OF DESIGN LEVEL
9. NET SAFE BEARING CAPACITY OF SOIL AT BOTTOM OF FOUNDATION IS CONSIDERED AS 375 KN/SQ.M.
10. REBARS CAN BE MOVED LOCALLY BY +/- 25mm TO AVOID INTERFERENCE WITH EMBEDDED PARTS

CONCRETE INFORMATION

REINFORCING BAR LIST
CAST UNIT CODE: P55 PCS: 1

TYPE	POS	PCS	GRADE	D [mm]	L [mm]	dL [mm]	WEIGHT SUM [kg]	a	b	c	d	e	u	v	x	TD	COMMENT
B	P551	18	B500B	12	1750		28.0	1580	200				90			60	
U	P552	9	B500B	10	1980		11.0	150	450	450	450	450				40	
D	P553	19	B500B	10	1380		16.2	500	430	500						40	
A	P554	42	B500B	12	1040		38.8	1040									
A	P555	14	B500B	12	3140		39.0	3140									
B	P556	4	B500B	12	3600		12.8	3132	507				90			60	
B	P557	4	B500B	12	1520		5.4	1046	507				90			60	
D	P558	14	B500B	10	1190		10.4	500	245	500						40	
D	P559	42	B500B	10	1220		31.8	500	275	500						40	
U	P5510	9	B500B	10	2170		12.1	150	545	450	545	450				40	
D	P5511	6	B500B	10	1470		5.5	500	525	500						40	
U	P5512	9	B500B	10	1530		8.5	150	336	336	337	336				40	
U	P5513	9	B500B	10	1550		8.6	150	450	235	450	235				40	

REINFORCING BAR TOTAL WEIGHT [kg] 228.1

REINFORCING BAR LIST
CAST UNIT CODE: P70 PCS: 1

TYPE	POS	PCS	GRADE	D [mm]	L [mm]	dL [mm]	WEIGHT SUM [kg]	a	b	c	d	e	u	v	x	TD	COMMENT
B	P701	16	B500B	12	1530		21.7	1360	200				90			60	
U	P702	14	B500B	10	1980		17.1	150	450	450	450	450				40	
D	P703	24	B500B	10	1380		20.5	500	430	500						40	
B	P704	4	B500B	12	1520		5.4	1046	507				90			60	
B	P705	4	B500B	12	3600		12.8	3132	507				90			60	
D	P706	14	B500B	10	1220		10.6	500	275	500						40	
D	P707	42	B500B	10	1190		31.1	500	245	500						40	
A	P708	42	B500B	12	1040		38.8	1040									
A	P709	14	B500B	12	3140		39.0	3140									
U	P7010	14	B500B	10	1530		13.2	150	336	336	337	336				40	

REINFORCING BAR TOTAL WEIGHT [kg] 210.3

REINFORCING BAR LIST
CAST UNIT CODE: P71 PCS: 1

TYPE	POS	PCS	GRADE	D [mm]	L [mm]	dL [mm]	WEIGHT SUM [kg]	a	b	c	d	e	u	v	x	TD	COMMENT
B	P711	16	B500B	12	1400		19.9	1230	200				90			60	
U	P712	14	B500B	10	1980		17.1	150	450	450	450	450				40	
D	P713	24	B500B	10	1380		20.5	500	430	500						40	
A	P714	42	B500B	12	1040		38.8	1040									
A	P715	14	B500B	12	3140		39.0	3140									
B	P716	4	B500B	12	3600		12.8	3132	507				90			60	
B	P717	4	B500B	12	1520		5.4	1046	507				90			60	
D	P718	14	B500B	10	1190		10.4	500	245	500						40	
D	P719	42	B500B	10	1220		31.8	500	275	500						40	
U	P7110	12	B500B	10	1530		11.3	150	336	336	337	336				40	

REINFORCING BAR TOTAL WEIGHT [kg] 207.1

REINFORCING BAR LIST
CAST UNIT CODE: P96 PCS: 1

TYPE	POS	PCS	GRADE	D [mm]	L [mm]	dL [mm]	WEIGHT SUM [kg]	a	b	c	d	e	u	v	x	TD	COMMENT
U	P961	12	B500B	10	1980		14.7	150	450	450	450	450				40	
B	P962	16	B500B	12	1270		18.0	1100	200				90			60	
D	P963	24	B500B	10	1380		20.5	500	430	500						40	
B	P964	4	B500B	12	3600		12.8	3132	507				90			60	
B	P965	4	B500B	12	1520		5.4	1046	507				90			60	
D	P966	14	B500B	10	1190		10.4	500	245	500						40	
D	P967	42	B500B	10	1220		31.8	500	275	500						40	
A	P968	42	B500B	12	1040		38.8	1040									
A	P969	14	B500B	12	3140		39.0	3140									
U	P9610	10	B500B	10	1530		9.5	150	336	336	337	336				40	

REINFORCING BAR TOTAL WEIGHT [kg] 200.9

REINFORCING BAR LIST
CAST UNIT CODE: P98 PCS: 1

TYPE	POS	PCS	GRADE	D [mm]	L [mm]	dL [mm]	WEIGHT SUM [kg]	a	b	c	d	e	u	v	x	TD	COMMENT
D	P963	24	B500B	10	1380		20.5	500	430	500						40	
U	P981	6	B500B	10	1980		7.3	150	450	450	450	450				40	
B	P982	16	B500B	12	920		13.1	750	200				90			60	
B	P983	4	B500B	12	1520		5.4	1046	507				90			60	
B	P984	4	B500B	12	3600		12.8	3132	507				90			60	
D	P985	14	B500B	10	1220		10.6	500	275	500						40	
D	P986	42	B500B	10	1190		31.1	500	245	500						40	
A	P987	42	B500B	12	1040		38.8	1040									
A	P988	14	B500B	12	3140		39.0	3140									
U	P989	6	B500B	10	1530		5.7	150	336	336	337	336				40	

REINFORCING BAR TOTAL WEIGHT [kg] 184.3

REINFORCING BAR LIST
CAST UNIT CODE: P177 PCS: 1

TYPE	POS	PCS	GRADE	D [mm]	L [mm]	dL [mm]	WEIGHT SUM [kg]	a	b	c	d	e	u	v	x	TD	COMMENT
B	P556	4	B500B	12	3600		12.8	3132	507				90			60	
B	P557	4	B500B	12	1520		5.4	1046	507				90			60	
D	P558	14	B500B	10	1190		10.4	500	245	500						40	
D	P559	42	B500B	10	1220		31.8	500	275	500						40	
U	P1771	20	B500B	10	1530		18.9	150	336	336	337	336				40	
U	P1772	22	B500B	10	1980		26.9	150	450	450	450	450				40	
U	P1773	11	B500B	10	2170		14.8	150	545	450	545	450				40	
U	P1774	10	B500B	10	1550		9.6	150	450	235	450	235				40	
A	P1775	42	B500B	12	1040		38.8	1040									
A	P1776	14	B500B	12	3140		39.0	3140									
B	P1777	26	B500B	12	2000		46.2	1830	200				90			60	
D	P1778	31	B500B	10	1380		26.5	500	430	500						40	
D	P17710	6	B500B	10	1470		5.5	500	525	500						40	

REINFORCING BAR TOTAL WEIGHT [kg] 286.5

REINFORCEMENT BENDING SHAPES:

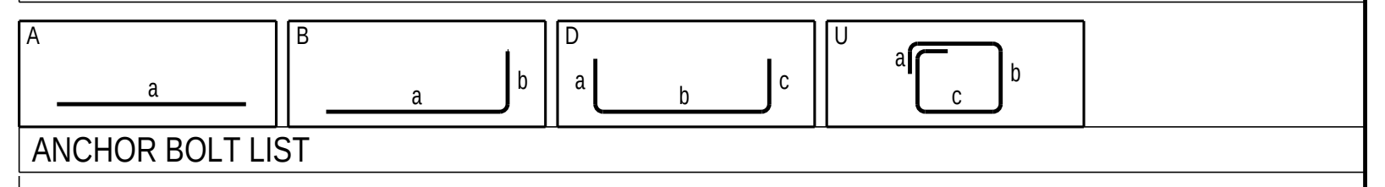

ANCHOR BOLT LIST

VALUE	UNIT	EMBEDS

KEYPLAN

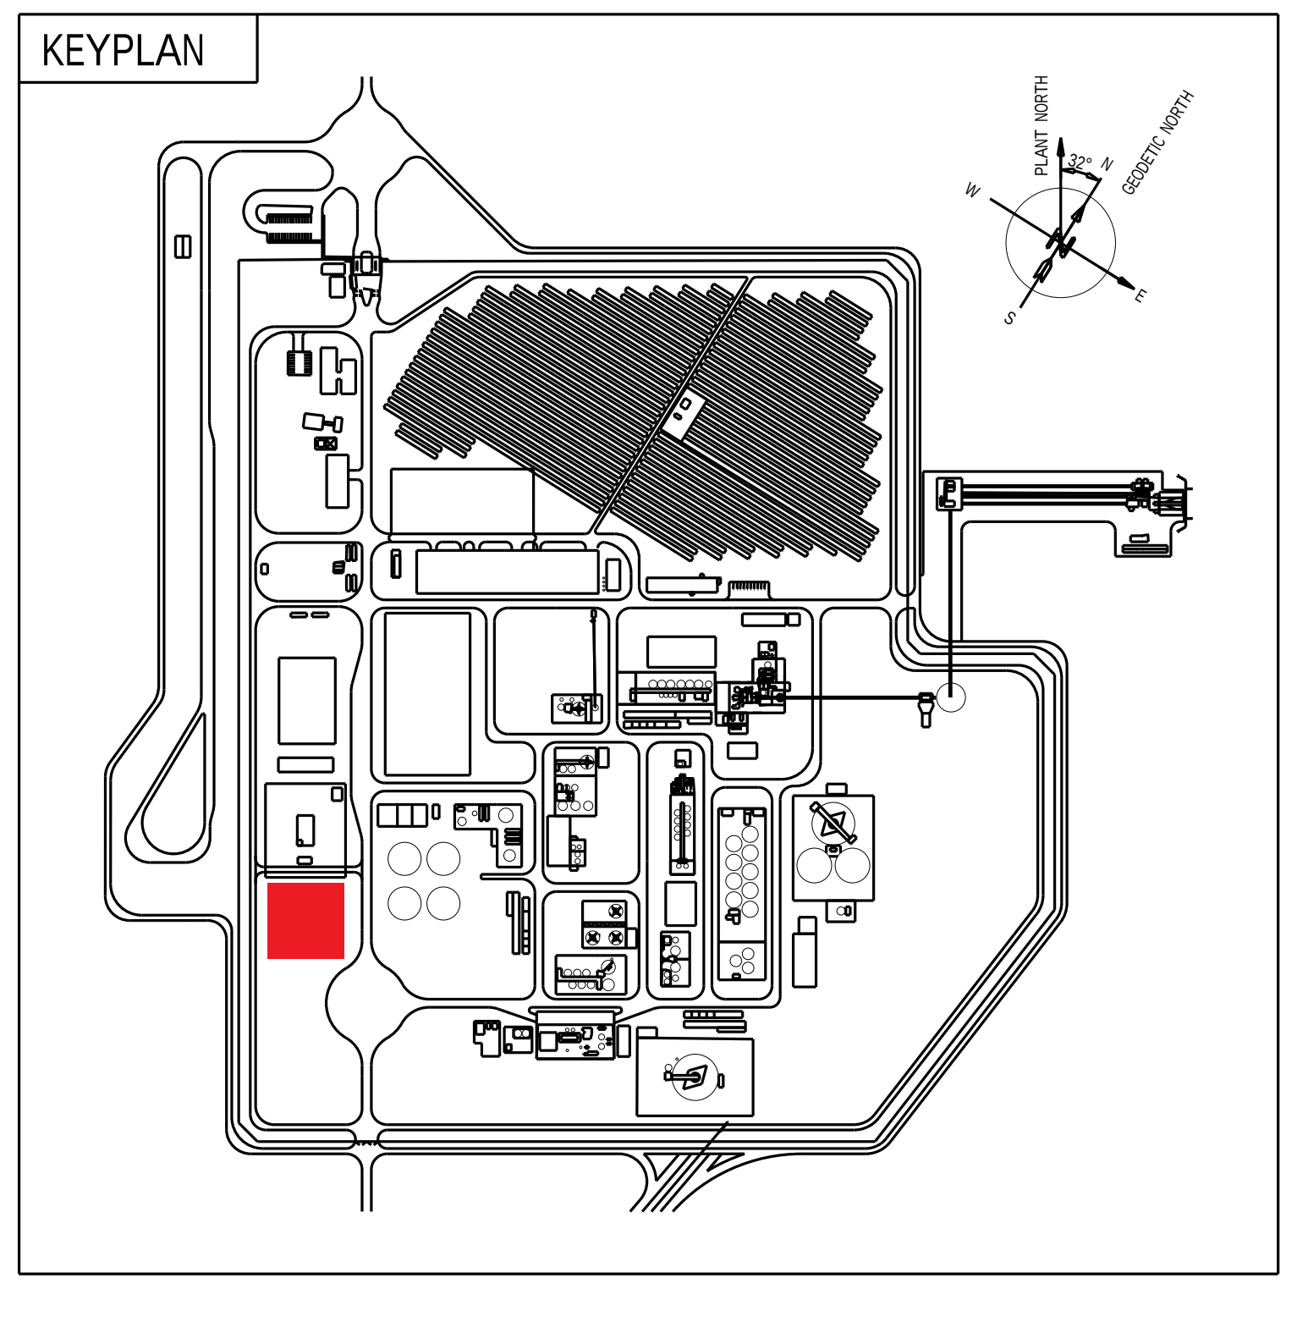

DOCUMENT NUMBER	REFERENCE DOCUMENTS	DOCUMENT NUMBER	REFERENCE DOCUMENTS
MD-216-49W1-EG-CV-CAL-1006	CALCULATIO REPORT		
MD-216-49W1-EG-CV-DED-1031	DETAIL- AND REINFORCEMENT DRAWING SLAB SECTOR GL D-G/1-4	MD-216-1000-EG-ST-CRT-1001	DESIGN CRITERIA
MD-216-49W1-EG-CV-DED-1028	DETAIL- AND REINFORCEMENT DRAWING SLAB SECTOR GL G-J/1-5	MD-216-49W1-EG-CV-DED-1030	DETAIL- AND REINFORCEMENT DRAWING SLAB SECTOR GL D-G/4-8
MD-216-49W1-EG-CV-GAD-1001	GENERAL ARRANGEMENT DRAWING 1-7/E-J	MD-216-49W1-EG-CV-GAD-1003	GENERAL ARRANGEMENT DRAWING 1-10/A-E

REV	DATE	REVISION DESCRIPTION	DRN	CHK	ENG	APP	EMP
D01	29.01.2024	AS-BUILT	JonRen	MauNot	NanWu	LuiPiz	
C01	01.03.2022	ISSUED FOR CONSTRUCTION	JonRen	MauNot	NanWu	LuiPiz	
A01	04.02.2022	ISSUED FOR APPROVAL	KalKar	MauNot	NanWu	LuiPiz	

RESERVED FOR VENDOR LOGO AND DRAWING NUMBER

LARSEN & TOUBRO

This drawing is the property of LARSEN & TOUBRO and must not be passed on to any person or body not authorized by us to recieve it or be copied or otherwise made use either in full or in part by such person or body without our prior permission in writing.

Outotec

The content of these documents are the sole property of Outotec Oyj. Any rights not expressly granted herein are reserved. Reproduction, transfer or distribution of part or all of the contents in any form without prior written permission of Outotec is prohibited.

MA'ADEN معادن
Saudi Arabian Mining Company شركة التعدين العربية السعودية

This document and the information contained herein is Ma'aden proprietary know-how. This document or any part thereof should not be reproduced, stored in a retrieval system or transmitted by any means, electronic or otherwise, or divulged without prior written permission of Ma'aden.

LARSEN & TOUBRO DRAWING NUMBER			REVISION
019045_080_C_D_24892_024_R0			2
OUTOTEC DRAWING NUMBER		DOCUMENT ID	REVISION
900707_GAU01_AG11_CTB01_49024		OU100736750	2

DRAWN	KalKar	04.02.2022
CHECKED	MauNot	04.02.2022
ENGINEER	KalKar	04.02.2022
APPROVED	LuiPiz	04.02.2022
EMPLOYER		
SCALE	1:25	A0

MANSOURAH - MASSARAH GOLD PROJECT
49W1 RAW WATER TREATMENT PLANT
CONTAINER FOUNDATIONS
DETAIL- AND REINFORCEMENT DRAWING

DRAWING NUMBER
MD-216-49W1-EG-CV-DED-1024
REV
D01

Tekla Structures