

DRAWING NUMBER
MD-216-49W1-EG-CV-DED-1025
REV
D01


CONCRETE INFORMATION
Concretes used C35

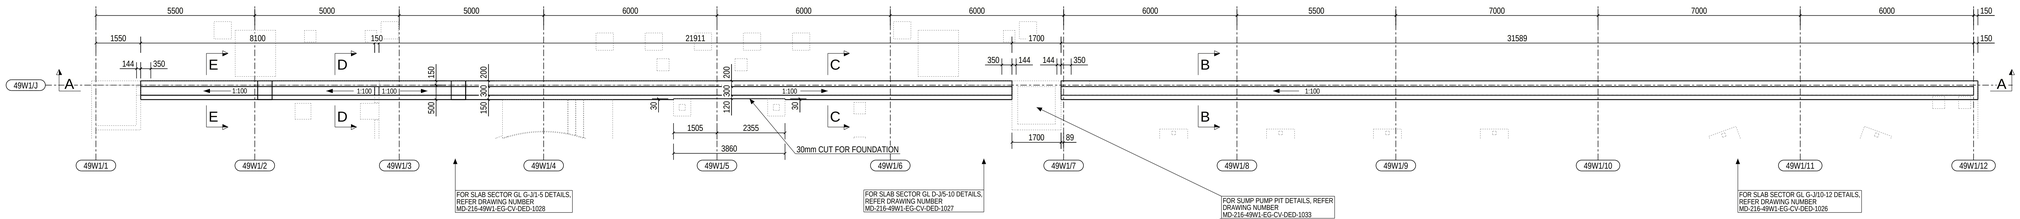


NORTH DRAIN CANAL - GENERAL ARRANGEMENT PLAN
(SCALE 1:75)

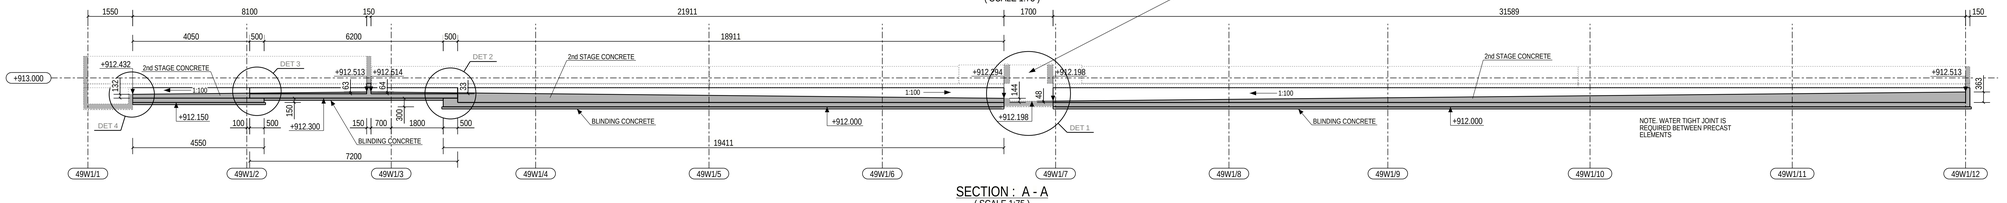


SECTION : A - A
(SCALE 1:75)

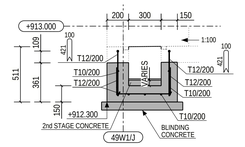


SECTION : D - D
(SCALE 1:20)

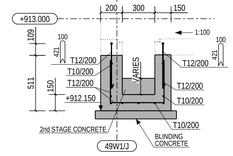


SECTION : E - E
(SCALE 1:20)

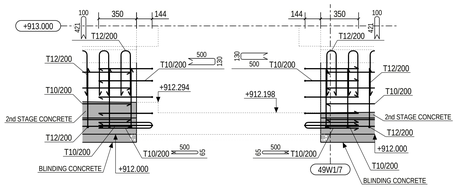


DETAIL 1
(SCALE 1:20)

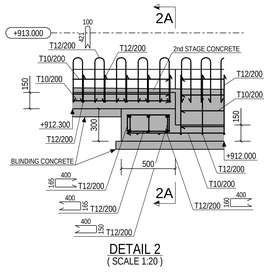


DETAIL 2
(SCALE 1:20)

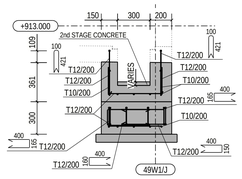


SECTION : 2A - 2A
(SCALE 1:20)

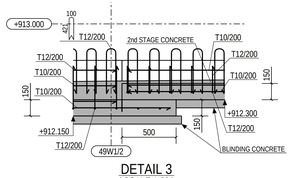


DETAIL 3
(SCALE 1:20)

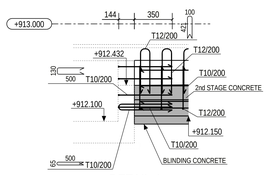

DETAIL 4
(SCALE 1:20)

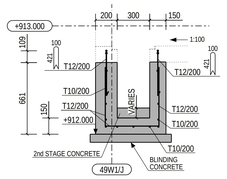

SECTION : B - B
(SCALE 1:20)

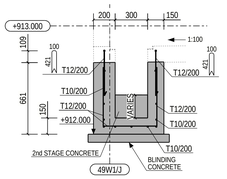

SECTION : C - C
(SCALE 1:20)


CANALS WILL BE PRECAST ELEMENTS.

SUITABLE LENGTH OF PRECAST ELEMENTS TO BE DECIDED BY SUPPLIER. LIFTING HOOKS AND LOCATIONS TO BE PROVIDED BY SUPPLIER.


SLOPE INSIDE CANAL TO BE MADE ON SITE WITH 2nd STAGE CONCRETE.

LEGEND:
R.L - REDUCED LEVEL
T.O.C. - TOP OF CONCRETE
B.O.F. - BOTTOM OF FOUNDATION
F.G.L. - FINISHED GROUND LEVEL
P.C.C. - PLAIN CEMENT CONCRETE
TYP - TYPICAL
MKD - MARKED
CL - CENTER LINE
BOTTOM REINF. (B)
TOP REINF. (T)
SBC - SAFE BEARING CAPACITY
MIN. - MINIMUM
REF. - REFERED
GA - GENERAL ARRANGEMENT
DWG. - DRAWING
R.C.C. - REINFORCED CEMENT CONCRETE


NOTES:
1. ALL DIMENSIONS ARE IN MILLIMETRES AND LEVELS ARE IN METRES UNLESS OTHERWISE STATED
2. GRADE OF CONCRETE SHALL BE C35 (35MPa) UNLESS NOTED OTHERWISE & C15 (15MPa) FOR BLINDING CONCRETE.
3. GRADE OF REINFORCEMENT SHALL BE DEFORMED BAR ASTM A615-GRADE 60 (fy=420MPa)
4. CLEAR COVER TO MAIN REINFORCEMENT SHALL BE AS FOLLOWS:
a) FOUNDATION: 75 mm (BOTTOM & SIDE)
b) FOUNDATION: 50 mm (TOP)
c) COLUMN & PEDESTAL: 50 mm
5. MINIMUM LAP LENGTHS OF REINFORCEMENT SHALL BE 40XBAR DIAMETER
6. FOR STANDARD REINFORCEMENT DETAILS & GENERAL NOTES FOR CIVIL WORKS REFER TO DRAWING NUMBER MD-216-1000-EG-CV-DED-1005 & 1001
7. ANCHOR BOLTS AND EMBEDDED STEELWORK SHALL BE HOT DIP GALVANIZED
8. T.O.C. & TOP OF SCREED TOLERANCE SHALL BE WITHIN +/- 10MM OF DESIGN LEVEL
9. NET SAFE BEARING CAPACITY OF SOIL AT BOTTOM OF FOUNDATION IS CONSIDERED AS 375 KN/SQ.M.
10. REBARS CAN BE MOVED LOCALLY BY +/- 25mm TO AVOID INTERFERENCE WITH EMBEDDED PARTS
11. SECOND STAGE CONCRETE (IN SITU) SHALL BE FINISHED PER 5.13.1 OF MA'ADEN SPECIFICATION MD-101-SMEM-EG-CV-SPC-0003.

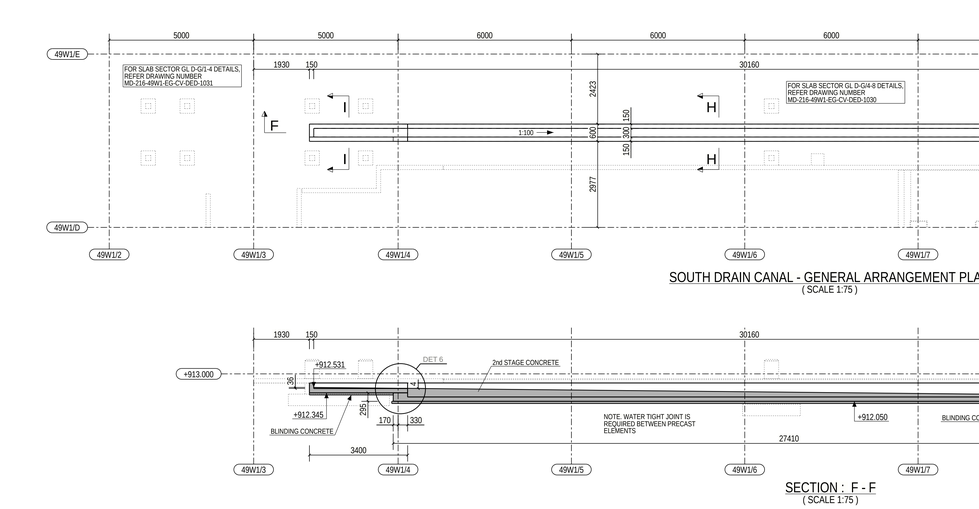


SOUTH DRAIN CANAL - GENERAL ARRANGEMENT PLAN
(SCALE 1:75)

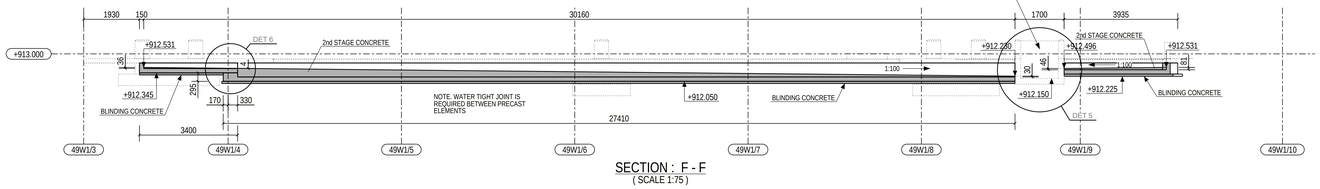


SECTION : F - F
(SCALE 1:75)

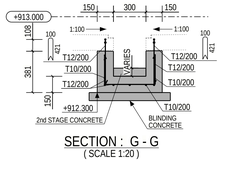


SECTION : G - G
(SCALE 1:20)

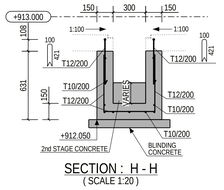


SECTION : H - H
(SCALE 1:20)

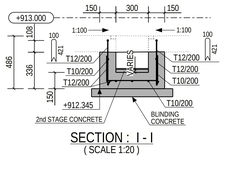


SECTION : I - I
(SCALE 1:20)

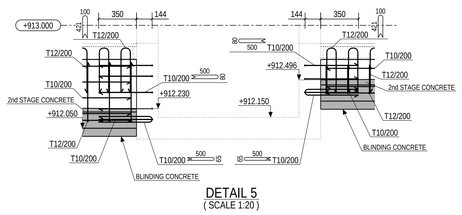

DETAIL 5
(SCALE 1:20)

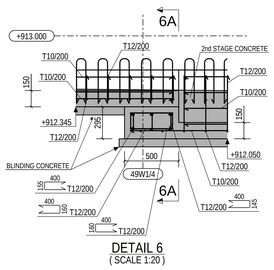


DETAIL 6
(SCALE 1:20)

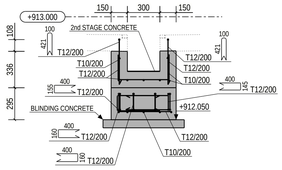

SECTION : 6A - 6A
(SCALE 1:20)

KEYPLAN

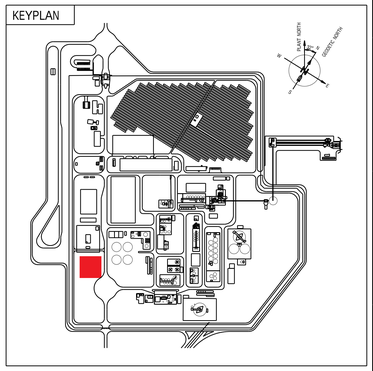

DOCUMENT NUMBER	REFERENCE DOCUMENTS
MD-216-49W1-EG-CV-DED-1033	SUMP PUMP PIT DIMENSIONAL- AND REINFORCEMENT DRAWING
MD-216-49W1-EG-CV-DED-1031	SLAB DETAIL- AND REINFORCEMENT DRAWING - GRIDLINES D-G/1-4
MD-216-49W1-EG-CV-DED-1029	SLAB DETAIL- AND REINFORCEMENT DRAWING - GRIDLINES D-G/8-12
MD-216-49W1-EG-CV-DED-1027	SLAB DETAIL- AND REINFORCEMENT DRAWING - GRIDLINES G-J/5-10
MD-216-49W1-EG-CV-GAD-1003	GENERAL ARRANGEMENT DRAWING - GRIDLINES 1-10/A-E
MD-216-49W1-EG-CV-GAD-1001	GENERAL ARRANGEMENT DRAWING - GRIDLINES 1-7/E-J

DOCUMENT NUMBER	REFERENCE DOCUMENTS
MD-216-1000-EG-ST-CRT-1001	DESIGN CRITERIA
MD-216-49W1-EG-CV-DED-1030	SLAB DETAIL- AND REINFORCEMENT DRAWING - GRIDLINES D-G/4-8
MD-216-49W1-EG-CV-DED-1028	SLAB DETAIL- AND REINFORCEMENT DRAWING - GRIDLINES G-J/1-5
MD-216-49W1-EG-CV-DED-1026	SLAB DETAIL- AND REINFORCEMENT DRAWING - GRIDLINES G-J/10-12
MD-216-49W1-EG-CV-GAD-1002	GENERAL ARRANGEMENT DRAWING - GRIDLINES 7-12/E-J

REV	DATE	REVISION DESCRIPTION	DRN	CHK	ENG	APP	EMP
D01	29.01.2024	AS-BUILT	JonNm	MauNot	NamWu	LuiPiz	
C01	01.03.2022	ISSUED FOR CONSTRUCTION	JonNm	MauNot	NamWu	LuiPiz	
A01	10.02.2022	ISSUED FOR APPROVAL	NikJan	MauNot	LuiPiz	SouCha	

RESERVED FOR VENDOR LOGO AND DRAWING NUMBER

LARSEN & TOUBRO

This drawing is the property of LARSEN & TOUBRO and must not be passed on to any person or body not authorized by us to receive it or be copied or otherwise made use either in full or in part by such person or body without our prior permission in writing.

Outotec

The content of these documents are the sole property of Outotec Oy. Any rights not expressly granted herein are reserved. Reproduction, transfer or distribution of part or all of the contents in any form without prior written permission of Outotec is prohibited.

MA'ADEN معادن
Saudi Arabian Mining Company شركة معادن العربية السعودية

This document and the information contained herein is Ma'aden proprietary know-how. This document or any part thereof should not be reproduced, stored in a retrieval system or transmitted by any means, electronic or otherwise, or divulged without prior written permission of Ma'aden.

LARSEN & TOUBRO DRAWING NUMBER	019045_080_C_D_24892_025
OUTOTEC DRAWING NUMBER	900707_GAU01_AG11_CTB01_49025
EMPLOYER	
SCALE	1:75

REVISION 2
DOCUMENT ID OU100736751
REVISION 2

DRAWN	NikJan	10.02.2022
CHECKED	MauNot	10.02.2022
ENGINEER	LuiPiz	10.02.2022
APPROVED	SouCha	10.02.2022

A0

MANSOURAH - MASSARAH GOLD PROJECT
49W1 RAW WATER TREATMENT PLANT
PRECAST DRAIN CANALS
DIMENSIONAL- AND REINFORCEMENT DRAWING

DRAWING NUMBER MD-216-49W1-EG-CV-DED-1025
REV D01