


DRAWING NUMBER: MD-216-49W1-EG-CV-DED-1026 | REV: D01

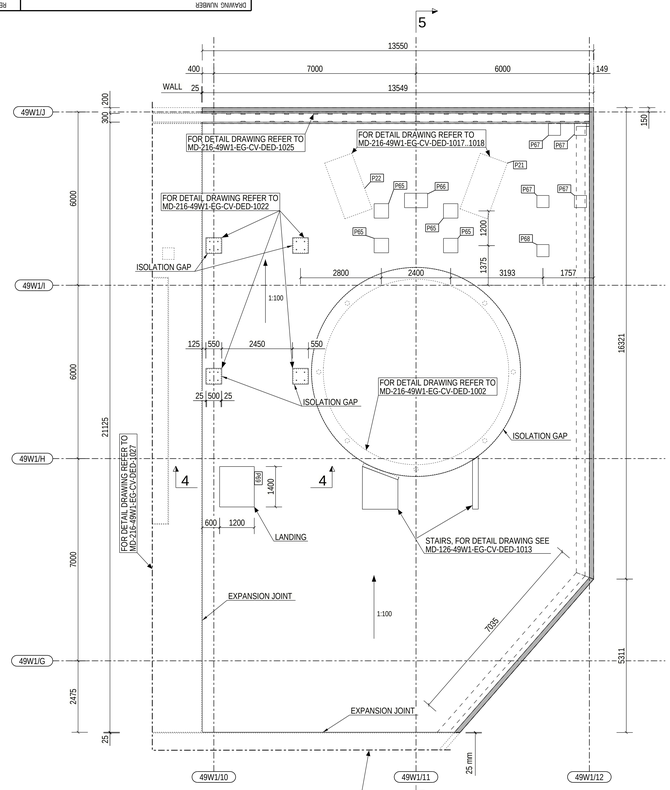


DIMENSION DRAWING
(SCALE 1:75)

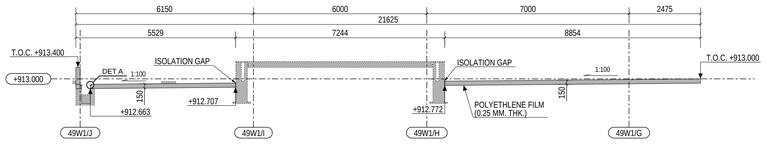


SECTION : 5 - 5
(SCALE 1:75)

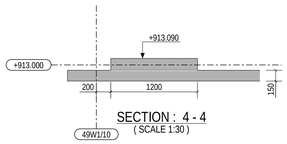


SECTION : 4 - 4
(SCALE 1:30)

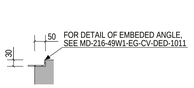


DETAIL A
1:10

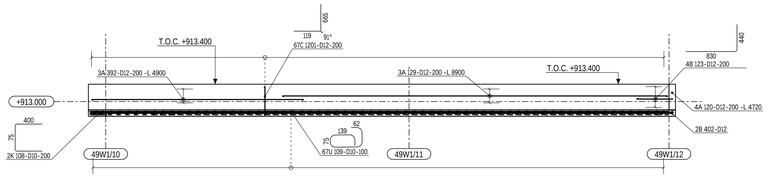


SECTION : 3 - 3
(SCALE 1:50)

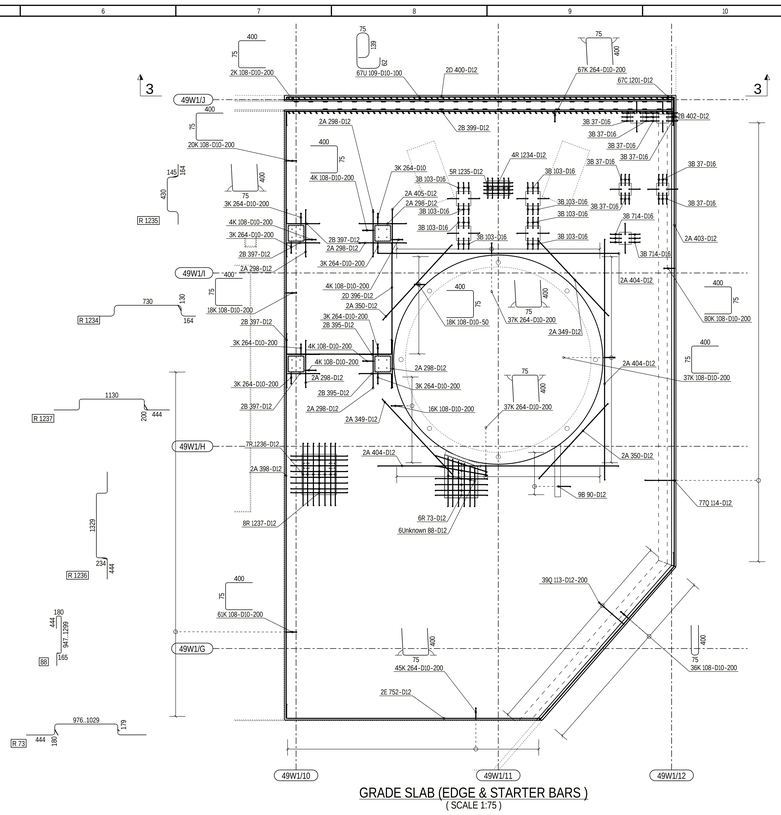


GRADE SLAB (EDGE & STARTER BARS)
(SCALE 1:75)

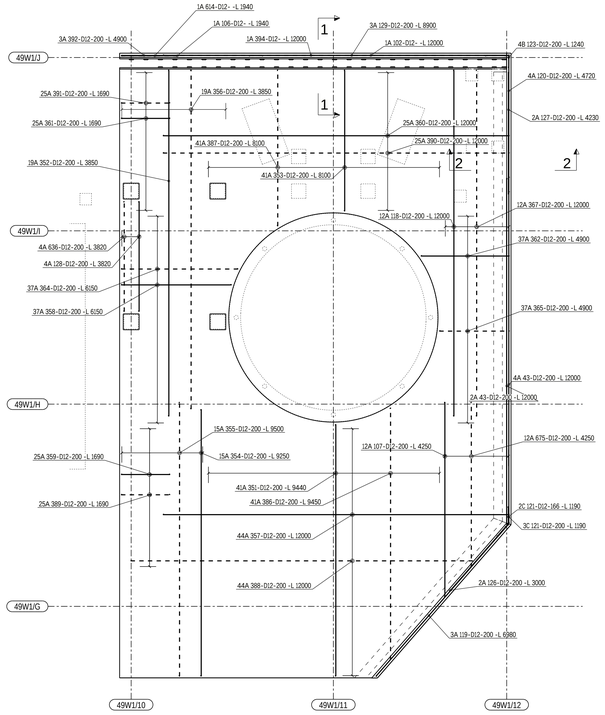


GRADE SLAB (LONGITUDINAL BARS)
(SCALE 1:75)

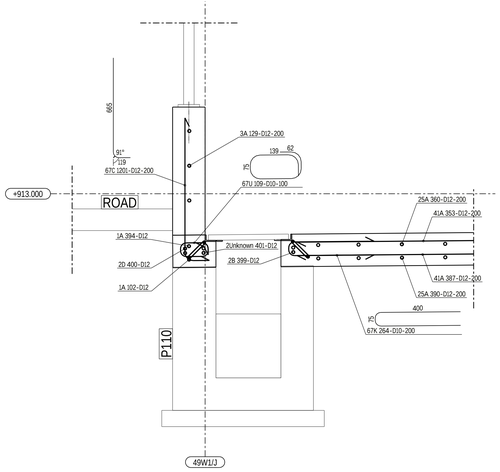


SECTION : 1 - 1
(SCALE 1:10)

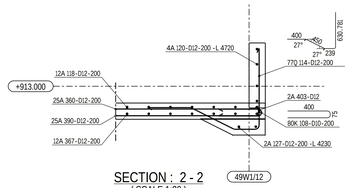


SECTION : 2 - 2
(SCALE 1:20)

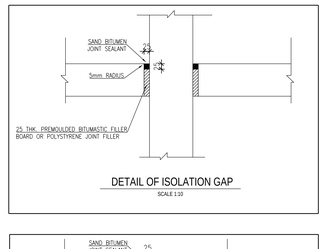


DETAIL OF ISOLATION GAP
SCALE 1:10

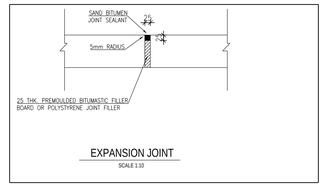

EXPANSION JOINT
SCALE 1:10

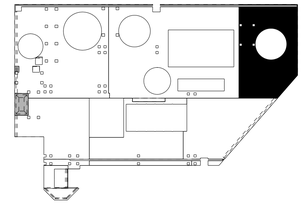

KEYPLAN

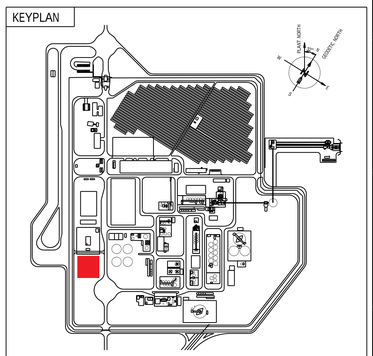

CONCRETE INFORMATION	
Concretes used	C35
Concrete cover 1	50±10mm

LEGEND:
R.L - REDUCED LEVEL
T.O.C. - TOP OF CONCRETE
B.O.F. - BOTTOM OF FOUNDATION
F.G.L - FINISHED GROUND LEVEL
P.C.C. - PLAIN CEMENT CONCRETE
TYP - TYPICAL
MKD - MARKED
CL - CENTER LINE
BOTTOM REINF. (B)
TOP REINF. (T)
SBC - SAFE BEARING CAPACITY
MIN. - MINIMUM
REF. - REFERED
GA - GENERAL ARRANGEMENT
DWG. - DRAWING
R.C.C. - REINFORCED CEMENT CONCRETE

NOTES:
1. ALL DIMENSIONS ARE IN MILLIMETRES AND LEVELS ARE IN METRES UNLESS OTHERWISE STATED
2. GRADE OF CONCRETE SHALL BE C35 (35MPa) UNLESS NOTED OTHERWISE & C15 (15MPa) FOR BUNDING CONCRETE.
3. GRADE OF REINFORCEMENT SHALL BE DEFORMED BAR ASTM A615-GRADE 60 (fy=420MPa)
4. CLEAR COVER TO MAIN REINFORCEMENT SHALL BE AS FOLLOWS:
a) FOUNDATION: 75 mm (BOTTOM & SIDE)
b) FOUNDATION: 50 mm (TOP)
c) COLUMN & PEDESTAL: 50 mm
5. MINIMUM LAP LENGTHS OF REINFORCEMENT SHALL BE 40XBAR DIAMETER
6. FOR STANDARD REINFORCEMENT DETAILS & GENERAL NOTES FOR CIVIL WORKS REFER TO DRAWING NUMBER MD-216-1000-EG-CV-DED-1005 & 1001
7. ANCHOR BOLTS AND EMBEDDED STEELWORK SHALL BE HOT DIP GALVANIZED
8. T.O.C. & TOP OF SCREED TOLERANCE SHALL BE WITHIN +/- 10MM OF DESIGN LEVEL
9. NET SAFE BEARING CAPACITY OF SOIL AT BOTTOM OF FOUNDATION IS CONSIDERED AS 375 KN/SQ.M.
10. REBARS CAN BE MOVED LOCALLY BY +/- 25mm TO AVOID INTERFERENCE WITH EMBEDDED PARTS

DOCUMENT NUMBER	REFERENCE DOCUMENTS	DOCUMENT NUMBER	REFERENCE DOCUMENTS
MD-216-49W1-EG-CV-DED-1011	49W1-TNK-001 PIT		
MD-216-49W1-EG-CV-DED-1002	TANK FOUNDATION	MD-216-49W1-EG-CV-DED-1025	DRAIN CANAL
MD-216-49W1-EG-CV-DED-1018	EQUIPMENT FOUNDATION PUMPS 2	MD-216-49W1-EG-CV-DED-1019	PIPERACK FOUNDATION 2
MD-216-49W1-EG-CV-GAD-1003	1-10/1A-E GENERAL ARRANGEMENT DRAWING	MD-216-49W1-EG-CV-DED-1017	EQUIPMENT FOUNDATION PUMPS 1
MD-216-49W1-EG-CV-GAD-1001	1-B/E-J GENERAL ARRANGEMENT DRAWING	MD-216-49W1-EG-CV-GAD-1002	7-12/D-J GENERAL ARRANGEMENT DRAWING

REV	DATE	REVISION DESCRIPTION	DRN	CHK	ENG	APP	EMP
D01	29.01.2024	AS-BUILT	JonRen	MauNot	NamWu	LuiPiz	
C01	01.03.2022	ISSUED FOR CONSTRUCTION	JonRen	MauNot	NamWu	LuiPiz	
A01	11.02.2022	ISSUED FOR APPROVAL	AbdDus	MauNot	NamWu	LuiPiz	

RESERVED FOR VENDOR LOGO AND DRAWING NUMBER

LARSEN & TOUBRO

This drawing is the property of LARSEN & TOUBRO and must not be passed on to any person or body not authorized by us to receive it or be copied or otherwise made use either in full or in part by such person or body without our prior permission in writing.

Outotec

The content of these documents are the sole property of Outotec Oyj. Any rights not expressly granted herein are reserved. Reproduction, transfer or distribution of part or all of the contents in any form without prior written permission of Outotec is prohibited.

MA'ADEN معادن
Saudi Arabian Mining Company شركة معادن العربية السعودية

This document and the information contained herein is Ma'aden proprietary know-how. This document or any part thereof should not be reproduced, stored in a retrieval system or transmitted by any means, electronic or otherwise, or divulged without prior written permission of Ma'aden.

L'ARSEN & TOUBRO DRAWING NUMBER	019045_080_C_D_24892_026		REVISION 2
OUTOTEC DRAWING NUMBER	900707_GAU01_AG11_CTB01_49026	DOCUMENT ID OU100741880	REVISION 2
DRAWN	AbdDus	09.02.2022	
CHECKED	MauNot	09.02.2022	
ENGINEER	NamWu	09.02.2022	
APPROVED	LuiPiz	09.02.2022	
EMPLOYER			
SCALE	1:75	A0	

MANSOURAH - MASSARAH GOLD PROJECT
49W1 RAW WATER TREATMENT PLANT
SLAB SECTOR GL G-J/10-12
DETAIL AND REINFORCEMENT DRAWING

DRAWING NUMBER: MD-216-49W1-EG-CV-DED-1026 | REV: D01

Track Changes