


DRAWING NUMBER: MD-216-3440-EG-CV-DED-1256 | REV: D01

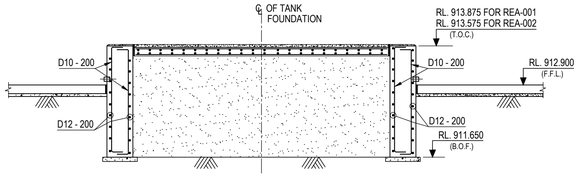


SECTION : A-A
SCALE 1:50

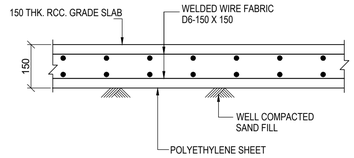

TYP. DET. OF 150 THK. GRADE SLAB
SCALE 1:10

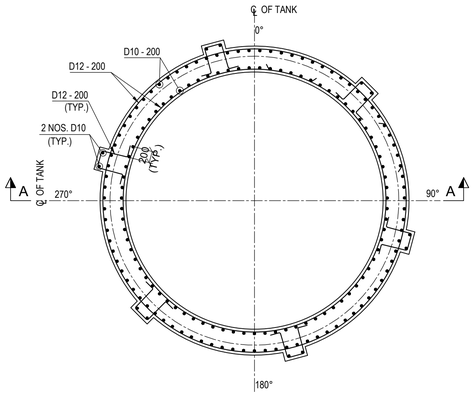

TYP. RCC DET. OF TANK FOUNDATION AT BOTTOM
(TANK MKD. 3440-REA-001 & 3440-REA-002)
SCALE 1:50

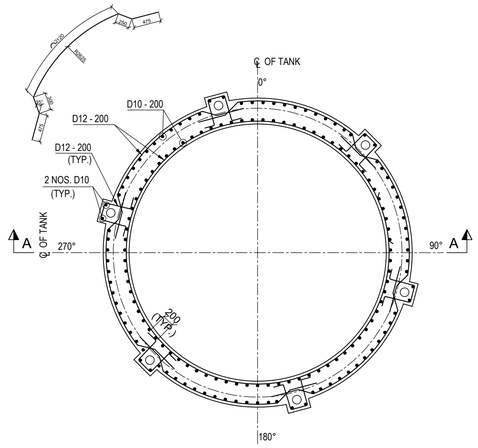

TYP. RCC DET. OF TANK FOUNDATION AT TOP
(TANK MKD. 3440-REA-001 & 3440-REA-002)
SCALE 1:50

LEGEND :-

R.L. - REDUCED LEVEL
℄ - CENTRE LINE
T.O.C. - TOP OF CONCRETE.
F.G.L. - FINISHED GROUND LEVEL.
B.O.F. - BOTTOM OF FOUNDATION
TYP. - TYPICAL.
P.C.D. - PITCH CIRCLE DIAMETER.
R.C.C - REINFORCED CEMENT CONCRETE
P.C.C - PLAIN CEMENT CONCRETE
MKD. - MARKED.
THK. - THICK

NOTES :-

1. ALL DIMENSIONS ARE IN MILLIMETRES AND LEVELS AND CO-ORDINATES ARE IN METRES. UNLESS OTHERWISE STATED.
2. GRADE OF CONCRETE SHALL BE C35 FOR FOUNDATION.
3. GRADE OF REINFORCEMENT SHALL BE DEFORMED BAR ASTM A615 - GRADE 60 (fy = 420 MPa).
4. NET SAFE BEARING CAPACITY OF SOIL AT BOTTOM OF FOUNDATION IS CONSIDERED AS 350KN/SQ. M.
5. CLEAR COVER TO REINFORCEMENT SHALL BE AS
   a) RING WALL = 50mm
6. MINIMUM LAP LENGTH OF REINFORCEMENT SHALL BE 40 x DIA. OF BAR AS PER DRAWING NO. MD-216-1000-EG-CV-DED-1001 (GENERAL NOTES FOR CIVIL WORKS)
7. THIS DRG. SHALL BE READ IN CONJUNCTION WITH DRG. NO. MD-216-3440-EG-CV-GAD-1255.

DOCUMENT NUMBER	REFERENCE DOCUMENTS	REV	DATE	REVISION DESCRIPTION	DRN	CHK	ENG	APP	EMP
MD-216-1000-EG-ST-CRT-1001	CIVIL, STRUCTURAL & ARCHITECTURAL - DESIGN CRITERIA								
MD-216-3440-EG-ME-PLN-1001	3440-REA-001, 002 HOT ACID CURE REACTOR								
MD-216-3440-EG-ME-GAD-1002	3440-REA-002 HOT ACID CURE REACTOR								
MD-216-3440-EG-ME-GAD-1001	3440-REA-001 HOT ACID CURE REACTOR	D01	15/03/2023	AS-BUILT	SYA	SJM	SOR	AG	
MD-216-3420-EG-ME-GAD-1013	PRESSURE OXIDATION - AUTOCLAVE	C01	19/05/2020	ISSUED FOR CONSTRUCTION	SYA	SJM	SOR	AG	
MD-216-3420-EG-CV-GAD-1001	PRESSURE OXIDATION - AUTOCLAVE F.V. & SCRUBBER	A01	18/04/2020	ISSUED FOR REFERENCE	SYA	SJM	SOR	AG	

RESERVED FOR VENDOR LOGO AND DRAWING NUMBER

LARSEN & TOUBRO

This drawing is the property of LARSEN & TOUBRO and must not be passed on to any person or body not authorized by us to receive it nor be copied or otherwise made use either in full or in part by such person or body without our prior permission in writing.

Outotec

The content of these documents are the sole property of Outotec Oyj. Any rights not expressly granted herein are reserved. Reproduction, transfer or distribution of part or all of the contents in any form without prior written permission of Outotec is prohibited.

MA'ADEN معادن
Saudi Arabian Mining Company شركة معادن العربية السعودية

This document and the information contained herein is Ma'aden proprietary know-how. This document or any part thereof should not be reproduced, stored in a retrieval system or transmitted by any means, electronic or otherwise, or divulged without prior written permission of Ma'aden.

LARSEN & TOUBRO DRAWING NUMBER: 019045_450_C_D_24111_001 | REVISION: 2
OUTOTEC DRAWING NUMBER: 900707__GAU01__RD51__CTB17__34401 | DOCUMENT ID: OU1006814432 | REVISION: 2

DRAWN	SYA	15/04/2020
CHECKED	SJM	17/04/2020
ENGINEER	SOR	15/04/2020
APPROVED	AG	18/04/2020
EMPLOYER		
SCALE	1:50, 1:10	A1

MANSOURAH - MASSARAH GOLD PROJECT
DETAIL DRAWING
HOT ACID CURE
RCC DETAIL OF TANK FOUNDATION

DRAWING NUMBER: MD-216-3440-EG-CV-DED-1256 | REV: D01