


DRAWING NUMBER: MD-216-3440-EG-CV-GAD-1255 | REV: D01

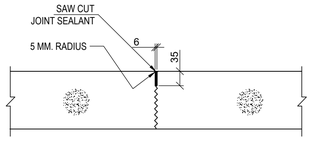


TYP. DETAIL OF CONSTRUCTION JOINT
SCALE 1:10

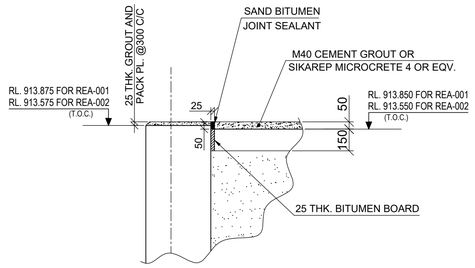


DETAIL - 'X'
SCALE 1:20

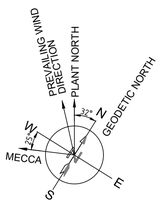


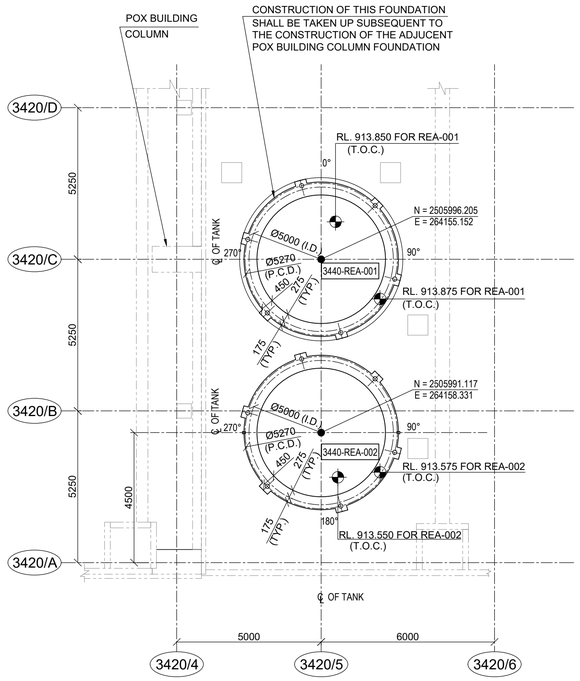


LAYOUT OF FOUNDATION FOR HOT ACID CURE TANK
(TANK MKD. 3440-REA-001 & 002)
SCALE 1:100

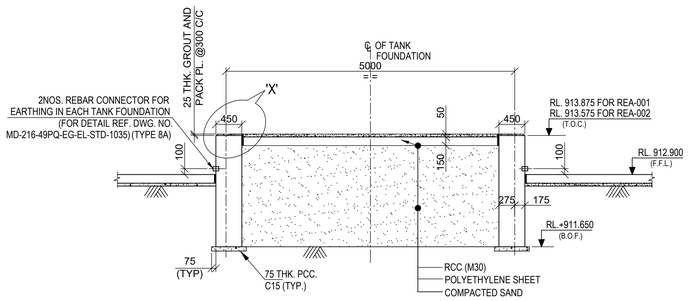


SECTION : A-A
SCALE 1:50

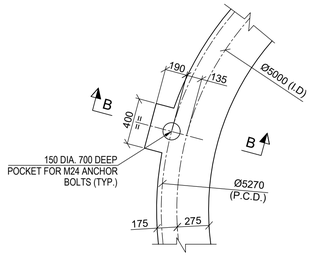


DETAIL : 'Y'
SCALE 1:25

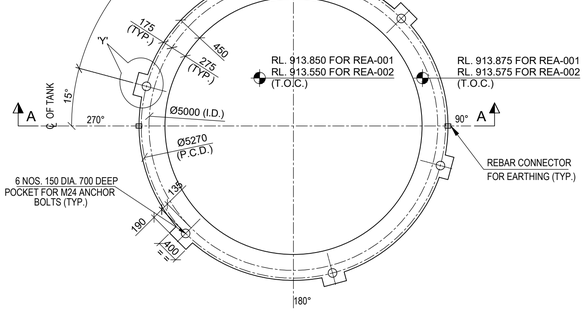

DETAIL OF TANK FOUNDATION MKD. 3440-REA-001 & 3440-REA-002
SCALE 1:50

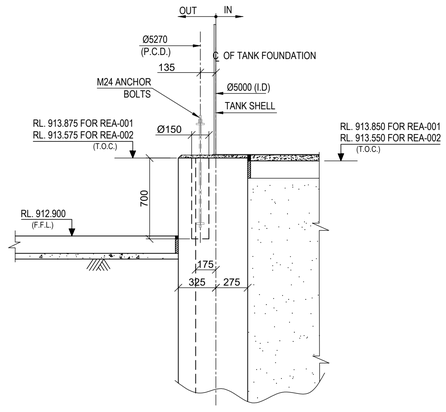

SECTION : B-B
SCALE 1:25

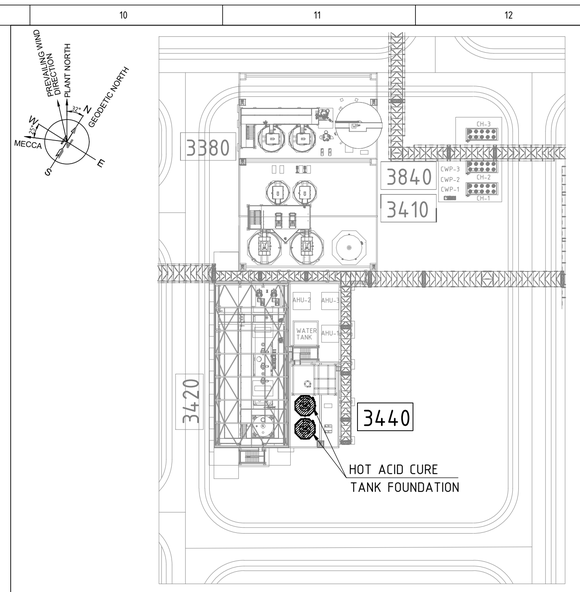

KEY PLAN
(SCALE- 1:750)

LEGEND :-

R.L. - REDUCED LEVEL
℄ - CENTRE LINE
T.O.C. - TOP OF CONCRETE
TYP. - TYPICAL
F.G.L. - FINISHED GROUND LEVEL
F.F.L. - FINISHED FLOOR LEVEL
B.O.F. - BOTTOM OF FOUNDATION
P.C.D. - PITCH CIRCLE DIAMETER
Ø - DIAMETER
I.D. - INTERNAL DIAMETER
P.C.C. - PLAIN CEMENT CONCRETE
MKD. - MARKED
THK. - THICK

NOTES :-

1. ALL DIMENSIONS ARE IN MILLIMETRES AND LEVELS AND CO-ORDINATES ARE IN METRES UNLESS OTHERWISE STATED.
2. GRADE OF CONCRETE SHALL BE C35 FOR FOUNDATION.
3. GRADE OF REINFORCEMENT SHALL BE DEFORMED BAR ASTM A615 - GRADE 60 (fy = 420 MPa).
4. NET SAFE BEARING CAPACITY OF SOIL AT BOTTOM OF FOUNDATION CONSIDERED 350KN/SQ. M.
5. IF ANY PART OF FOUNDATION COMES ON BACKFILL ZONE OF ADJACENT FOUNDATION OR ANY LOOSE SOIL ARE ENCOUNTERED BELOW FOUNDATION LEVEL THE SAME SHALL BE REMOVED AND FILLED WITH PCC.
6. THE CONTENT OF THIS DRAWING SHALL CONFORM TO THE PROVISIONS OF CIVIL, STRUCTURAL AND ARCHITECTURAL DESIGN CRITERIA DOC. NO. MD-216-1000-EG-ST-CRT-1001.
7. THIS DRG. SHALL BE READ IN CONJUNCTION WITH DRG. NO. MD-216-3440-EG-CV-DED-1256.

DOCUMENT NUMBER	REFERENCE DOCUMENTS	REV	DATE	REVISION DESCRIPTION	DRN	CHK	ENG	APP	EMP
MD-216-1000-EG-ST-CRT-1001	CIVIL, STRUCTURAL & ARCHITECTURAL - DESIGN CRITERIA								
MD-216-3440-EG-ME-PLN-1001	3440-REA-001, 002 HOT ACID CURE REACTOR								
MD-216-3440-EG-ME-GAD-1002	3440-REA-002 HOT ACID CURE REACTOR								
MD-216-3440-EG-ME-GAD-1001	3440-REA-001 HOT ACID CURE REACTOR	D01	15/03/2023	AS-BUILT	SYA	SYA	SOR	AG	
MD-216-3420-EG-ME-GAD-1013	PRESSURE OXIDATION - AUTOCLAVE	C01	19/05/2020	ISSUED FOR CONSTRUCTION & REVISED AS MARKED 1.01	SYA	SYA	SOR	AG	
MD-216-3420-EG-CV-GAD-1001	PRESSURE OXIDATION - AUTOCLAVE F.V. & SCRUBBER	A01	18/04/2020	ISSUED FOR REFERENCE	SYA	SJM	SOR	AG	

RESERVED FOR VENDOR LOGO AND DRAWING NUMBER

LARSEN & TOUBRO

This drawing is the property of LARSEN & TOUBRO and must not be passed on to any person or body not authorized by us to receive it nor be copied or otherwise made use either in full or in part by such person or body without our prior permission in writing.

Outotec

The content of these documents are the sole property of Outotec Oyj. Any rights not expressly granted herein are reserved. Reproduction, transfer or distribution of part or all of the contents in any form without prior written permission of Outotec is prohibited.

MA'ADEN معادن
Saudi Arabian Mining Company شركة التعدين العربية السعودية

This document and the information contained herein is Ma'aden proprietary know-how. This document or any part thereof should not be reproduced, stored in a retrieval system or transmitted by any means, electronic or otherwise, or divulged without prior written permission of Ma'aden.

LARSEN & TOUBRO DRAWING NUMBER: 019045_450_C_G_24110_001 | REVISION: 2
OUTOTEC DRAWING NUMBER: 900707__GAU01__RD51__MTL01__34406 | DOCUMENT ID: OU100681431 | REVISION: 2

DRAWN	SYA	15/04/2020
CHECKED	SJM	17/04/2020
ENGINEER	SOR	15/04/2020
APPROVED	AG	18/04/2020
EMPLOYER		
SCALE 1:50, 1:10	A1	

MANSOURAH - MASSARAH GOLD PROJECT
GENERAL ARRANGEMENT DRAWING
HOT ACID CURE
LAYOUT & DETAIL OF TANK FOUNDATION

DRAWING NUMBER: MD-216-3440-EG-CV-GAD-1255 | REV: D01