


DRAWING NUMBER: MD - 216 - 3440 - EG - CV - GAD - 1256 | REV: D01

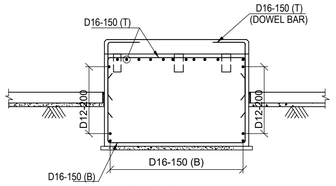


SECTION : J-J
SCALE 1:40

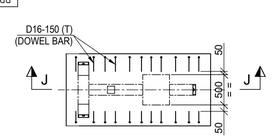


RC. DET. OF FDN. FOR PUMP MKD. 3420-PMP-001,002,003 & 004
(TOP VIEW OF SECOND STAGE CONCRETE)

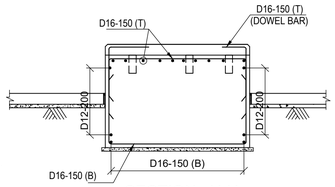


SECTION : H-H
SCALE 1:40

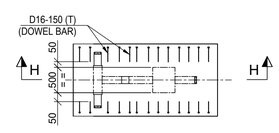


RC. DET. OF FDN. FOR PUMP MKD. 3420-PMP-005 & 006
(TOP VIEW OF SECOND STAGE CONCRETE)

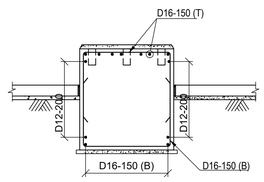


SECTION : K-K
SCALE 1:40

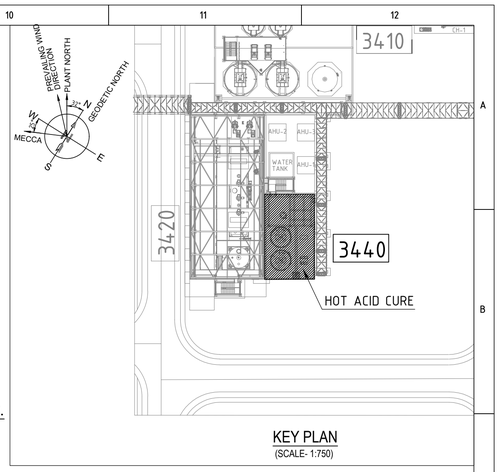


KEY PLAN
(SCALE- 1:750)

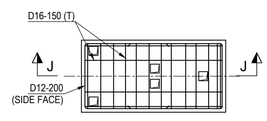


RC. DET. OF FDN. FOR PUMP MKD. 3420-PMP-001,002,003 & 004
(TOP VIEW OF FIRST STAGE CONCRETE)
SCALE 1:40

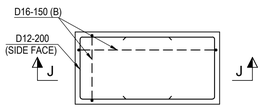


RC. DET. OF FDN. FOR PUMP MKD. 3420-PMP-001,002,003 & 004
(BOTTOM VIEW)
SCALE 1:40

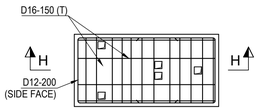


RC. DET. OF FDN. FOR PUMP MKD. 3420-PMP-005 & 006
(TOP VIEW OF FIRST STAGE CONCRETE)
SCALE 1:40

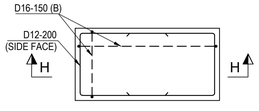


RC. DET. OF FDN. FOR PUMP MKD. 3420-PMP-005 & 006
(BOTTOM VIEW)
SCALE 1:40

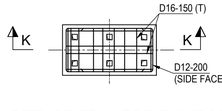



RC. DET. OF FDN. FOR PUMP MKD. 3440-PMP-001 & 002
(TOP VIEW)

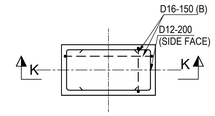


RC. DET. OF FDN. FOR PUMP MKD. 3440-PMP-001 & 002
(BOTTOM VIEW)
SCALE 1:40

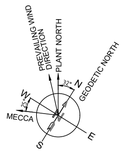

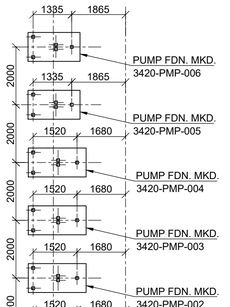


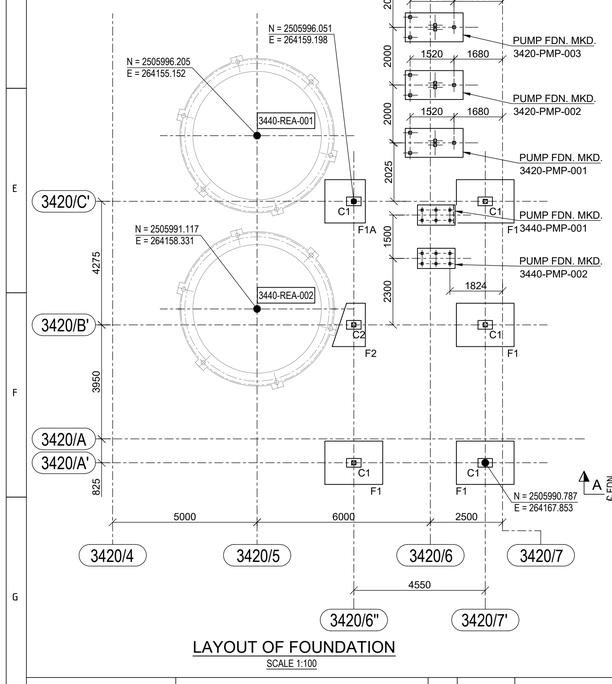


LAYOUT OF FOUNDATION
SCALE 1:100

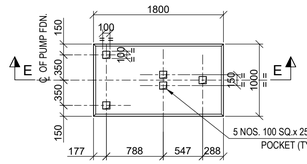


FDN. FOR PUMP MKD. 3420-PMP-005 & 006
SCALE 1:40

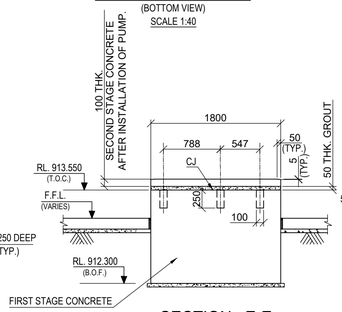


SECTION : E-E
SCALE 1:40

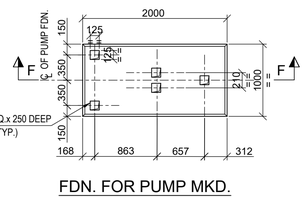


FDN. FOR PUMP MKD. 3420-PMP-001,002,003 & 004
SCALE 1:40

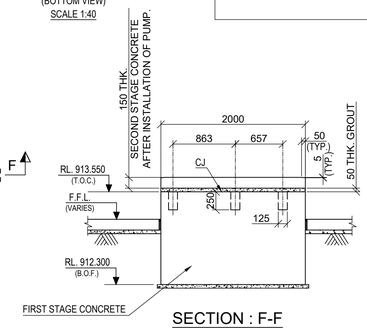


SECTION : F-F
SCALE 1:40

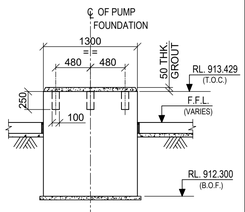


SECTION : G-G
SCALE 1:40

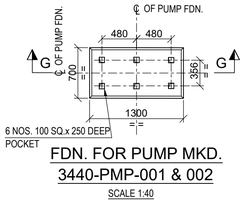


FDN. FOR PUMP MKD. 3440-PMP-001 & 002
SCALE 1:40

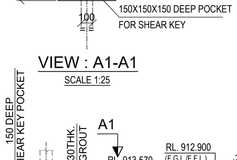

VIEW : A1-A1
SCALE 1:25

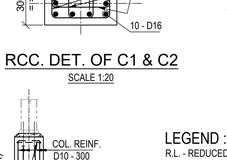


RCC. DET. OF C1 & C2
SCALE 1:20

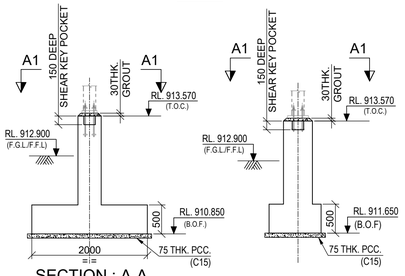


SECTION : A-A
SCALE 1:50


SECTION : B-B
SCALE 1:50

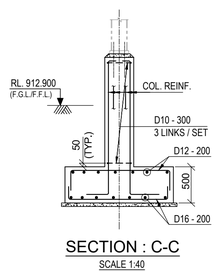


SECTION : C-C
SCALE 1:40

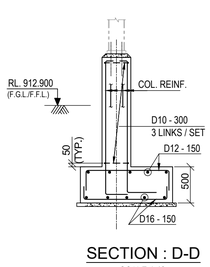


SECTION : D-D
SCALE 1:40

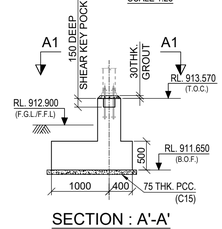


SECTION : A'-A'
SCALE 1:50

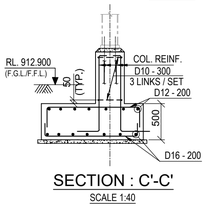


SECTION : C'-C'
SCALE 1:40

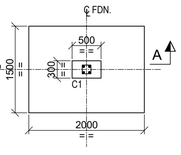


DETAIL OF FOUNDATION MKD. F1
SCALE 1:50

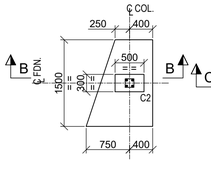


DETAIL OF FOUNDATION MKD. F2
SCALE 1:50

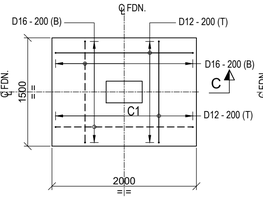


RCC. DETAIL OF FOUNDATION MKD. F1
SCALE 1:40

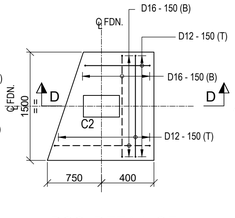

RCC. DETAIL OF FOUNDATION MKD. F2
SCALE 1:40

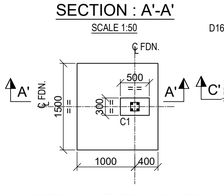

DETAIL OF FOUNDATION MKD. F1A
SCALE 1:50

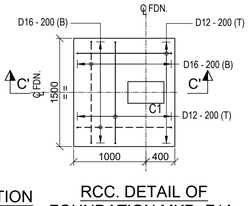

RCC. DETAIL OF FOUNDATION MKD. F1A
SCALE 1:40

LEGEND :-

R.L. - REDUCED LEVEL
℄ - CENTRE LINE
T.O.C. - TOP OF CONCRETE
F.G.L. - FINISHED GROUND LEVEL
F.F.L. - FINISHED FLOOR LEVEL
B.O.F. - BOTTOM OF FOUNDATION
MKD. - MARKED
GA - GENERAL ARRANGEMENT
COL. - COLUMN
REINF. - REINFORCEMENT
SQ. - SQUARE
R.C - REINFORCED CONCRETE
TYP. - TYPICAL
P.C.C - PLAIN CEMENT CONCRETE
THK. - THICK
T.O.G. - TOP OF GROUT
DET. - DETAIL
DRG. - DRAWING
FDN. - FOUNDATION
R.C.C - REINFORCED CEMENT CONCRETE
BOTTOM REINFORCEMENT (B) - – – –
TOP REINFORCEMENT (T) - ———
CJ - CONSTRUCTION JOINT

NOTES:-

1. ALL DIMENSIONS ARE IN MILLIMETRES AND LEVELS AND CO-ORDINATES ARE IN METRES UNLESS OTHERWISE STATED.
2. NET SAFE BEARING CAPACITY OF SOIL AT BOTTOM OF FOUNDATION IS CONSIDERED AS 350KN/ SQ. M.
3. GRADE OF CONCRETE SHALL BE C35 (35Mpa) FOR FOUNDATION, C30 (30Mpa) FOR GRADE SLAB & C15 (15Mpa) FOR BLINDING CONCRETE.
4. GRADE OF REINFORCEMENT SHALL BE DEFORMED BAR 420 MPa (GRADE 60) - ASTM A615/A615M.
5. CLEAR COVER TO REINFORCEMENT SHALL BE AS FOLLOWS
   a) FOUNDATION = 50 mm
   b) COLUMN = 50mm
6. IF ANY PART OF FOUNDATION COMES ON BACKFILL ZONE OF ADJACENT FOUNDATION OR ANY LOOSE SOIL ARE ENCOUNTERED BELOW FOUNDATION LEVEL THE SAME SHALL BE REMOVED AND FILLED WITH PCC.
7. FOR STANDARD REINFORCEMENT DETAIL & GENERAL NOTES FOR CIVIL WORKS REFER DRAWING NO. MD-216-1000-EG-CV-DED-1005 & 1001.

DOCUMENT NUMBER	REFERENCE DOCUMENTS			REVISION DESCRIPTION	DRN	CHK	ENG	APP	EMP
		D01	15/03/2023	AS-BUILT	SYA	SJM	SOR	AG	
		C03	04/01/2021	ISSUED FOR CONSTRUCTION AND REVISED AS MKD. C03	SYA	SJM	SOR	AG	
		C02	19/12/2020	ISSUED FOR CONSTRUCTION AND REVISED AS MKD. C02	SYA	SJM	SOR	AG	
MD-216-3420-EG-ME-GAD-1013	PRESSURE OXIDATION-AUTOCLAVE PLAN AT EL.+912.900	C01	30/11/2020	ISSUED FOR CONSTRUCTION AND REVISED AS MKD. C01	SYA	SJM	SOR	AG	
MD-216-3440-EG-ST-GAD-2243	HOT ACID CURE - PLAN, ELEVATIONS & DETAILS	A01	20/10/2020	ISSUED FOR REFERENCE	SYA	SJM	SOR	AG	

RESERVED FOR VENDOR LOGO AND DRAWING NUMBER

LARSEN & TOUBRO

This drawing is the property of LARSEN & TOUBRO and must not be passed on to any person or body not authorized by us to receive it nor be copied or otherwise made use either in full or in part by such person or body without our prior permission in writing.

Outotec

The content of these documents are the sole property of Outotec Oyj. Any rights not expressly granted herein are reserved. Reproduction, transfer or distribution of part or all of the contents in any form without prior written permission of Outotec is prohibited.

MA'ADEN معادن
Saudi Arabian Mining Company شركة معادن العربية السعودية

This document and the information contained herein is Ma'aden proprietary know-how. This document or any part thereof should not be reproduced, stored in a retrieval system or transmitted by any means, electronic or otherwise, or divulged without prior written permission of Ma'aden.

LARSEN & TOUBRO DRAWING NUMBER: 019045_450_C_G_24565_001 | REVISION: 4
OUTOTEC DRAWING NUMBER: 900707 _GAU01 _RD51 _MTL01 _34409 | DOCUMENT ID: 0U100704167 | REVISION: 4

DRAWN	SYA	15/10/2020
CHECKED	SJM	19/10/2020
ENGINEER	SOR	15/10/2020
APPROVED	AG	20/10/2020
EMPLOYER		

SCALE: 1:75, 1:50, 1:25, 1:10 | A1

MANSOURAH - MASSARAH GOLD PROJECT
GENERAL ARRANGEMENT DRAWING
HOT ACID CURE
GA & DETAILS OF FOUNDATION

DRAWING NUMBER: MD - 216 - 3440 - EG - CV - GAD - 1256 | REV: D01