


DRAWING NUMBER: MD-216-3440-EG-CV-GAD-1257 REV D01

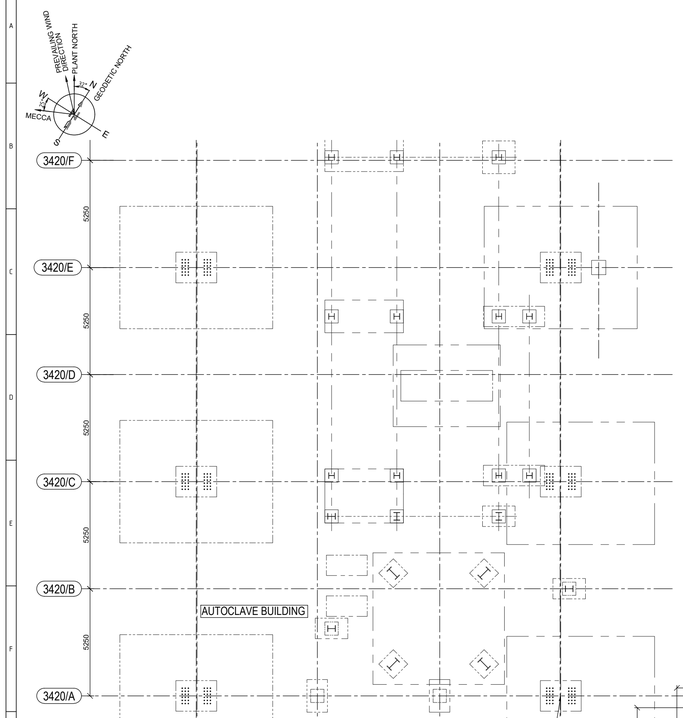

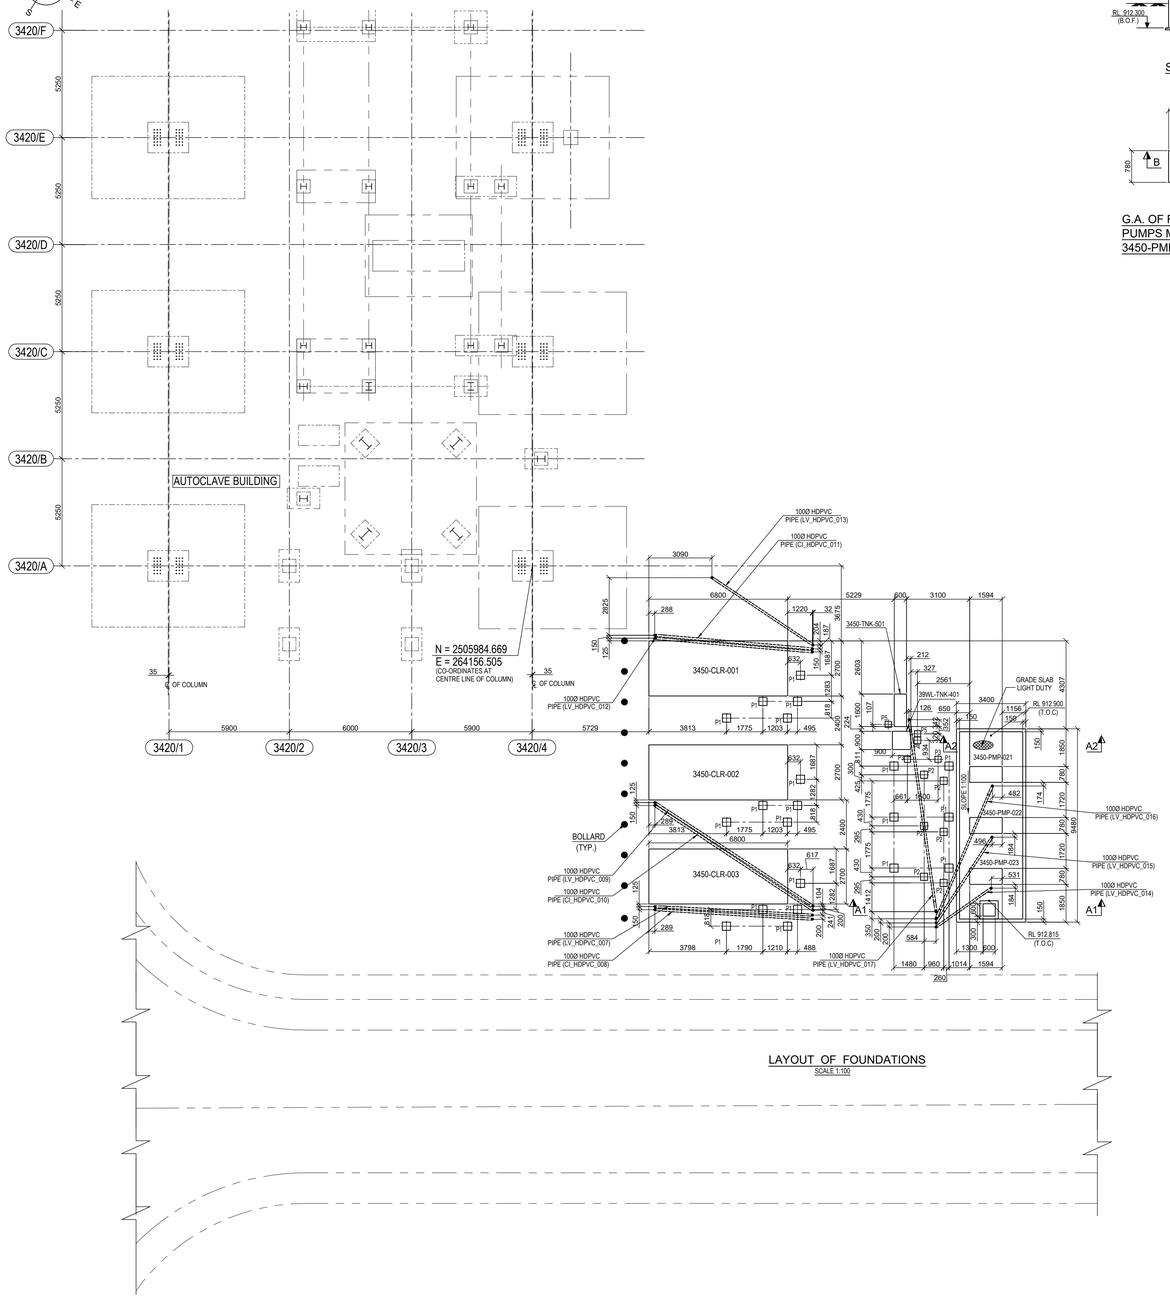

LAYOUT OF FOUNDATIONS
SCALE 1:100

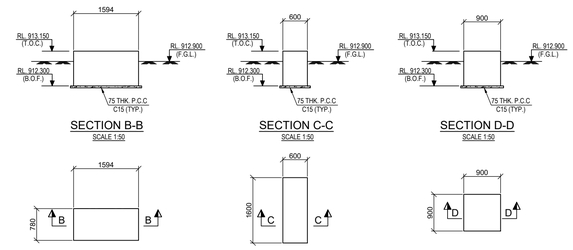

SECTION B-B — SCALE 1:50
SECTION C-C — SCALE 1:50
SECTION D-D — SCALE 1:50
SECTION F-F — SCALE 1:50
SECTION G-G — SCALE 1:50
SECTION H-H — SCALE 1:50

G.A. OF FOUNDATION FOR PUMPS MKD 3450-PMP-021 , 3450-PMP-022 & 3450-PMP-023 — SCALE 1:50


G.A. OF FOUNDATION FOR EQUIP. MKD 3450-TNK-501.

G.A. OF FOUNDATION FOR EQUIP. MKD 39WL-TNK-401.


R.C. DET. OF FDN. FOR PUMPS MKD 3450-PMP-021 , 3450-PMP-022 & 3450-PMP-023 — SCALE 1:50

R.C. DET. OF FDN. FOR EQUIP. MKD 3450-TNK-501. — SCALE 1:50


R.C. DET. OF FDN. FOR EQUIP. MKD 39WL-TNK-401. — SCALE 1:50

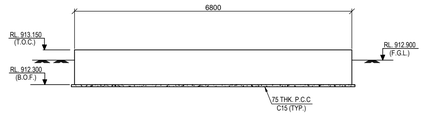


SECTION A-A — SCALE 1:50

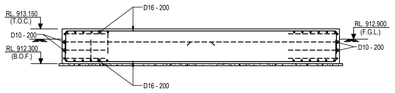


SECTION E-E — SCALE 1:50

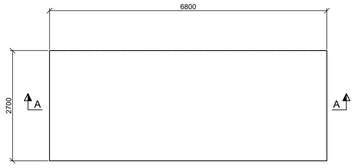

G.A. OF FOUNDATION FOR CHILLER MKD 3450-CLR-001 , 3450-CLR-002 & 3450-CLR-003 — SCALE 1:50

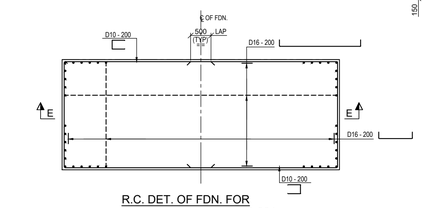


R.C. DET. OF FDN. FOR CHILLER MKD 3450-CLR-001 , 3450-CLR-002 & 3450-CLR-003 — SCALE 1:50

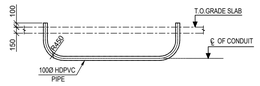


TYPICAL DETAIL OF CONDUIT — SCALE 1:50

SCHEDULE OF CONDUIT :-

CONDUIT MKD.	ELEVATION AT ℄ OF CONDUIT
LV_HDPVC_007	RL 911.900
CI_HDPVC_008	RL 911.900
LV_HDPVC_009	RL 911.900
CI_HDPVC_010	RL 911.900
CI_HDPVC_011	RL 911.900
LV_HDPVC_012	RL 911.900
LV_HDPVC_013	RL 911.900
LV_HDPVC_014	RL 911.900
LV_HDPVC_015	RL 911.900
LV_HDPVC_016	RL 911.900
LV_HDPVC_017	RL 911.900

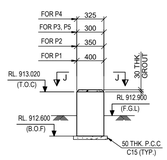


DETAIL OF P1,P2,P3,P4,P5 — SCALE 1:30

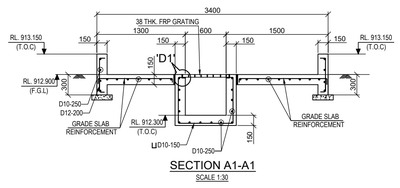


SECTION A1-A1 — SCALE 1:30




R.C. DET. OF P1, P2, P3, P4, P5 — SCALE 1:30

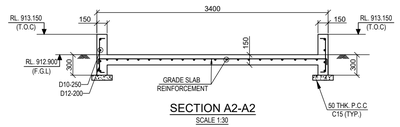

SECTION A2-A2 — SCALE 1:30

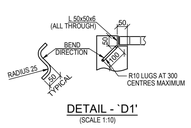

DETAIL - 'D1' — (SCALE 1:10)

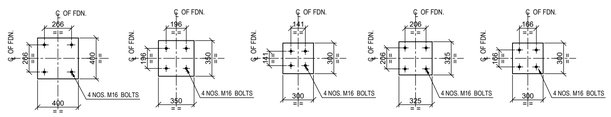

VIEW : J-J (FOR P1) — SCALE 1:20
VIEW : J-J (FOR P2) — SCALE 1:20
VIEW : J-J (FOR P3) — SCALE 1:20
VIEW : J-J (FOR P4) — SCALE 1:20
VIEW : J-J (FOR P5) — SCALE 1:20

LEGEND :-

R.L. - REDUCED LEVEL
T.O.C. - TOP OF CONCRETE.
F.G.L. - FINISHED GROUND LEVEL.
G.A. - GENERALARRANGEMENT.
TYP. - TYPICAL.
P.C.C. - PLAIN CEMENT CONCRETE
R.C. - REINFORCED CONCRETE
℄ - CENTRE LINE
MKD. - MARKED
B.O.F. - BOTTOM OF FOUNDATION
THK. - THICK
FDN. - FOUNDATION
DIA - DIAMETER
DET. - DETAILS
EQUIP. - EQUIPMENT
T.O.PAVING - TOP OF PAVING
Ø - DIAMETER
R - RADIUS

NOTES :-

1. ALL DIMENSIONS ARE IN MILLIMETRES AND LEVELS AND CO-ORDINATES ARE IN METRES. UNLESS OTHERWISE STATED.
2. GRADE OF CONCRETE SHALL BE C35 (35MPa) FOR FOUNDATION & COLUMN.
3. GRADE OF REINFORCEMENT SHALL BE DEFORMED BAR ASTM A615 - GRADE 60 (fy = 420 MPa)
4. CLEAR COVER TO REINFORCEMENT SHALL BE AS
   a) FOUNDATION = 50mm (BOTTOM & SIDE), 50 mm (TOP)
5. IF ANY PART OF FOUNDATION COMES ON BACKFILL ZONE OF ADJACENT FOUNDATION OR ANY LOOSE SOIL ARE ENCOUNTERED BELOW FOUNDATION LEVEL THE SAME SHALL BE REMOVED AND FILLED WITH PCC.
6. FOR STANDARD REINFORCEMENT DETAIL & GENERAL NOTES FOR CIVIL WORKS REFER DRAWING NO. MD-216-1000-EG-CV-DED-1005 &1001.
7. FOR DETAILS OF GRADE SLAB REFER DRAWING NO. MD-216-1000-EG-CV-DED-1002.

DOCUMENT NUMBER	REFERENCE DOCUMENTS	REV	DATE	REVISION DESCRIPTION	DRN	CHK	ENG	APP	EMP
		D01	15/03/2023	AS-BUILT	PML	SJM	SOR	AG	
		C05	25/05/2021	ISSUED FOR CONSTRUCTION AND REVISED AS MARKED	PML	SJM	SOR	AG	
		C04	04/05/2021	ISSUED FOR CONSTRUCTION AND REVISED AS MARKED	PML	SJM	SOR	AG	
MD-216-3400-EG-EL-LAD-1006	PRESSURE OXIDATION	C03	15/03/2021	ISSUED FOR CONSTRUCTION AND REVISED AS MARKED	PML	SJM	SOR	AG	
	CABLE ROUTE LAYOUT	C02	03/03/2021	ISSUED FOR CONSTRUCTION AND REVISED AS MARKED	PML	SJM	SOR	AG	
MD-216-3900-EG-HV-LAD-V567-1001	SERVICES/ UTILITIES	C01	15/01/2021	ISSUED FOR CONSTRUCTION	SYA	SJM	SOR	AG	
	HVAC SYSTEM FOR AUTOCLAVE BUILDING	A01	19/12/2020	ISSUED FOR REVIEW	SYA	SJM	SOR	AG	

RESERVED FOR VENDOR LOGO AND DRAWING NUMBER

LARSEN & TOUBRO

This drawing is the property of LARSEN & TOUBRO and must not be passed on to any person or body not authorized by us to receive it nor be copied or otherwise made use either in full or in part by such person or body without our prior permission in writing.

Outotec

The content of these documents are the sole property of Outotec Oyj. Any rights not expressly granted herein are reserved. Reproduction, transfer or distribution of part or all of the contents in any form without prior written permission of Outotec is prohibited.

MA'ADEN — Saudi Arabian Mining Company

This document and the information contained herein is Ma'aden proprietary know-how. This document or any part thereof should not be reproduced, stored in a retrieval system or transmitted by any means, electronic or otherwise, or divulged without prior written permission of Ma'aden.

LARSEN & TOUBRO DRAWING NUMBER	019045_450_C_G_24565_002		REVISION 6
OUTOTEC DRAWING NUMBER	900707__GAU01__RD51__MTL01__34410	DOCUMENT ID OU100704168	REVISION 6
DRAWN	SYA	14/12/2020	MANSOURAH - MASSARAH GOLD PROJECT
CHECKED	SJM	17/12/2020	GENERAL ARRANGEMENT DRAWING
ENGINEER	SOR	14/12/2020	HOT ACID CURE
APPROVED	AG	19/12/2020	GA & DETAILS OF FOUNDATION
EMPLOYER			
SCALE 1:100, 1:50, 1:25	A0		DRAWING NUMBER MD-216-3440-EG-CV-GAD-1257 REV D01