


DRAWING NUMBER: MD-216-3450-EG-CV-DED-1265 | REV: D01

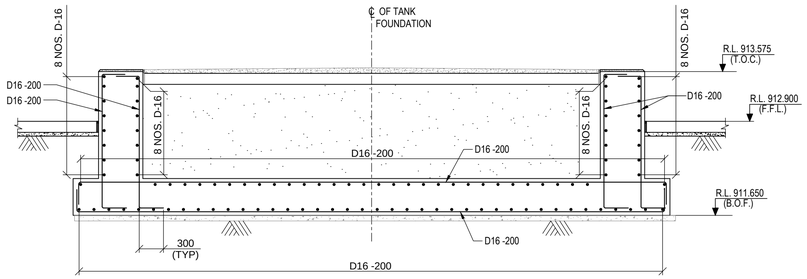


SECTION A-A
(SCALE - 1:40)

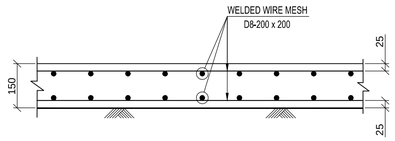


DETAIL OF GRADE SLAB
(SCALE 1:10)

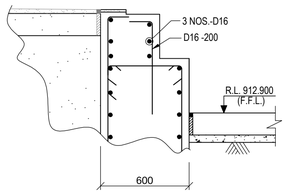

SECTION B-B
(SCALE 1:20)

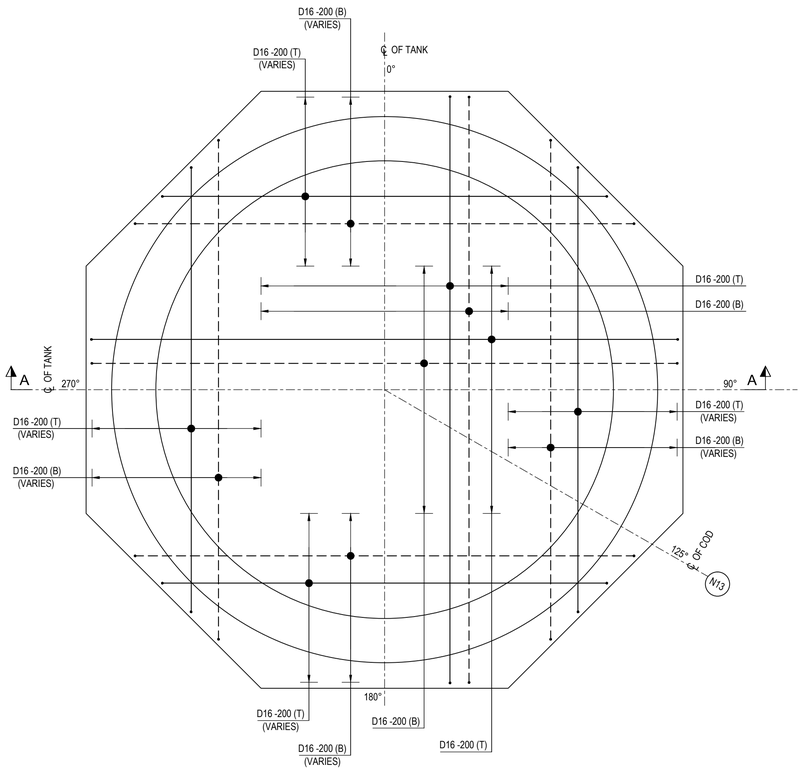

RCC. DETAIL OF TANK FOUNDATION MKD F1
(FOR 3450-TNK-001)
(SCALE - 1:40)

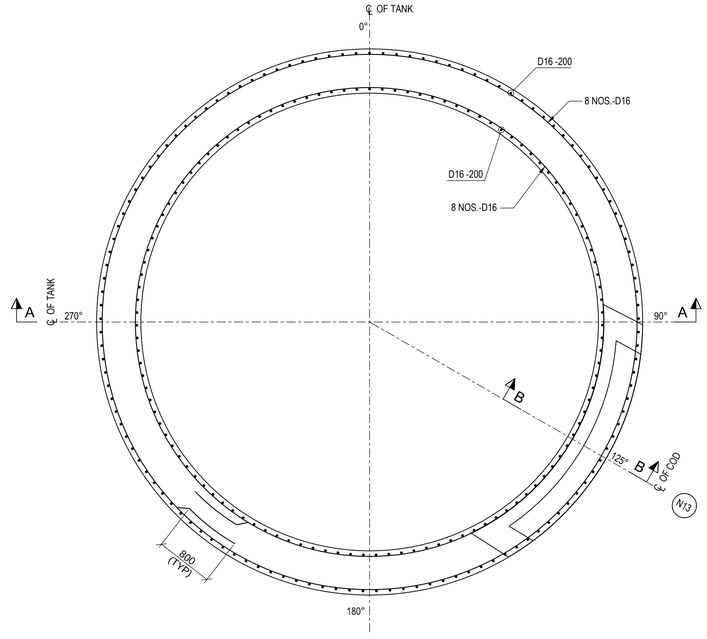

RCC. DETAIL OF WALL
(FOR 3450-TNK-001)
(SCALE - 1:40)

LEGEND :-

R.L. - REDUCED LEVEL
℄ - CENTRE LINE
MM - MILLIMETRE
T.O.C. - TOP OF CONCRETE
TYP. - TYPICAL
R - RADIUS
R.C.C - REINFORCED CEMENT CONCRETE
F.G.L. - FINISHED GROUND LEVEL
F.F.L. - FINISHED FLOOR LEVEL
B.O.F. - BOTTOM OF FOUNDATION
P.C.D. - PITCH CIRCLE DIAMETER
Ø - DIAMETER
I.D. - INTERNAL DIAMETER
P.C.C - PLAIN CEMENT CONCRETE
MKD. - MARKED
THK. - THICK
COD - CLEAN OUT DOOR
FDN. - FOUNDATION
T.O.G. - TOP OF GROUT
BOTTOM REINFORCEMENT (B) - – – – – –
TOP REINFORCEMENT (T) - ————
EQV. - EQUIVALENT

NOTES:-

1. ALL DIMENSIONS ARE IN MILLIMETRES AND LEVELS AND CO-ORDINATES ARE IN METRES UNLESS OTHERWISE STATED.
2. GRADE OF CONCRETE SHALL BE 35 MPa FOR FOUNDATION, 30 MPa FOR GRADE SLAB & 15 MPa FOR BLINDING CONCRETE.
3. GRADE OF REINFORCEMENT SHALL BE DEFORMED BAR 420 MPa (GRADE 60) - ASTM A615/A615M.
4. NET SAFE BEARING CAPACITY OF SOIL AT BOTTOM OF FOUNDATION IS CONSIDERED 300KN/ SQ. M
5. GRADE OF WELDED WIRE FABRIC ASTM A185 (PLAIN)/A497 (DEFORMED)
6. CLEAR COVER TO MAIN REINFORCEMENT SHALL BE AS FOLLOWS:
   a) FOUNDATION : 50 mm. b) RING WALL : 50 mm. c) GRADE SLAB : 20 mm.
7. IF ANY PART OF FOUNDATION COMES ON BACKFILL ZONE OF ADJACENT FOUNDATION OR ANY LOOSE SOIL ARE ENCOUNTERED BELOW FOUNDATION LEVEL THE SAME SHALL BE REMOVED AND FILLED WITH PCC.
8. FOR DETAIL OF ANCHOR BOLTS, REFER DRAWING NO. MD-216-1000-EG-CV-DED-1003.
9. THIS DRAWING SHALL BE READ IN CONJUNCTION WITH GENERAL NOTES DRAWING NO. MD-216-1000-EG-CV-DED-1001.
10. THIS DRAWING SHALL BE READ IN CONJUNCTION WITH STANDARD REINFORCEMENT DETAILS DRAWING NO. MD-216-1000-EG-CV-DED-1005.

MD-216-3450-EG-CV-GAD-1258	CCD & POX PROCESS WATER STORAGE								
	LAYOUT & DETAILS OF TANK FDN. 3450-TNK-001								
MD-216-3410-EG-CV-GAD-1001	PRESSURE OXIDATION - AUTOCLAVE FEED STORAGE								
	PLAN AT EL. +912.900 - GRID A-I/1-5								
MD-216-3450-EG-ST-GAD-2245	PRESSURE OXIDATION-SERVICES	D01	16/03/2023	AS-BUILT	AUD	SJM	SOR	AG	
	PLAN, ELVN, DETAIL OF TANK 3450-TNK-001	C02	09/10/2020	ISSUED FOR CONSTRUCTION & REVISED AS MARKED C02	AUD	SJM	SOR	AG	
MD-216-3450-EG-ME-GAD-1001	PRESSURE OXIDATION-SERVICES	C01	15/07/2020	ISSUED FOR CONSTRUCTION & REVISED AS PER EMPLOYER	SYA	SJM	SOR	AG	
	POX DEMIN WATER TANK 3450-TNK-001			COMMENTS ON 10/07/2020					
DOCUMENT NUMBER	REFERENCE DOCUMENTS	A01	16/06/2020	ISSUED FOR REFERENCE	PML	SJM	SOR	AG	
DOCUMENT NUMBER	REFERENCE DOCUMENTS	REV	DATE	REVISION DESCRIPTION	DRN	CHK	ENG	APP	EMP

RESERVED FOR VENDOR LOGO AND DRAWING NUMBER

LARSEN & TOUBRO

This drawing is the property of LARSEN & TOUBRO and must not be passed on to any person or body not authorized by us to receive it nor be copied or otherwise made use either in full or in part by such person or body without our prior permission in writing.

Outotec

The content of these documents are the sole property of Outotec Oyj. Any rights not expressly granted herein are reserved. Reproduction, transfer or distribution of part or all of the contents in any form without prior written permission of Outotec is prohibited.

MA'ADEN معادن Saudi Arabian Mining Company شركة المعادن العربية السعودية

This document and the information contained herein is Ma'aden proprietary know-how. This document or any part thereof should not be reproduced, stored in a retrieval system or transmitted by any means, electronic or otherwise, or divulged without prior written permission of Ma'aden.

LARSEN & TOUBRO DRAWING NUMBER: 019045_450_C_D_24114_002 | REVISION: 3

OUTOTEC DRAWING NUMBER: 900707__GAU01__HH12__CTB17__34518 | DOCUMENT ID: OU100688493 | REVISION: 3

DRAWN	PML	12/06/2020
CHECKED	SJM	15/06/2020
ENGINEER	SOR	12/06/2020
APPROVED	AG	16/06/2020
EMPLOYER		
SCALE	1:100, 1:50,1:20	A1

MANSOURAH - MASSARAH GOLD PROJECT
DETAIL DRAWING
CCD & POX WATER STORAGE
RCC DETAILS OF TANK FOUNDATION 3450-TNK-001

DRAWING NUMBER: MD - 216 - 3450 - EG - CV - DED - 1265 | REV: D01