




DRAWING NUMBER: MD - 216 - 3450 - EG - CV - GAD - 1266 | REV: D01

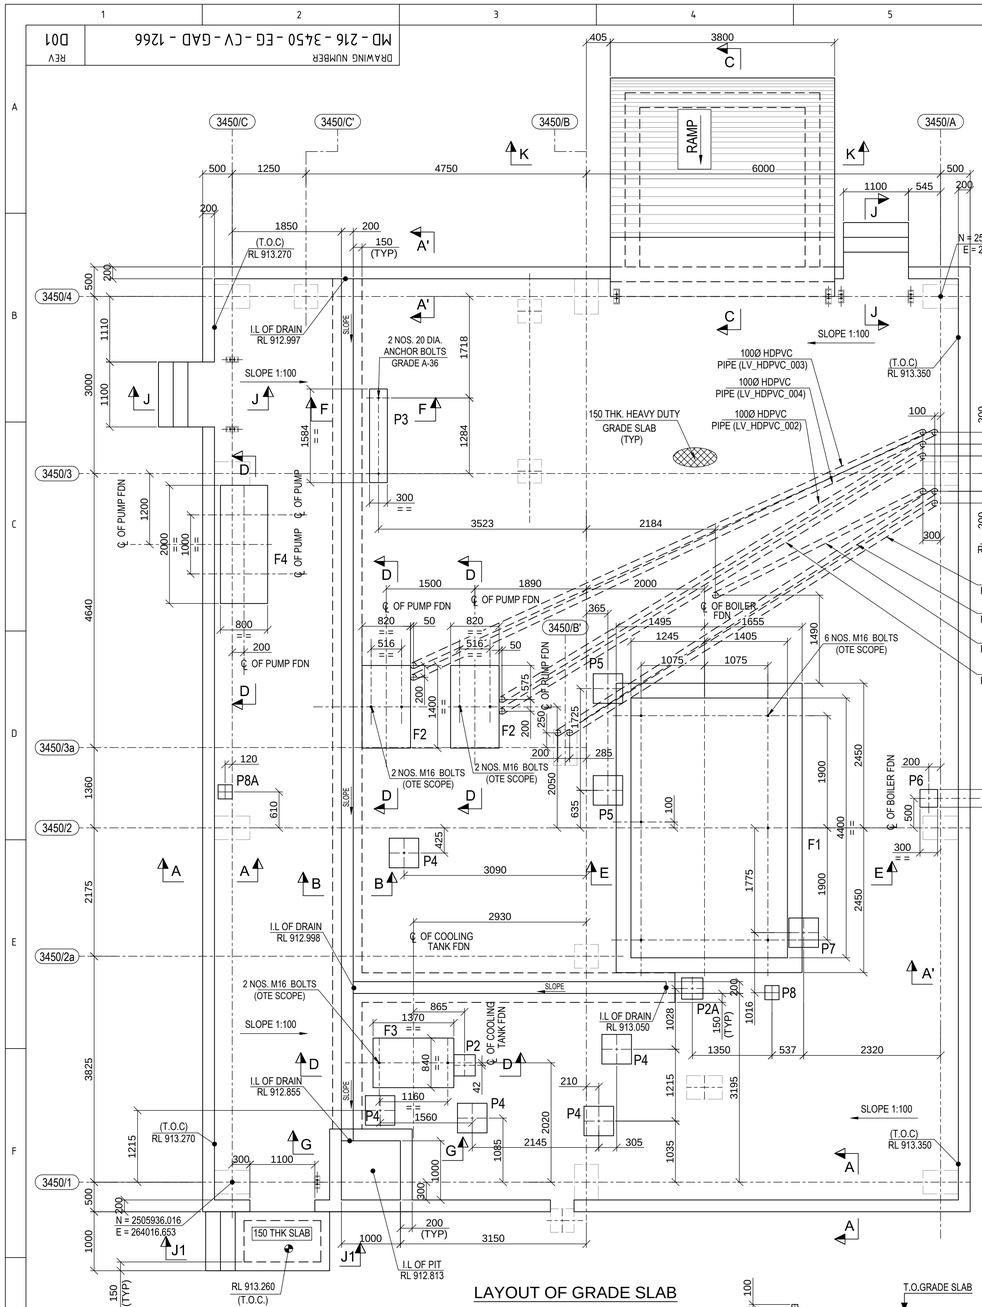


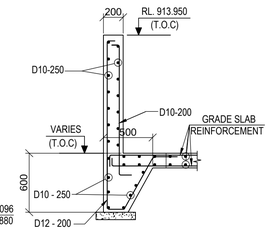


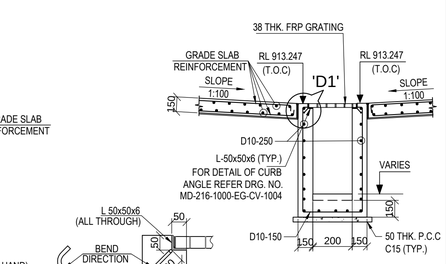


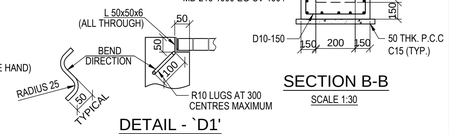


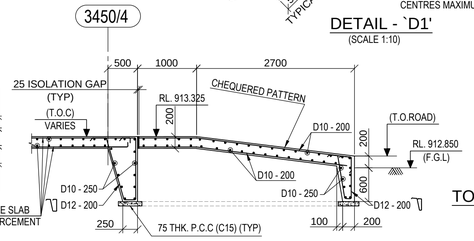


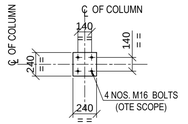


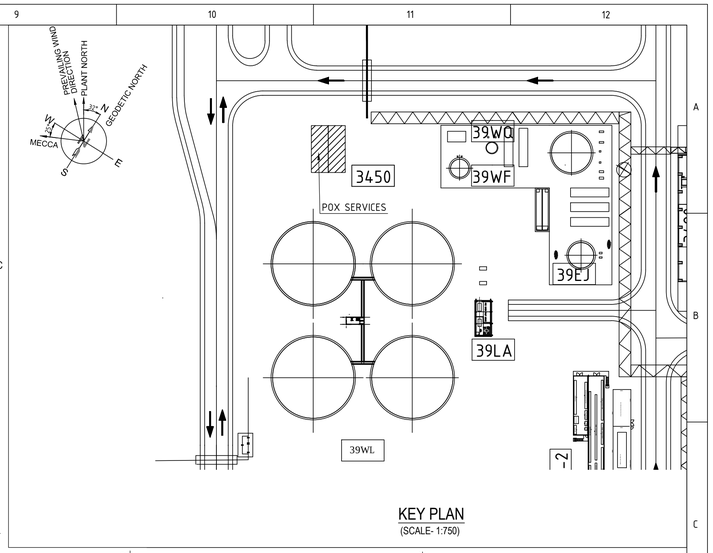


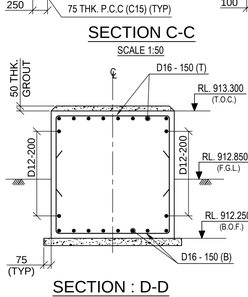


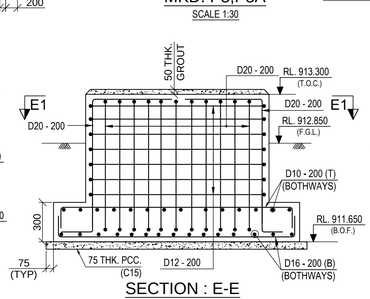


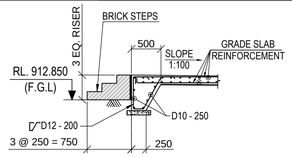


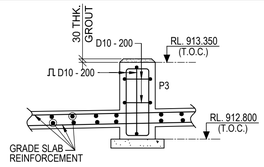


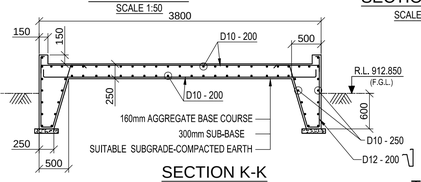


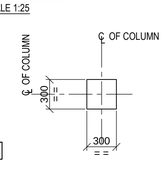


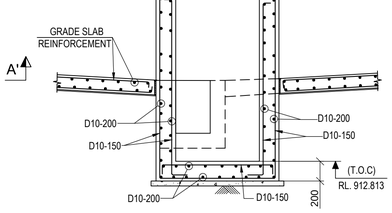


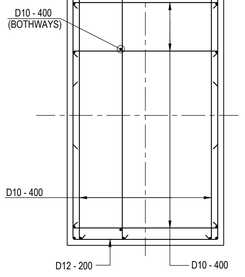


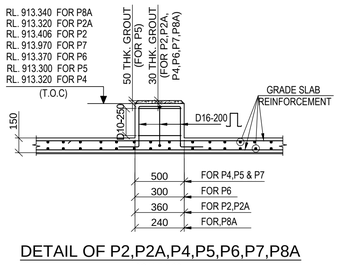


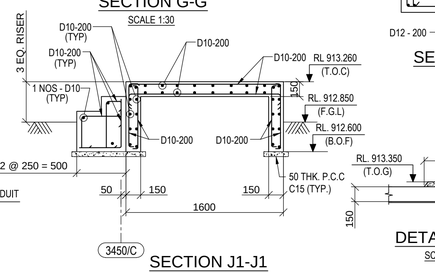

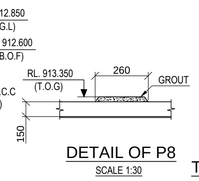

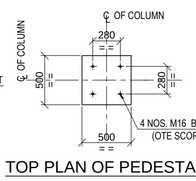

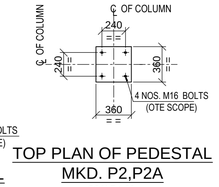

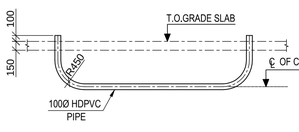

LEGEND :-

R.L - REDUCED LEVEL
I.L - INVERT LEVEL
THK. - THICK
TYP. - TYPICAL
T.O.C - TOP OF CONCRETE
℄ - CENTRE LINE
P.C.C - PLAIN CEMENT CONCRETE
DIA - DIAMETER
B.O.F. - BOTTOM OF FOUNDATION
MKD. - MARKED
FDN. - FOUNDATION
RCC - REINFORCED CEMENT CONCRETE
FGL - FINISHED GROUND LEVEL
T.O.G - TOP OF GROUT
T.O.ROAD - TOP OF ROAD
Ø - DIAMETER
R - RADIUS

SCHEDULE OF CONDUIT :-

CONDUIT MKD.	ELEVATION AT ℄ OF CONDUIT
LV_HDPVC_001	RL 912.575
LV_HDPVC_002	RL 912.575
LV_HDPVC_003	RL 912.575
LV_HDPVC_004	RL 912.575
LV_HDPVC_005	RL 912.575
LV_HDPVC_006	RL 912.380
LV_HDPVC_007	RL 912.225

NOTES:-

1. ALL DIMENSIONS ARE IN MILLIMETRES AND LEVELS AND CO-ORDINATES ARE IN METRES UNLESS OTHERWISE STATED.
2. NET SAFE BEARING CAPACITY OF SOIL AT BOTTOM OF FOUNDATION IS CONSIDERED AS 350KN/ SQ. M.
3. GRADE OF CONCRETE SHALL BE C35 (35Mpa) FOR FOUNDATION, C30 (30Mpa) FOR GRADE SLAB & C15 (15Mpa) FOR BLINDING CONCRETE.
4. GRADE OF REINFORCEMENT SHALL BE DEFORMED BAR 420 MPa (GRADE 60) - ASTM A615/A615M.
5. CLEAR COVER TO REINFORCEMENT SHALL BE AS FOLLOWS
   a) FOUNDATION = 50 mm
   b) COLUMN = 50mm
6. IF ANY PART OF FOUNDATION COMES ON BACKFILL ZONE OF ADJACENT FOUNDATION OR ANY LOOSE SOIL ARE ENCOUNTERED BELOW FOUNDATION LEVEL THE SAME SHALL BE REMOVED AND FILLED WITH PCC.
7. FOR STANDARD REINFORCEMENT DETAIL & GENERAL NOTES FOR CIVIL WORKS REFER DRAWING NO. MD-216-1000-EG-CV-DED-1005 & 1001.
8. FOR DETAILS OF GRADE SLAB REFER DRAWING NO. MD-216-1000-EG-CV-DED-1002.

DOCUMENT NUMBER	REFERENCE DOCUMENTS	REV	DATE	REVISION DESCRIPTION	DRN	CHK	ENG	APP	EMP
		D01	16/03/2023	AS-BUILT	PML	SJM	SOR	AG	
MD-216-3450-EG-EL-LAD-1006	PRESSURE OXIDATION- SERVICES	C03	18/03/2021	ISSUED FOR CONSTRUCTION AND REVISED AS MARKED △C03	PML	SJM	SOR	AG	
	CABLE ROUTE LAYOUT - BOILER ROOM	C02	16/02/2021	ISSUED FOR CONSTRUCTION AND REVISED AS MARKED △C02	PML	SJM	SOR	AG	
MD-216-3450-EG-ST-GAD-2255	POX SERVICE- PLAN, ELEVATIONS & DETAILS	C01	16/01/2021	ISSUED FOR CONSTRUCTION AND REVISED AS MARKED △C01	PML	SJM	SOR	AG	
MD-216-3450-EG-ST-GAD-2254	POX SERVICE- PLAN, ELEVATIONS & DETAILS	A01	12/12/2020	ISSUED FOR REVIEW	PML	SJM	SOR	AG	

RESERVED FOR VENDOR LOGO AND DRAWING NUMBER

LARSEN & TOUBRO
This drawing is the property of LARSEN & TOUBRO and must not be passed on to any person or body not authorized by us to receive it nor be copied or otherwise made use either in full or in part by such person or body without our prior permission in writing.

Outotec
The content of these documents are the sole property of Outotec Oy. Any rights not expressly granted herein are reserved. Reproduction, transfer or distribution of part or all of the contents in any form without prior written permission of Outotec is prohibited.

MA'ADEN معادن
Saudi Arabian Mining Company شركة التعدين العربية السعودية
This document and the information contained herein is Ma'aden proprietary know-how. This document or any part thereof should not be reproduced, stored in a retrieval system or transmitted by any means, electronic or otherwise, or divulged without prior written permission of Ma'aden.

LARSEN & TOUBRO DRAWING NUMBER	019045_450_C_G_24540_001	REVISION 4
OUTOTEC DRAWING NUMBER	900707__GAU01__HH12__MTL01__34538	DOCUMENT ID 0U100708463 / REVISION 4

DRAWN	PML	06/12/2020
CHECKED	SJM	08/12/2020
ENGINEER	SOR	10/12/2020
APPROVED	AG	12/12/2020
EMPLOYER		
SCALE	1:100, 1:50	A1

MANSOURAH - MASSARAH GOLD PROJECT
GENERAL ARRANGEMENT DRAWING
PRESSURE OXIDATION SERVICES
GA & DETAILS OF GRADE SLAB

DRAWING NUMBER: MD - 216 - 3450 - EG - CV - GAD - 1266 | REV: D01