

DRAWING NUMBER: MD-216-3450-EG-CV-DED-1270 | REV: D01

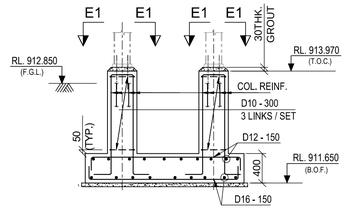


SECTION : E-E

SCALE 1:40

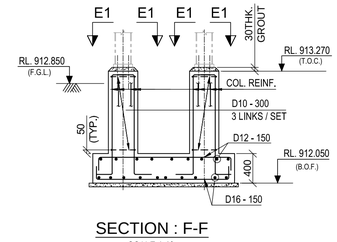


SECTION : F-F

SCALE 1:40

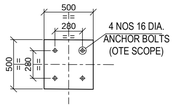


VIEW : E1-E1

SCALE 1:30

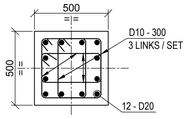


RCC. DET. OF C2

SCALE 1:20

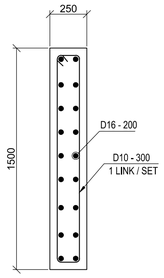


SECTION : D-D

SCALE 1:20

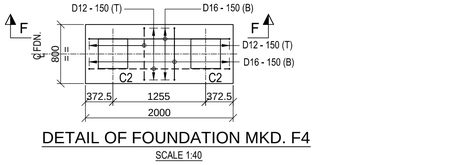


DETAIL OF FOUNDATION MKD. F4

SCALE 1:40

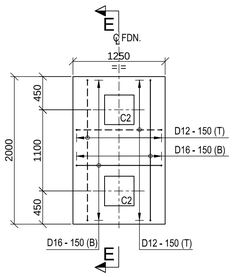

DETAIL OF FOUNDATION MKD. F3


SCALE 1:40

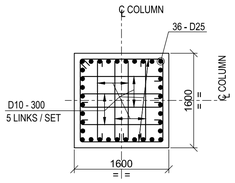

SECTION : 1A-1A


(RCC. DET. OF C1)

SCALE 1:50

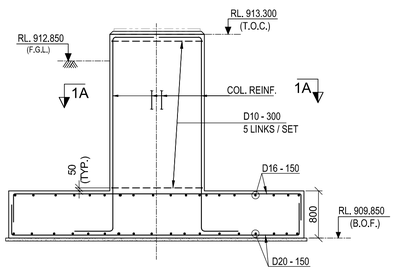


SECTION : 1-1

SCALE 1:50

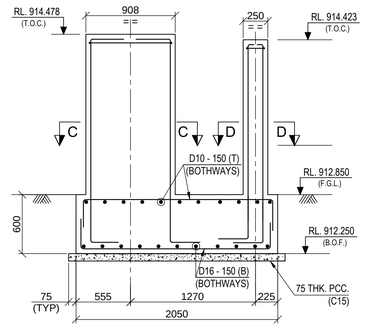


SECTION : B-B

SCALE 1:30

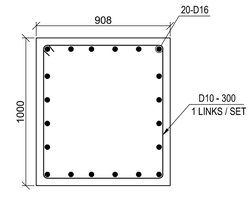


SECTION : C-C

SCALE 1:20

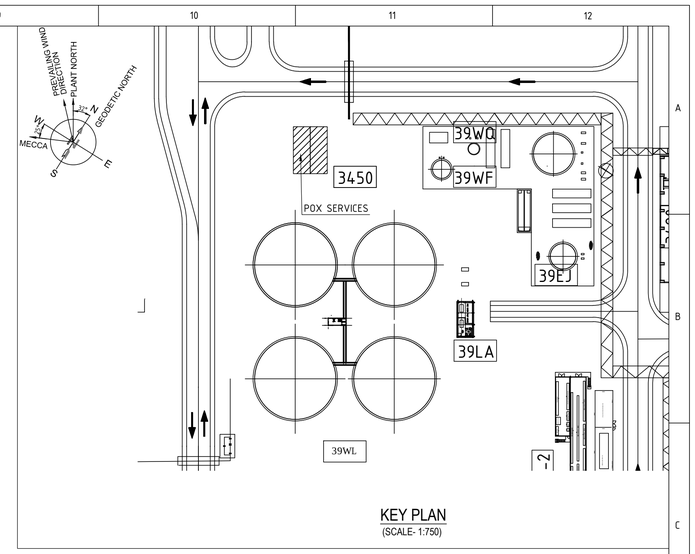

KEY PLAN

(SCALE- 1:750)

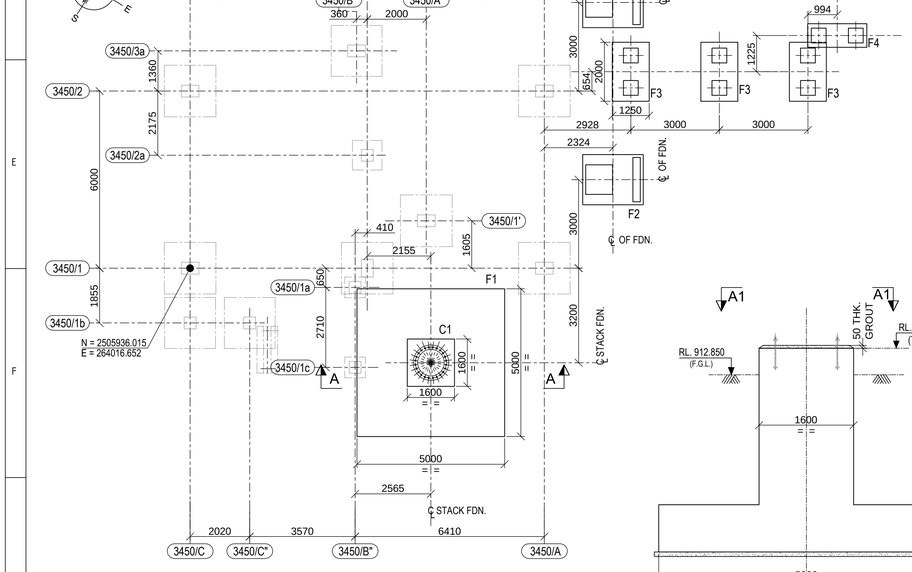


LAYOUT OF STACK FOUNDATION

SCALE 1:100


SECTION : A-A

SCALE 1:50

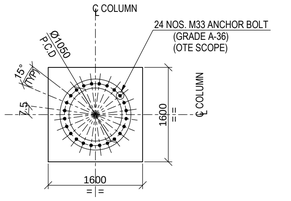

VIEW : A1-A1


SCALE 1:50

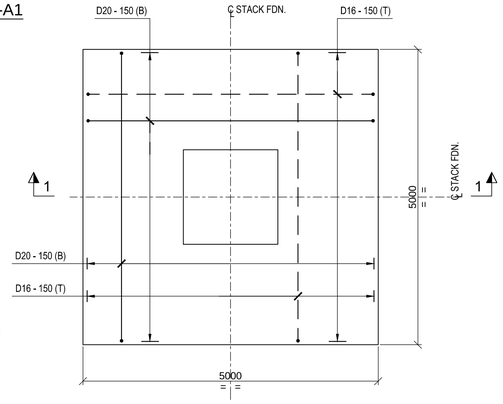

RCC DETAIL OF FDN. MKD. F1

(1 NO. REQD.)

SCALE 1:50

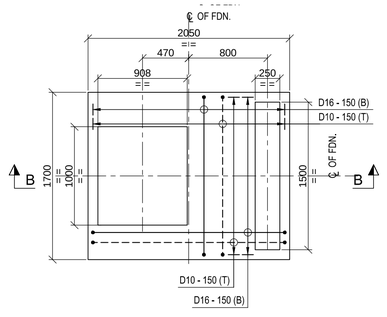

DETAIL OF FOUNDATION MKD. F2

SCALE 1:30

LEGEND :-

R.L. - REDUCED LEVEL
℄ - CENTRE LINE
T.O.C. - TOP OF CONCRETE
F.G.L. - FINISHED GROUND LEVEL
B.O.F. - BOTTOM OF FOUNDATION
MKD. - MARKED
COL. - COLUMN
REINF. - REINFORCEMENT
SQ. - SQUARE
TYP. - TYPICAL
P.C.C - PLAIN CEMENT CONCRETE
THK. - THICK
T.O.G. - TOP OF GROUT
DET. - DETAIL
DRG. - DRAWING
FDN. - FOUNDATION
R.C.C - REINFORCED CEMENT CONCRETE
BOTTOM REINFORCEMENT (B) - ———
TOP REINFORCEMENT (T) - – – –
PCD - PITCH CIRCLE DIAMETER
Ø - DIAMETER

NOTES:-

1. ALL DIMENSIONS ARE IN MILLIMETRES AND LEVELS AND CO-ORDINATES ARE IN METRES UNLESS OTHERWISE STATED.
2. NET SAFE BEARING CAPACITY OF SOIL AT BOTTOM OF FOUNDATION IS CONSIDERED AS 325KN/ SQ. M.
3. GRADE OF CONCRETE SHALL BE C35 (35Mpa) FOR FOUNDATION, C30 (30Mpa) FOR GRADE SLAB & C15 (15Mpa) FOR BLINDING CONCRETE.
4. GRADE OF REINFORCEMENT SHALL BE DEFORMED BAR 420 MPa (GRADE 60) - ASTM A615/A615M.
5. CLEAR COVER TO REINFORCEMENT SHALL BE AS FOLLOWS
   a) FOUNDATION = 50 mm
   b) COLUMN = 50mm
6. IF ANY PART OF FOUNDATION COMES ON BACKFILL ZONE OF ADJACENT FOUNDATION OR ANY LOOSE SOIL ARE ENCOUNTERED BELOW FOUNDATION LEVEL THE SAME SHALL BE REMOVED AND FILLED WITH PCC.
7. FOR STANDARD REINFORCEMENT DETAIL & GENERAL NOTES FOR CIVIL WORKS REFER DRAWING NO. MD-216-1000-EG-CV-DED-1005 & 1001.
8. THIS DRAWING SHALL BE READ IN CONJUNCTION WITH DRAWING NO. MD-216-3450-EG-CV-GAD-1265.

DOCUMENT NUMBER	REFERENCE DOCUMENTS	REV	DATE	REVISION DESCRIPTION	DRN	CHK	ENG	APP	EMP
MD-216-3450-EG-ME-GAD-1014	LOAD PLAN PRESSURE OXIDATION - SERVICES								
	FOUNDATION DETAILS	D01	16/03/2023	AS-BUILT	SYA	SJM	SOR	AG	
MD-216-3450-EG-ME-GAD-1006	LOAD PLAN PRESSURE OXIDATION-SERVICES	C01	05/02/2021	ISSUED FOR CONSTRUCTION & REVISED AS MARKED C01	SYA	SJM	SOR	AG	
	STEAM GEN. BOILER HOUSE +913.350	A01	29/12/2020	ISSUED FOR REVIEW	AMJ	SJM	SOR	AG	

RESERVED FOR VENDOR LOGO AND DRAWING NUMBER

LARSEN & TOUBRO DRAWING NUMBER: O19045_450_C_D_24527_001 — REVISION: 2

OUTOTEC DRAWING NUMBER: 900707 _GAU01 _HH12 _CTB17 _34521 — DOCUMENT ID: OU100704680 — REVISION: 2

LARSEN & TOUBRO

This drawing is the property of LARSEN & TOUBRO and must not be passed on to any person or body not authorized by us to receive it nor be copied or otherwise made use either in full or in part by such person or body without our prior permission in writing.

Outotec

The content of these documents are the sole property of Outotec Oy). Any rights not expressly granted herein are reserved. Reproduction, transfer or distribution of part or all of the contents in any form without prior written permission of Outotec is prohibited.

MA'ADEN معادن Saudi Arabian Mining Company شركة المعادن العربية السعودية

This document and the information contained herein is Ma'aden proprietary know-how. This document or any part thereof should not be reproduced, stored in a retrieval system or transmitted by any means, electronic or otherwise, or divulged without prior written permission of Ma'aden.

DRAWN	AMJ	28/12/2020
CHECKED	SJM	29/12/2020
ENGINEER	SOR	28/12/2020
APPROVED	AG	29/12/2020
EMPLOYER		
SCALE 1:100, 1:50		A1

MANSOURAH - MASSARAH GOLD PROJECT
DETAIL DRAWING
PRESSURE OXIDATION SERVICES
RCC DETAILS OF FOUNDATION

DRAWING NUMBER: MD - 216 - 3450 - EG - CV - DED - 1270 — REV: D01