

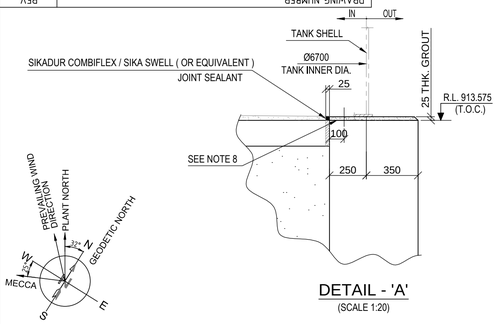



DETAIL - 'A'
(SCALE 1:20)

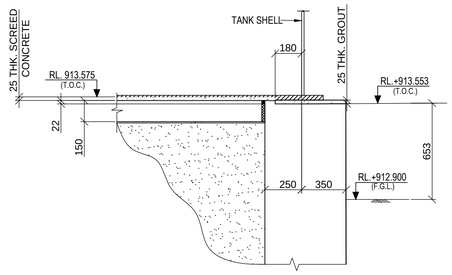


SECTION B1-B1
(SCALE 1:20)

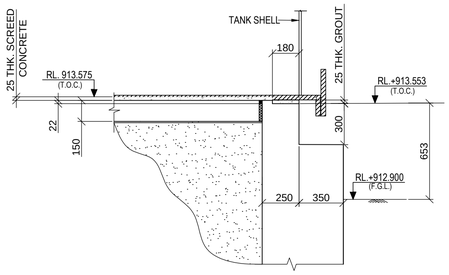


SECTION B-B
(SCALE 1:20)

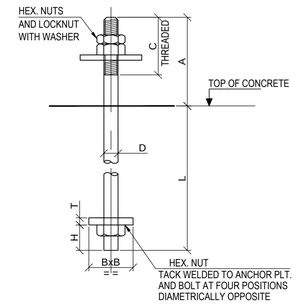


TYPICAL DETAIL OF BOLT
(SCALE - 1:50)

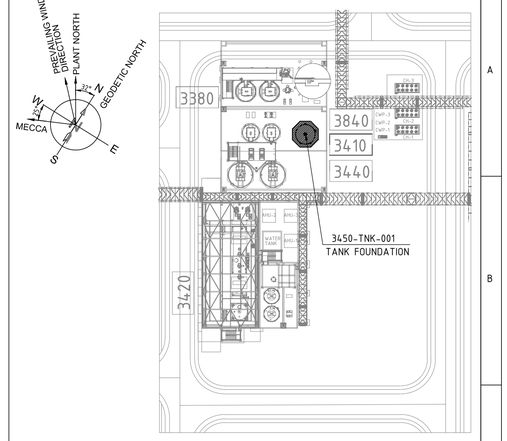


KEY PLAN
(S0CALE 1:1000)

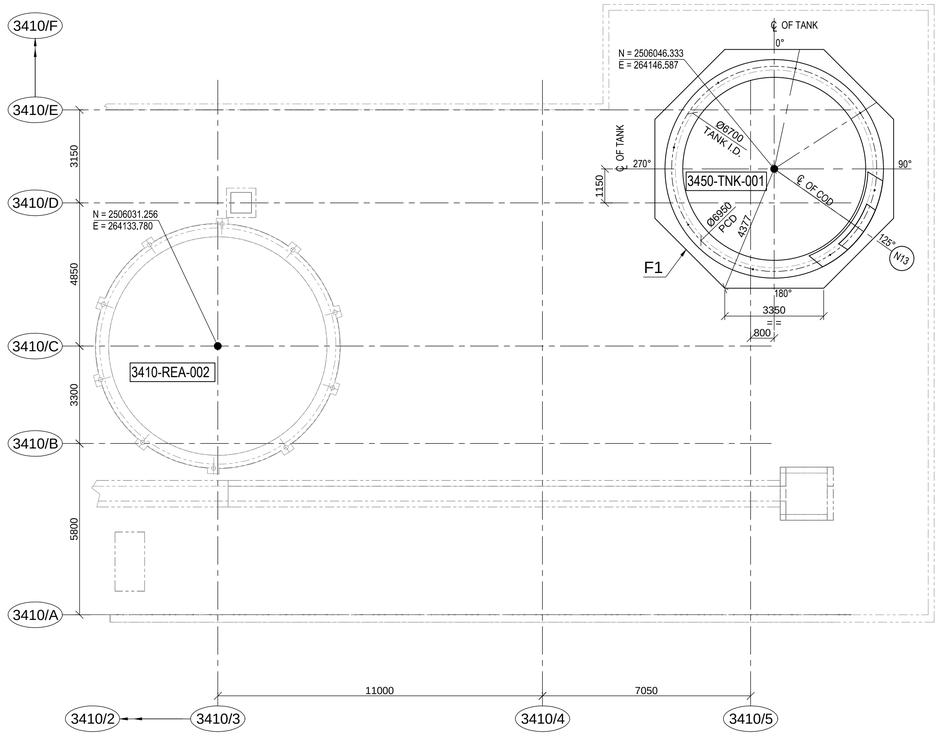


LAYOUT OF FOUNDATION
(TANK MKD. 3450-TNK-001)
(SCALE - 1:100)

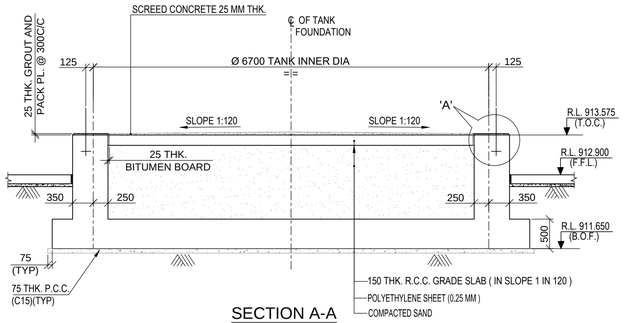

SECTION A-A
(SCALE - 1:50)

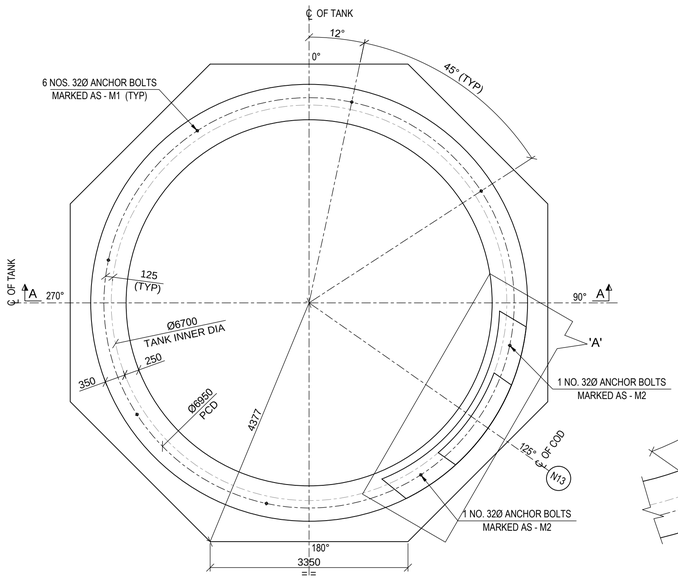

DETAIL OF TANK FOUNDATION MKD F1
(TANK MKD. 3450-TNK-001)
(SCALE - 1:50)

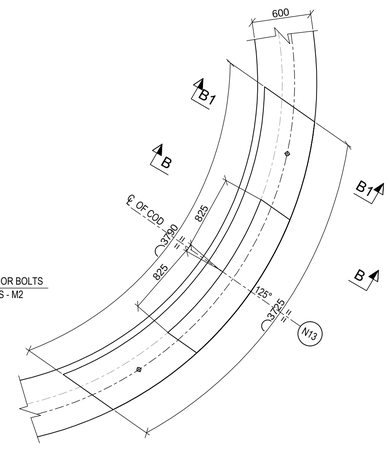

DETAIL - 'A'
(SCALE 1:30)

SCHEDULE OF BOLTS

BOLT MARK	LEVEL (T.O.C)	D BOLT DIA., MM	NO. OF BOLTS	BxB BOTTOM PLATE (SQUARE) SQ MM	DIMENSIONS (MM)				
					L	A	C	T	H
M1	R.L. 913.575	32	6	100x100	800	605	180	16	35
M2	R.L. 913.553	32	2	100x100	800	627	180	16	35

LEGEND :-

R.L. - REDUCED LEVEL
℄ - CENTRE LINE
MM - MILLIMETRE
T.O.C. - TOP OF CONCRETE
TYP. - TYPICAL
R - RADIUS
R.C.C - REINFORCED CEMENT CONCRETE
F.G.L. - FINISHED GROUND LEVEL
F.F.L. - FINISHED FLOOR LEVEL
B.O.F. - BOTTOM OF FOUNDATION
P.C.D. - PITCH CIRCLE DIAMETER
Ø - DIAMETER
I.D. - INTERNAL DIAMETER
P.C.C - PLAIN CEMENT CONCRETE
MKD. - MARKED
THK. - THICK
COD - CLEAN OUT DOOR
FDN. - FOUNDATION
DIA. - DIAMETER
C/C - CENTRE TO CENTRE
EQV. - EQUIVALENT
PLT. - PLATE

NOTES:-

1. ALL DIMENSIONS ARE IN MILLIMETRES AND LEVELS AND CO-ORDINATES ARE IN METRES UNLESS OTHERWISE STATED.
2. GRADE OF CONCRETE SHALL BE 35 MPa FOR FOUNDATION, 30 MPa FOR GRADE SLAB & 15 MPa FOR BLINDING CONCRETE.
3. NET SAFE BEARING CAPACITY OF SOIL AT BOTTOM OF FOUNDATION IS CONSIDERED 300KN/ SQ. M
4. IF ANY PART OF FOUNDATION COMES ON BACKFILL ZONE OF ADJACENT FOUNDATION OR ANY LOOSE SOIL ARE ENCOUNTERED BELOW FOUNDATION LEVEL THE SAME SHALL BE REMOVED AND FILLED WITH PCC.
5. FOR DETAIL OF ANCHOR BOLTS, REFER DRAWING NO. MD-216-1000-EG-CV-DED-1003.
6. THIS DRAWING SHALL BE READ IN CONJUNCTION WITH GENERAL NOTES DRAWING NO. MD-216-1000-EG-CV-DED-1001.
7. TANK CO-ORDINATES MENTIONED IN THIS DRAWING ARE BASED ON E3D LAYOUT AS ON DATE. HOWEVER, BEFORE CONSTRUCTION FINAL CO-ORDINATES SHOULD BE VERIFIED.
8. 100 MM GROUT TO BE PLACED FOR PLACEMENT OF SEALANT.

DOCUMENT NUMBER	REFERENCE DOCUMENTS	REV	DATE	REVISION DESCRIPTION	DRN	CHK	ENG	APP	EMP
MD-216-3420-EG-ME-GAD-2001	PRESSURE OXIDATION-SERVICES PLAN, ELVN, DETAIL OF 3450-TNK-001								
MD-216-3450-EG-CV-DED-1265	CCD & POX WATER STORAGE								
	RCC DETAILS OF TANK FOUNDATION 3450-TNK-001								
MD-216-3410-EG-CV-GAD-1001	PRESSURE OXIDATION - AUTOCLAVE FEED STORAGE								
	PLAN AT EL. +912.900 - GRID A-I/1-5	D01	16/03/2023	AS-BUILT	AUD	SJM	SOR	AG	
MD-216-3420-EG-ME-GAD-1011	PRESSURE OXIDATION-FEED STORAGE	C03	14/12/2020	ISSUED FOR CONSTRUCTION & REVISED AS MARKED C03	AUD	SJM	SOR	AG	
	PLAN AT EL. +912.900	C02	09/10/2020	ISSUED FOR CONSTRUCTION & REVISED AS MARKED C02	AUD	SJM	SOR	AG	
MD-216-3450-EG-ME-GAD-1001	PRESSURE OXIDATION-SERVICES	C01	15/07/2020	ISSUED FOR CONSTRUCTION & REVISED AS PER EMPLOYER	SYA	SJM	SOR	AG	
	POX DEMIN WATER TANK 3450-TNK-001			COMMENTS ON 10/07/2020					
DOCUMENT NUMBER	REFERENCE DOCUMENTS	A01	16/06/2020	ISSUED FOR REFERENCE	PML	SJM	SOR	AG	

RESERVED FOR VENDOR LOGO AND DRAWING NUMBER

LARSEN & TOUBRO
This drawing is the property of LARSEN & TOUBRO and must not be passed on to any person or body not authorized by us to receive it nor be copied or otherwise made use either in full or in part by such person or body without our prior permission in writing.

Outotec
The content of these documents are the sole property of Outotec Oyj. Any rights not expressly granted herein are reserved. Reproduction, transfer or distribution of part or all of the contents in any form without prior written permission of Outotec is prohibited.

MA'ADEN معادن
Saudi Arabian Mining Company شركة معادن العربية السعودية
This document and the information contained herein is Ma'aden proprietary know-how. This document or any part thereof should not be reproduced, stored in a retrieval system or transmitted by any means, electronic or otherwise, or divulged without prior written permission of Ma'aden.

LARSEN & TOUBRO DRAWING NUMBER		REVISION
019045_450_C_G_24113_001		4
OUTOTEC DRAWING NUMBER	DOCUMENT ID	REVISION
900707__GAU01__HH12__MTL03__34512	OU100675354	4

DRAWN	PML	12/06/2020
CHECKED	SJM	15/06/2020
ENGINEER	SOR	12/06/2020
APPROVED	AG	16/06/2020
EMPLOYER		
SCALE 1:100, 1:50,1:20		A1

MANSOURAH - MASSARAH GOLD PROJECT
GENERAL ARRANGEMENT DRAWING
CCD & POX PROCESS WATER STORAGE
LAYOUT & DETAILS OF TANK FDN. 3450-TNK-001

DRAWING NUMBER	REV
MD - 216 - 3450 - EG - CV - GAD - 1258	D01