




DRAWING NUMBER: MD - 216 - 3450 - EG - CV - GAD - 1259
REV: D01

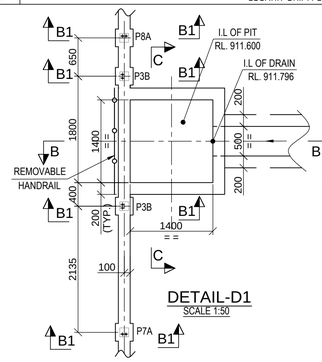


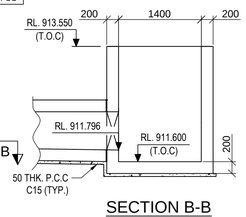


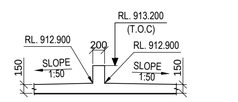


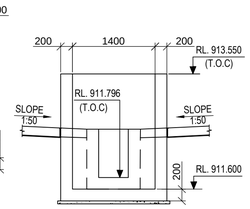


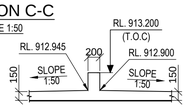


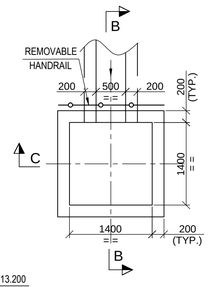


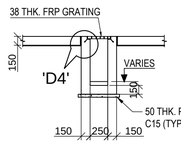


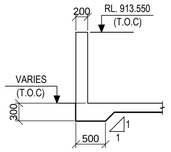

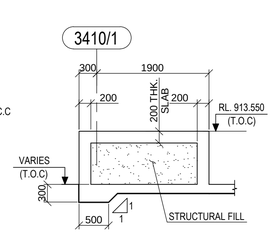


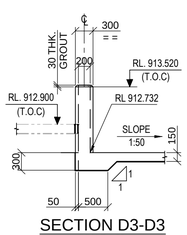

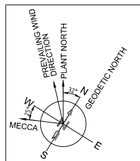


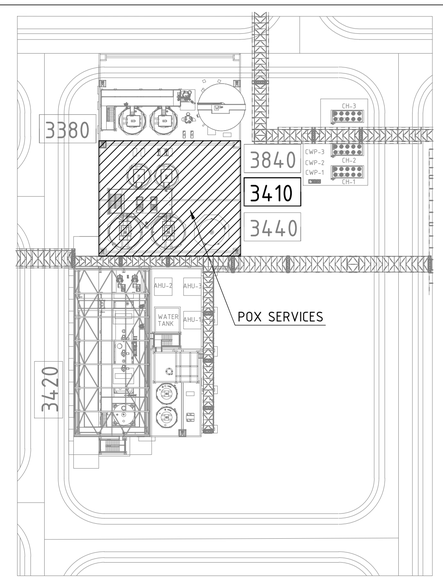



KEY PLAN
(SCALE- 1:750)

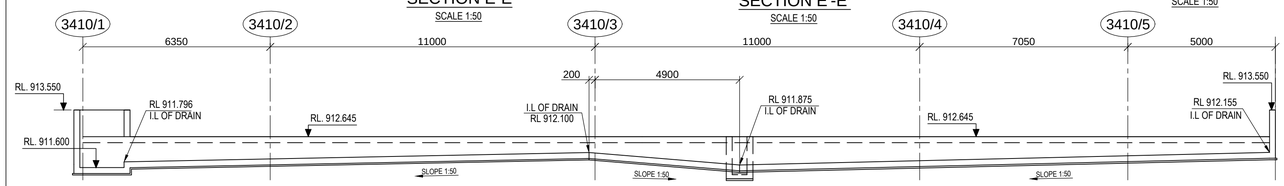


SECTION A-A
SCALE 1:100

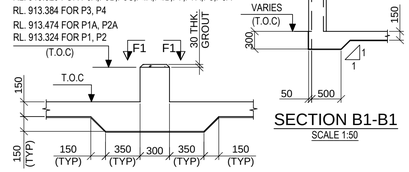


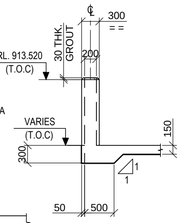


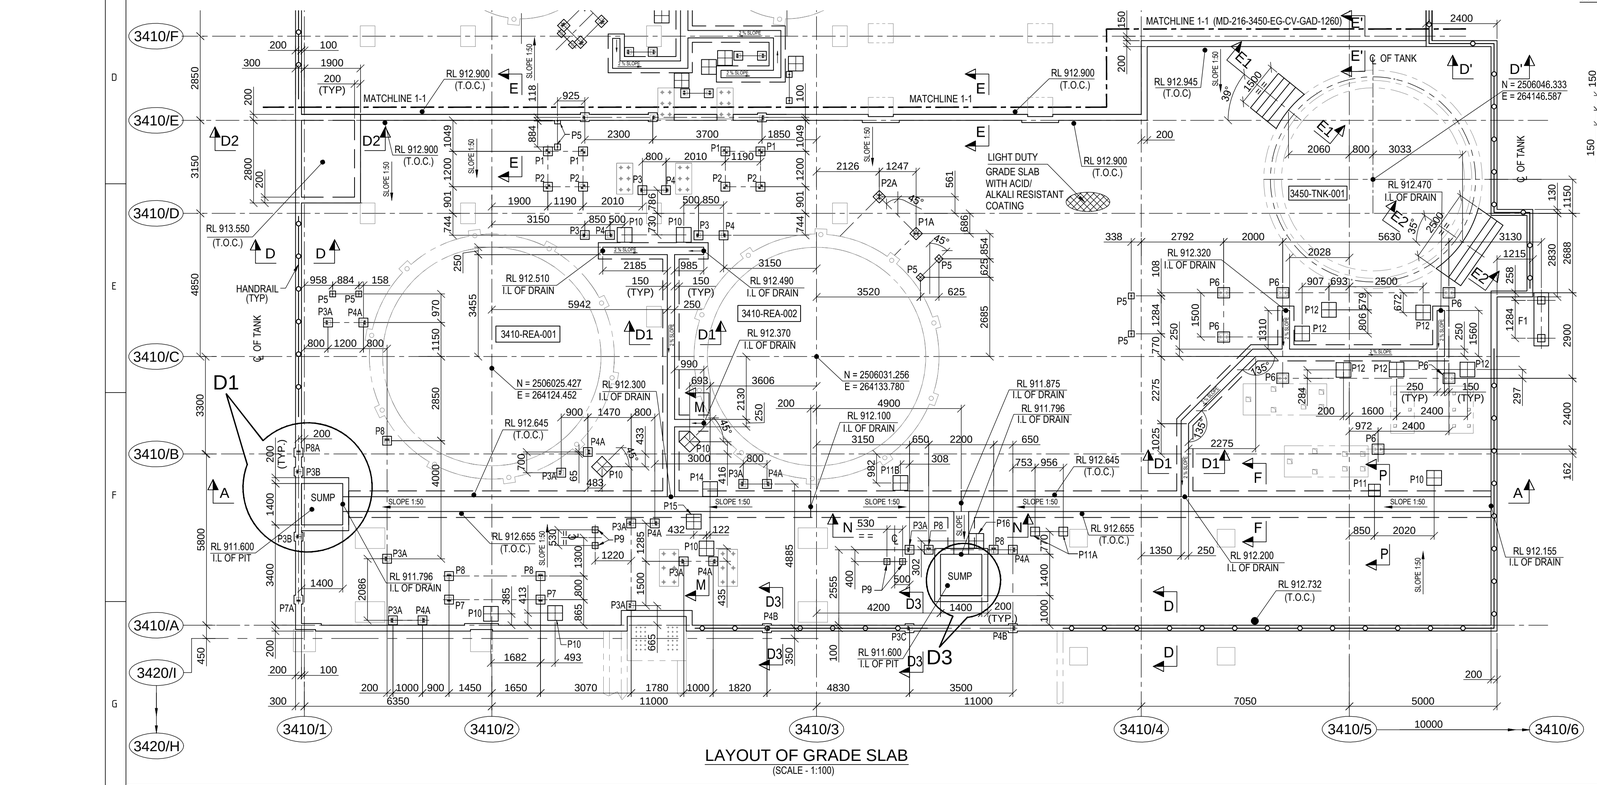



LAYOUT OF GRADE SLAB
(SCALE - 1:100)

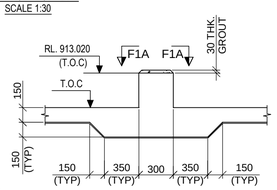


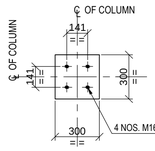


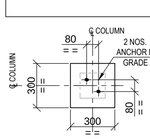


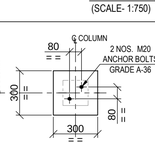


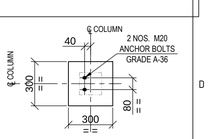


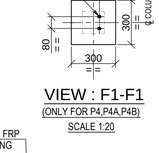


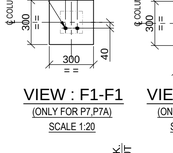


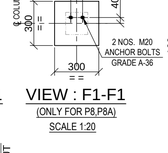


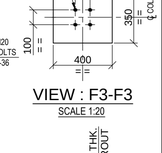


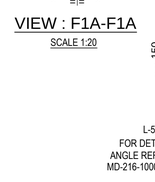


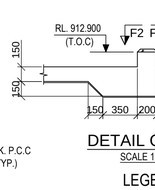

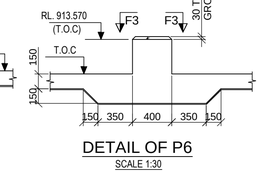

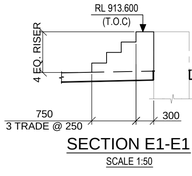

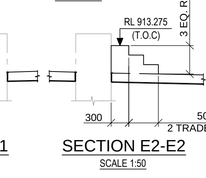

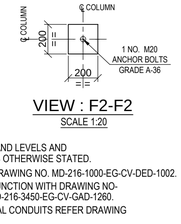

LEGEND :-

R.L. - REDUCED LEVEL
I.L - INVERT LEVEL
THK. - THICK
TYP. - TYPICAL.
T.O.C - TOP OF CONCRETE
℄ - CENTRE LINE
P.C.C - PLAIN CEMENT CONCRETE

NOTES:-

1. ALL DIMENSIONS ARE IN MILLIMETRES AND LEVELS AND CO-ORDINATES ARE IN METRES UNLESS OTHERWISE STATED.
2. FOR DETAILS OF GRADE SLAB REFER DRAWING NO. MD-216-1000-EG-CV-DED-1002.
3. THIS DRAWING IS TO BE READ IN CONJUNCTION WITH DRAWING NO- MD-216-3450-EG-CV-DED-1266,1267 & MD-216-3450-EG-CV-GAD-1260.
4. FOR DETAILS OF EMBEDDED ELECTRICAL CONDUITS REFER DRAWING NO. MD-216-3400-EG-EL-LAD-1001

DOCUMENT NUMBER	REFERENCE DOCUMENTS	REV	DATE	REVISION DESCRIPTION	DRN	CHK	ENG	APP	EMP
		D01	16/03/2023	AS-BUILT	PML	SJM	SOR	AG	
MD-216-3420-EG-ME-GAD-1001	GENERAL ARRANGEMENT DRAWING PRESSURE OXIDATION	C03	06/03/2021	ISSUED FOR CONSTRUCTION AND REVISED AS MARKED (2)	PML	SJM	SOR	AG	
	-FEED STORAGE PLAN AT EL. +912.900	C02	20/10/2020	ISSUED FOR CONSTRUCTION AND REVISED AS MARKED (1)	PML	SJM	SOR	AG	
MD-216-3410-EG-CV-GAD-1001	CIVIL WORKS GUIDE DRAWING PRESSURE OXIDATION-	C01	15/07/2020	ISSUED FOR CONSTRUCTION	SYA	SJM	SOR	AG	
	AUTOCLAVE FEED STORAGE PLAN AT EL. +912.900	A01	12/06/2020	ISSUED FOR REFERENCE	SYA	SJM	SOR	AG	

RESERVED FOR VENDOR LOGO AND DRAWING NUMBER

LARSEN & TOUBRO DRAWING NUMBER: 019045_450_C_G_24113_002 — REVISION: 4
OUTOTEC DRAWING NUMBER: 900707 _GAU01 _HH12 _MTL01 _34516 — DOCUMENT ID: OU100688491 — REVISION: 4

LARSEN & TOUBRO
This drawing is the property of LARSEN & TOUBRO and must not be passed on to any person or body not authorized by us to receive it nor be copied or otherwise made use either in full or in part by such person or body without our prior permission in writing.

Outotec
The content of these documents are the sole property of Outotec Oy). Any rights not expressly granted herein are reserved. Reproduction, transfer or distribution of part or all of the contents in any form without prior written permission of Outotec is prohibited.

MA'ADEN معادن
Saudi Arabian Mining Company شركة التعدين العربية السعودية
This document and the information contained herein is Ma'aden proprietary know-how. This document or any part thereof should not be reproduced, stored in a retrieval system or transmitted by any means, electronic or otherwise, or divulged without prior written permission of Ma'aden.

DRAWN	SYA	09/06/2020	MANSOURAH - MASSARAH GOLD PROJECT
CHECKED	SJM	11/06/2020	GENERAL ARRANGEMENT DRAWING
ENGINEER	SOR	09/06/2020	CCD & POX WATER STORAGE
APPROVED	AG	12/06/2020	GA & DETAILS OF GRADE SLAB
EMPLOYER			
SCALE 1:100, 1:50		A1	DRAWING NUMBER: MD - 216 - 3450 - EG - CV - GAD - 1259 — REV: D01