MA'ADEN معادن
Saudi Arabian Mining Company شركة التعدين العربية السعودية

Project **Mansourah Massarah Gold Project**
Customer: **MA'ADEN GOLD AND BASE METALS (MA'ADEN)**

Title: **GENERAL ARRANGEMENT DRAWING**
CCD & POX WATER STORAGE
GA & DETAILS OF GRADE SLAB


Document Number: **MD-216-3450-EG-CV-GAD-1260**
Revision: **D01**
Revision Date: **16.03.2023**
Status: **ASBUILT**

Outotec Document Number:	900707	GAU01	HH12	MTL01	34517	OU100688492	4
L&T Document Number:	O19045	450	C	G	24113	003	4


REVISION HISTORY

Rev	Date	Revision Text	Prepared By	Reviewed By	Approved By	Employer
A01	12.06.2020	FIRST ISSUE	SOR	SJM	AG	
C01	15.07.2020	ISSUED FOR CONSTRUCTION	SOR	SJM	AG	
C02	20.10.2020	ISSUED FOR CONSTRUCTION AND REVISED AS MARKED △C02	SOR	SJM	AG	
C03	06.03.2021	ISSUED FOR CONSTRUCTION AND REVISED AS MARKED △C03	SOR	SJM	AG	
D01	16.03.2023	AS BUILT	SOR	SJM	AG	


DRAWING NUMBER: MD-216-3450-EG-CV-GAD-1260 | REV: D01

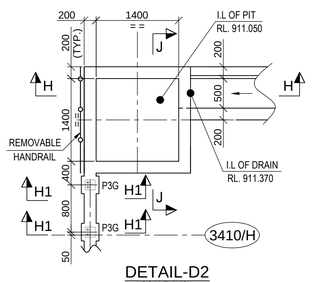


DETAIL-D2
SCALE 1:50

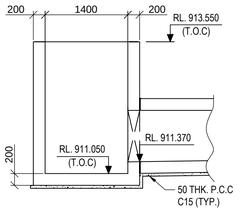


SECTION H-H
SCALE 1:50

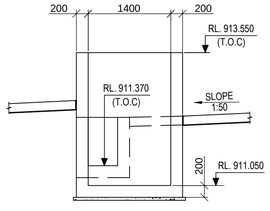


SECTION J-J
SCALE 1:50

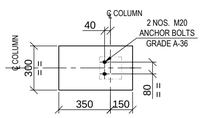


VIEW : F1B-F1B
(ONLY FOR P7B)
SCALE 1:20

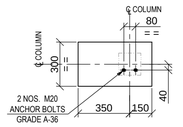


VIEW : F1B-F1B
(ONLY FOR P4D)
SCALE 1:20

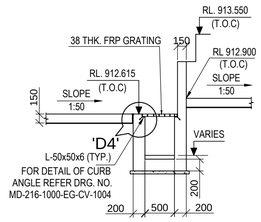


SECTION L-L
SCALE 1:50

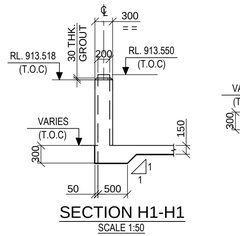


SECTION H1-H1
SCALE 1:50

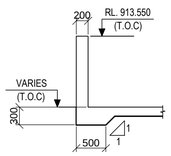


SECTION K-K
SECTION K'-K' (OPPOSITE HAND)
SCALE 1:50

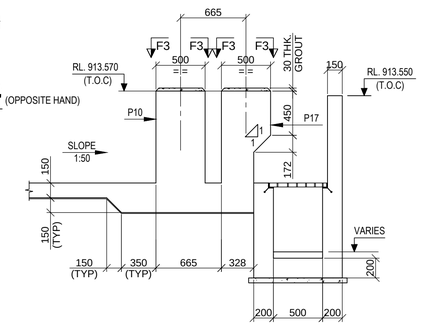


SECTION Q-Q
SCALE 1:30

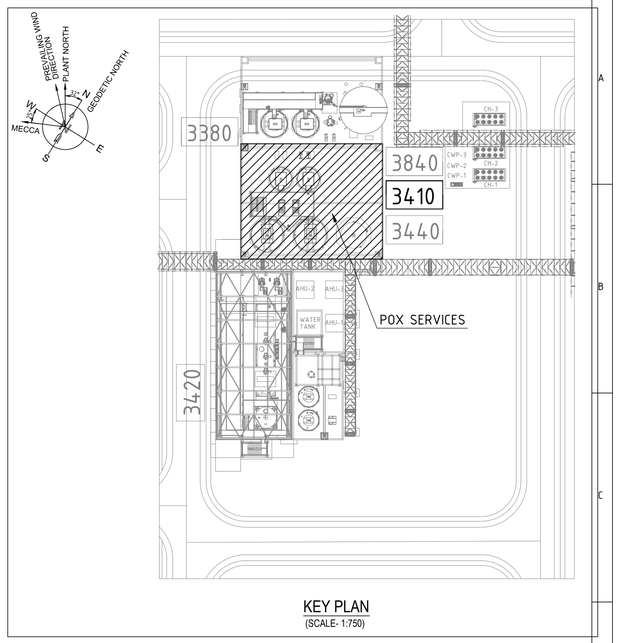


KEY PLAN
(SCALE- 1:750)

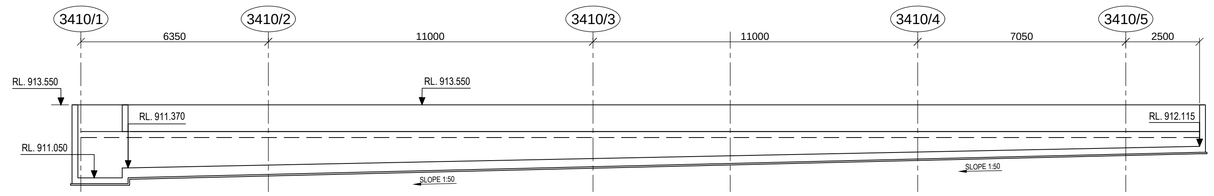


SECTION G-G
SCALE 1:100

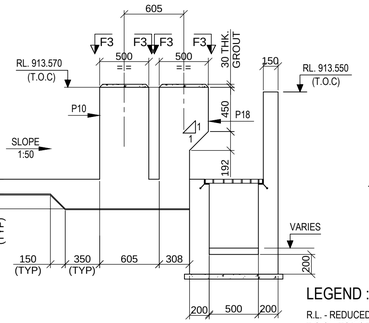

SECTION R-R
SCALE 1:30

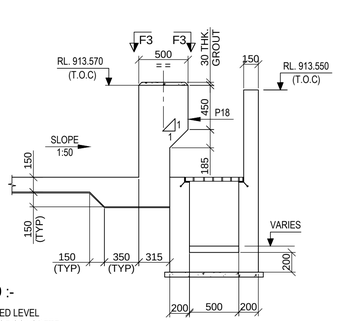


SECTION R1-R1
SCALE 1:30

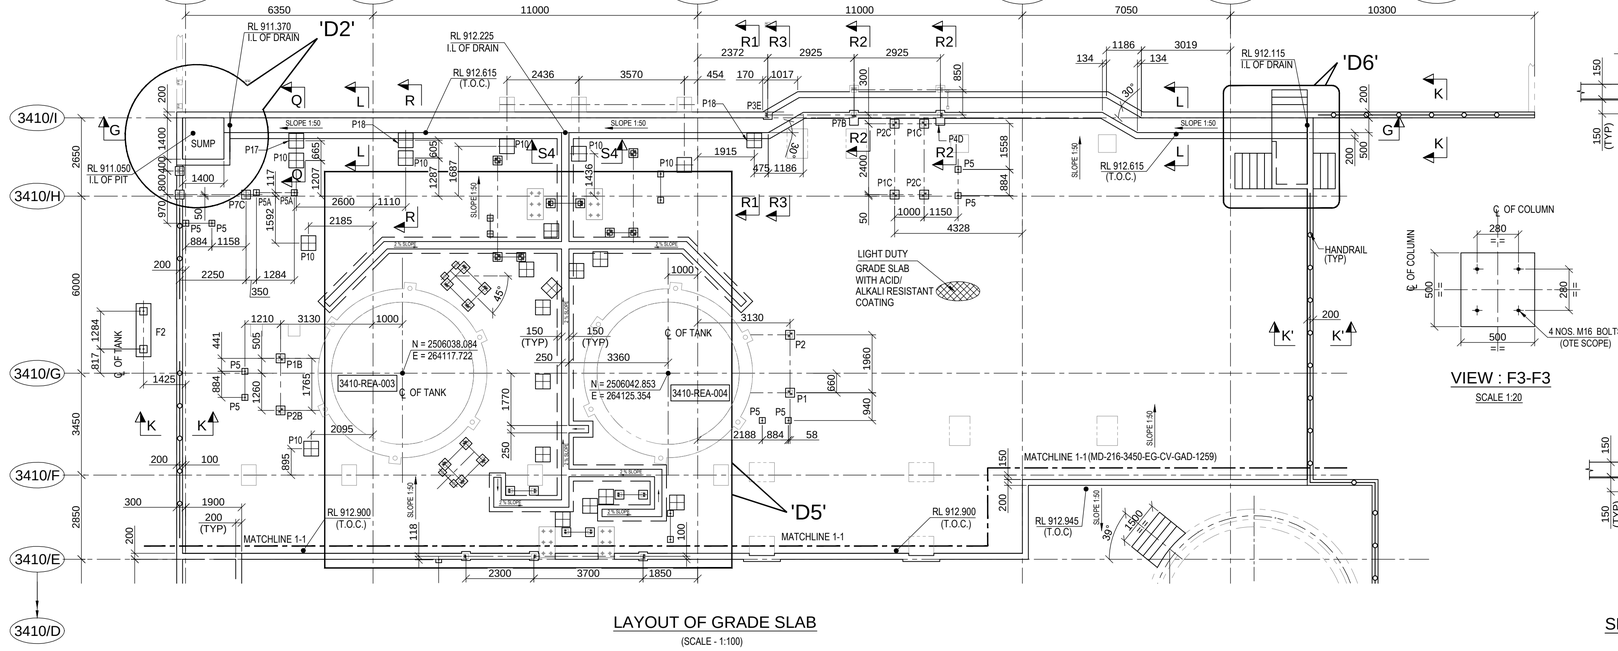

LAYOUT OF GRADE SLAB
(SCALE - 1:100)

VIEW : F3-F3
SCALE 1:20

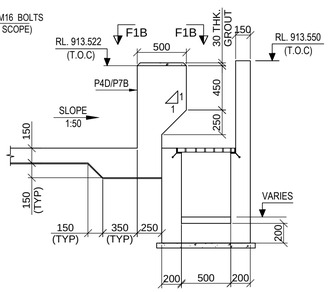

SECTION R2-R2
SCALE 1:30

LEGEND :-

R.L. - REDUCED LEVEL
T.O.C. - TOP OF CONCRETE.
F.G.L. - FINISHED GROUND LEVEL.
TYP. - TYPICAL.
P.C.C - PLAIN CEMENT CONCRETE
MKD. - MARKED
℄ - CENTRE LINE
B.O.F. - BOTTOM OF FOUNDATION
THK. - THICK
FDN. - FOUNDATION
RCC - REINFORCED CEMENT CONCRETE
I.L - INVERT LEVEL
REINF - REINFORCEMENT

NOTES:-

1. ALL DIMENSIONS ARE IN MILLIMETRES AND LEVELS AND CO-ORDINATES ARE IN METRES UNLESS OTHERWISE STATED.
2. GRADE OF CONCRETE SHALL BE C35 (35MPa) FOR FOUNDATION & COLUMN.
3. GRADE OF REINFORCEMENT SHALL BE DEFORMED BAR ASTM A615 - GRADE 60 (fy = 420 MPa).
4. CLEAR COVER TO MAIN REINFORCEMENT SHALL BE AS
   a) FOUNDATION = 50 mm (BOTTOM & SIDE) 50 mm. (TOP)
   b) COLUMN = 50mm
5. IF ANY PART OF FOUNDATION COMES ON BACKFILL ZONE OF ADJACENT FOUNDATION OR ANY LOOSE SOIL ARE ENCOUNTERED BELOW FOUNDATION LEVEL THE SAME SHALL BE REMOVED AND FILLED WITH PCC.
6. FOR STANDARD REINFORCEMENT DETAIL & GENERAL NOTES FOR CIVIL WORKS REFER DRAWING NO. MD-216-1000-EG-CV-DED-1005 &1001.
7. FOR REINFORCEMENT DETAIL REFER DRAWING NO. MD-216-3450-EG-CV-DED-1267.
8. FOR DETAILS OF EMBEDDED ELECTRICAL CONDUITS REFER DRAWING NO. MD-216-3400-EG-EL-LAD-1001
9. THIS DRAWING IS TO BE READ IN CONJUNCTION WITH DRAWING NO- MD-216-3450-EG-CV-DED-1266,1267 & MD-216-3450-EG-CV-GAD-1259.

SHEET 1 OF 2

DOCUMENT NUMBER	REFERENCE DOCUMENTS	REV	DATE	REVISION DESCRIPTION	DRN	CHK	ENG	APP	EMP
		D01	16/03/2023	AS-BUILT	PML	SJM	SOR	AG	
MD-216-3420-EG-ME-GAD-1001	GENERAL ARRANGEMENT DRAWING PRESSURE OXIDATION -FEED STORAGE PLAN AT EL. +912.900	C03	06/03/2021	ISSUED FOR CONSTRUCTION AND REVISED AS MARKED (1,2,3)	PML	SJM	SOR	AG	
		C02	20/10/2020	ISSUED FOR CONSTRUCTION AND REVISED AS MARKED (1,2,3)	PML	SJM	SOR	AG	
MD-216-3410-EG-CV-GAD-1001	CIVIL WORKS GUIDE DRAWING PRESSURE OXIDATION- AUTOCLAVE FEED STORAGE PLAN AT EL. +912.900	C01	15/07/2020	ISSUED FOR CONSTRUCTION	SYA	SJM	SOR	AG	
		A01	12/06/2020	ISSUED FOR REFERENCE	SYA	SJM	SOR	AG	

RESERVED FOR VENDOR LOGO AND DRAWING NUMBER

LARSEN & TOUBRO

This drawing is the property of LARSEN & TOUBRO and must not be passed on to any person or body not authorized by us to receive it nor be copied or otherwise made use either in full or in part by such person or body without our prior permission in writing.

Outotec

The content of these documents are the sole property of Outotec Oyj. Any rights not expressly granted herein are reserved. Reproduction, transfer or distribution of part or all of the contents in any form without prior written permission of Outotec is prohibited.

MA'ADEN معادن
Saudi Arabian Mining Company شركة المعادن العربية السعودية

This document and the information contained herein is Ma'aden proprietary know-how. This document or any part thereof should not be reproduced, stored in a retrieval system or transmitted by any means, electronic or otherwise, or divulged without prior written permission of Ma'aden.


LARSEN & TOUBRO DRAWING NUMBER: 019045_450_C_G_24113_003 | REVISION: 4
OUTOTEC DRAWING NUMBER: 900707 _GAU01 _HH12 _MTL01 _34517 | DOCUMENT ID: OU100688492 | REVISION: 4

DRAWN	SYA	09/06/2020
CHECKED	SJM	11/06/2020
ENGINEER	SOR	09/06/2020
APPROVED	AG	12/06/2020
EMPLOYER		
SCALE 1:100, 50		A1


MANSOURAH - MASSARAH GOLD PROJECT
GENERAL ARRANGEMENT DRAWING
CCD & POX WATER STORAGE
GA & DETAILS OF GRADE SLAB

DRAWING NUMBER: MD - 216 - 3450 - EG - CV - GAD - 1260 | REV: D01


DRAWING NUMBER: MD-216-3450-EG-CV-GAD-1260 | REV: D01

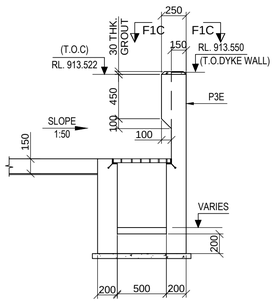


SECTION R3-R3
SCALE 1:30

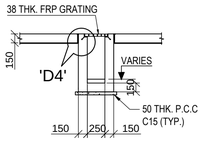


SECTION S-S
SCALE 1:50

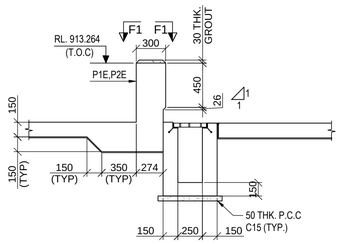


SECTION S1-S1
SCALE 1:30

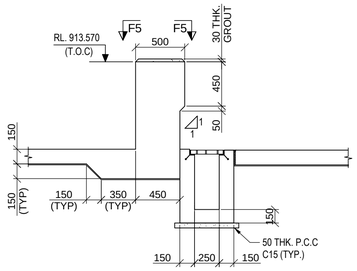


SECTION S2-S2
SCALE 1:30

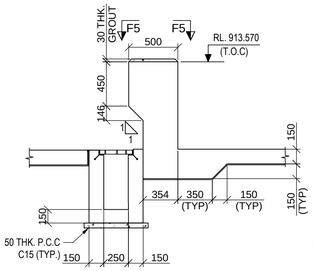


SECTION S3-S3
SCALE 1:30

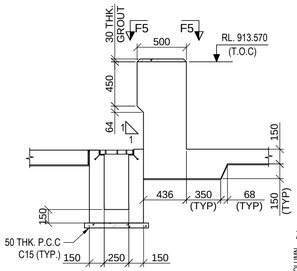


SECTION S4-S4
SCALE 1:30

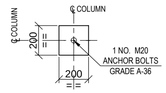


VIEW : F2-F2
SCALE 1:20

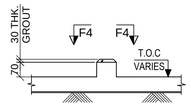


DETAIL OF P9
SCALE 1:30

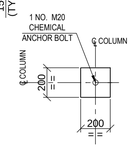


VIEW : F4-F4
SCALE 1:20

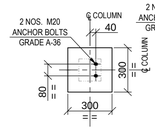


VIEW : F1-F1
(ONLY FOR P4,P4C,P4E)
SCALE 1:20

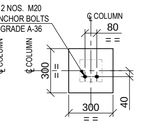


VIEW : F1-F1
(ONLY FOR P7C)
SCALE 1:20

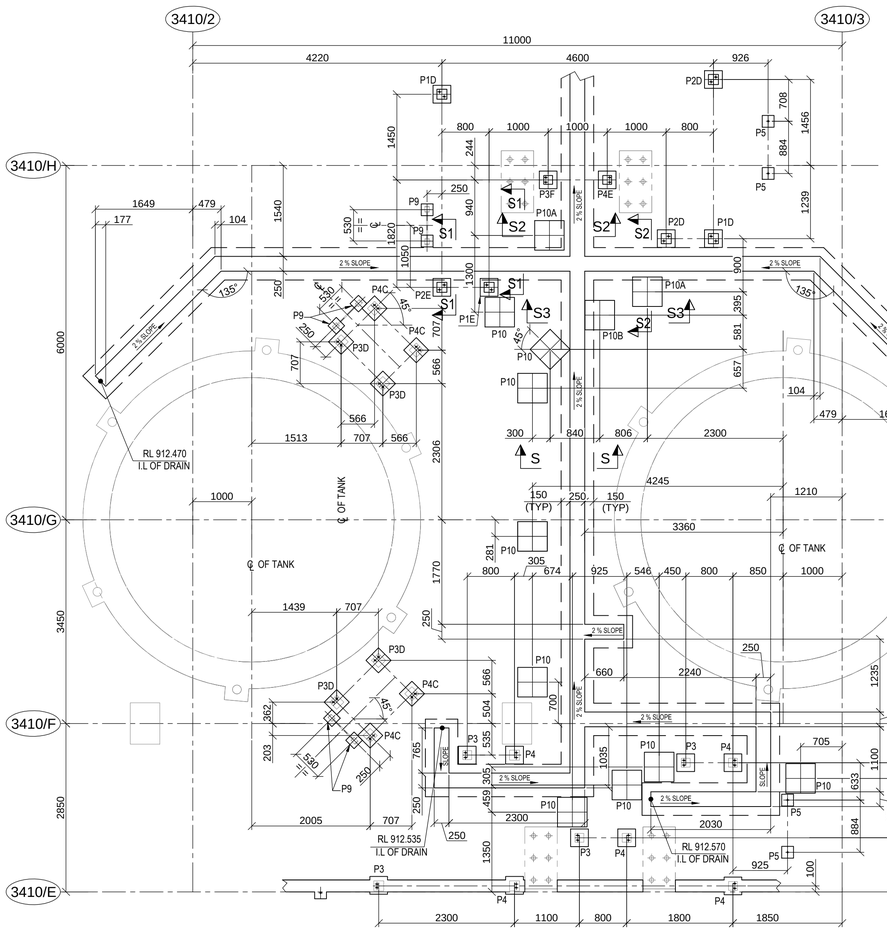


DETAIL - D5
SCALE 1:50

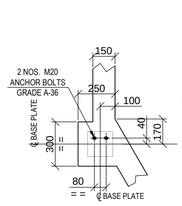


VIEW : F1C-F1C
SCALE 1:20

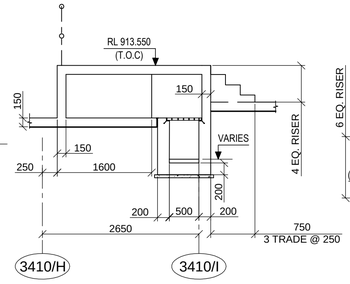


SECTION T-T
SCALE 1:50

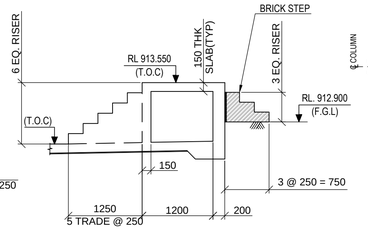


SECTION T1-T1
SCALE 1:50

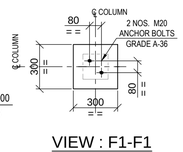


VIEW : F1-F1
(ONLY FOR P1B,P1C,P1D,P1E)
SCALE 1:20

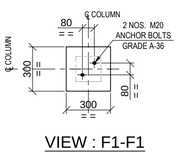


VIEW : F1-F1
(ONLY FOR P2B,P2C,P2D,P2E)
SCALE 1:20

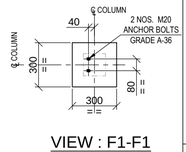


VIEW : F1-F1
(ONLY FOR P3,P3D,P3F,P3G)
SCALE 1:20

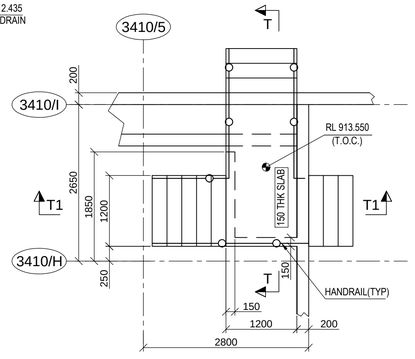


DETAIL - D6
SCALE 1:50

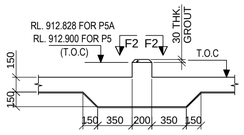


DETAIL OF P5 & P5A
SCALE 1:30

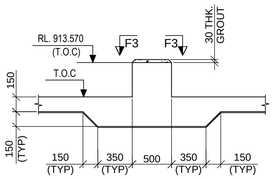


DETAIL OF P10
SCALE 1:30

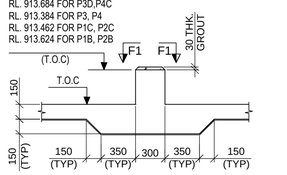

DETAIL OF P1B,P1C,P1D,P2B,P2C,
P2D,P3,P3D,P3F,P3G,P4,
P4C,P4E,P7C
SCALE 1:30

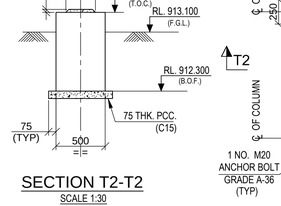

SECTION T2-T2
SCALE 1:30

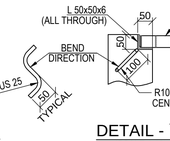

DETAIL - 'D4'
(SCALE 1:10)
(TYPICAL)

DETAIL OF FOUNDATION MKD F2
(1 NO REQUIRED)
SCALE 1:30

LEGEND :-

R.L. - REDUCED LEVEL
T.O.C. - TOP OF CONCRETE.
F.G.L. - FINISHED GROUND LEVEL.
TYP - TYPICAL
P.C.C - PLAIN CEMENT CONCRETE
MKD. - MARKED
℄ - CENTRE LINE
B.O.F. - BOTTOM OF FOUNDATION
THK. - THICK
FDN. - FOUNDATION
RCC - REINFORCED CEMENT CONCRETE
I.L - INVERT LEVEL
REINF - REINFORCEMENT

NOTES:-

1. ALL DIMENSIONS ARE IN MILLIMETRES AND LEVELS AND CO-ORDINATES ARE IN METRES UNLESS OTHERWISE STATED.
2. GRADE OF CONCRETE SHALL BE C35 (35MPa) FOR FOUNDATION & COLUMN.
3. GRADE OF REINFORCEMENT SHALL BE DEFORMED BAR ASTM A615 - GRADE 60 (fy = 420 MPa).
4. CLEAR COVER TO MAIN REINFORCEMENT SHALL BE AS
   a) FOUNDATION = 50 mm (BOTTOM & SIDE) 50 mm. (TOP)
   b) COLUMN = 50mm
5. IF ANY PART OF FOUNDATION COMES ON BACKFILL ZONE OF ADJACENT FOUNDATION OR ANY LOOSE SOIL ARE ENCOUNTERED BELOW FOUNDATION LEVEL THE SAME SHALL BE REMOVED AND FILLED WITH PCC.
6. FOR STANDARD REINFORCEMENT DETAIL & GENERAL NOTES FOR CIVIL WORKS REFER DRAWING NO. MD-216-1000-EG-CV-DED-1005 &1001.
7. FOR REINFORCEMENT DETAIL REFER DRAWING NO. MD-216-3450-EG-CV-DED-1267.

SHEET 2 OF 2

DOCUMENT NUMBER	REFERENCE DOCUMENTS	REV	DATE	REVISION DESCRIPTION	DRN	CHK	ENG	APP	EMP
		D01	16/03/2023	AS-BUILT	PML	SJM	SOR	AG	
MD-216-3420-EG-ME-GAD-1001	GENERAL ARRANGEMENT DRAWING PRESSURE OXIDATION	C03	06/03/2021	ISSUED FOR CONSTRUCTION AND REVISED AS MARKED	PML	SJM	SOR	AG	
	-FEED STORAGE PLAN AT EL. +912.900	C02	20/10/2020	ISSUED FOR CONSTRUCTION AND REVISED AS MARKED	PML	SJM	SOR	AG	
MD-216-3410-EG-CV-GAD-1001	CIVIL WORKS GUIDE DRAWING PRESSURE OXIDATION-	C01	15/07/2020	ISSUED FOR CONSTRUCTION	SYA	SJM	SOR	AG	
	AUTOCLAVE FEED STORAGE PLAN AT EL. +912.900	A01	12/06/2020	ISSUED FOR REFERENCE	SYA	SJM	SOR	AG	

RESERVED FOR VENDOR LOGO AND DRAWING NUMBER

LARSEN & TOUBRO

This drawing is the property of LARSEN & TOUBRO and must not be passed on to any person or body not authorized by us to receive it nor be copied or otherwise made use either in full or in part by such person or body without our prior permission in writing.

Outotec

The content of these documents are the sole property of Outotec Oyj. Any rights not expressly granted herein are reserved. Reproduction, transfer or distribution of part or all of the contents in any form without prior written permission of Outotec is prohibited.

MA'ADEN معادن
Saudi Arabian Mining Company شركة التعدين العربية السعودية

This document and the information contained herein is Ma'aden proprietary know-how. This document or any part thereof should not be reproduced, stored in a retrieval system or transmitted by any means, electronic or otherwise, or divulged without prior written permission of Ma'aden.

LARSEN & TOUBRO DRAWING NUMBER: 019045_450_C_G_24113_003 | REVISION: 4
OUTOTEC DRAWING NUMBER: 900707__GAU01__HH12__MTL01__34517 | DOCUMENT ID: OU100688492 | REVISION: 4

DRAWN	SYA	09/06/2020
CHECKED	SJM	11/06/2020
ENGINEER	SOR	09/06/2020
APPROVED	AG	12/06/2020
EMPLOYER		
SCALE 1:100, 50		A1

MANSOURAH - MASSARAH GOLD PROJECT
GENERAL ARRANGEMENT DRAWING
CCD & POX WATER STORAGE
GA & DETAILS OF GRADE SLAB

DRAWING NUMBER: MD-216-3450-EG-CV-GAD-1260 | REV: D01