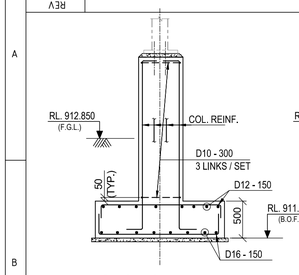
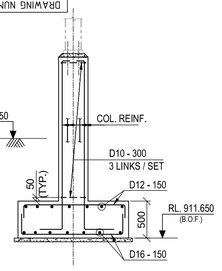
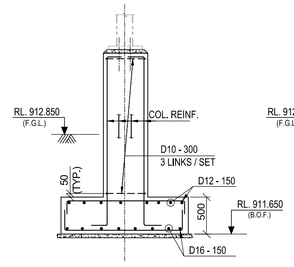
DRAWING NUMBER: MD-216-3450-EG-CV-GAD-1265 | REV: D01



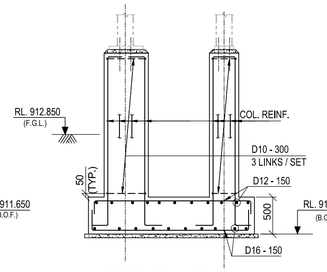

SECTION : F-F
SCALE 1:40





SECTION : G-G
SCALE 1:40





SECTION : H-H
SCALE 1:40





SECTION : J-J
SCALE 1:40

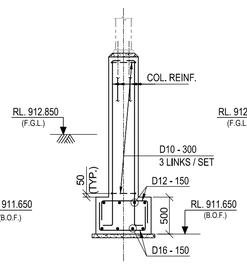



SECTION : K-K
SCALE 1:40

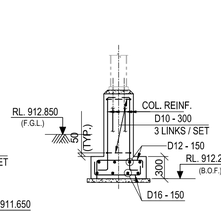



SECTION : N-N
SCALE 1:40

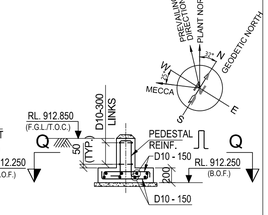



SECTION : P-P
SCALE 1:40

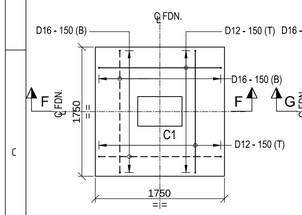



RCC. DET. OF FDN MKD. F1
SCALE 1:40

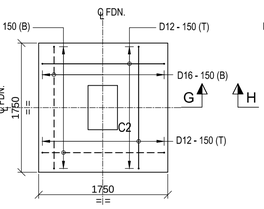



RCC. DET. OF FDN MKD. F2
SCALE 1:40

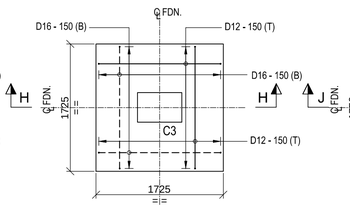



RCC. DET. OF FDN MKD. F3
SCALE 1:40

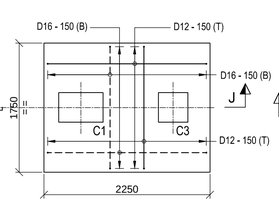



RCC. DET. OF FDN MKD. F4
SCALE 1:40

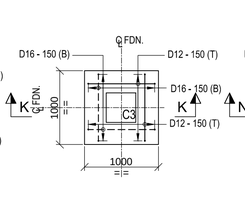



RCC. DET. OF FDN MKD. F5
SCALE 1:40

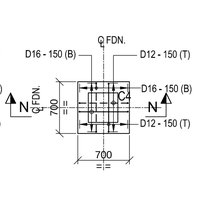



RCC. DET. OF FDN MKD. F6
SCALE 1:40

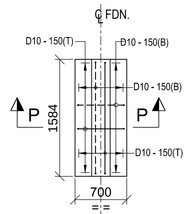



RCC. DET. OF FDN MKD. F7
SCALE 1:40

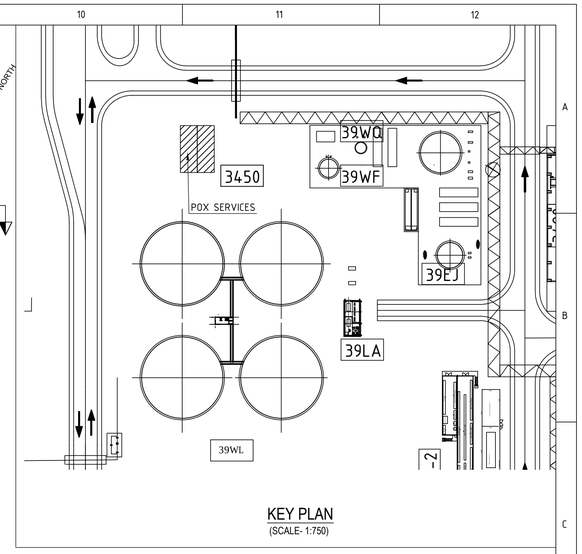



KEY PLAN
(SCALE- 1:750)

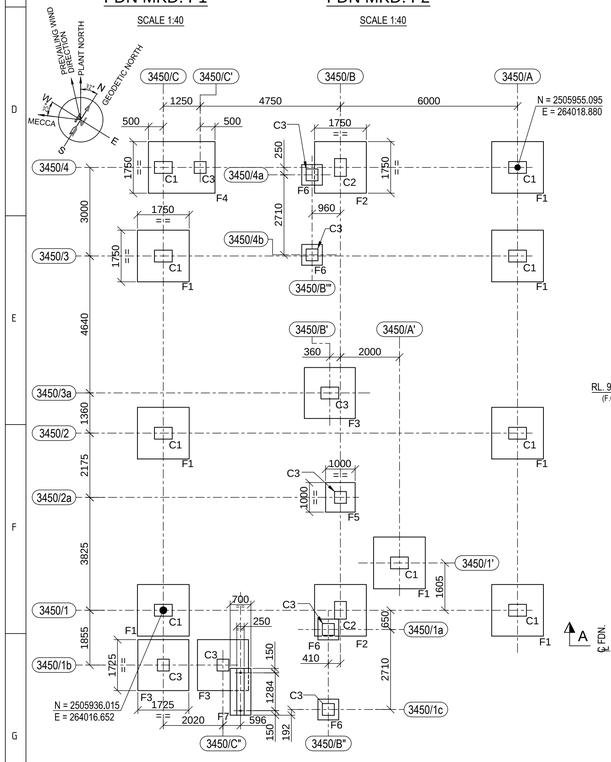



LAYOUT OF FOUNDATION
SCALE 1:100

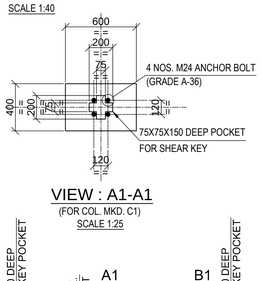

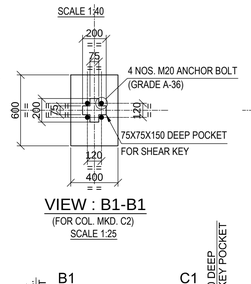

VIEW : A1-A1
(FOR COL. MKD. C1)
SCALE 1:25



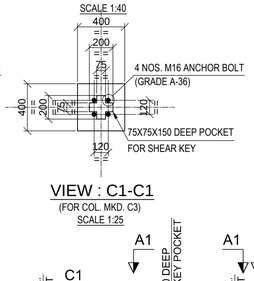

VIEW : B1-B1
(FOR COL. MKD. C2)
SCALE 1:25



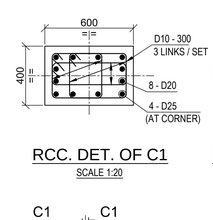

VIEW : C1-C1
(FOR COL. MKD. C3)
SCALE 1:25





RCC. DET. OF C1
SCALE 1:20

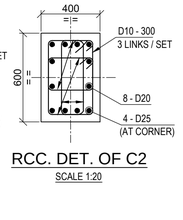



RCC. DET. OF C2
SCALE 1:20

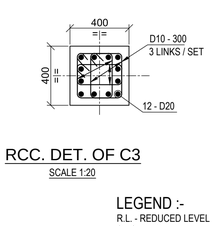



RCC. DET. OF C3
SCALE 1:20

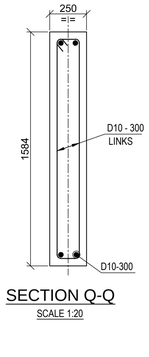



SECTION Q-Q
SCALE 1:20

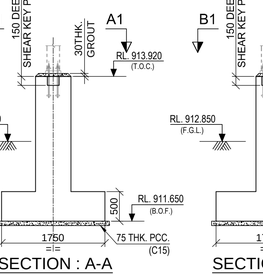



SECTION : A-A
SCALE 1:50

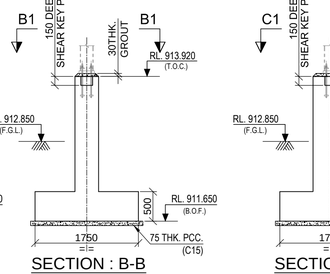



SECTION : B-B
SCALE 1:50

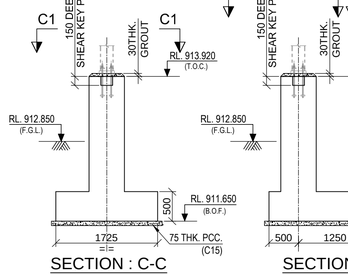



SECTION : C-C
SCALE 1:50

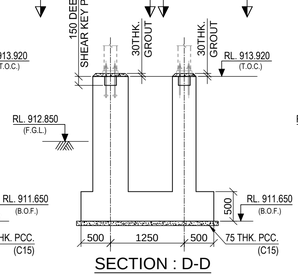


SECTION : D-D
SCALE 1:50

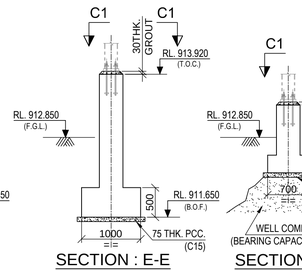



SECTION : E-E
SCALE 1:50

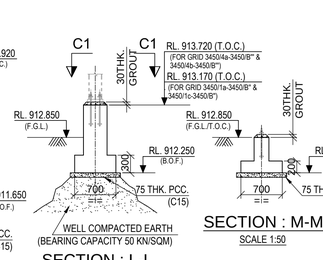



SECTION : L-L
SCALE 1:50

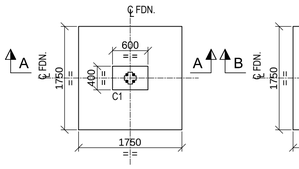
SECTION : M-M
SCALE 1:50





DET. OF FDN. MKD. F1
SCALE 1:50

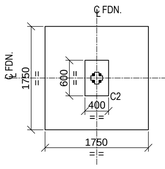



DET. OF FDN. MKD. F2
SCALE 1:50

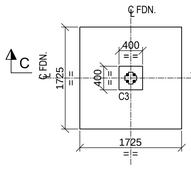



DET. OF FDN. MKD. F3
SCALE 1:50

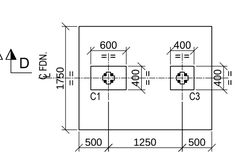



DET. OF FDN. MKD. F4
SCALE 1:50

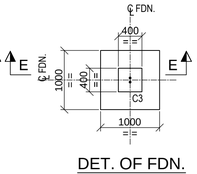


DET. OF FDN. MKD. F5
SCALE 1:50

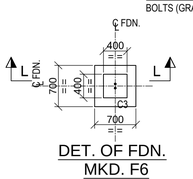


DET. OF FDN. MKD. F6
SCALE 1:50

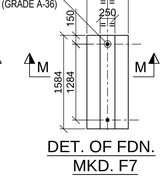


DET. OF FDN. MKD. F7
SCALE 1:50

## LEGEND :-

R.L. - REDUCED LEVEL
℄ - CENTRE LINE
T.O.C. - TOP OF CONCRETE
F.G.L. - FINISHED GROUND LEVEL
F.F.L. - FINISHED FLOOR LEVEL
B.O.F. - BOTTOM OF FOUNDATION
MKD. - MARKED
GA - GENERAL ARRANGEMENT
COL. - COLUMN
REINF. - REINFORCEMENT
SQ. - SQUARE
TYP. - TYPICAL
P.C.C - PLAIN CEMENT CONCRETE
THK. - THICK
T.O.G. - TOP OF GROUT
DET. - DETAIL
DRG. - DRAWING
FDN. - FOUNDATION
R.C.C - REINFORCED CEMENT CONCRETE
BOTTOM REINFORCEMENT (B) - _ _ _ _
TOP REINFORCEMENT (T) - ———
CJ - CONSTRUCTION JOINT

## NOTES:-

1. ALL DIMENSIONS ARE IN MILLIMETRES AND LEVELS AND CO-ORDINATES ARE IN METRES UNLESS OTHERWISE STATED.
2. NET SAFE BEARING CAPACITY OF SOIL AT BOTTOM OF FOUNDATION IS CONSIDERED AS 350KN/ SQ. M.
3. GRADE OF CONCRETE SHALL BE C35 (35Mpa) FOR FOUNDATION, C30 (30Mpa) FOR GRADE SLAB & C15 (15Mpa) FOR BLINDING CONCRETE.
4. GRADE OF REINFORCEMENT SHALL BE DEFORMED BAR 420 MPa (GRADE 60) - ASTM A615/A615M.
5. CLEAR COVER TO REINFORCEMENT SHALL BE AS FOLLOWS
   a) FOUNDATION = 50 mm
   b) COLUMN = 50mm
6. IF ANY PART OF FOUNDATION COMES ON BACKFILL ZONE OF ADJACENT FOUNDATION OR ANY LOOSE SOIL ARE ENCOUNTERED BELOW FOUNDATION LEVEL THE SAME SHALL BE REMOVED AND FILLED WITH PCC.
7. FOR STANDARD REINFORCEMENT DETAIL & GENERAL NOTES FOR CIVIL WORKS REFER DRAWING NO. MD-216-1000-EG-CV-DED-1005 & 1001.

| DOCUMENT NUMBER | REFERENCE DOCUMENTS | REV | DATE | REVISION DESCRIPTION | DRN | CHK | ENG | APP | EMP |
|---|---|---|---|---|---|---|---|---|---|
| | | D01 | 16/03/2023 | AS-BUILT | SYA | SJM | SOR | AG | |
| MD-216-3450-EG-ST-GAD-2255 | POX SERVICE- PLAN, ELEVATIONS & DETAILS | C01 | 30/11/2020 | ISSUED FOR CONSTRUCTION AND REVISED AS MKD. C01 | SYA | SJM | SOR | AG | |
| MD-216-3450-EG-ST-GAD-2254 | POX SERVICE- PLAN, ELEVATIONS & DETAILS | A01 | 20/10/2020 | ISSUED FOR REFERENCE | SYA | SJM | SOR | AG | |

RESERVED FOR VENDOR LOGO AND DRAWING NUMBER

LARSEN & TOUBRO

This drawing is the property of LARSEN & TOUBRO and must not be passed on to any person or body not authorized by us to receive it nor be copied or otherwise made use either in full or in part by such person or body without our prior permission in writing.

Outotec

The content of these documents are the sole property of Outotec Oy). Any rights not expressly granted herein are reserved. Reproduction, transfer or distribution of part or all of the contents in any form without prior written permission of Outotec is prohibited.

MA'ADEN معادن
Saudi Arabian Mining Company شركة التعدين العربية السعودية

This document and the information contained herein is Ma'aden proprietary know-how. This document or any part thereof should not be reproduced, stored in a retrieval system or transmitted by any means, electronic or otherwise, or divulged without prior written permission of Ma'aden.

| | | | |
|---|---|---|---|
| LARSEN & TOUBRO DRAWING NUMBER | 019045_450_C_G_24526_001 | | REVISION 2 |
| OUTOTEC DRAWING NUMBER | 900707 _GAU01 _HH12 _MTL01 _34530 | DOCUMENT ID OU100704679 | REVISION 2 |

| | | | |
|---|---|---|---|
| DRAWN | SYA | 15/10/2020 | MANSOURAH - MASSARAH GOLD PROJECT |
| CHECKED | SJM | 19/10/2020 | GENERAL ARRANGEMENT DRAWING |
| ENGINEER | SOR | 15/10/2020 | PRESSURE OXIDATION SERVICES |
| APPROVED | AG | 20/10/2020 | GA & DETAILS OF FOUNDATION |
| EMPLOYER | | | |
| SCALE 1:100, 1:50 | A1 | | DRAWING NUMBER MD - 216 - 3450 - EG - CV - GAD - 1265 REV D01 |