


DRAWING NUMBER: MD-216-3510-EG-CV-DED-1280 | REV: D01

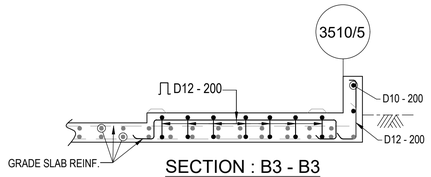


SECTION : B3 - B3
(SCALE 1:25)

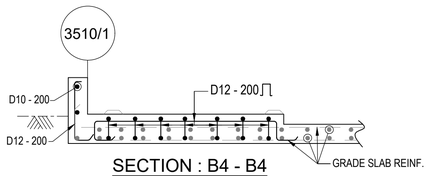


SECTION : B4 - B4
(SCALE 1:25)

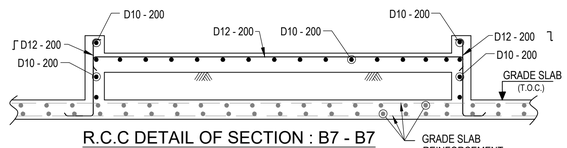


R.C.C DETAIL OF SECTION : B7 - B7
(REF. DRG NO. MD-216-3510-EG-CV-GAD-1280)
(SCALE 1:25)

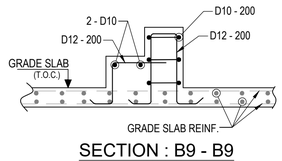


SECTION : B9 - B9
(REF. DRG NO. MD-216-3510-EG-CV-GAD-1280)
(SCALE 1:25)

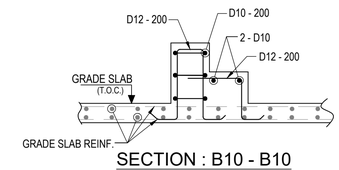


SECTION : B10 - B10
SECTION : B11 - B11
(REF. DRG NO. MD-216-3510-EG-CV-GAD-1280)
(SCALE 1:25)

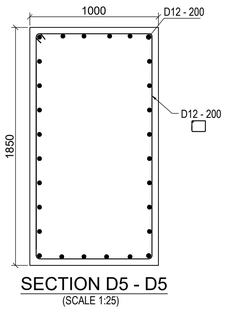


SECTION D5 - D5
(SCALE 1:25)

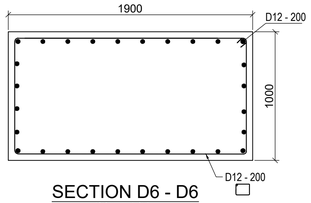


SECTION D6 - D6
(SCALE 1:25)

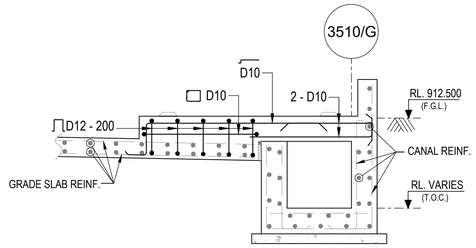


SECTION : B1 - B1
(SCALE 1:25)

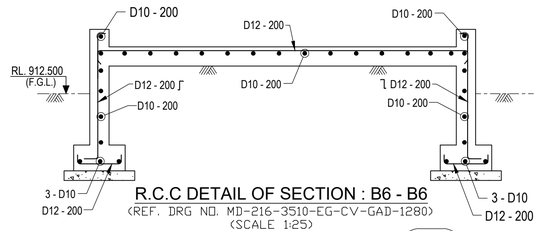


R.C.C DETAIL OF SECTION : B6 - B6
(REF. DRG NO. MD-216-3510-EG-CV-GAD-1280)
(SCALE 1:25)

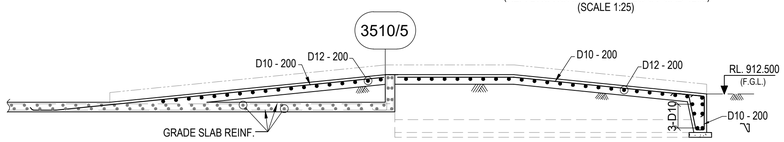


R.C.C DETAIL OF SECTION : B8 - B8
(REF. DRG NO. MD-216-3510-EG-CV-GAD-1280)
(SCALE 1:50)

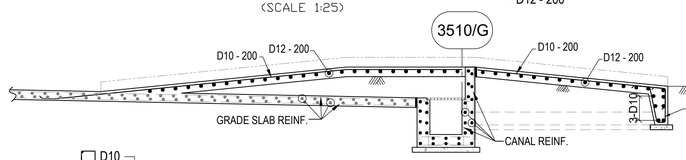


R.C.C DETAIL OF SECTION : B5 - B5
(REF. DRG NO. MD-216-3510-EG-CV-GAD-1280)
(SCALE 1:50)

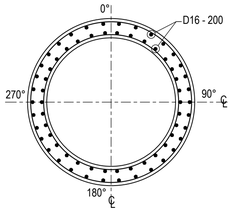


SECTION D3 - D3
(SCALE - 1:50)

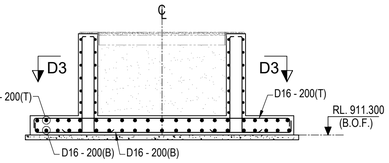


SECTION D2 - D2
(SCALE - 1:50)

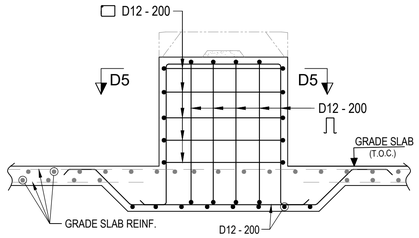


R.C.C DETAIL OF PEDESTAL MKD. P17 & P18
(SCALE 1:30)

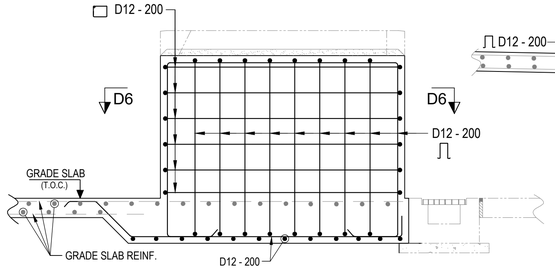


R.C.C DETAIL OF PEDESTAL MKD. P24 & P25
(SCALE 1:25)

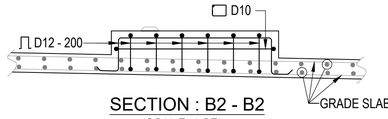


SECTION : B2 - B2
(SCALE 1:25)

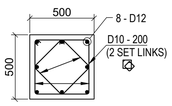


SECTION : C1 - C1
(SCALE 1:25)

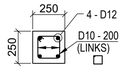


SECTION : C3 - C3
(SCALE 1:25)

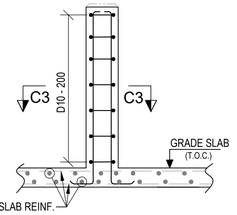


R.C.C DETAIL OF PEDESTAL MKD. P1D
(SCALE 1:25)

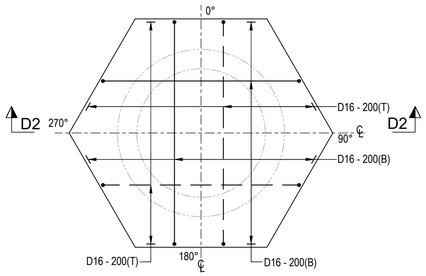


TANK-001, 002 & 003
R.C.C DETAIL OF FOUNDATION PLAN
(SCALE 1:50)

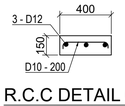


R.C.C DETAIL OF B1
(SCALE-1:25)

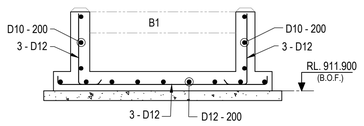

SECTION : A3 - A3
(SCALE 1:25)

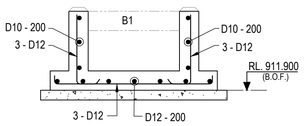


SECTION : A1 - A1
(SCALE 1:25)

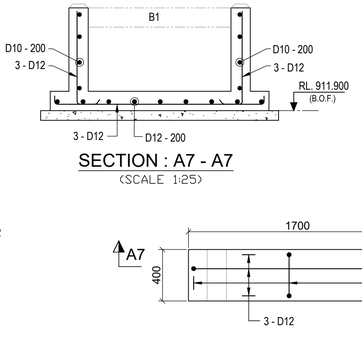


R.C.C DETAIL OF FOUNDATION MKD. F1B, F1C
(SCALE 1:25)


SECTION : A7 - A7
(SCALE 1:25)

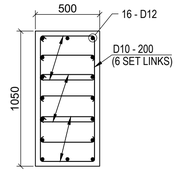


SECTION : D1 - D1
(SCALE 1:25)

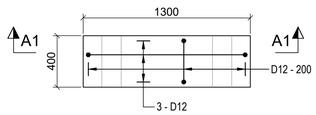


R.C.C DETAIL OF FOUNDATION MKD. F1A & F1E
(SCALE 1:25)

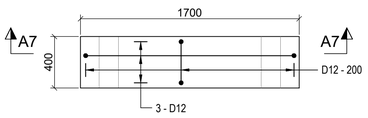


R.C.C DETAIL OF FOUNDATION MKD. F1D & F1F
(SCALE 1:25)

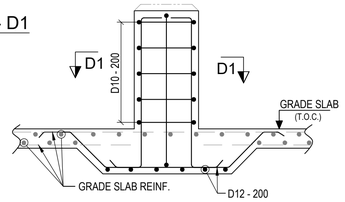


R.C.C DETAIL OF PEDESTAL MKD. P3, P4, P12, P13, P21 & P22
(SCALE 1:25)

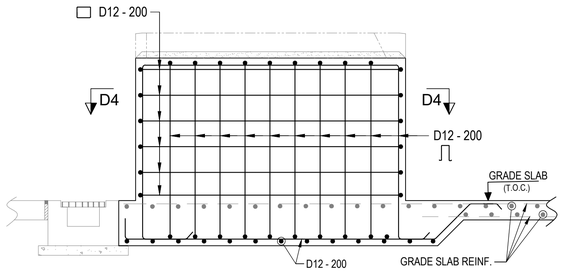


R.C.C DETAIL OF PEDESTAL MKD. P6 & P7
(SCALE 1:25)

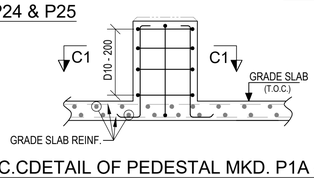


R.C.CDETAIL OF PEDESTAL MKD. P1A & P1B
(SCALE 1:25)

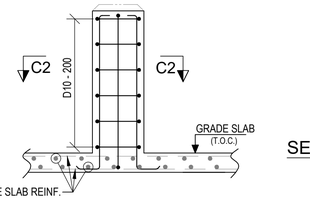

R.C.C DETAIL OF PEDESTAL MKD. P1C
(SCALE 1:25)

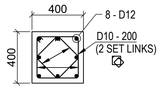

SECTION : C2 - C2
(SCALE 1:25)

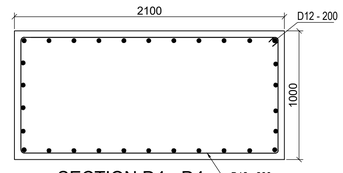

SECTION D4 - D4
(SCALE 1:25)

LEGEND:-

R.L. - REDUCED LEVEL
T.O.C - TOP OF CONCRETE
F.G.L - FINISHED GROUND LEVEL
B.O.F - BOTTOM OF FOUNDATION
P.C.C - PLAIN CEMENT CONCRETE
TYP - TYPICAL
MKD - MARKED
℄ - CENTRE LINE
B - BOTTOM REINFORCEMENT SHOWN THUS ———
T - TOP REINFORCEMENT SHOWN THUS – – – – – –
SBC - SAFE BEARING CAPACITY
MIN. - MINIMUM
REF. - REFER
GA - GENERAL ARRANGEMENT
DRG. - DRAWING
R.C.C. - REINFORCED CEMENT CONCRETE
REINF. - REINFORCEMENT

NOTES:-

1. ALL DIMENSIONS ARE IN MILLIMETRES AND LEVELS ARE IN METRES UNLESS OTHERWISE STATED.
2. GRADE OF CONCRETE SHALL BE C35 UNLESS NOTED OTHERWISE.
3. GRADE OF REINFORCEMENT SHALL BE DEFORMED BAR ASTM A615-GRADE 60 (fy=420 MPa)
4. CLEAR COVER TO MAIN REINFORCEMENT SHALL BE AS FOLLOWS:
   a) FOUNDATION : 75 mm. (BOTTOM & SIDE)
   b) FOUNDATION : 50 mm. (TOP)
   c) COLUMN & PEDESTAL : 50 mm.
   d) PIT : 50 mm.
5. FOR STANDARD REINF. DETAIL REFER DRG. NO : MD-216-1000-EG-CV-DED-1005.
6. FOR GA DRAWING REFER DRG. NO. MD - 216 - 3510 - EG - CV - GAD - 1277.
   MD - 216 - 3510 - EG - CV - GAD - 1278.
   MD - 216 - 3510 - EG - CV - GAD - 1279.
   MD - 216 - 3510 - EG - CV - GAD - 1280.

DOCUMENT NUMBER	REFERENCE DOCUMENTS	REV	DATE	REVISION DESCRIPTION	DRN	CHK	ENG	APP	EMP
MD-216-3510-EG-CV-GAD-1002	PLAN AT RL. 912.5 GRID D-G / 1-5	D01	22/02/2023	AS-BUILT	SBH	BDA	STY	AG	
MD-216-3510-EG-CV-GAD-1001	PLAN AT RL. 912.5 GRID A-D / 1-5	C01	07/11/2020	ISSUED FOR CONSTRUCTION AND REVISED AS MARKED	SBH	BDA	STY	AG	
MD-216-3510-EG-ME-GAD-1025	CCD CIRCUIT STEEL STRUCTURE LOADING DIAGRAM	A01	17/10/2020	ISSUED FOR REFERENCE	SBH	BDA	STY	AG	

RESERVED FOR VENDOR LOGO AND DRAWING NUMBER

LARSEN & TOUBRO

This drawing is the property of LARSEN & TOUBRO and must not be passed on to any person or body not authorized by us to receive it nor be copied or otherwise made use either in full or in part by such person or body without our prior permission in writing.

Outotec

The content of these documents are the sole property of Outotec Oyj. Any rights not expressly granted herein are reserved. Reproduction, transfer or distribution of part or all of the contents in any form without prior written permission of Outotec is prohibited.

MA'ADEN معادن
Saudi Arabian Mining Company شركة التعدين العربية السعودية

This document and the information contained herein is Ma'aden proprietary know-how. This document or any part thereof should not be reproduced, stored in a retrieval system or transmitted by any means, electronic or otherwise, or divulged without prior written permission of Ma'aden.

LARSEN & TOUBRO DRAWING NUMBER: 019045_450_C_D_24117_003 | REVISION: 2
OUTOTEC DRAWING NUMBER: 900707__GAU01__ST61__CTB17__35102 | DOCUMENT ID: OU100676807 | REVISION: 2

DRAWN	SBH	15/10/2020
CHECKED	BDA	16/10/2020
ENGINEER	STY	15/10/2020
APPROVED	AG	17/10/2020
EMPLOYER		
SCALE	1:100, 1:50	A1

MANSOURAH - MASSARAH GOLD PROJECT
DETAIL DRAWING
COUNTER CURRENT DECANTATION
GRADE SLAB

DRAWING NUMBER: MD - 216 - 3510 - EG - CV - DED - 1280 | REV: D01