


DRAWING NUMBER: MD-216-3510-EG-CV-GAD-1276 REV D01

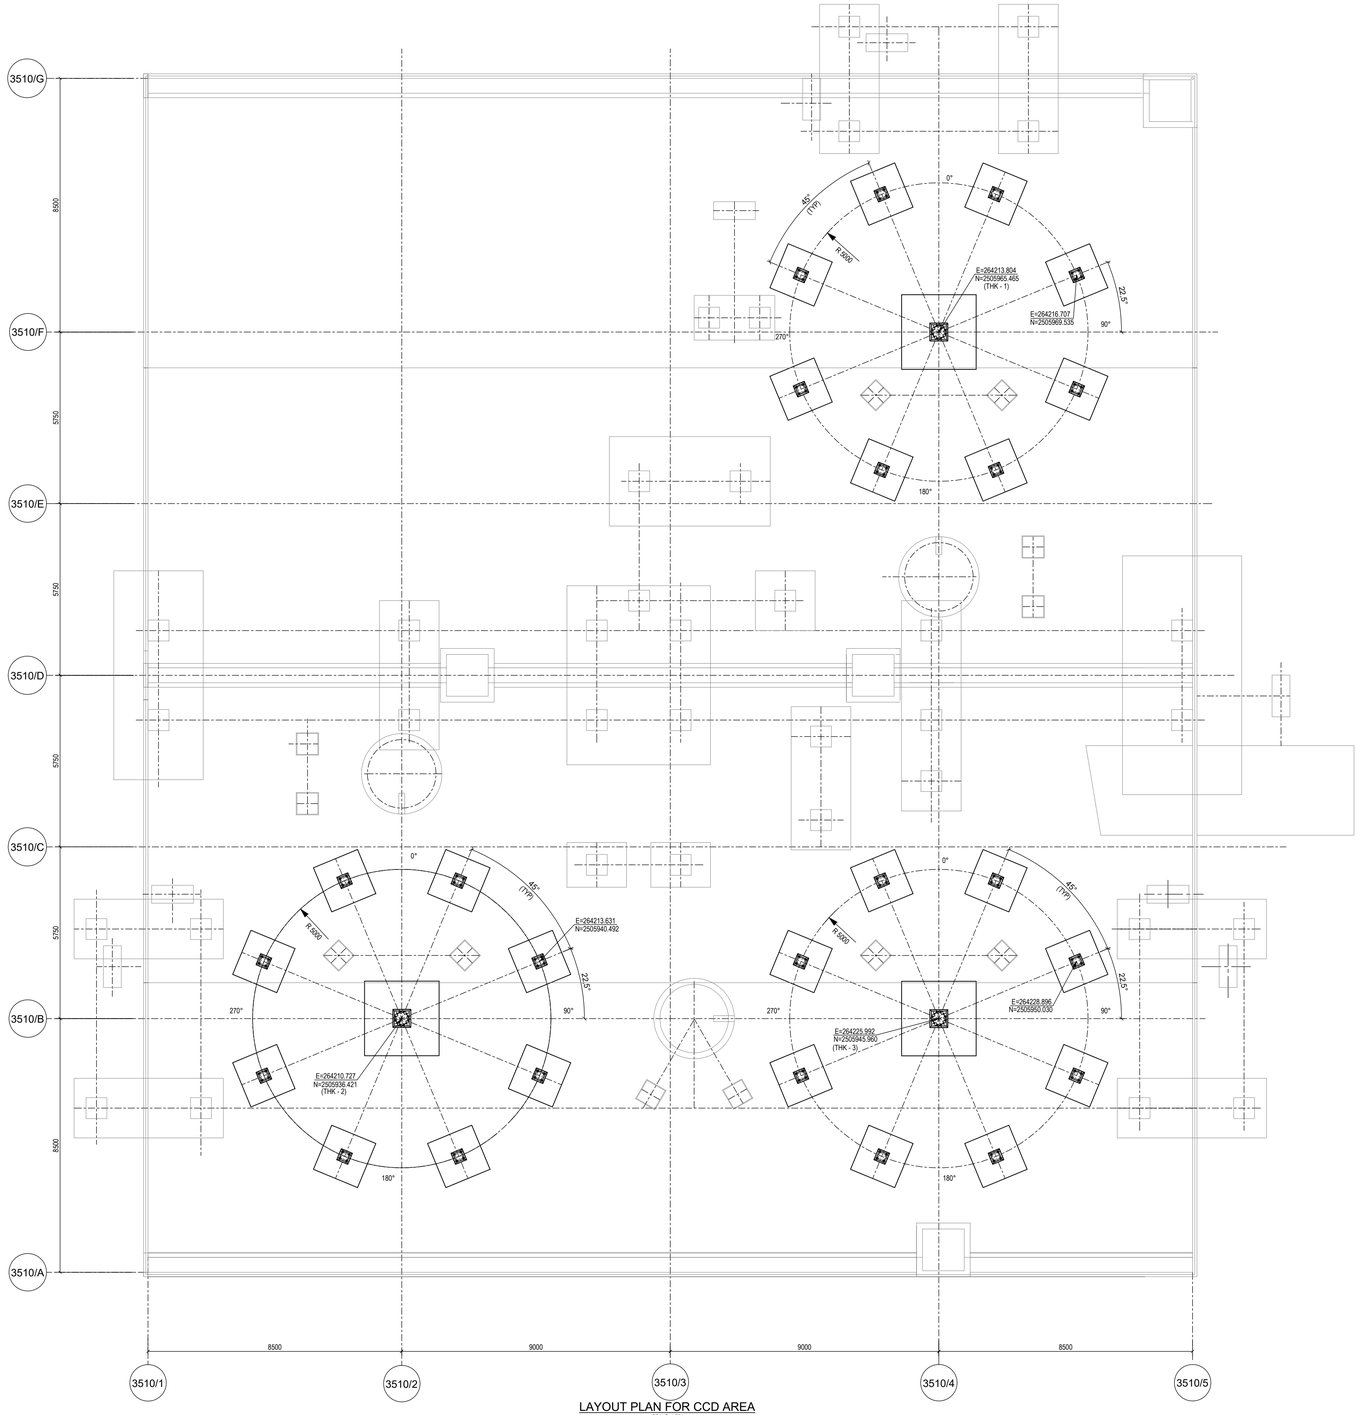


LAYOUT PLAN FOR CCD AREA
(SCALE- 1:75)

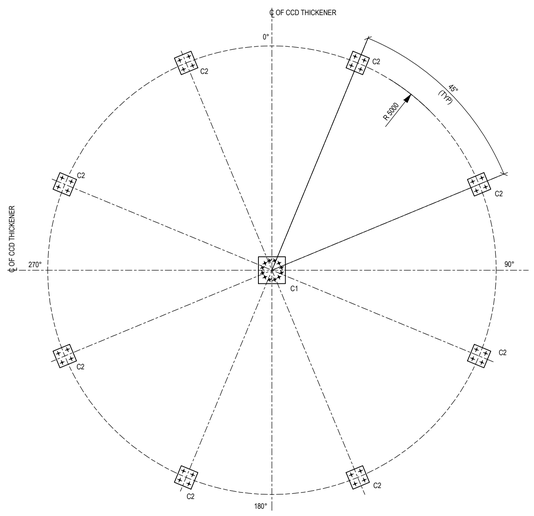


FOUNDATION BOLTS PLAN
(SCALE 1:50)

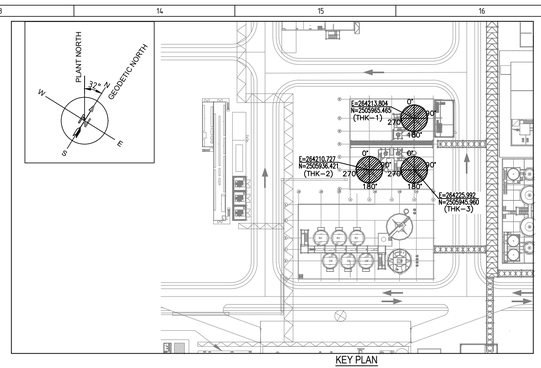


KEY PLAN

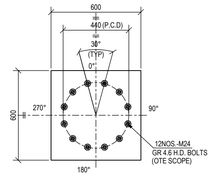


VIEW : B-B
(SCALE 1:15)

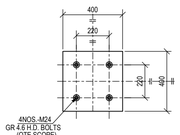


VIEW : D-D
(SCALE 1:15)

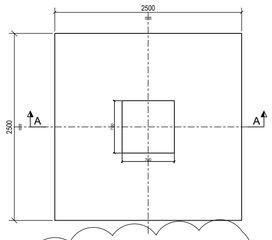


DETAIL OF FOUNDATION MKD. F1
(SCALE 1:30)
△D01

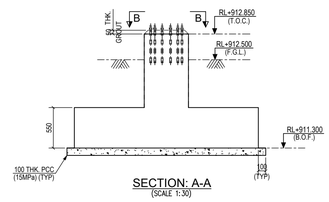


SECTION: A-A
(SCALE 1:30)

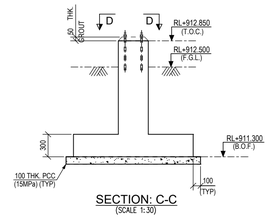

SECTION: C-C
(SCALE 1:30)

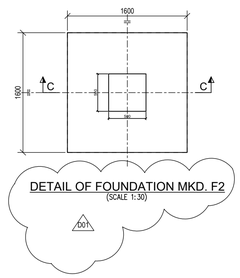

DETAIL OF FOUNDATION MKD. F2
(SCALE 1:30)
△D01

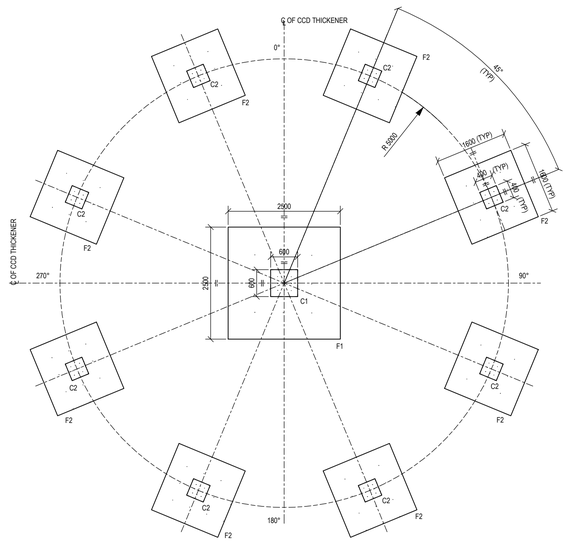

PLAN AT RL.+911.300(B.O.FDN.)
(FOR CCD THICKENER 1, 2 & 3) (SCALE 1:50)

LEGEND.:-

T.O.C - TOP OF CONCRETE
B.O.F - BOTTOM OF FOUNDATION
F.G.L - FINISHED GROUND LEVEL
C.C.D - COUNTER CURRENT DECANTATION
P.C.C - PLAIN CEMENT CONCRETE
℄ - CENTER LINE
TYP. - TYPICAL.

NOTES:-

1. ALL DIMENSIONS ARE IN MILLIMETRES AND LEVELS ARE IN METRES UNLESS OTHERWISE STATED.
2. GRADE OF CONCRETE SHALL BE C35
3. GRADE OF REINFORCEMENT SHALL BE DEFORMED BAR ASTM A615-GRADE 60 (fy=420 MPa)
4. NET SAFE BEARING CAPACITY CONSIDERED AT THE FOUNDING LEVEL IS 460 KN/SQ. M
5. IF ANY PART OF FOUNDATION COMES ON BACKFILL ZONE OF ADJACENT FOUNDATION OR ANY LOOSE PACKETS ARE ENCOUNTERED BELOW FOUNDATION LEVEL THE SAME SHALL BE REMOVED AND FILLED WITH PCC.
6. FOR DETAIL DRAWING REF. DRG. NO. MD - 216 - 3510 - EG - CV - DED - 1278.

DOCUMENT NUMBER	REFERENCE DOCUMENTS	REV	DATE	REVISION DESCRIPTION	DRN	CHK	ENG	APP	EMP
MD-216-3510-EG-ME-GAD-1009	LOAD PLAN - CCD CIRCUIT - LOAD TABLE								
MD-216-3510-EG-ME-GAD-1008	LOAD PLAN - CCD CIRCUIT - PLAN AT EL. +917.000								
MD-216-3510-EG-ME-GAD-1007	LOAD PLAN - CCD CIRCUIT - PLAN AT EL. +912.500								
MD-216-3510-EG-CV-GAD-1002	CIVIL WORKS GUIDE DRAWING - CCD CIRCUIT - PLAN AT EL. +912.500 - GRID D-G/1-5	D01	18/02/2023	AS-BUILT	NAEW-SN	BDA	STY	AG	
MD-216-3510-EG-CV-GAD-1001	CIVIL WORKS GUIDE DRAWING - CCD CIRCUIT - PLAN AT EL. +912.500 - GRID A-D/1-5	C03	30/05/2020	ISSUED FOR CONSTRUCTION & REVISED AS MKD. △D1	SBH	BDA	STY	AG	
MD-216-3510-EG-ME-GAD-1006	FOOTING AND LOADING PLAN COUNTER CURRENT DECANTATION THICKENER 3.	C02	30/03/2020	ISSUED FOR CONSTRUCTION	APM	BDA	STY	AG	
MD-216-3510-EG-ME-GAD-1004	FOOTING AND LOADING PLAN COUNTER CURRENT DECANTATION THICKENER 2.	C01	03/02/2020	ISSUED FOR CONSTRUCTION	SBH	BDA	STY	AG	
MD-216-3510-EG-ME-GAD-1002	FOOTING AND LOADING PLAN COUNTER CURRENT DECANTATION THICKENER 1.	A01	16/12/2019	ISSUED FOR REFERENCE	SBH	BDA	STY	AG	

RESERVED FOR VENDOR LOGO AND DRAWING NUMBER

LARSEN & TOUBRO

This drawing is the property of LARSEN & TOUBRO and must not be passed on to any person or body not authorized by us to receive it nor be copied or otherwise made use either in full or in part by such person or body without our prior permission in writing.

Outotec

The content of these documents are the sole property of Outotec Oyj. Any rights not expressly granted herein are reserved. Reproduction, transfer or distribution of part or all of the contents in any form without prior written permission of Outotec is prohibited.

MA'ADEN معادن
Saudi Arabian Mining Company شركة معادن السعودية

This document and the information contained herein is Ma'aden proprietary know-how. This document or any part thereof should not be reproduced, stored in a retrieval system or transmitted by any means, electronic or otherwise, or divulged without prior written permission of Ma'aden.

LARSEN & TOUBRO DRAWING NUMBER			REVISION
019045_450_C_G_24116_001			4
OUTOTEC DRAWING NUMBER		DOCUMENT ID	REVISION
900707 _ GAU01 _ ST61 _ MLD15 _ 35107		OU100665330	4
DRAWN	SBH	12/12/2019	MANSOURAH - MASSARAH GOLD PROJECT
CHECKED	BDA	13/12/2019	GENERAL ARRANGEMENT
ENGINEER	STY	12/12/2019	COUNTER CURRENT DECANTATION
APPROVED	AG	16/12/2019	THICKENER FOUNDATION
EMPLOYER			DRAWING NUMBER: MD - 216 - 3510 - EG - CV - GAD - 1276
SCALE 1:100		A0	REV D01